




A 40+50
DRIVE LT

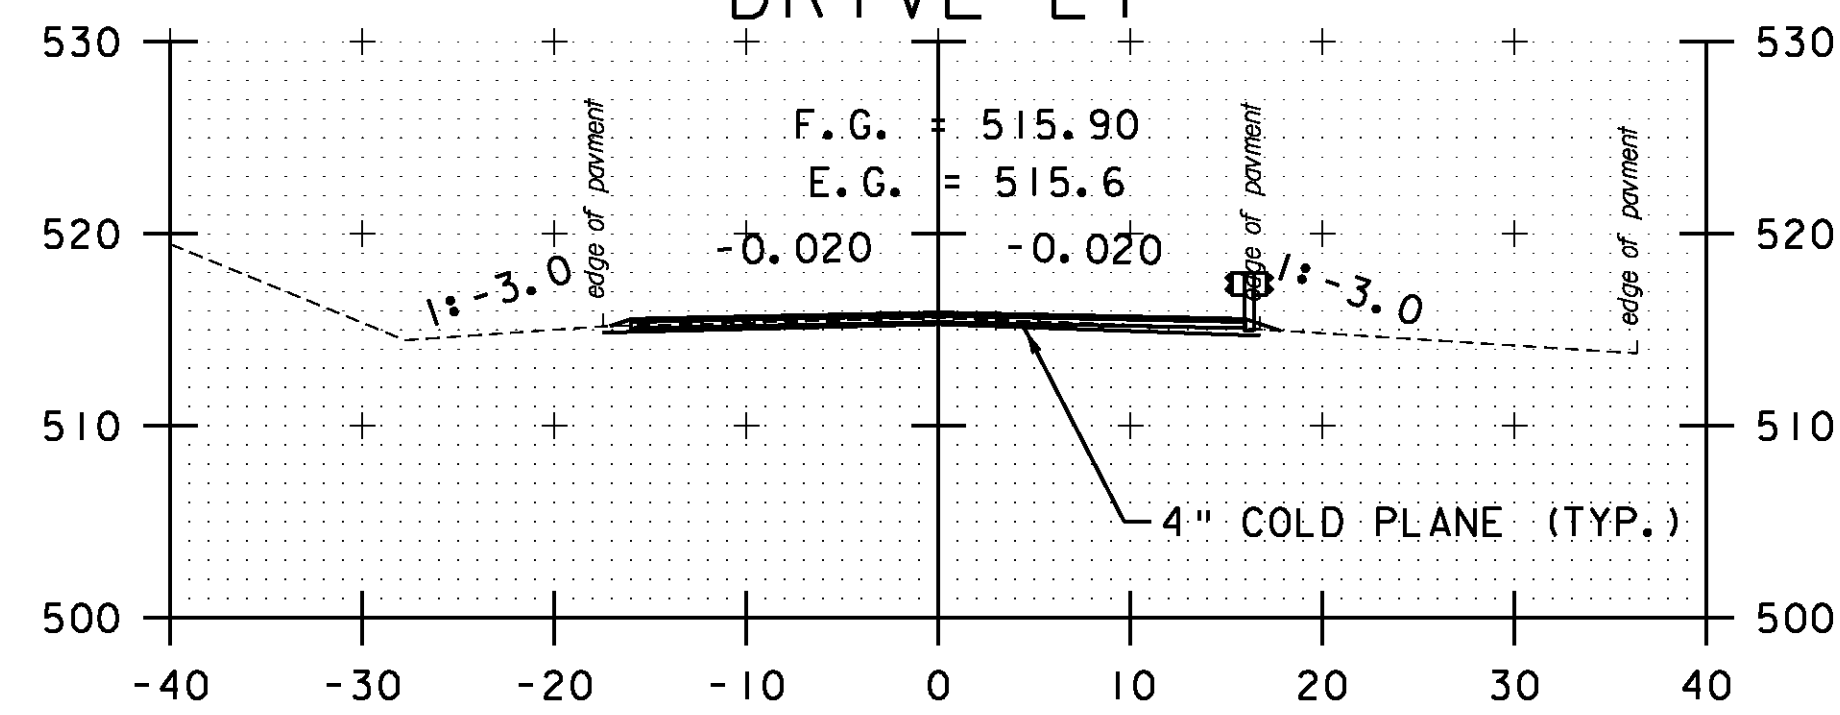


A 40+00

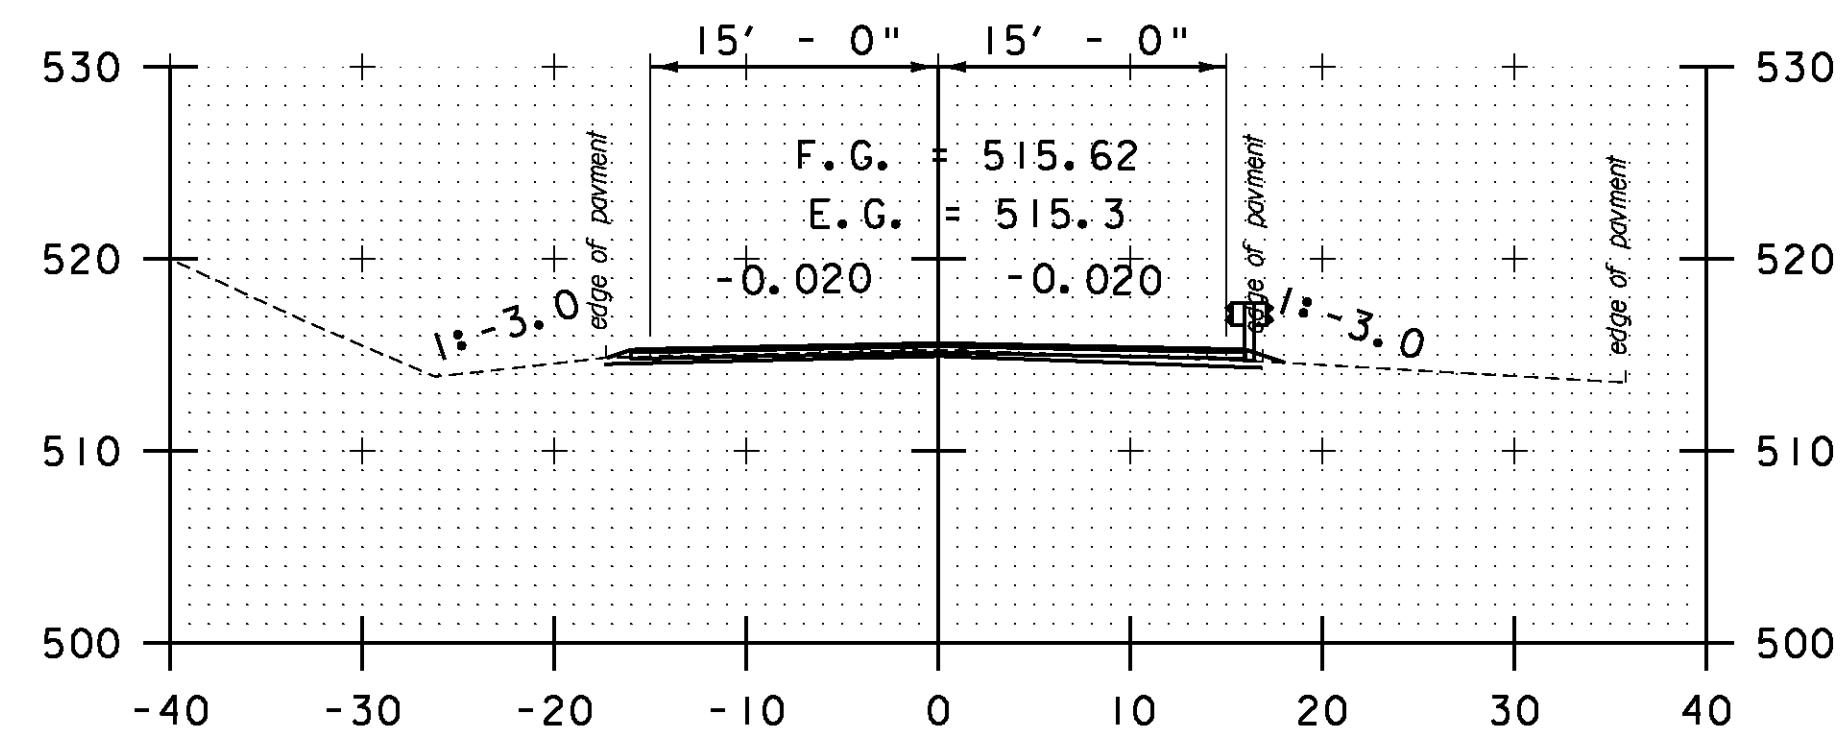


A 39+50

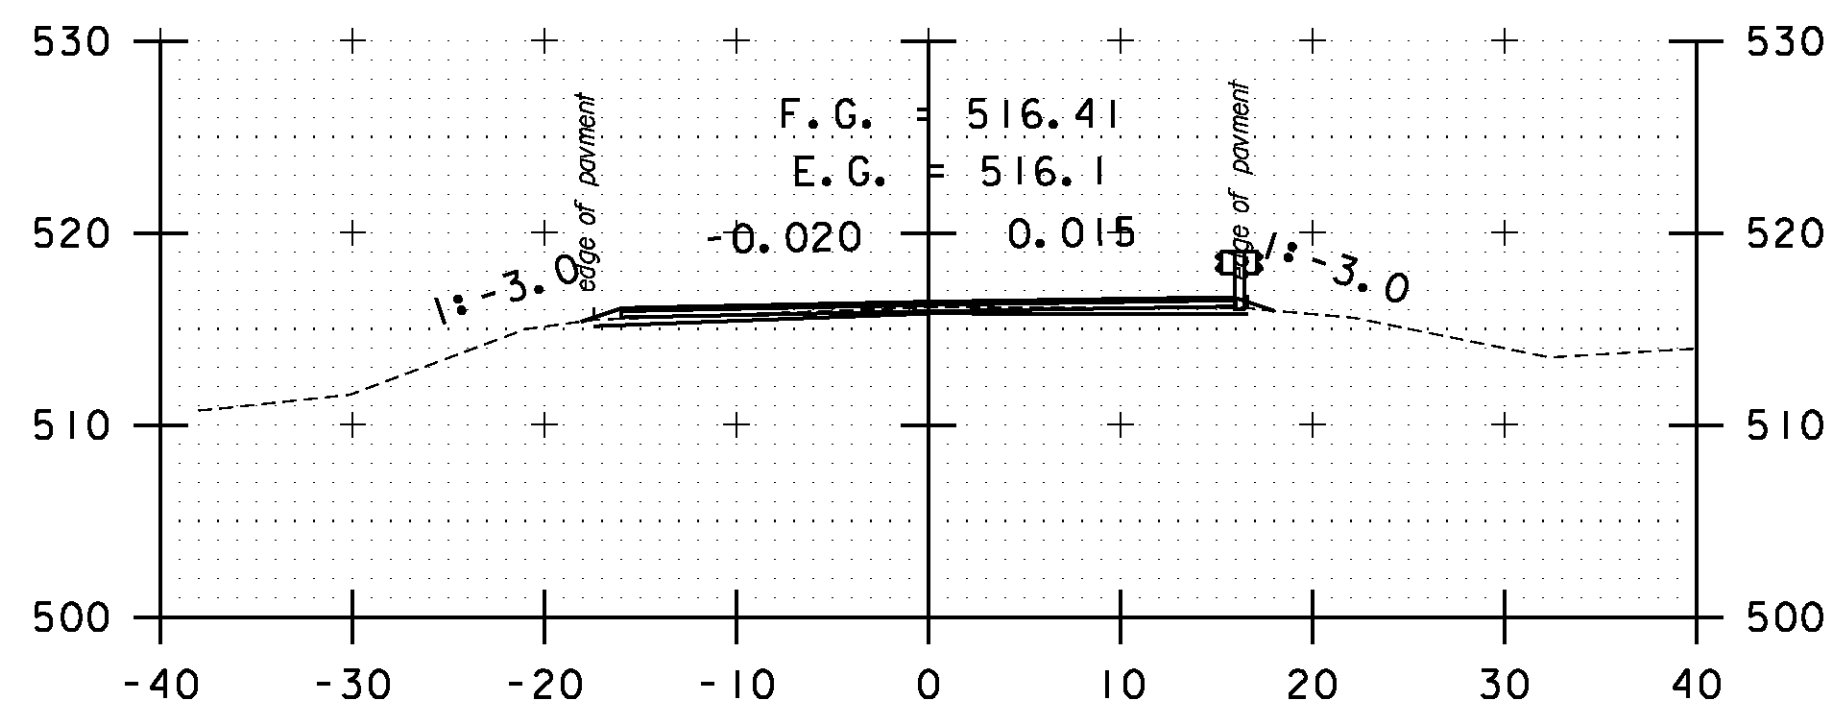


A 42+00

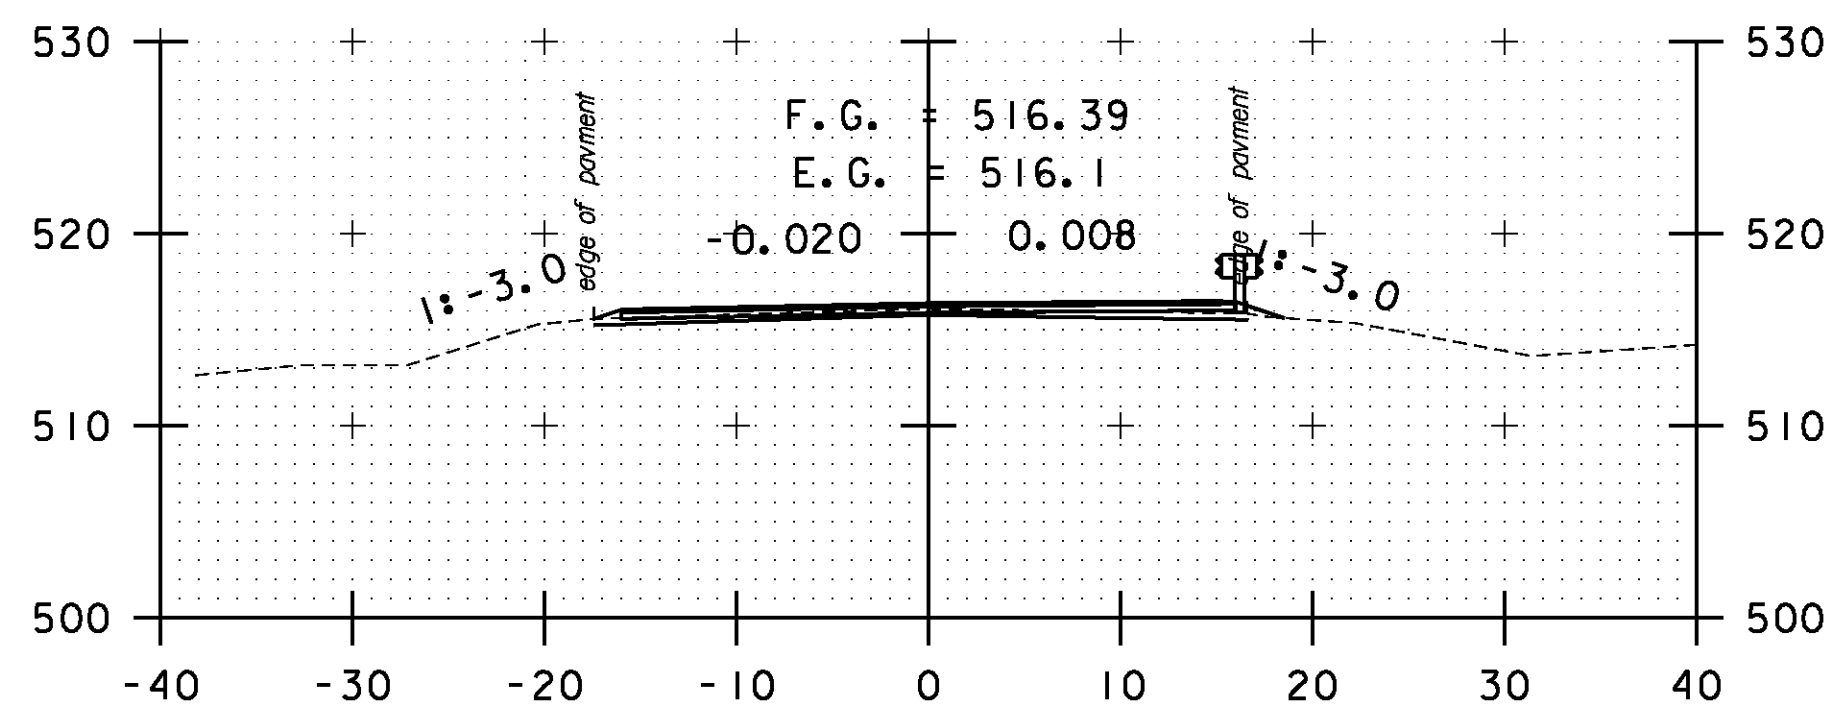


A 41+50

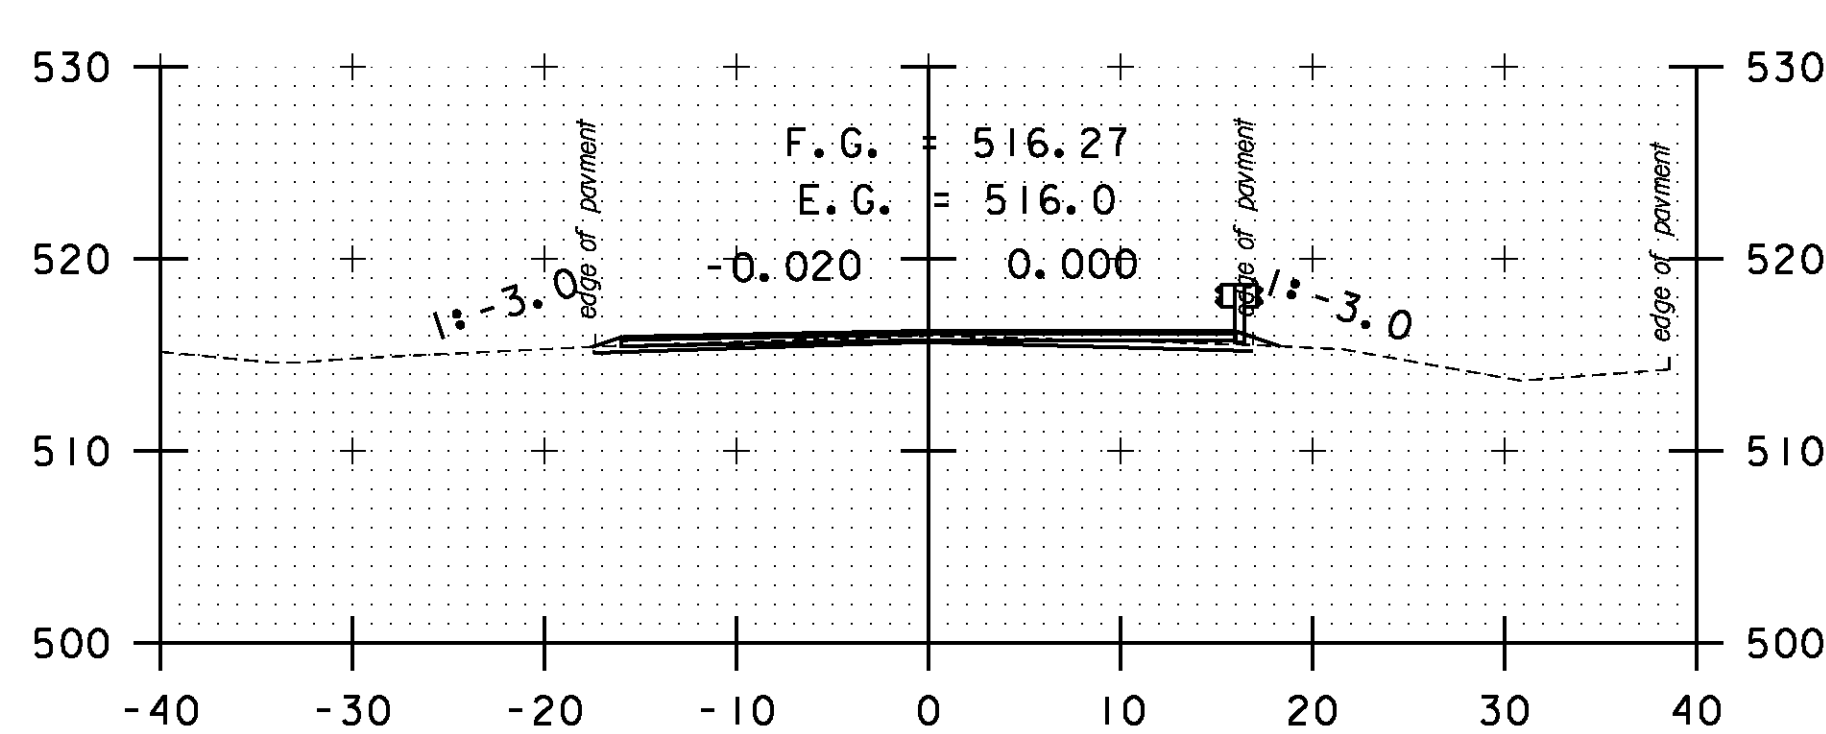


A 41+00

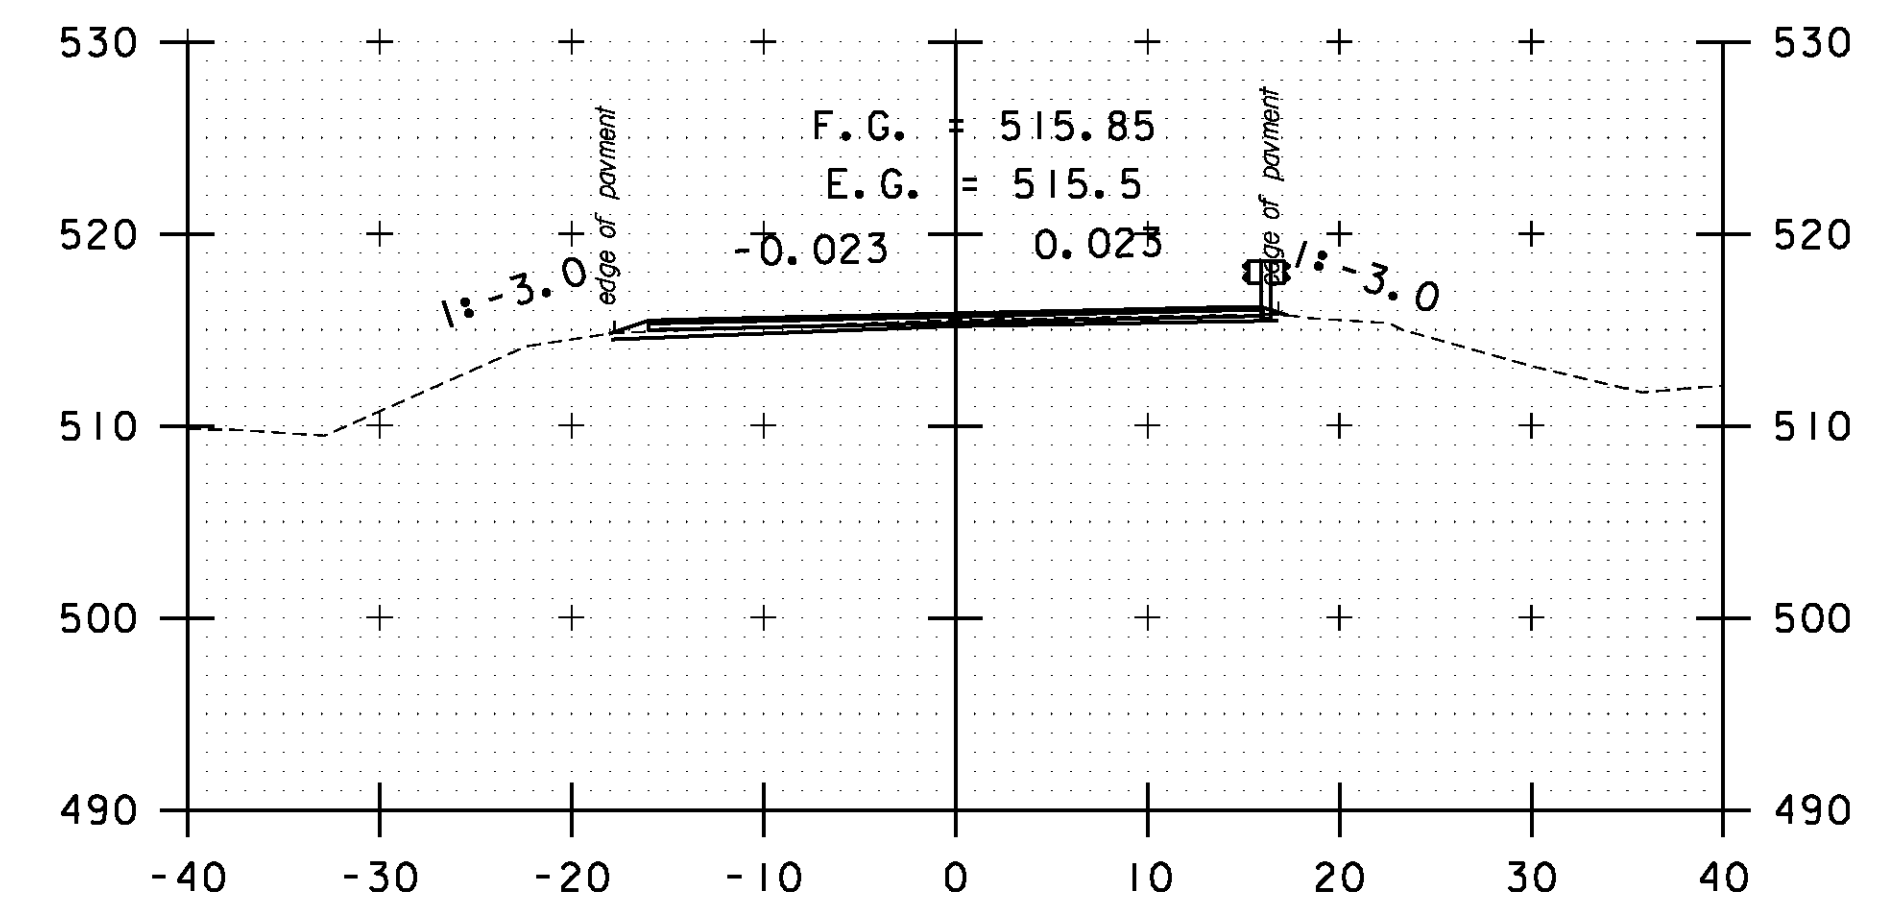

A 43+50

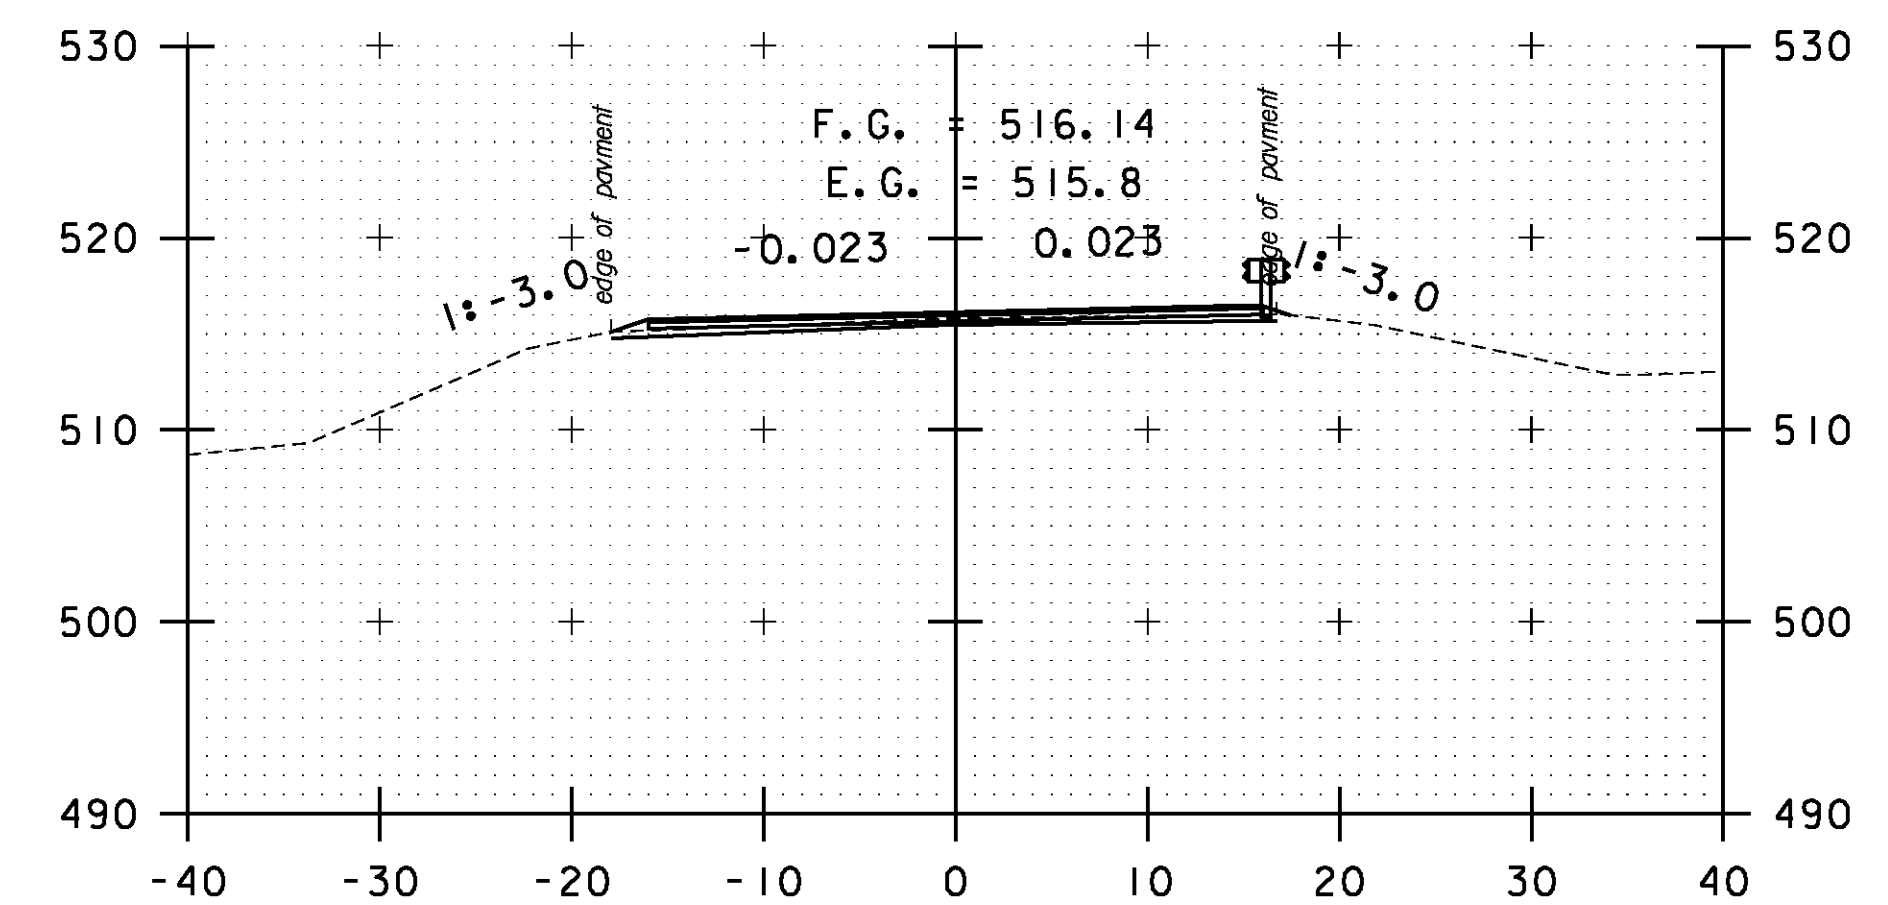

A 43+00

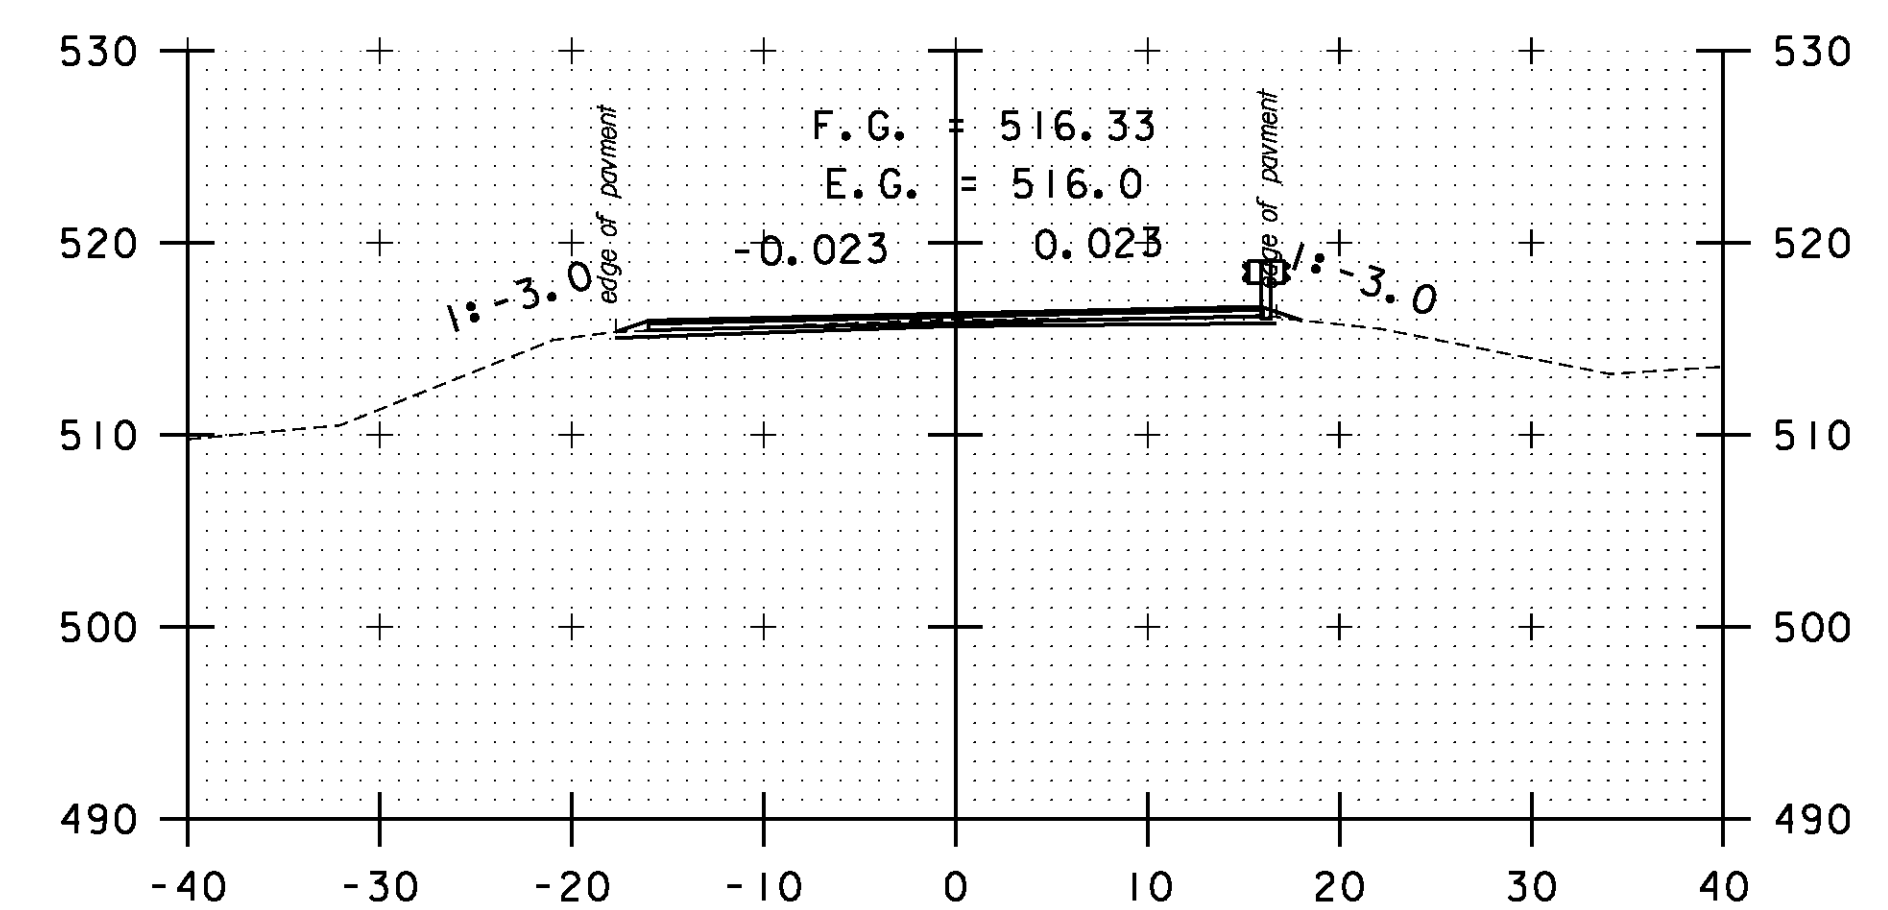

A 42+50

STA. A 39+50 TO STA. A 43+50

SCALE 1" = 10'-0"

CROSS SECTION SHEET 56

PROJECT NAME: BOLTON-WATERBURY

PROJECT NUMBER: STP 2709(1)

FILE NAME: p07C172.dgn

PROJECT LEADER: CDL

DESIGNED BY: BMB

PLOT FILE: p07C172_182.1

PLOT DATE: 4/16/2013

DRAWN BY: BMB

CHECKED BY: CDL

SHEET 182 OF 217