




A 45+00

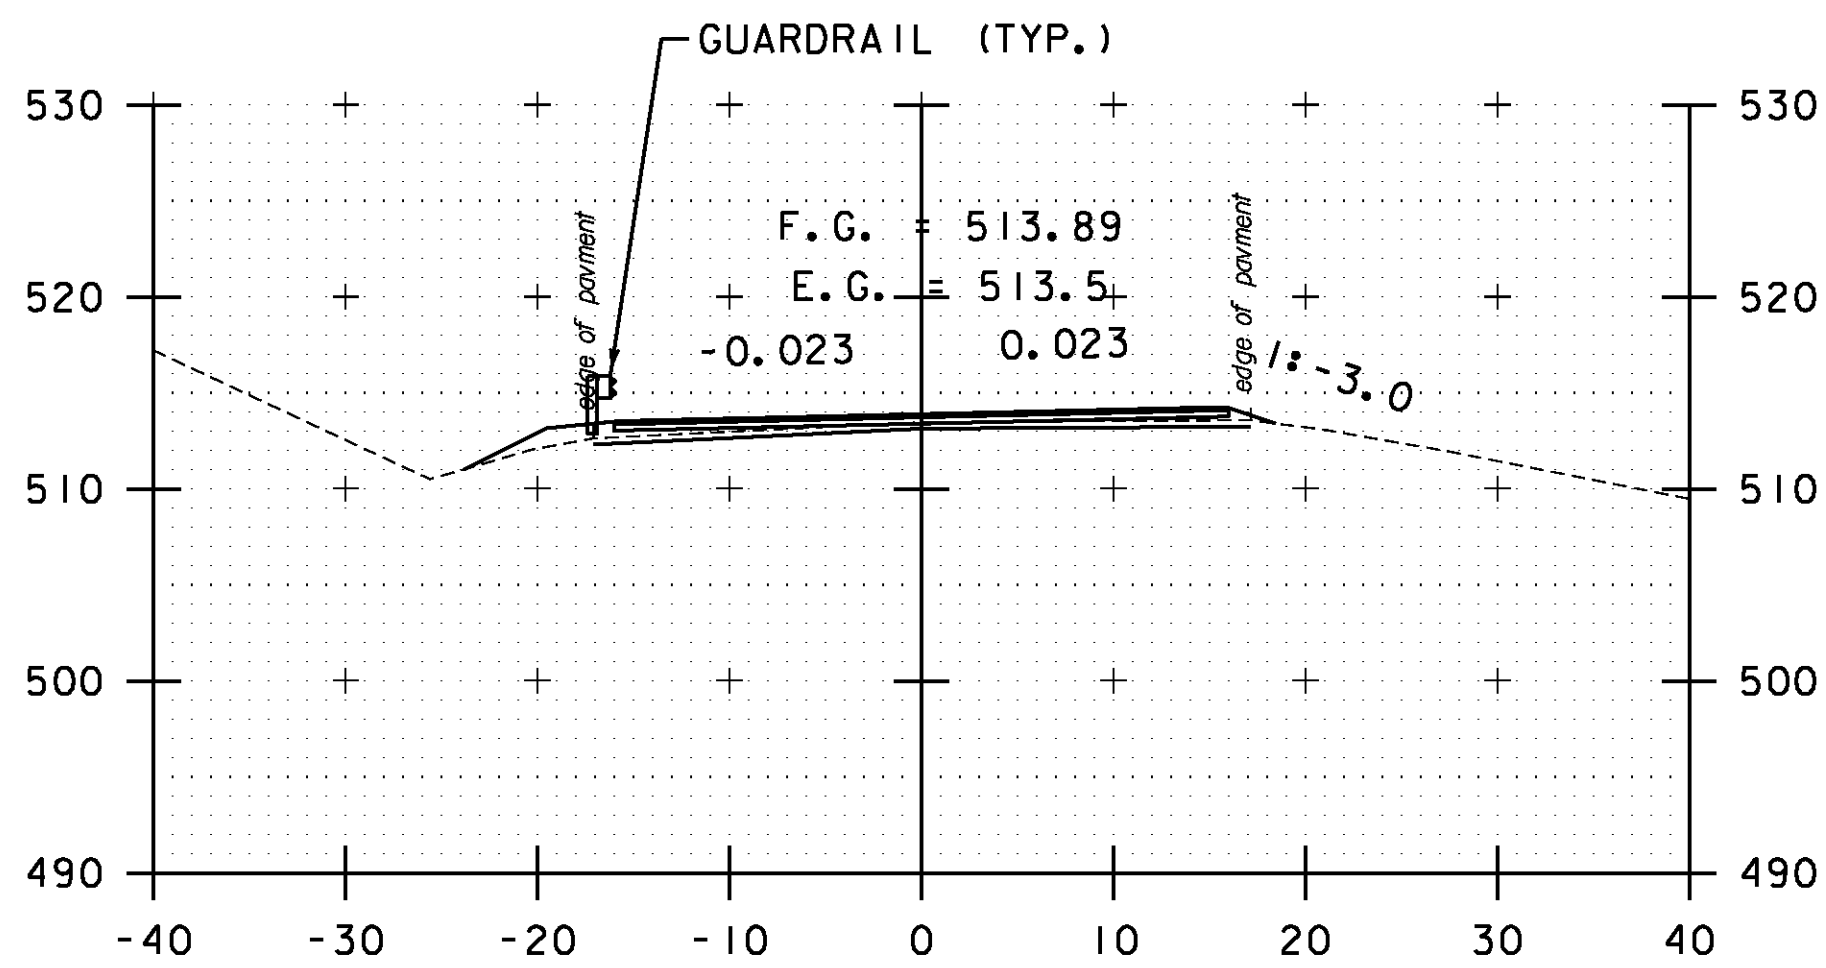


A 46+50

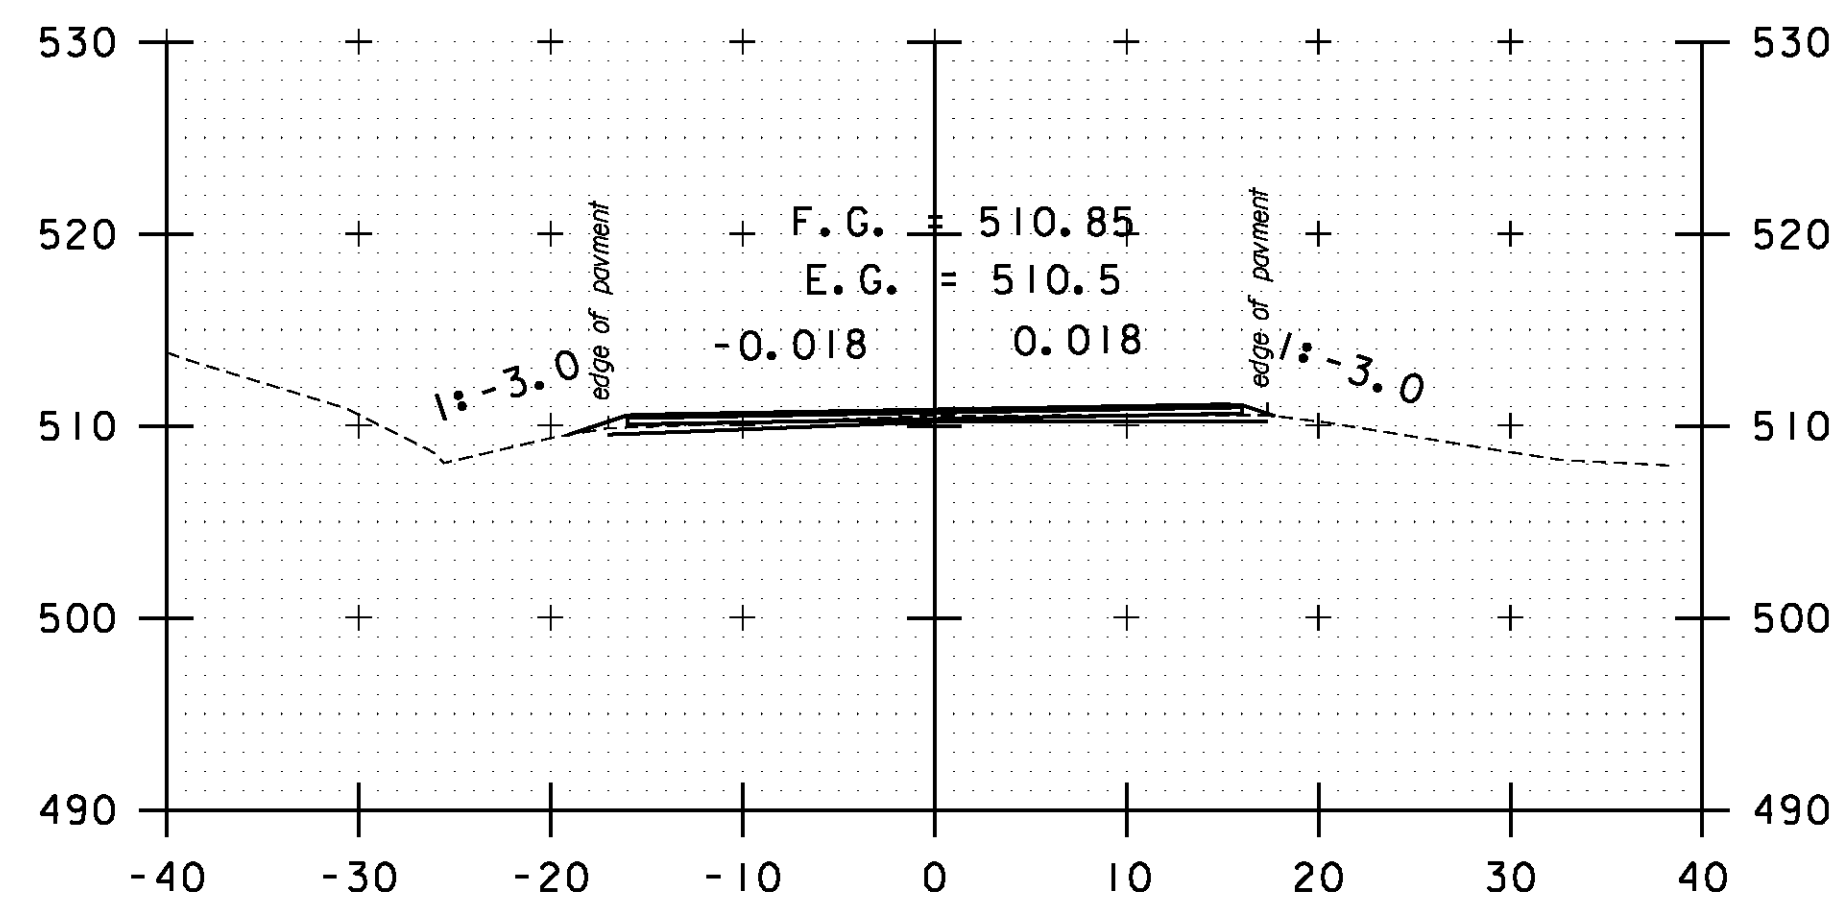


A 48+00

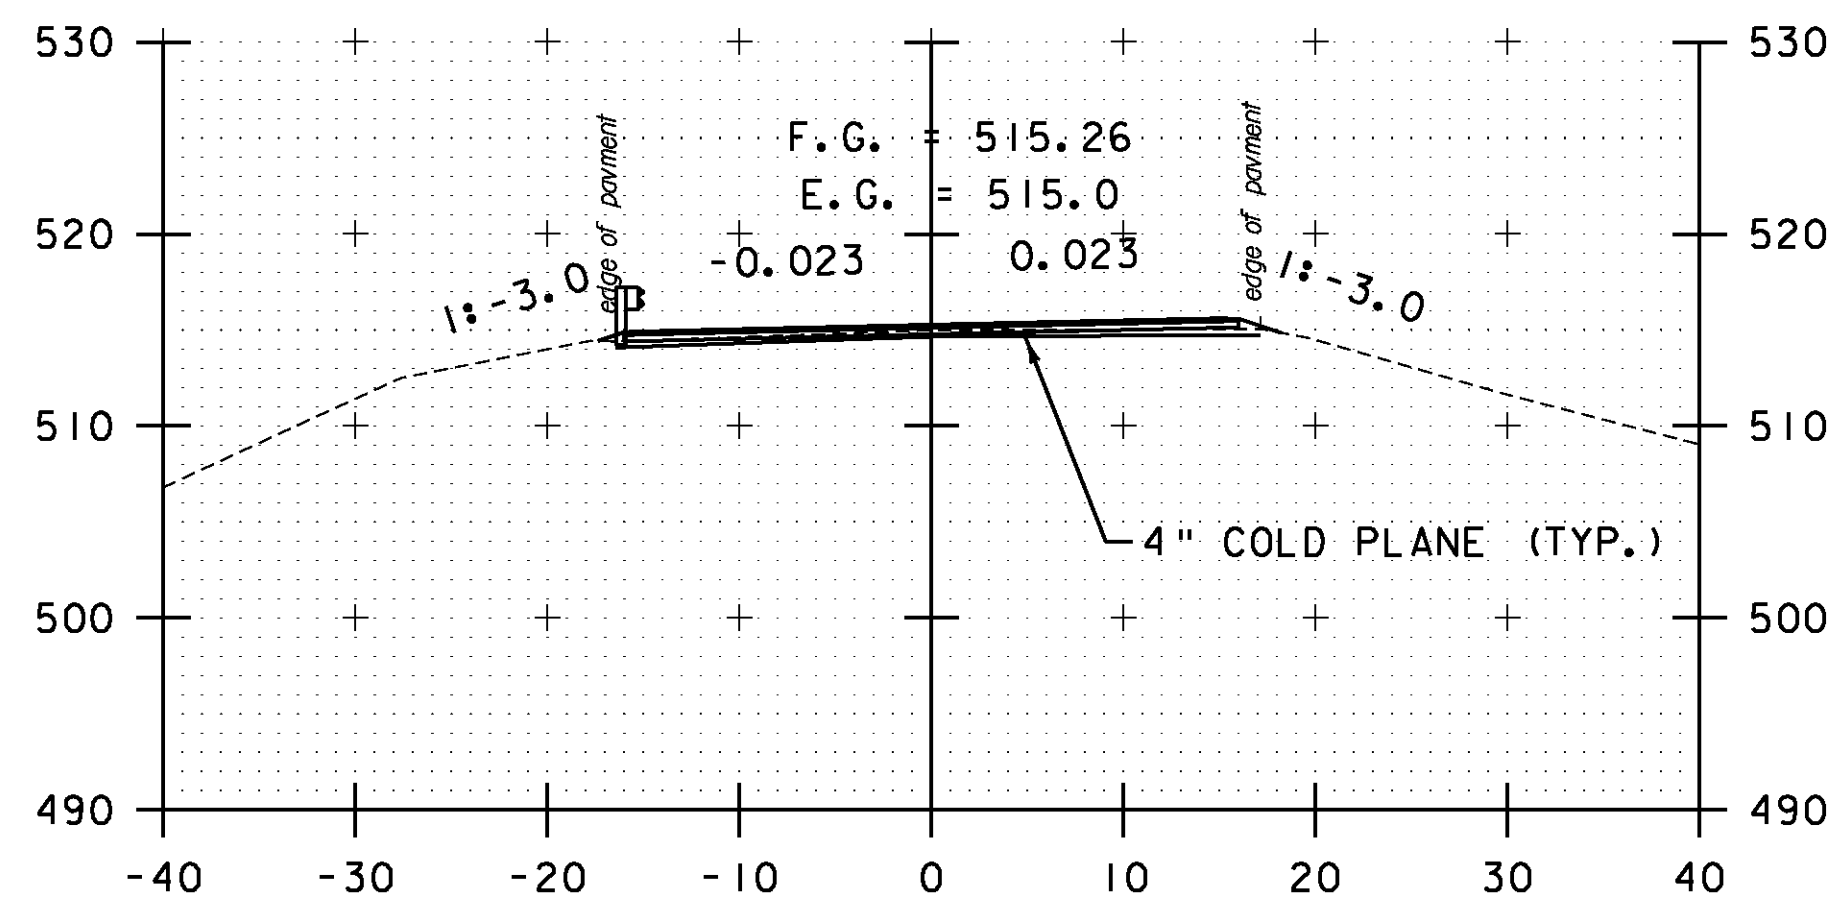


A 44+50

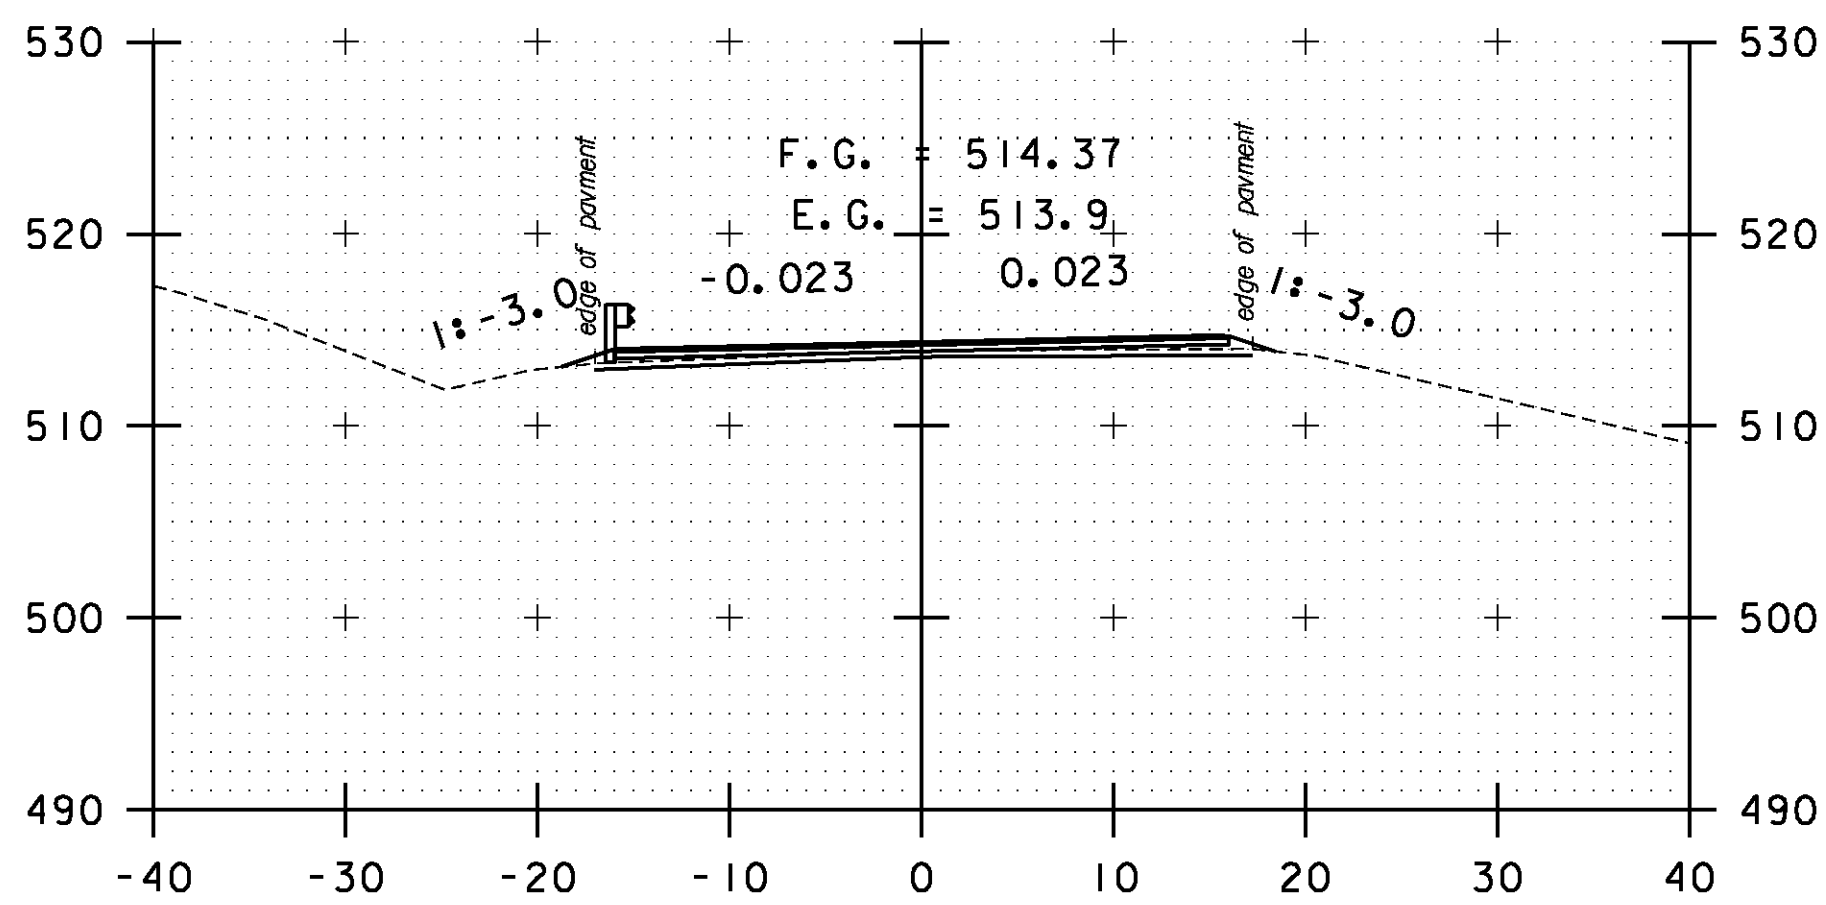


A 46+00

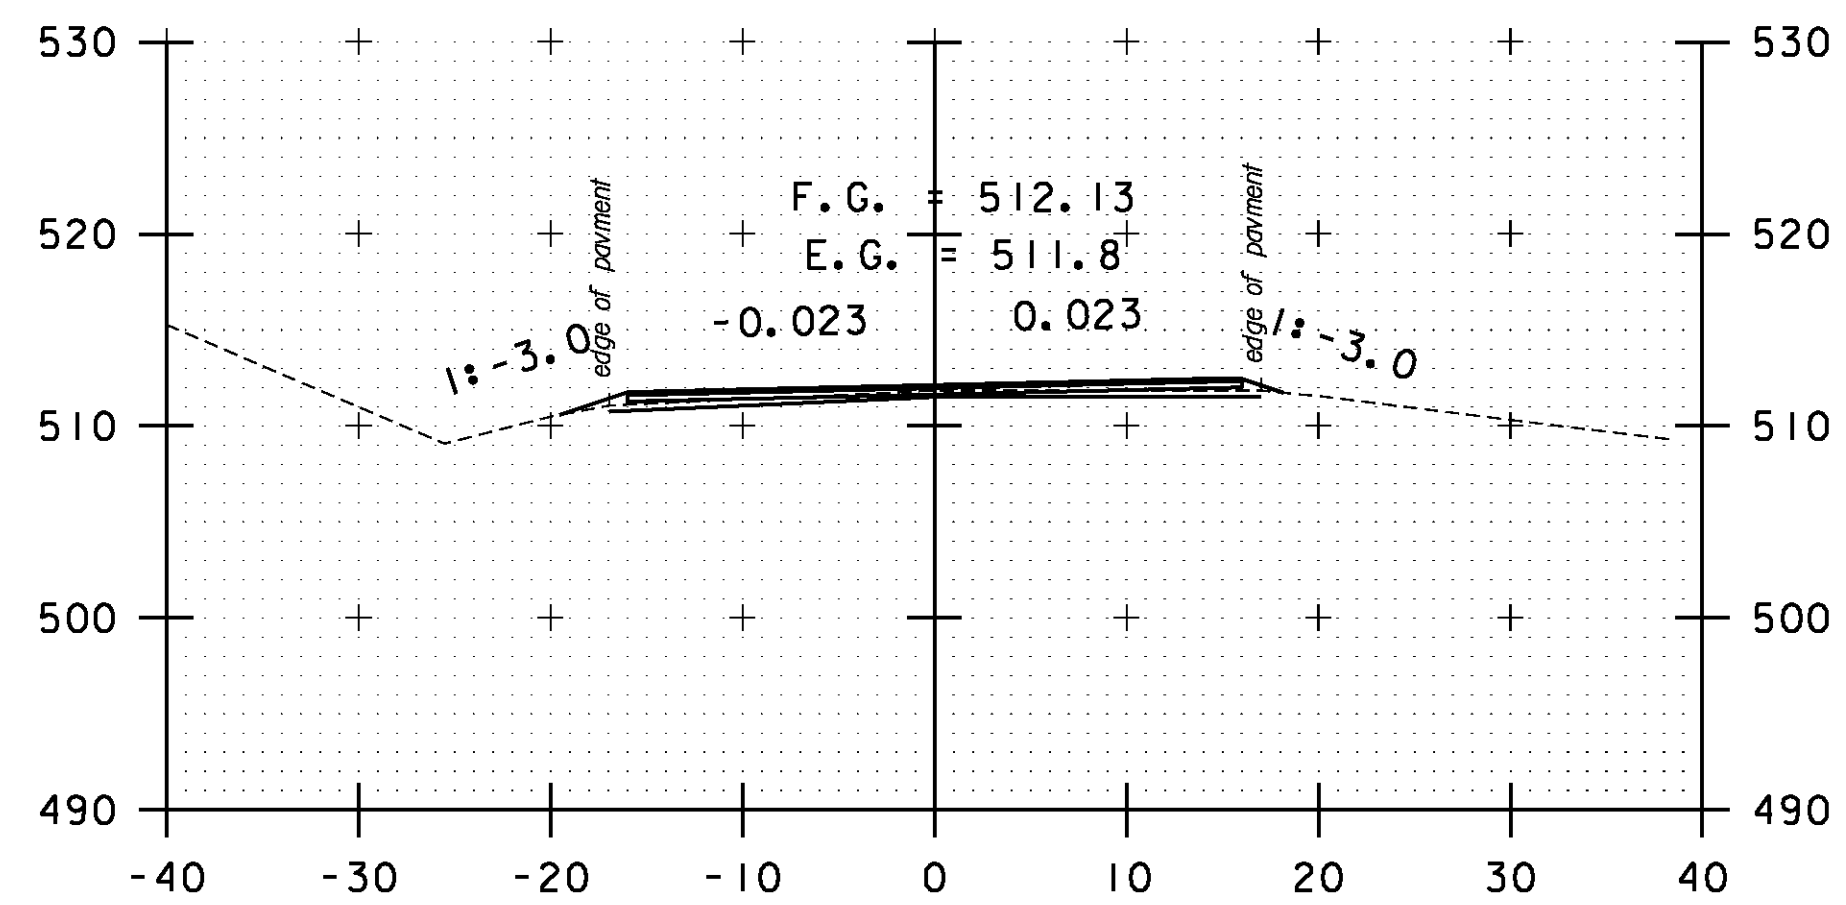


A 47+50

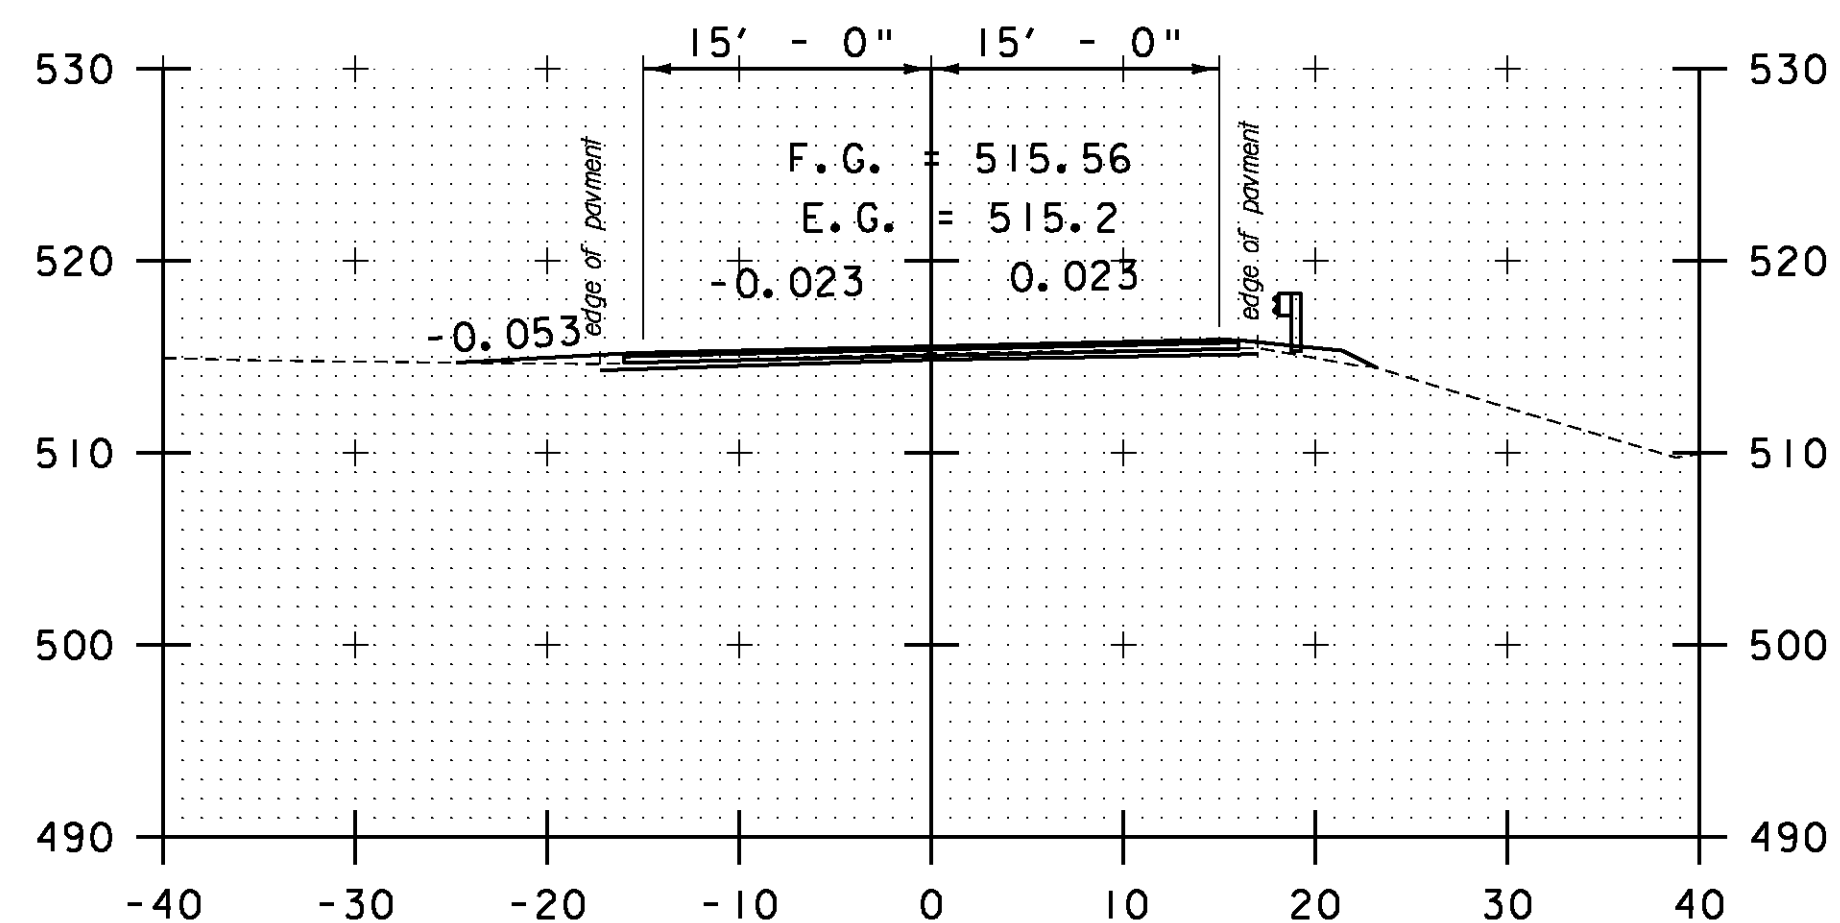

DRIVE LT
A 44+00

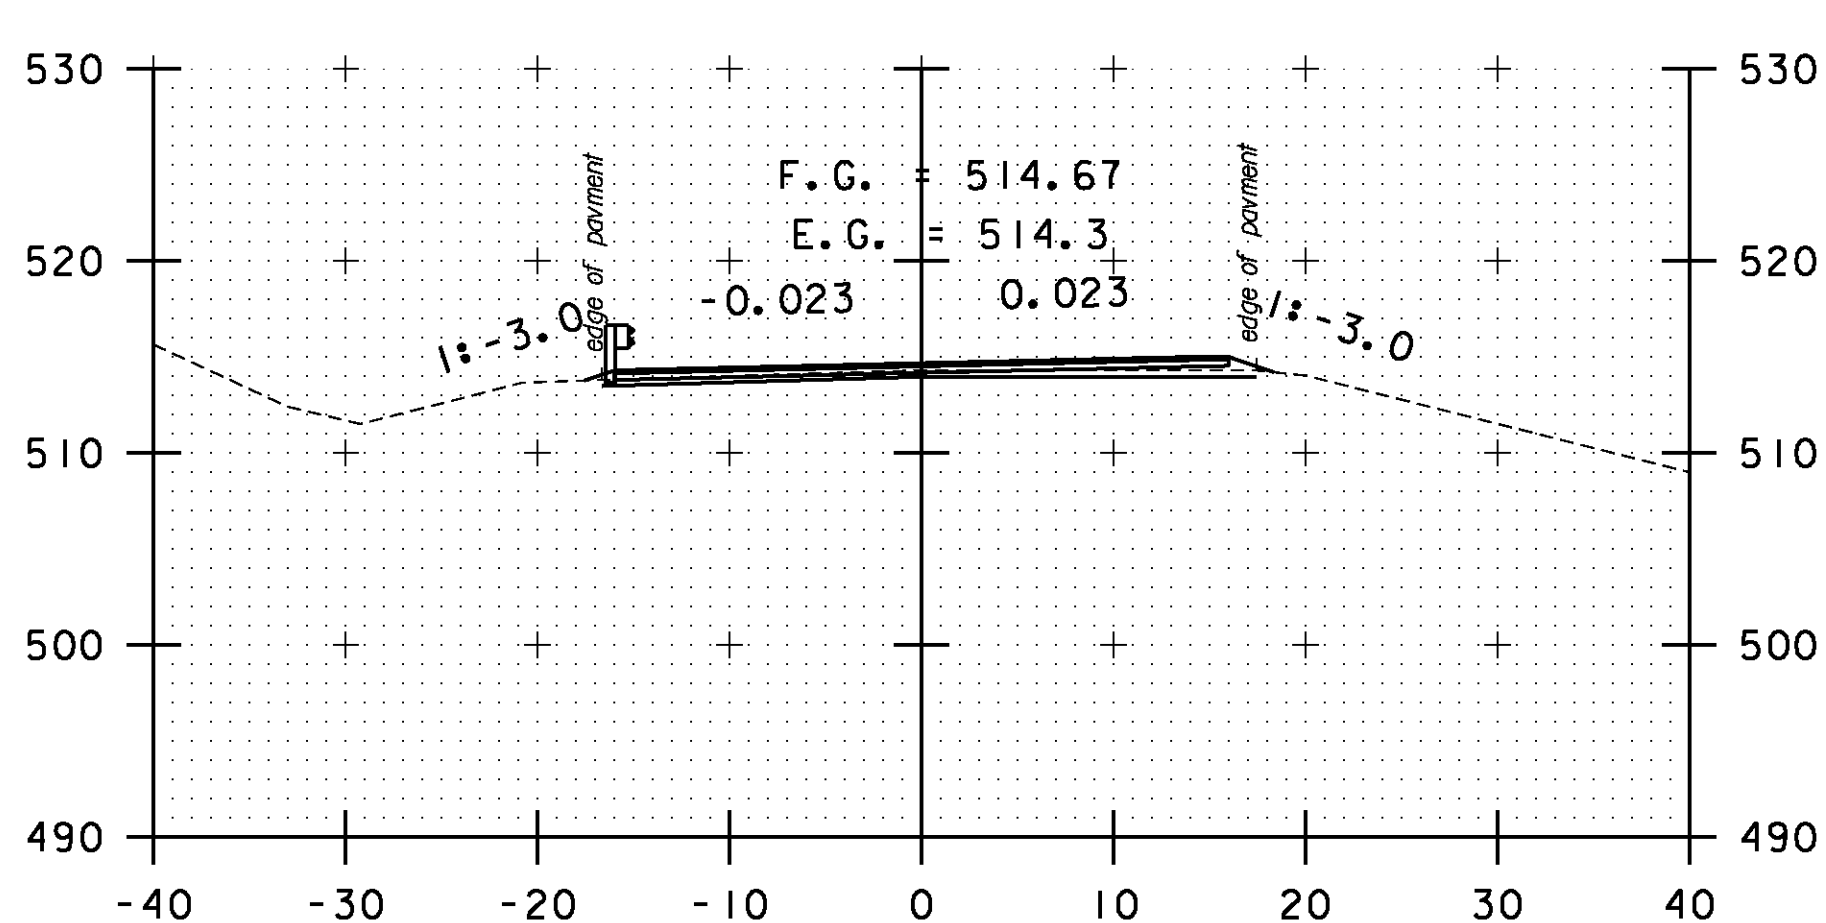


A 45+50

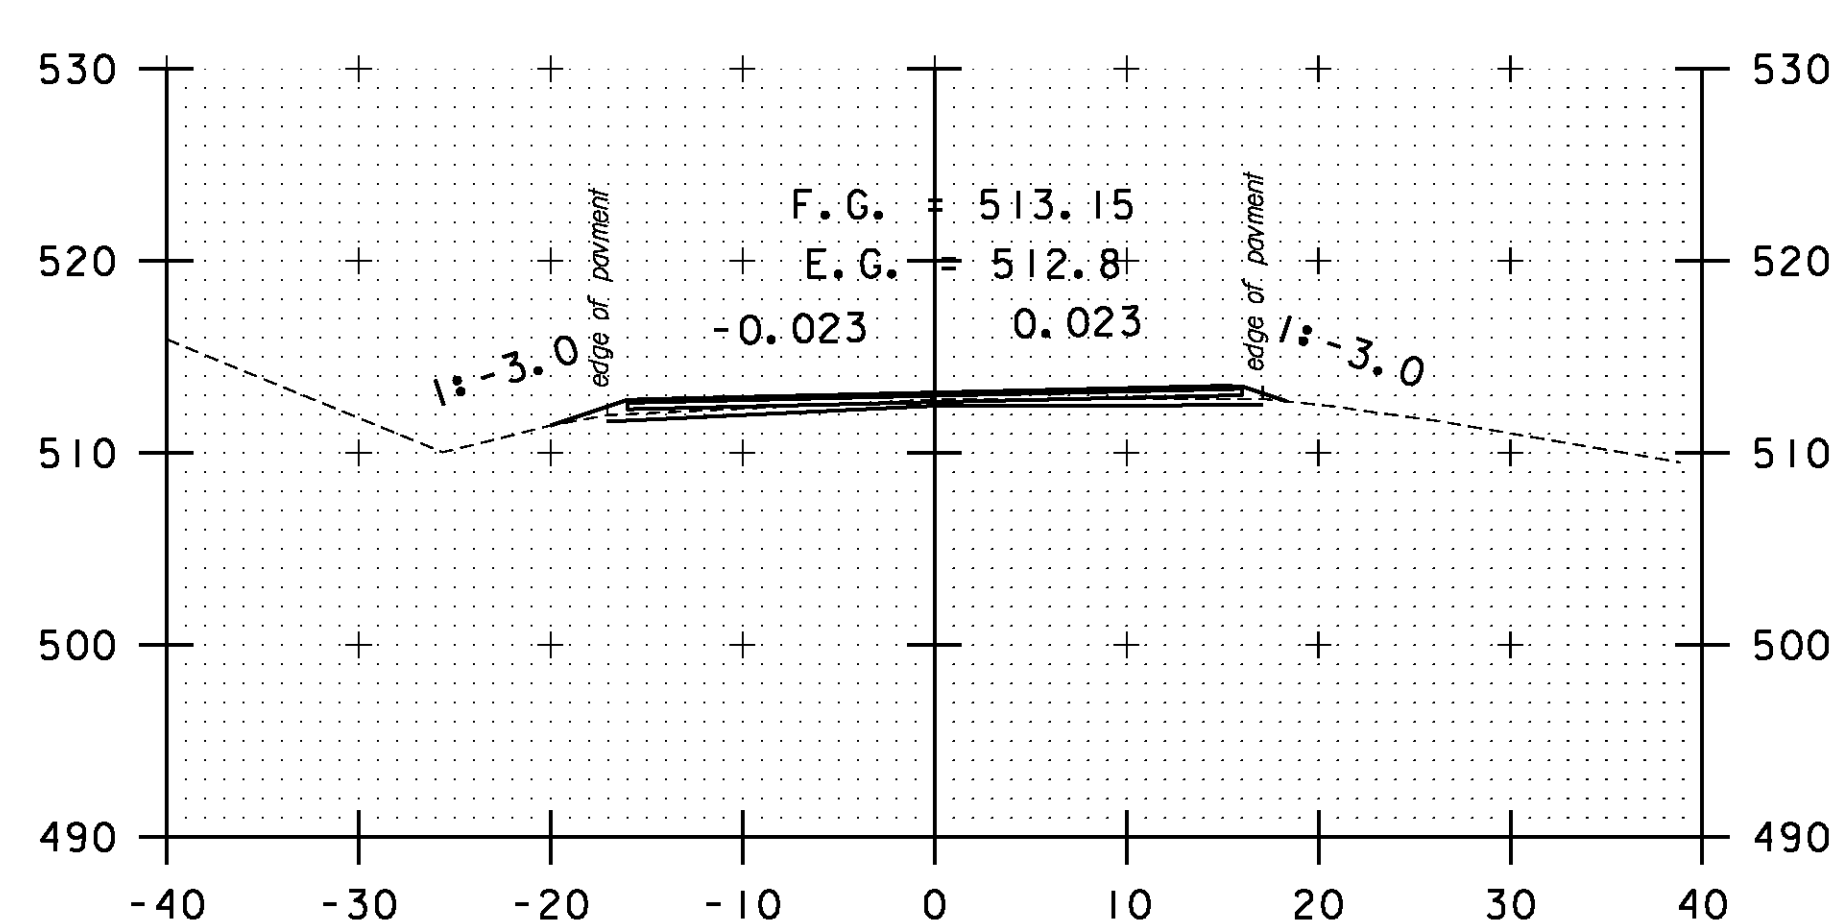

A 47+00

STA. A 44+00 TO STA. A 48+00

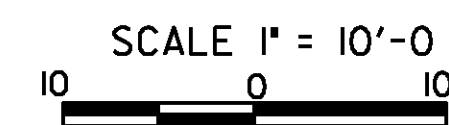

CROSS SECTION SHEET 57

PROJECT NAME: BOLTON-WATERBURY
PROJECT NUMBER: STP 2709(I)

FILE NAME: p07C172.dgn
PROJECT LEADER: CDL
DESIGNED BY: BMB
PLOT FILE: p07C172_183.1

PLOT DATE: 4/16/2013
DRAWN BY: BMB
CHECKED BY: CDL
SHEET 183 OF 217