




DRIVE LT  
A 58+50

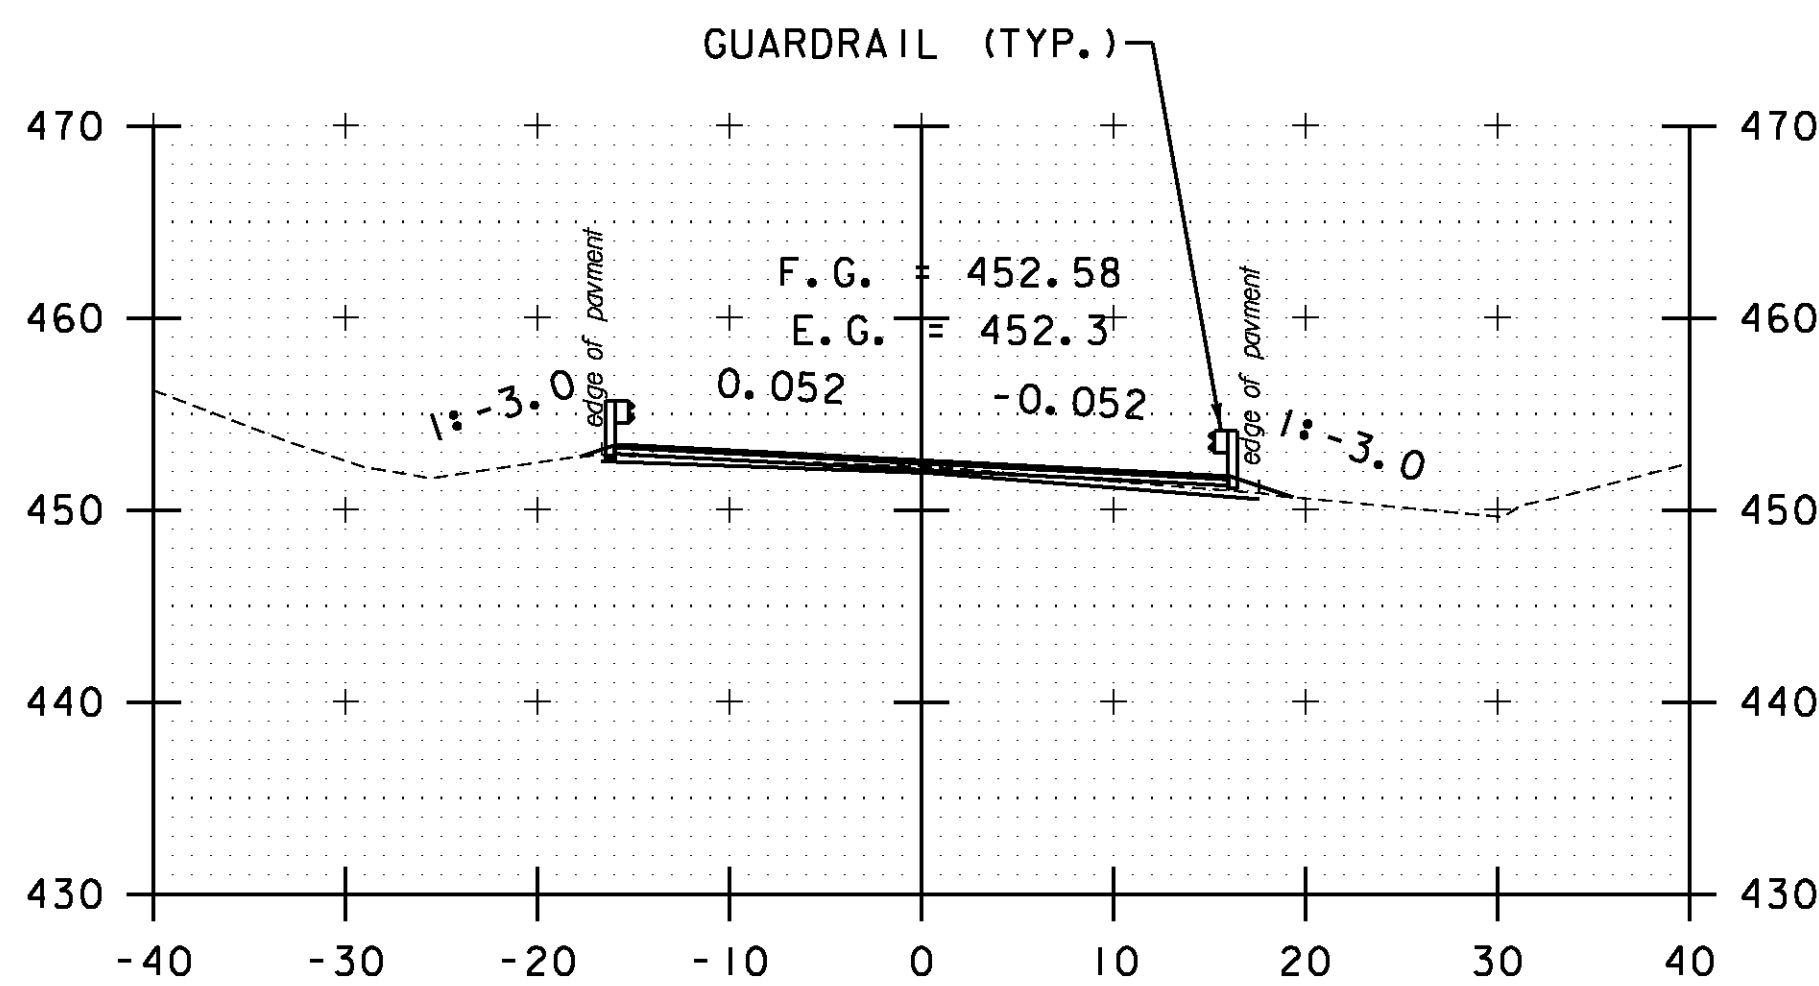


A 60+00

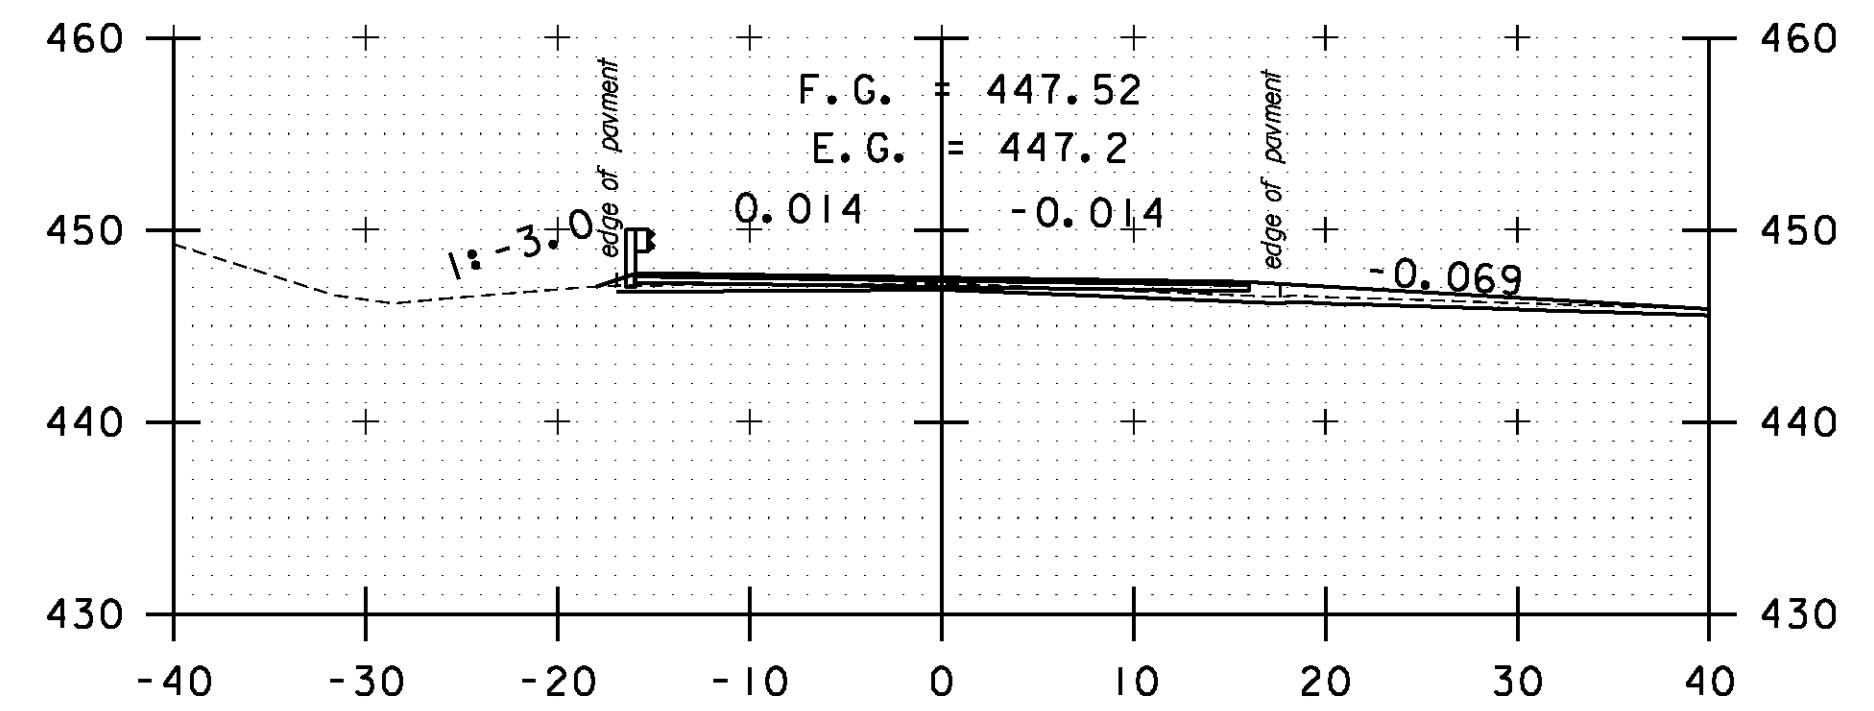


TH#43 RT  
A 61+00

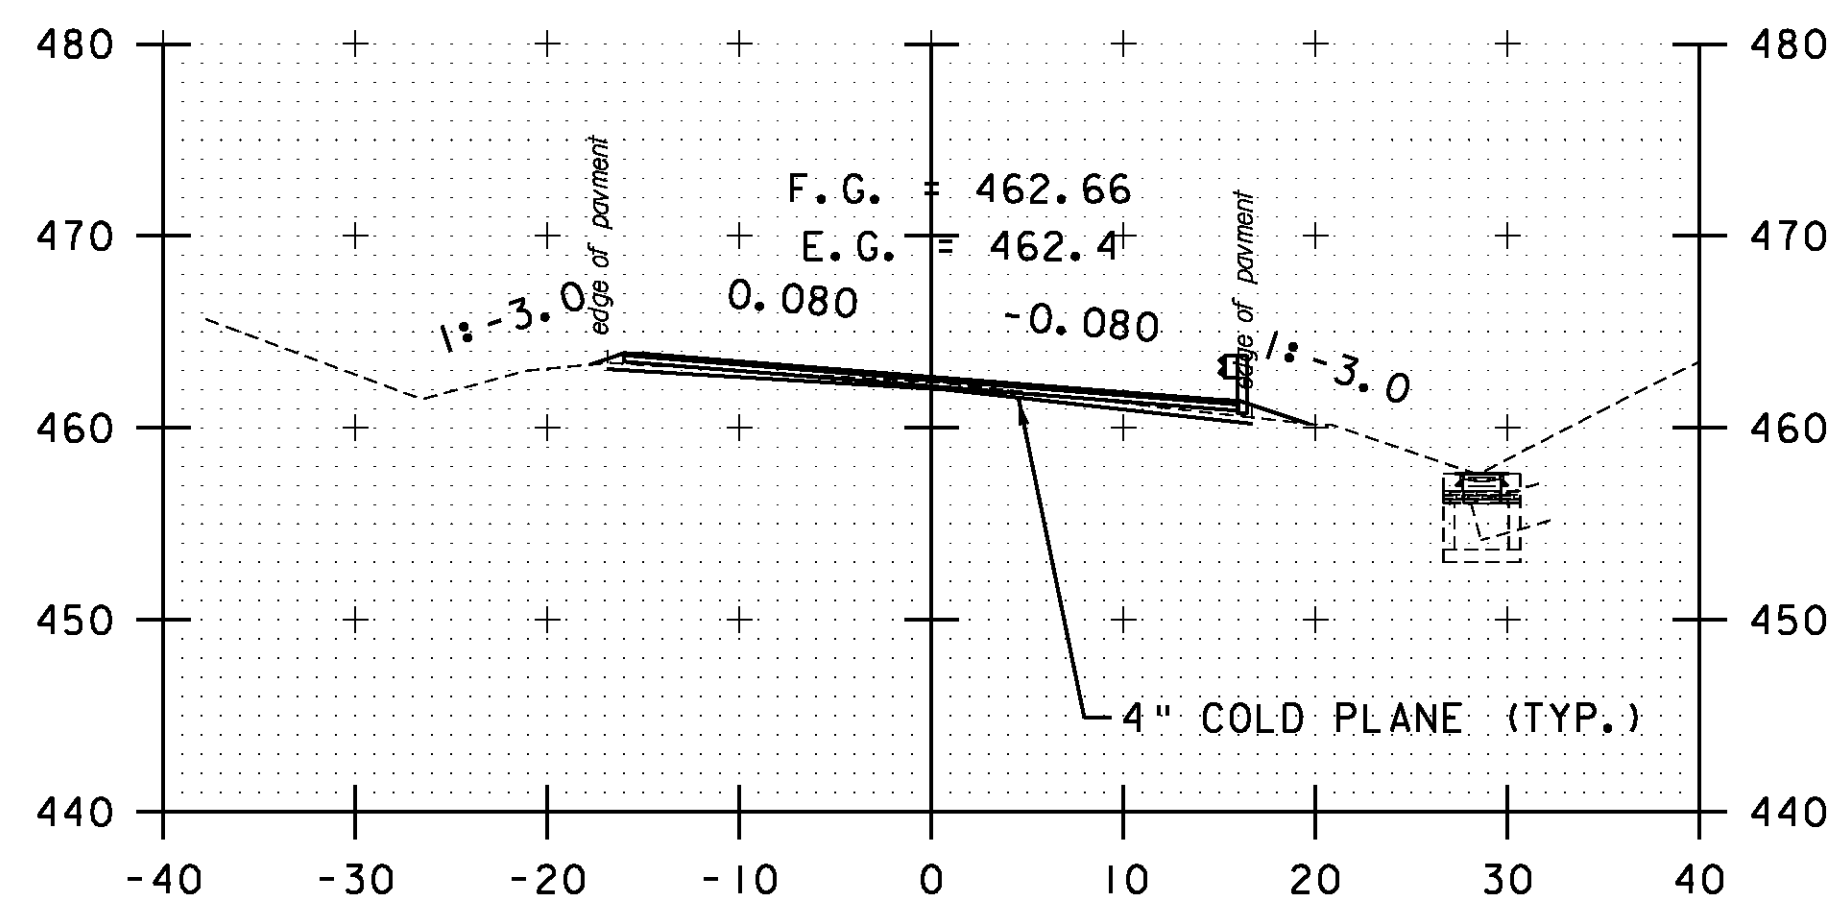


A 58+00

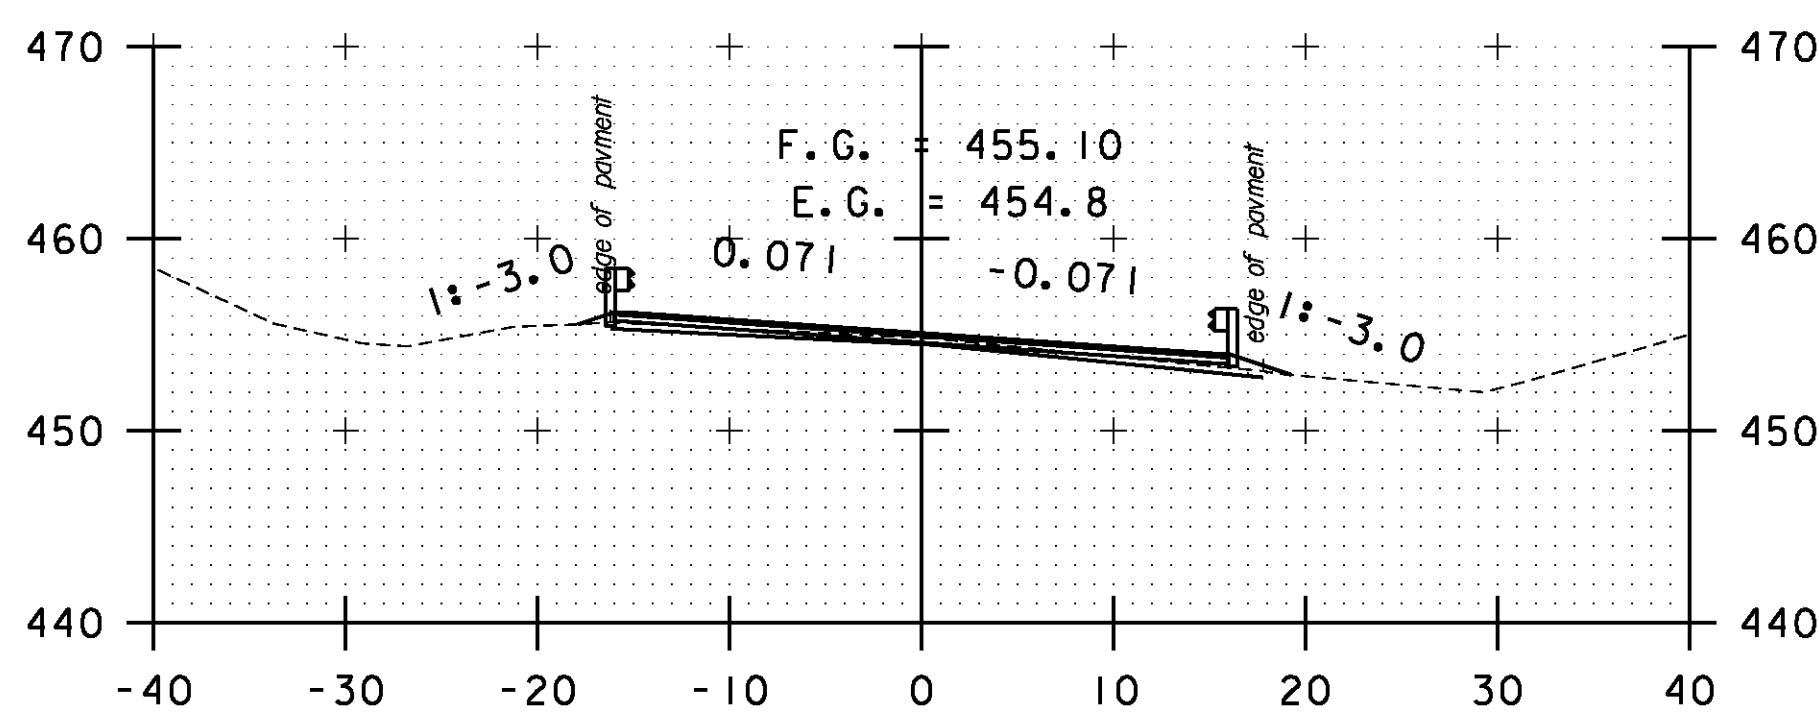


A 59+50

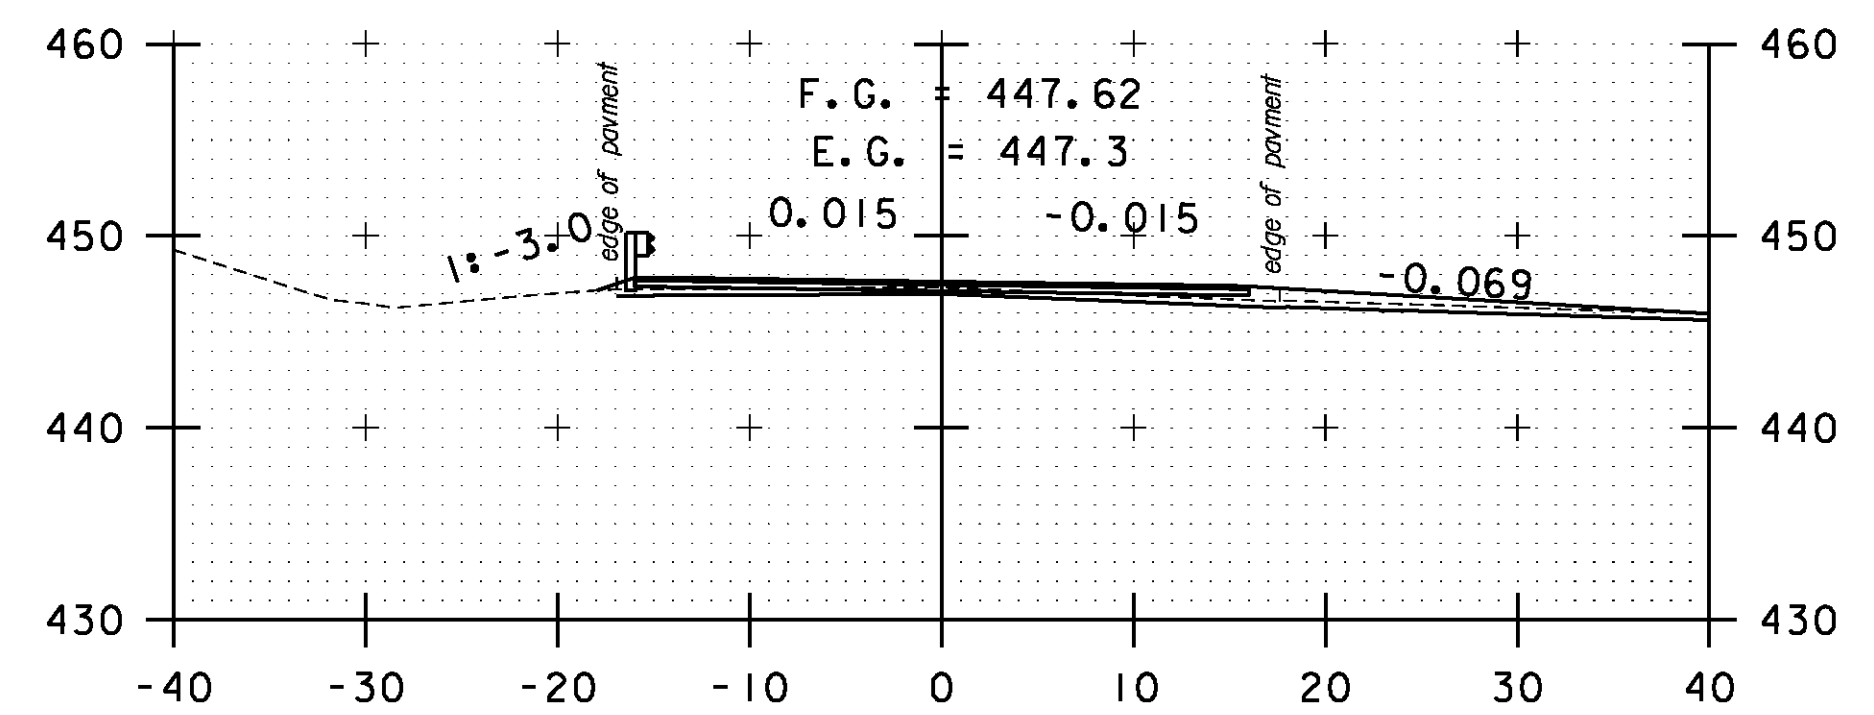


TH#43 RT  
A 60+98

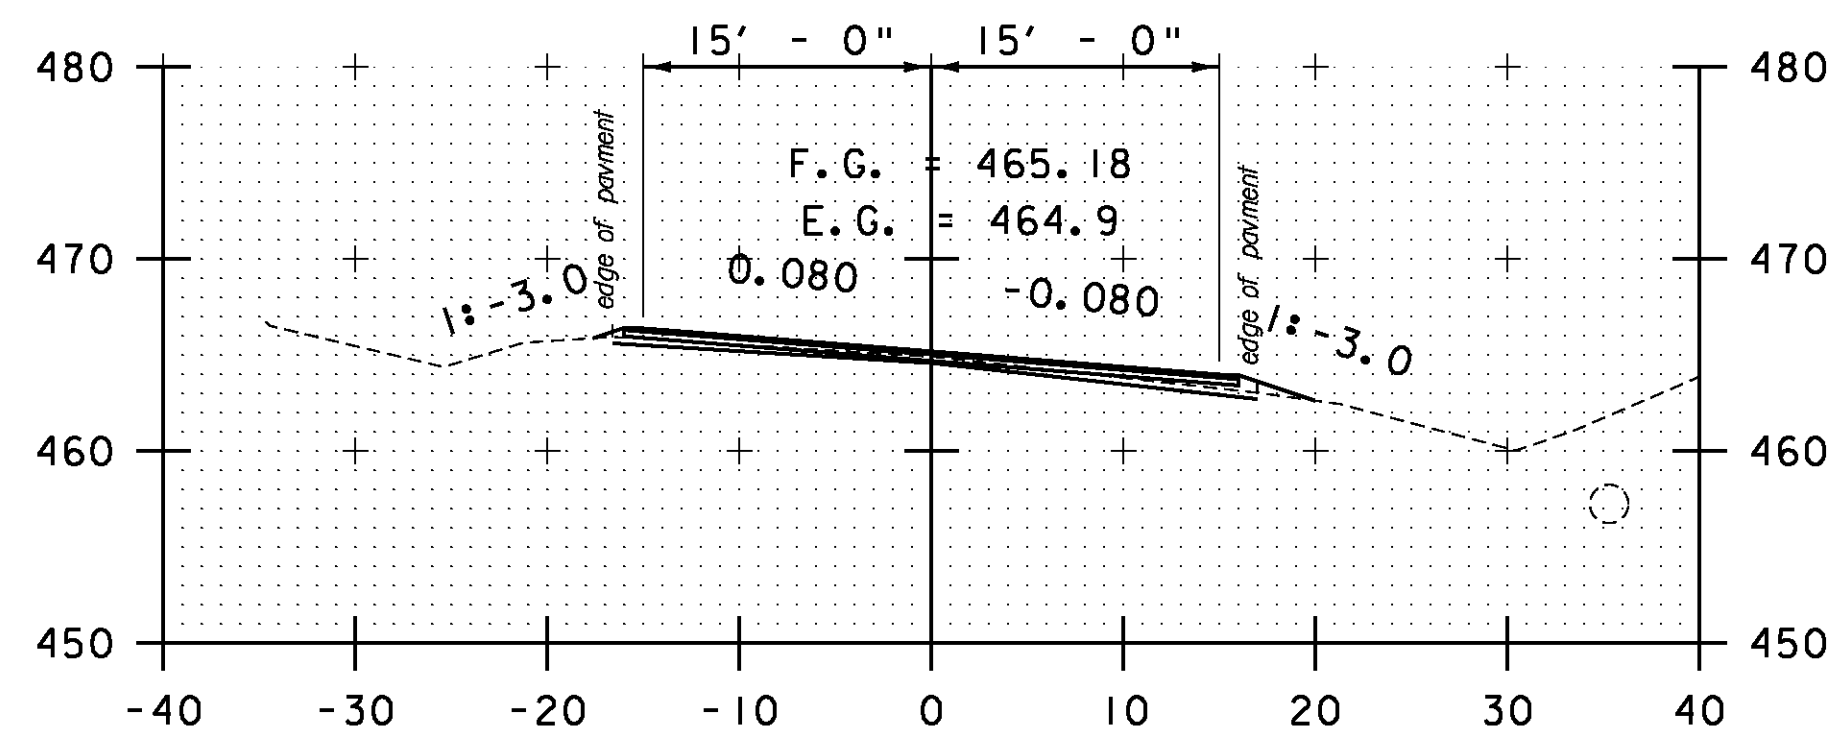

A 57+50

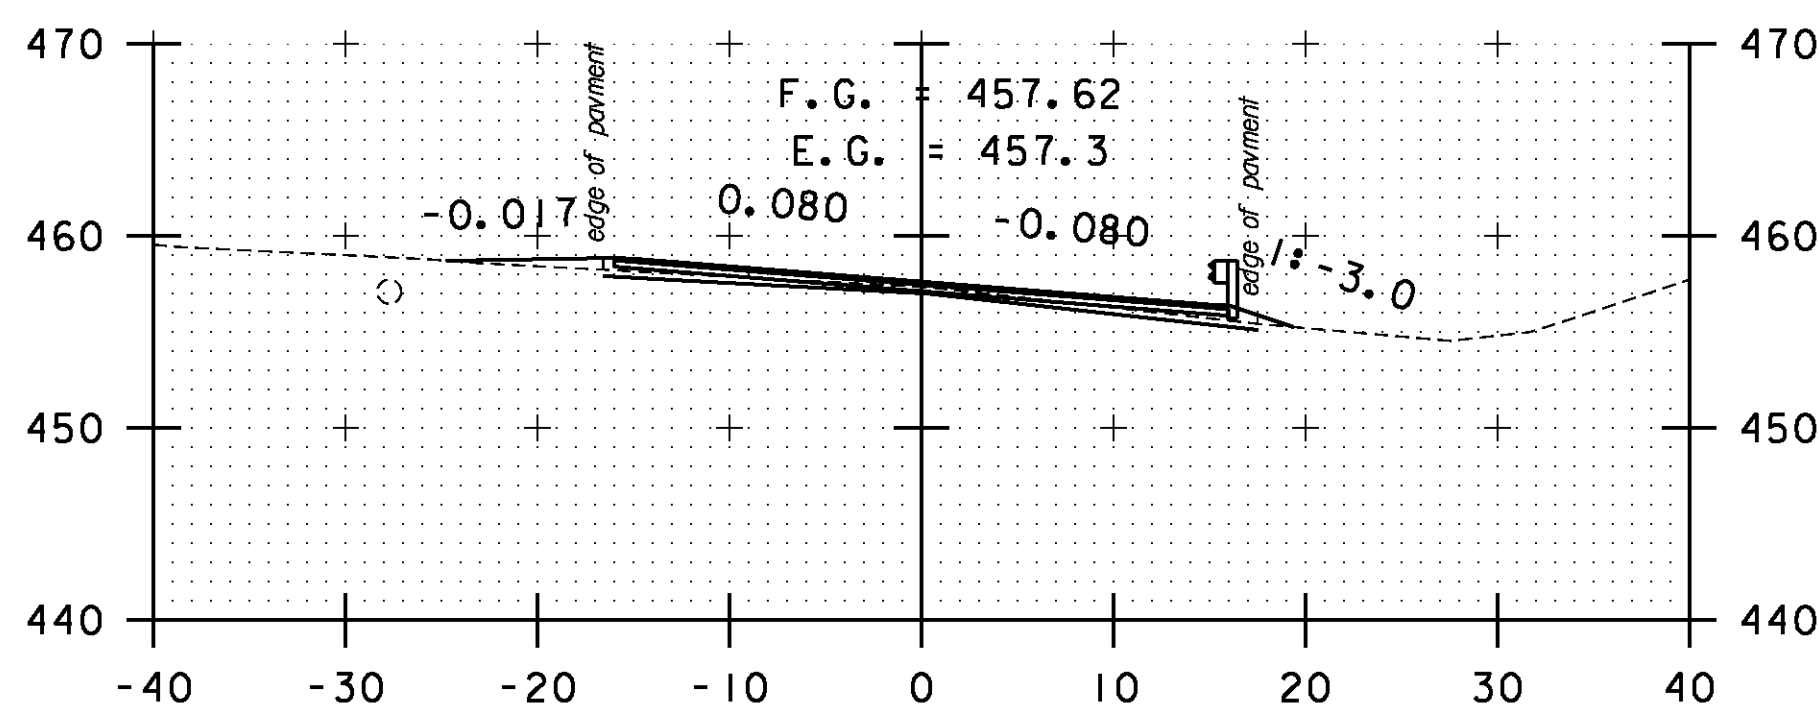

DRIVE LT  
A 59+00

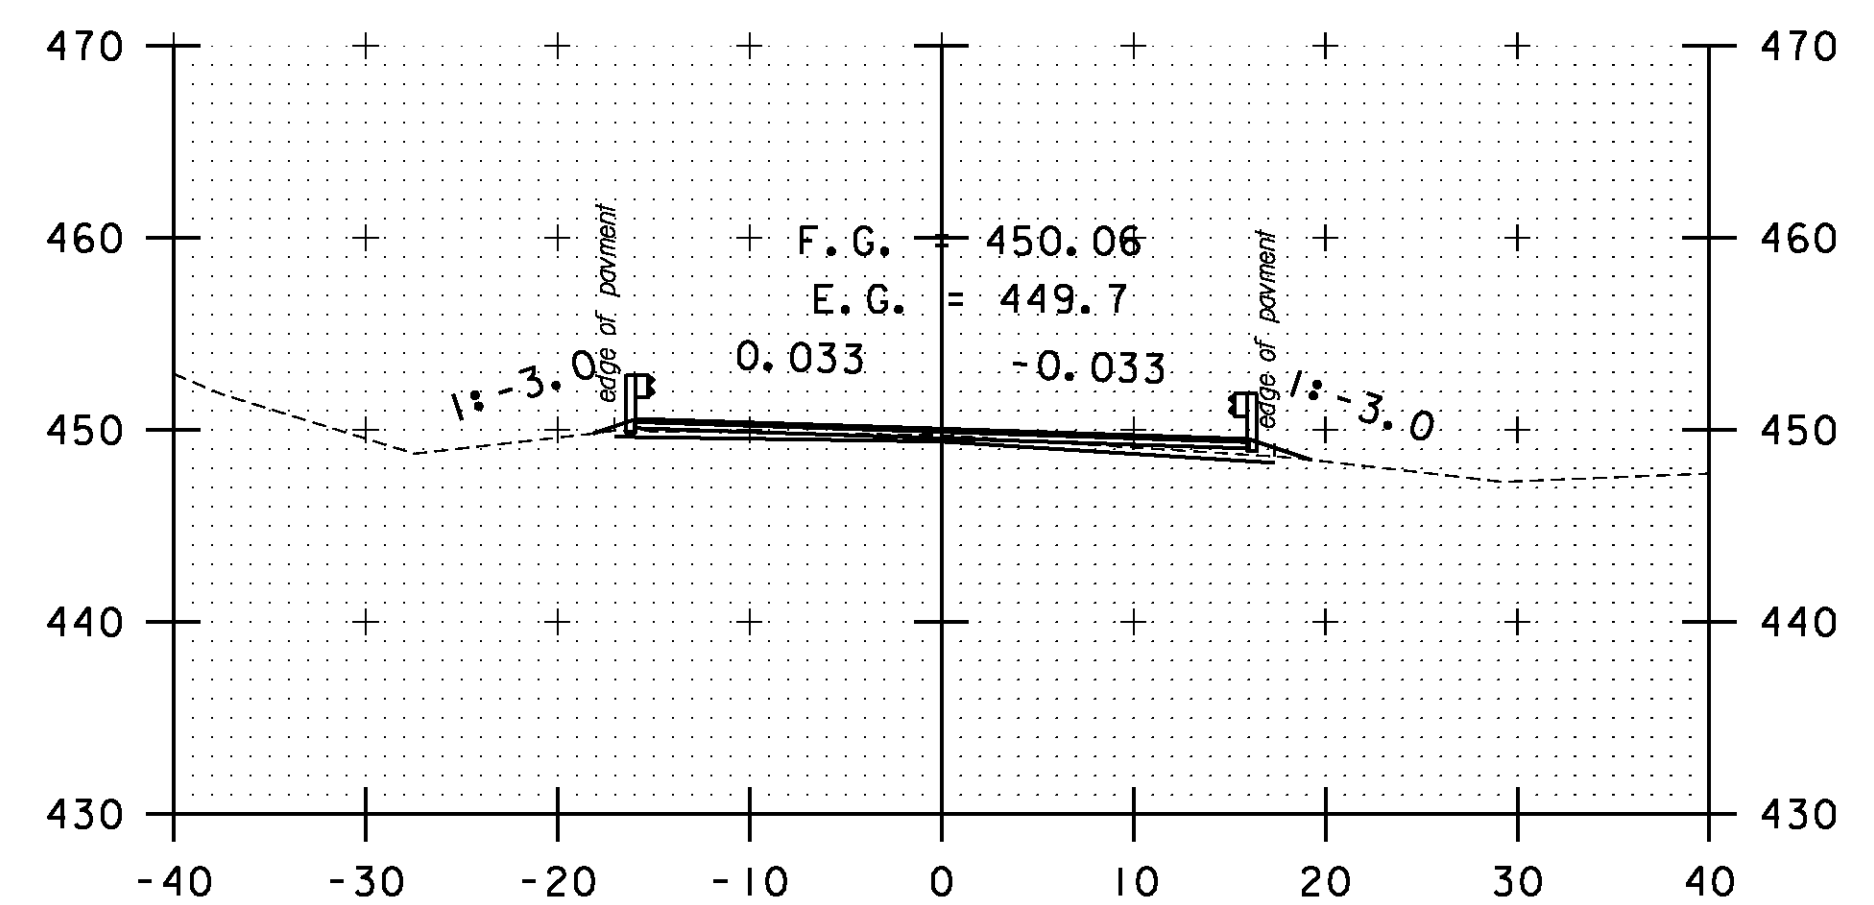

A 60+50

STA. A 57+50 TO STA. A 61+00

SCALE 1" = 10'-0"

**CROSS SECTION SHEET 60**

PROJECT NAME: BOLTON-WATERBURY

PROJECT NUMBER: STP 2709(I)

FILE NAME: p07C172.dgn

PROJECT LEADER: CDL

DESIGNED BY: BMB

PLOT FILE: p07C172.186.1

PLOT DATE: 4/16/2013

DRAWN BY: BMB

CHECKED BY: CDL

SHEET 186 OF 217