




A 62+50

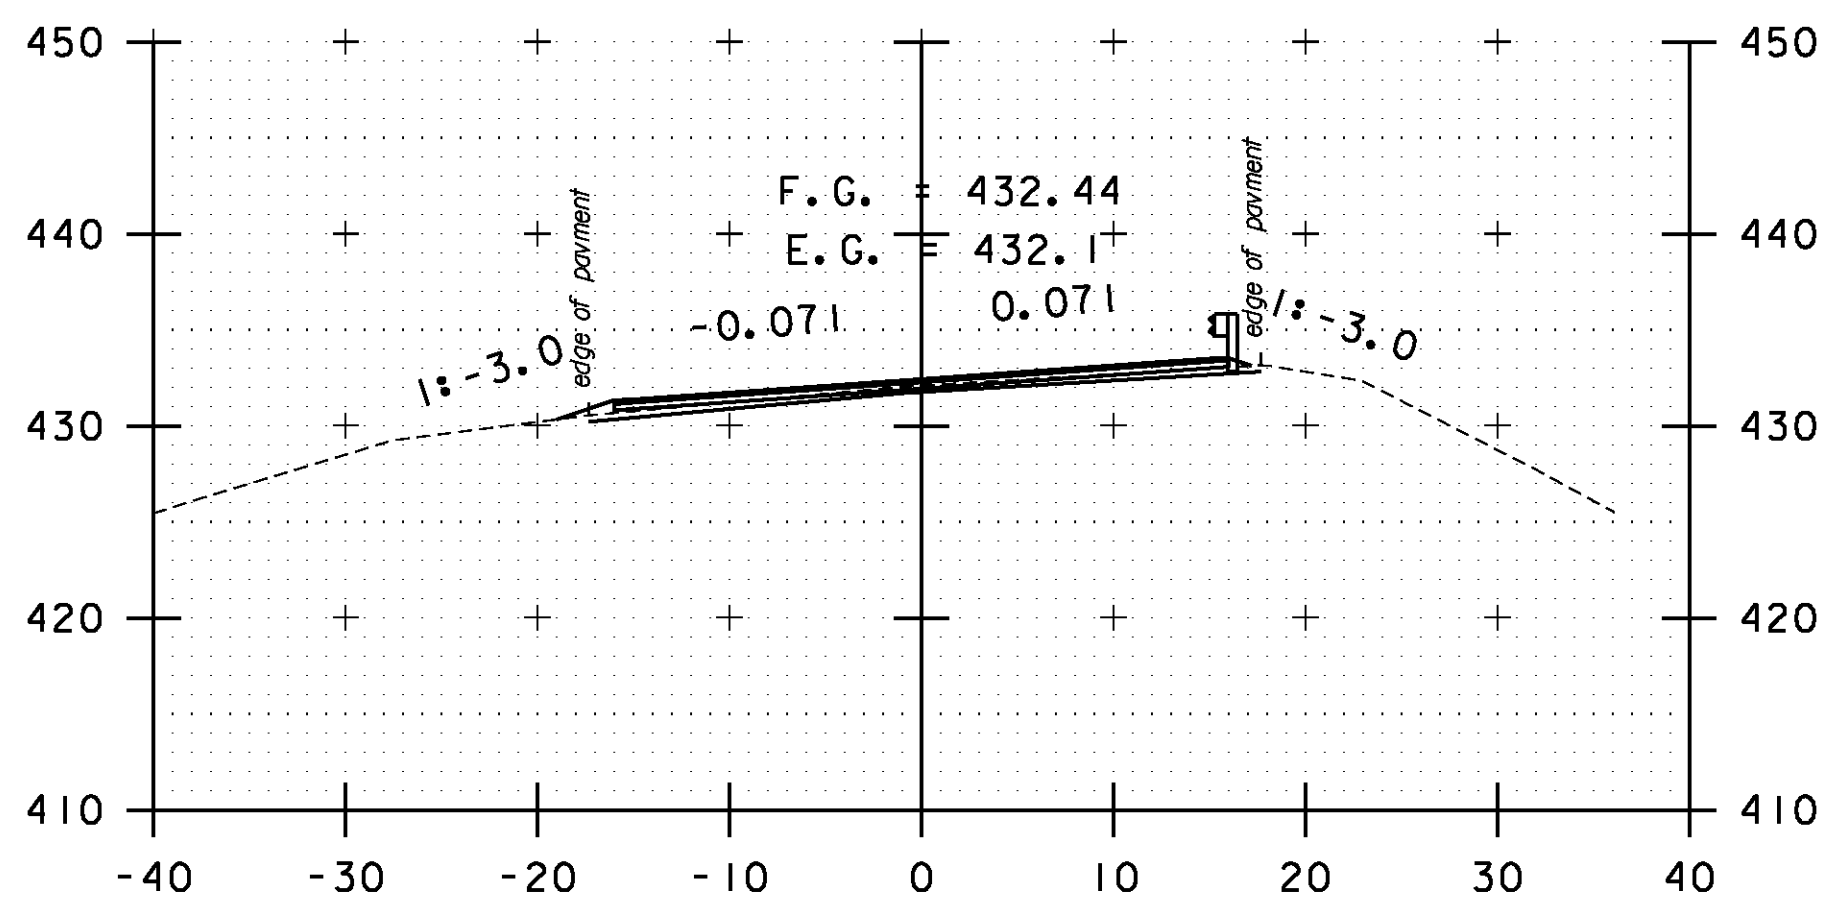


A 64+00

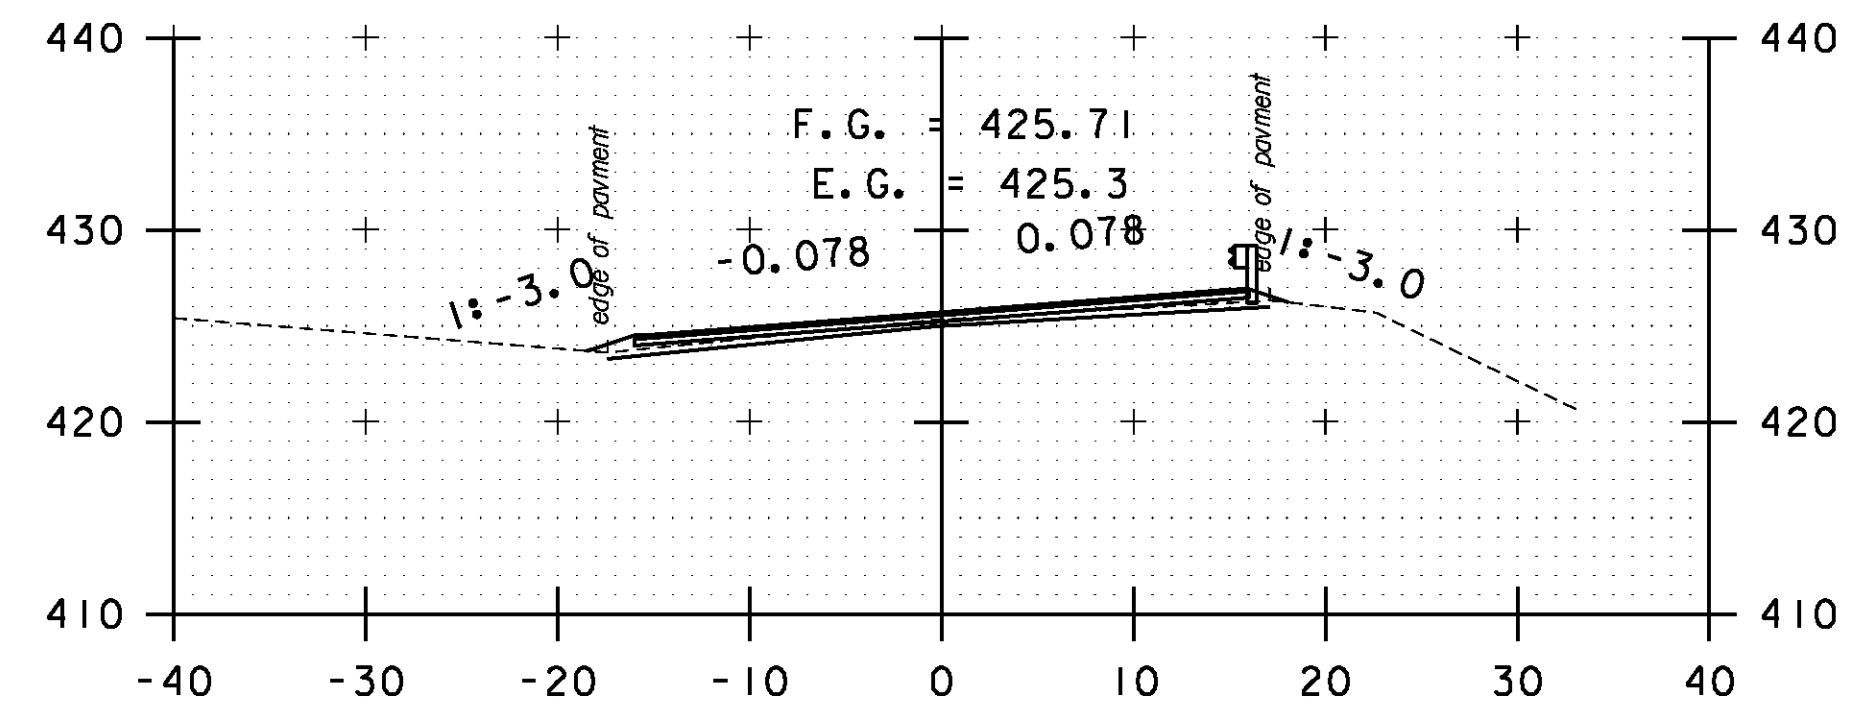


A 65+50

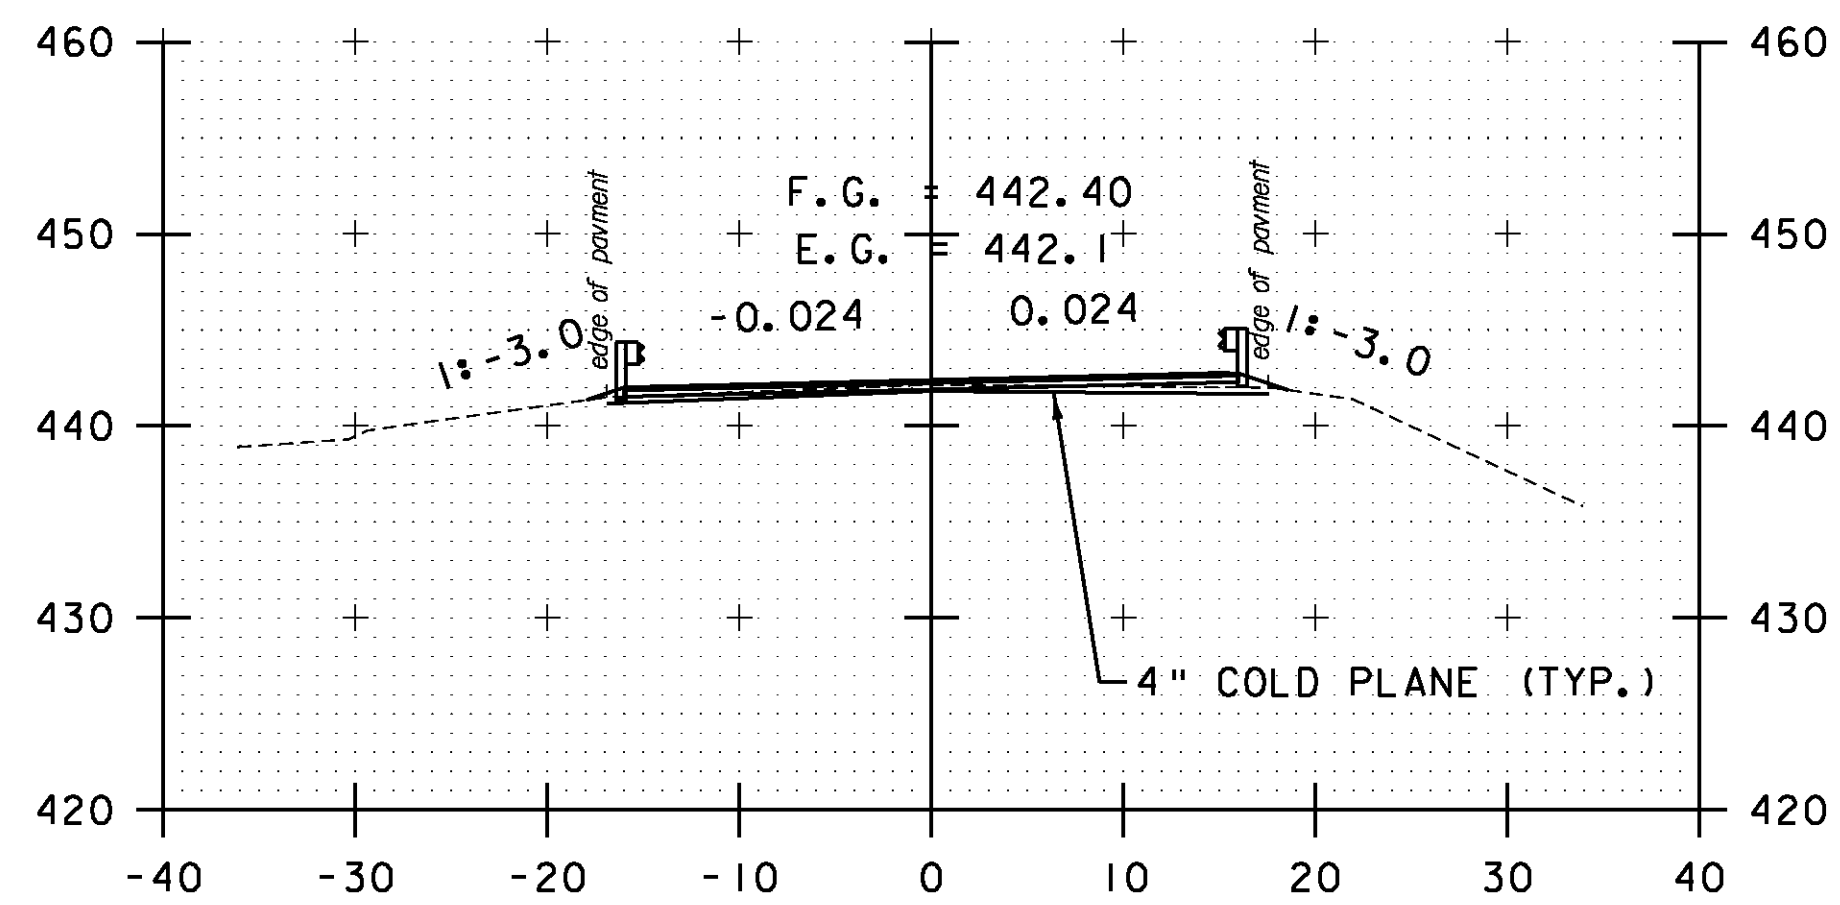


A 62+00

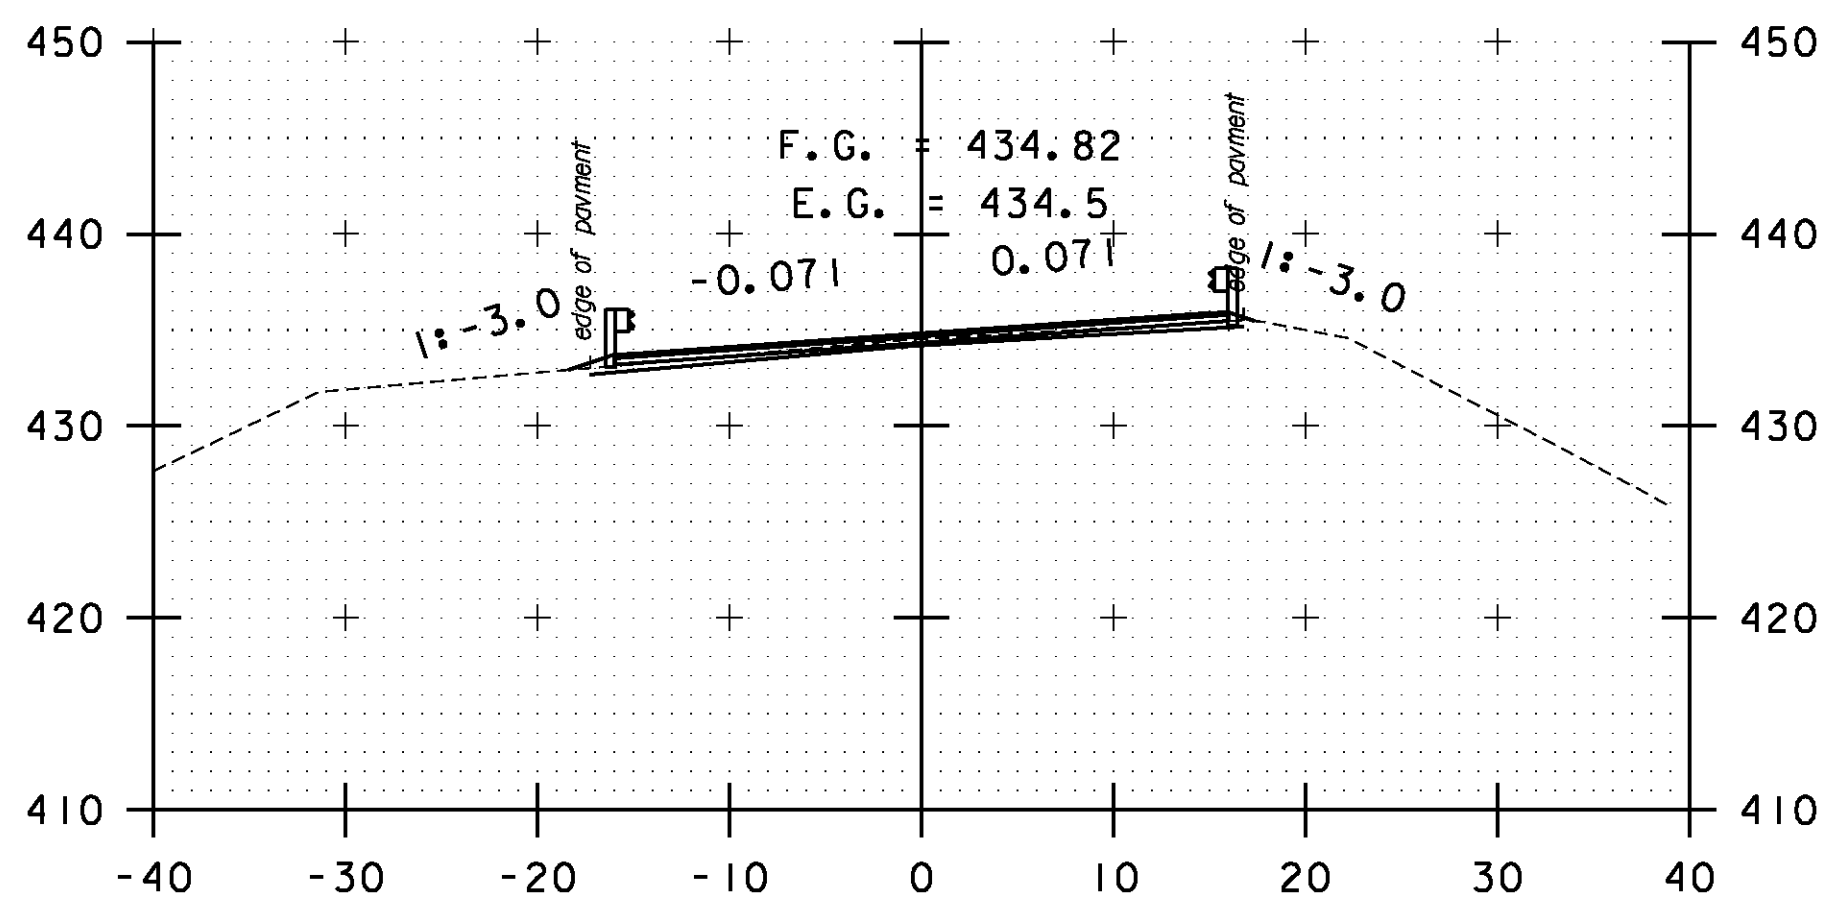


A 63+50

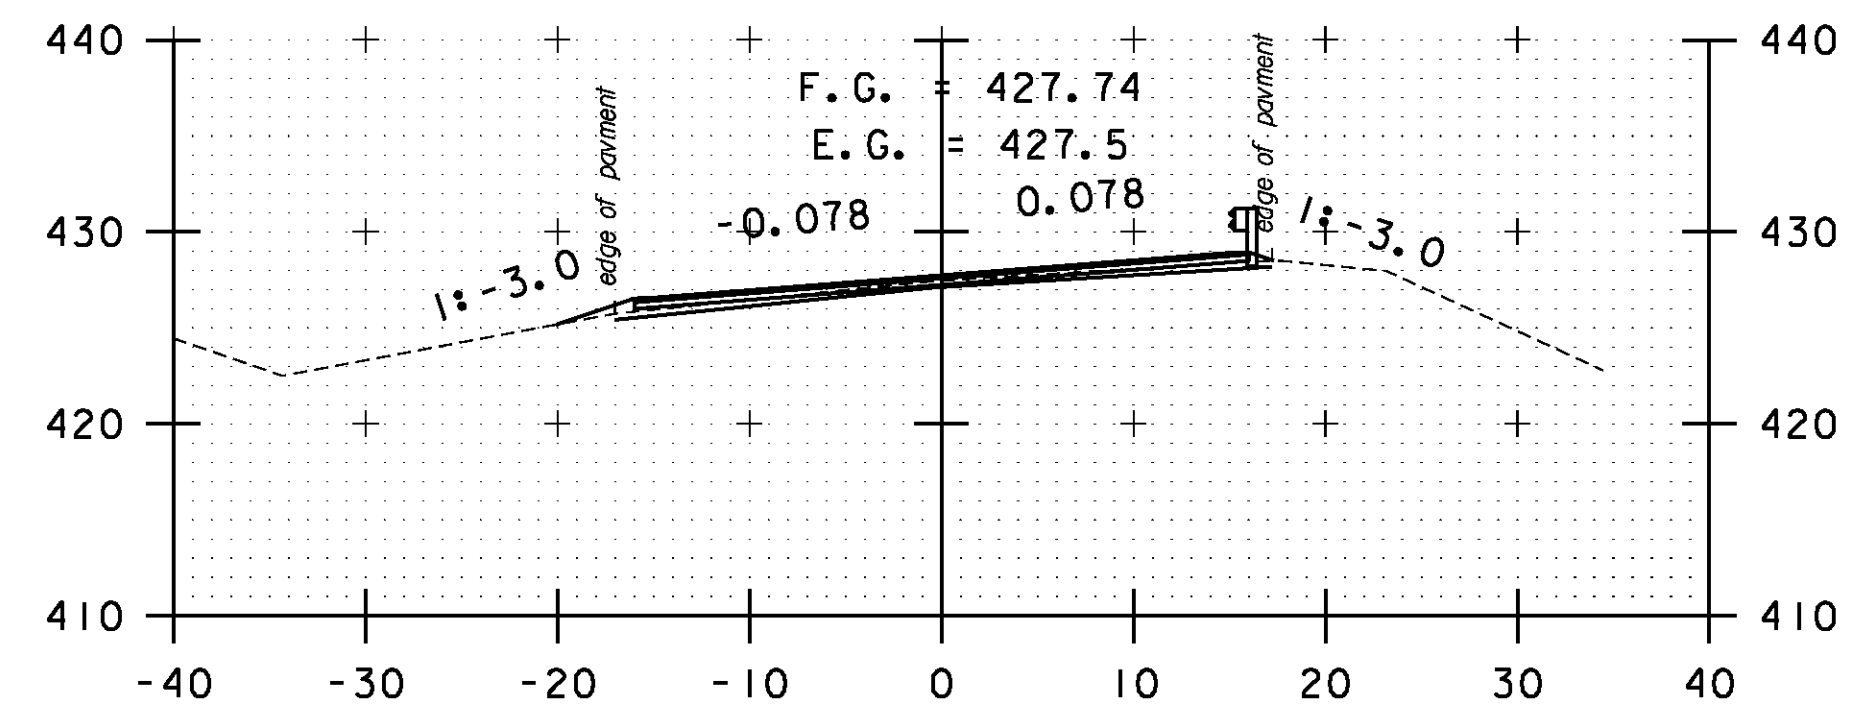


A 65+00

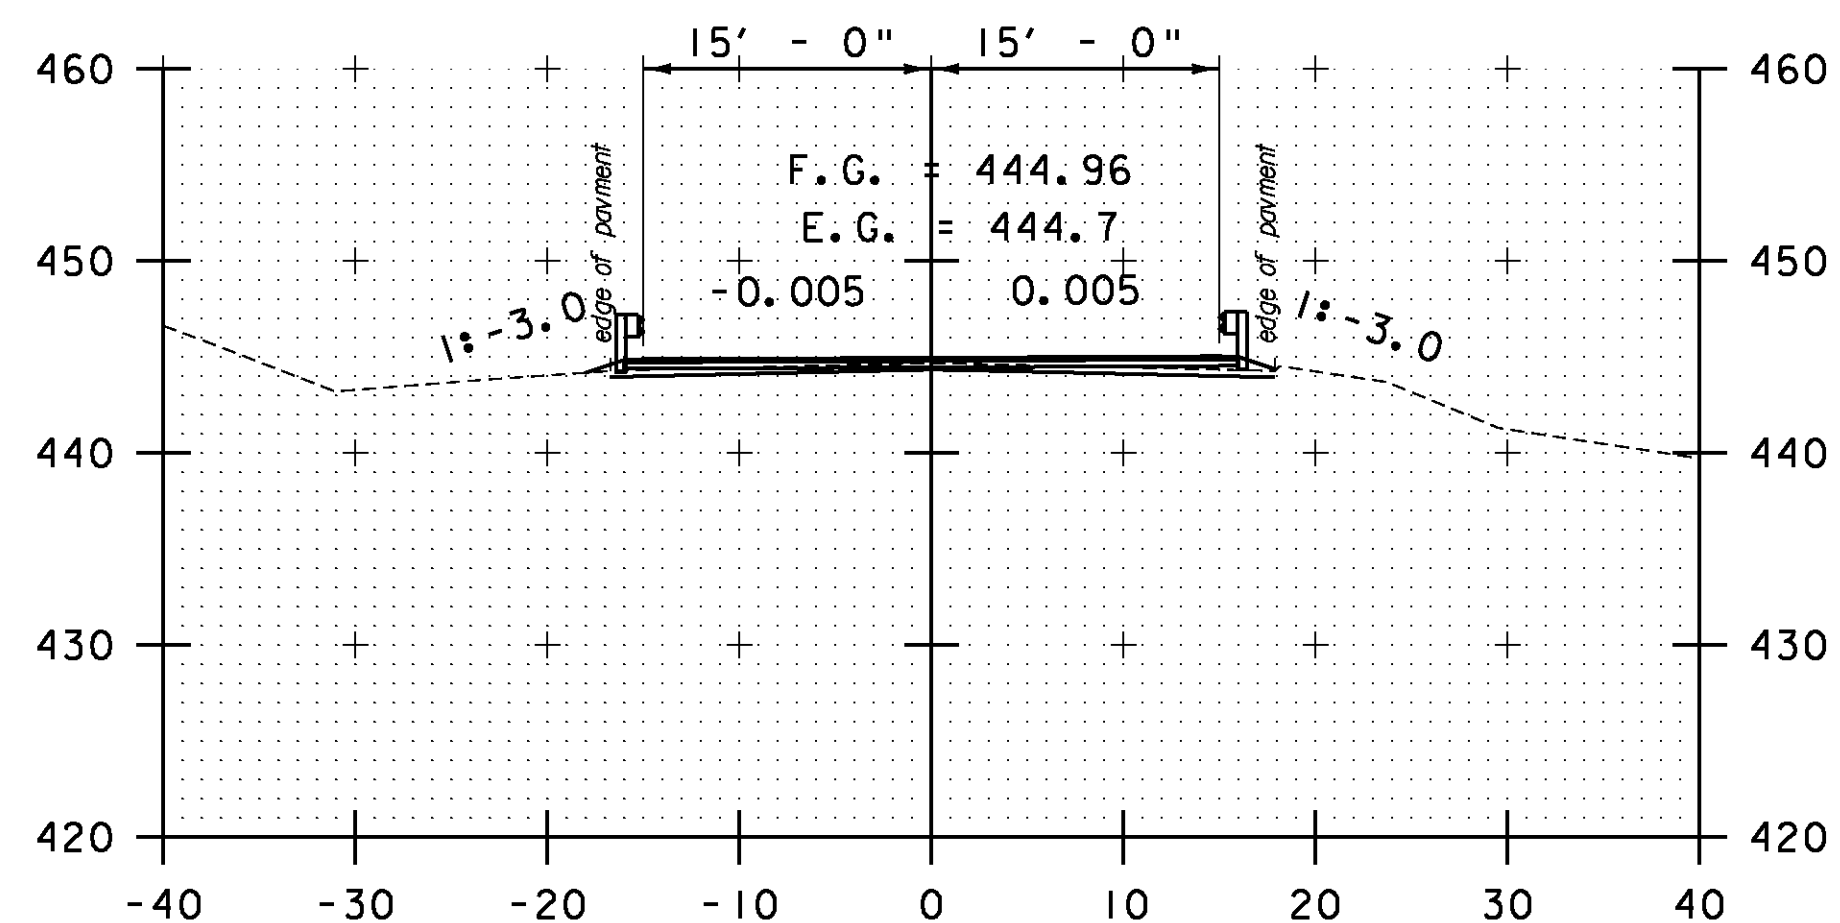

A 61+50

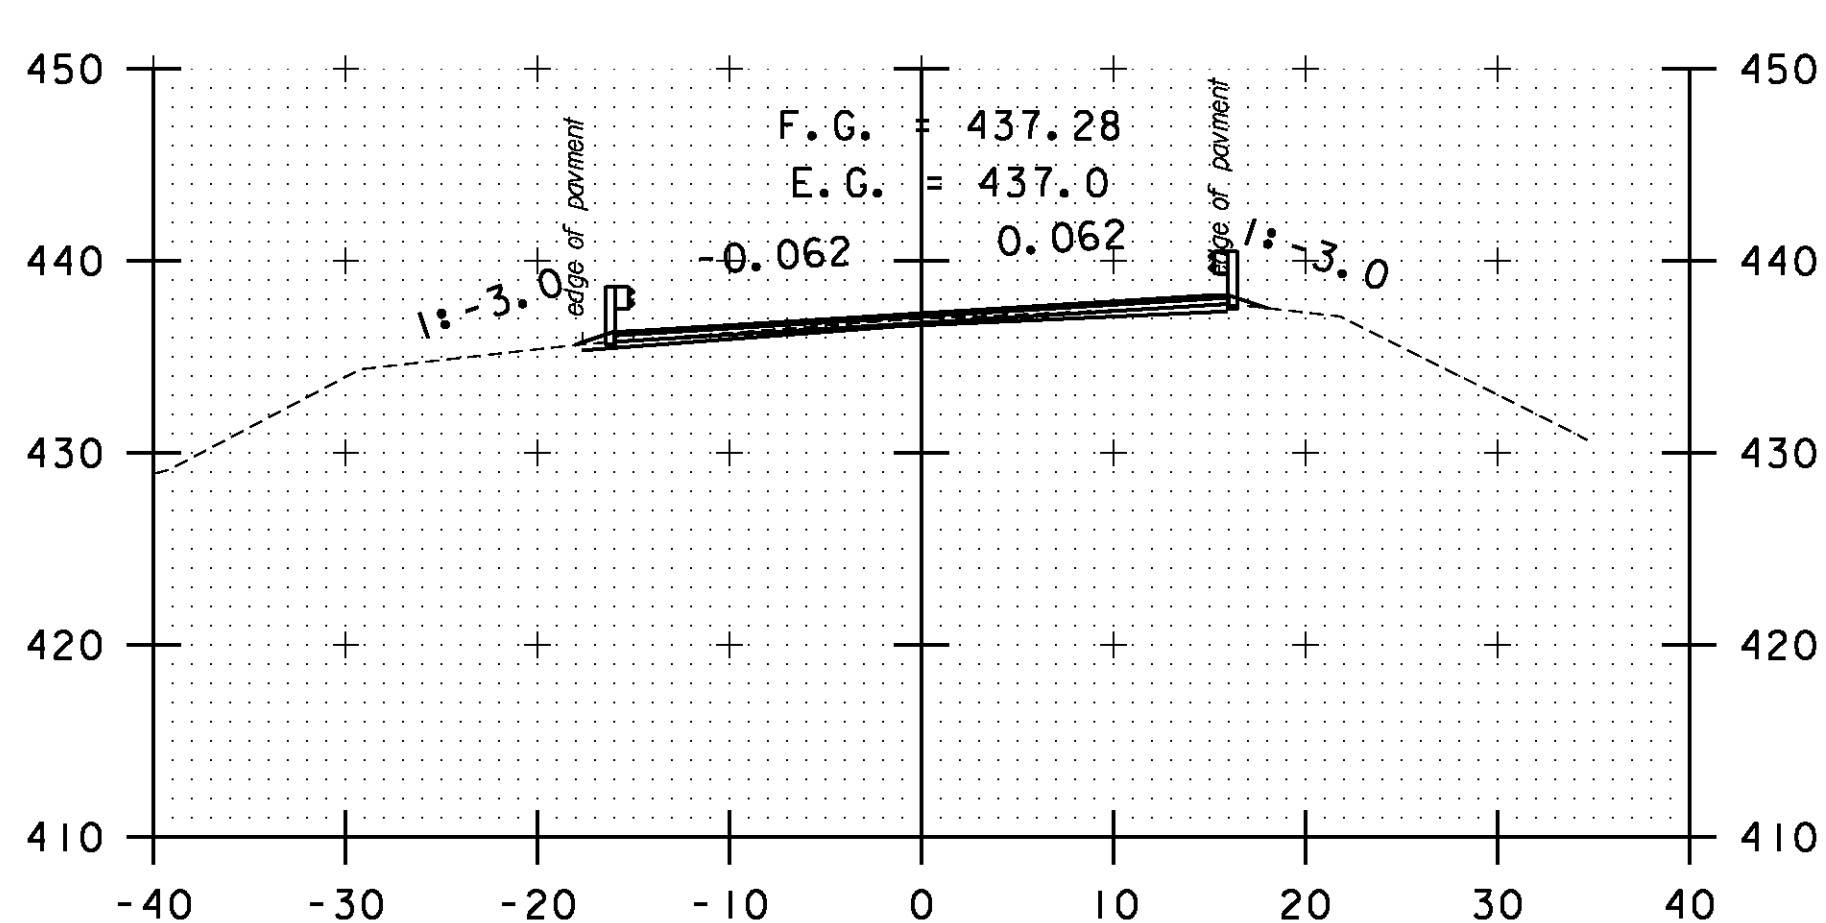


A 63+00

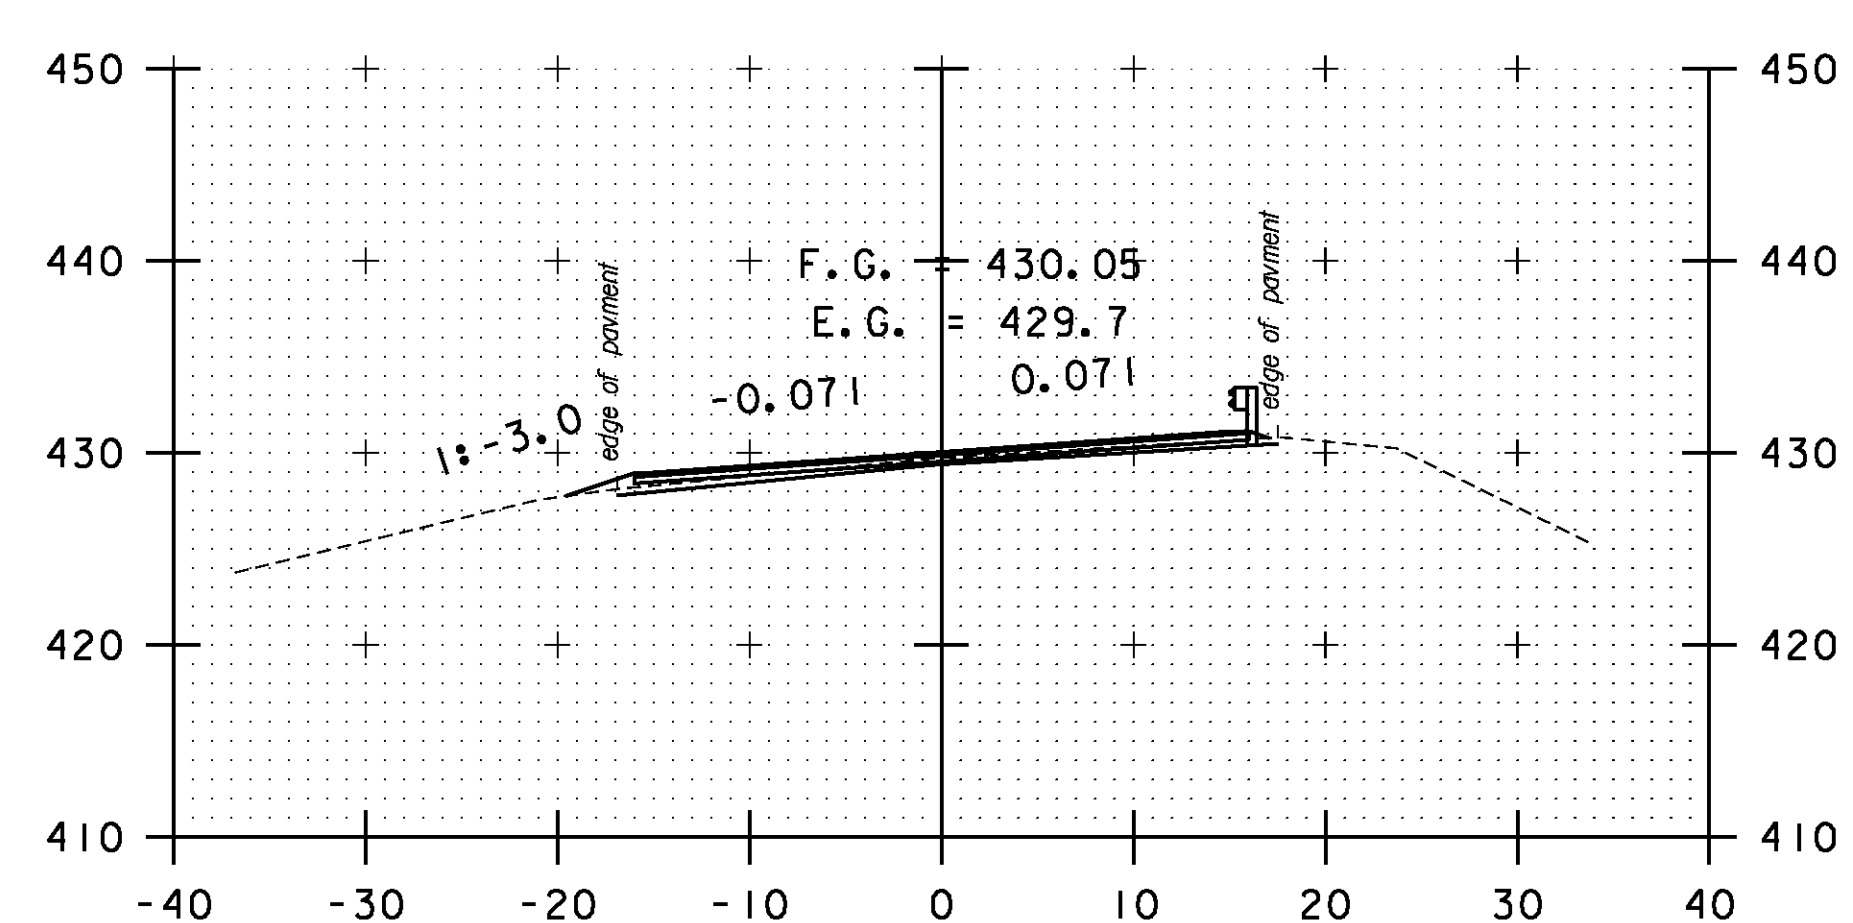

A 64+50

STA. A 61+50 TO STA. A 65+50

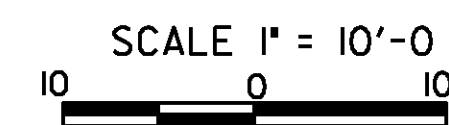

**CROSS SECTION SHEET 61**

PROJECT NAME: BOLTON-WATERBURY  
PROJECT NUMBER: STP 2709(I)

FILE NAME: p07C172.dgn  
PROJECT LEADER: CDL  
DESIGNED BY: BMB  
PLOT FILE: p07C172\_187.1

PLOT DATE: 4/16/2013  
DRAWN BY: BMB  
CHECKED BY: CDL  
SHEET 187 OF 217