




A 76+00

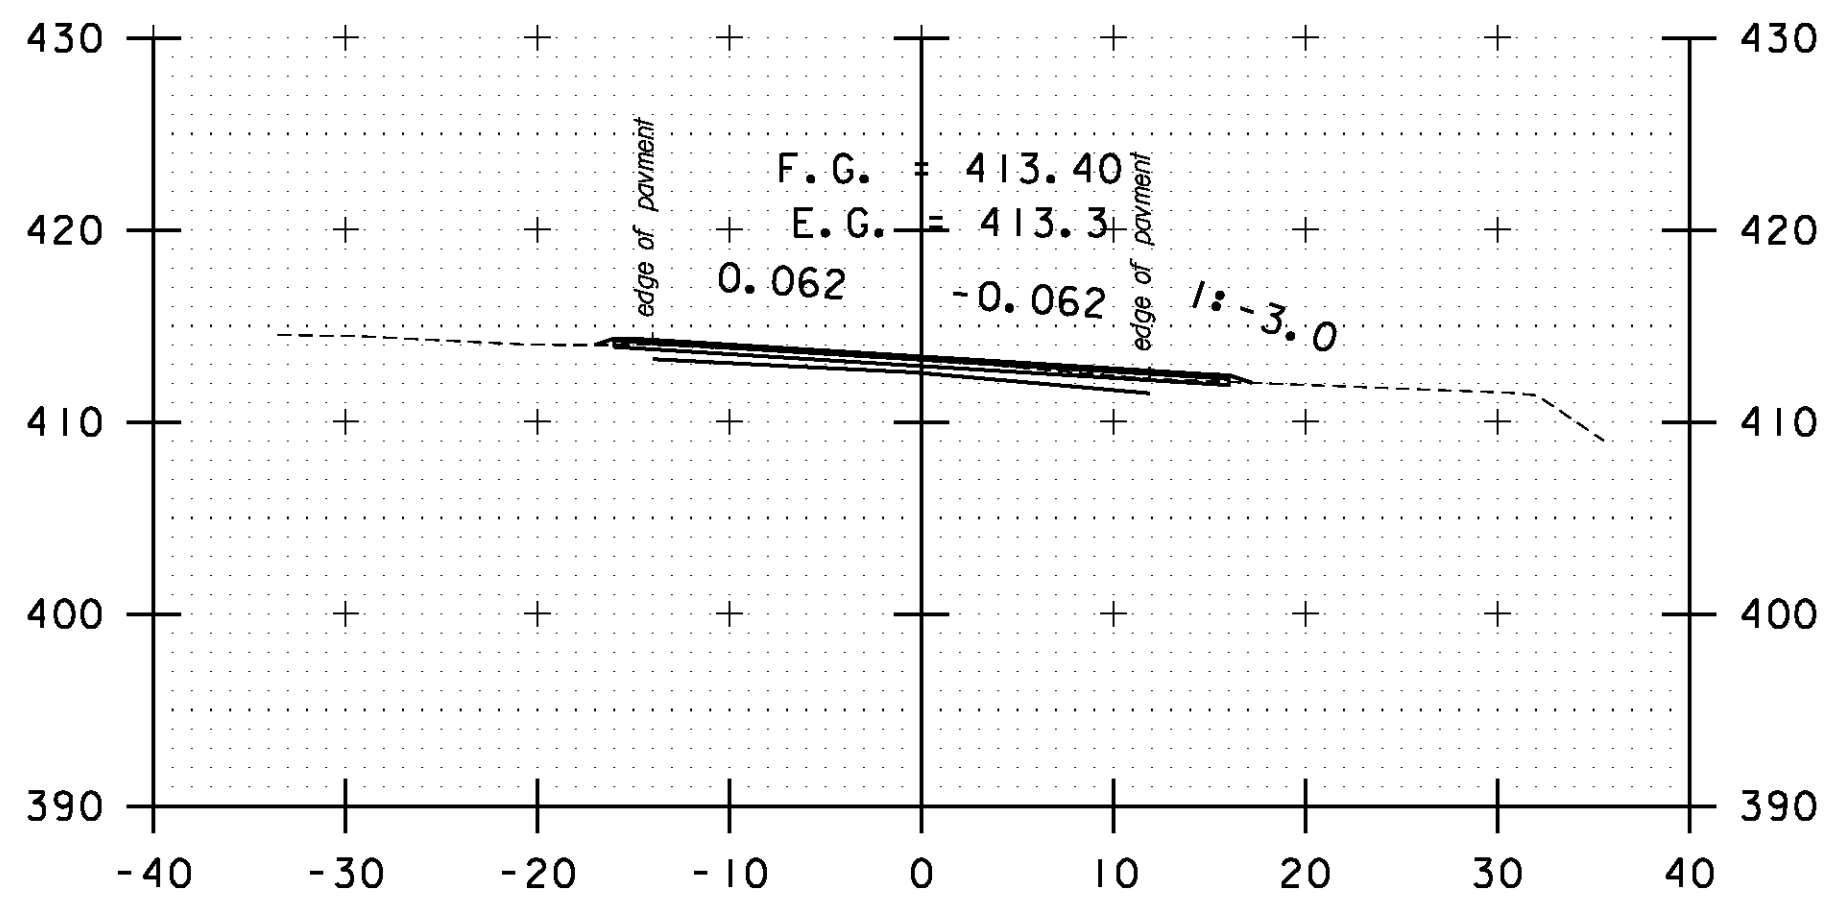


A 77+50

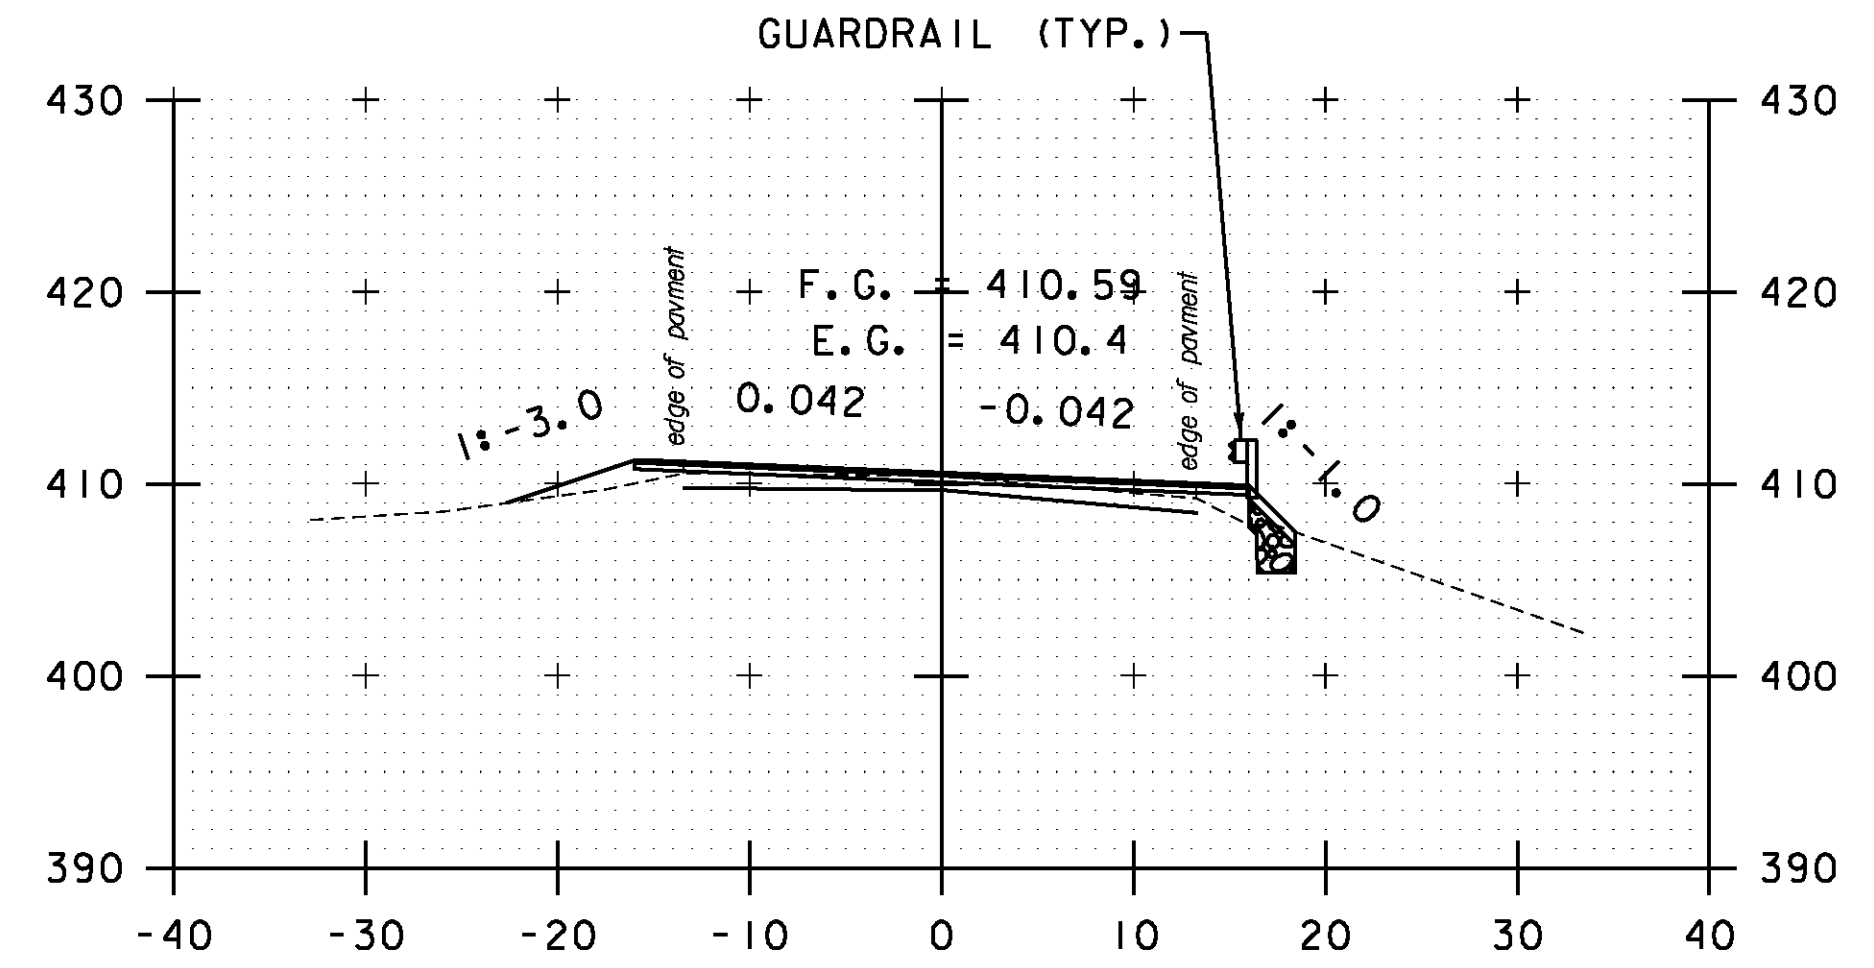


A 79+00

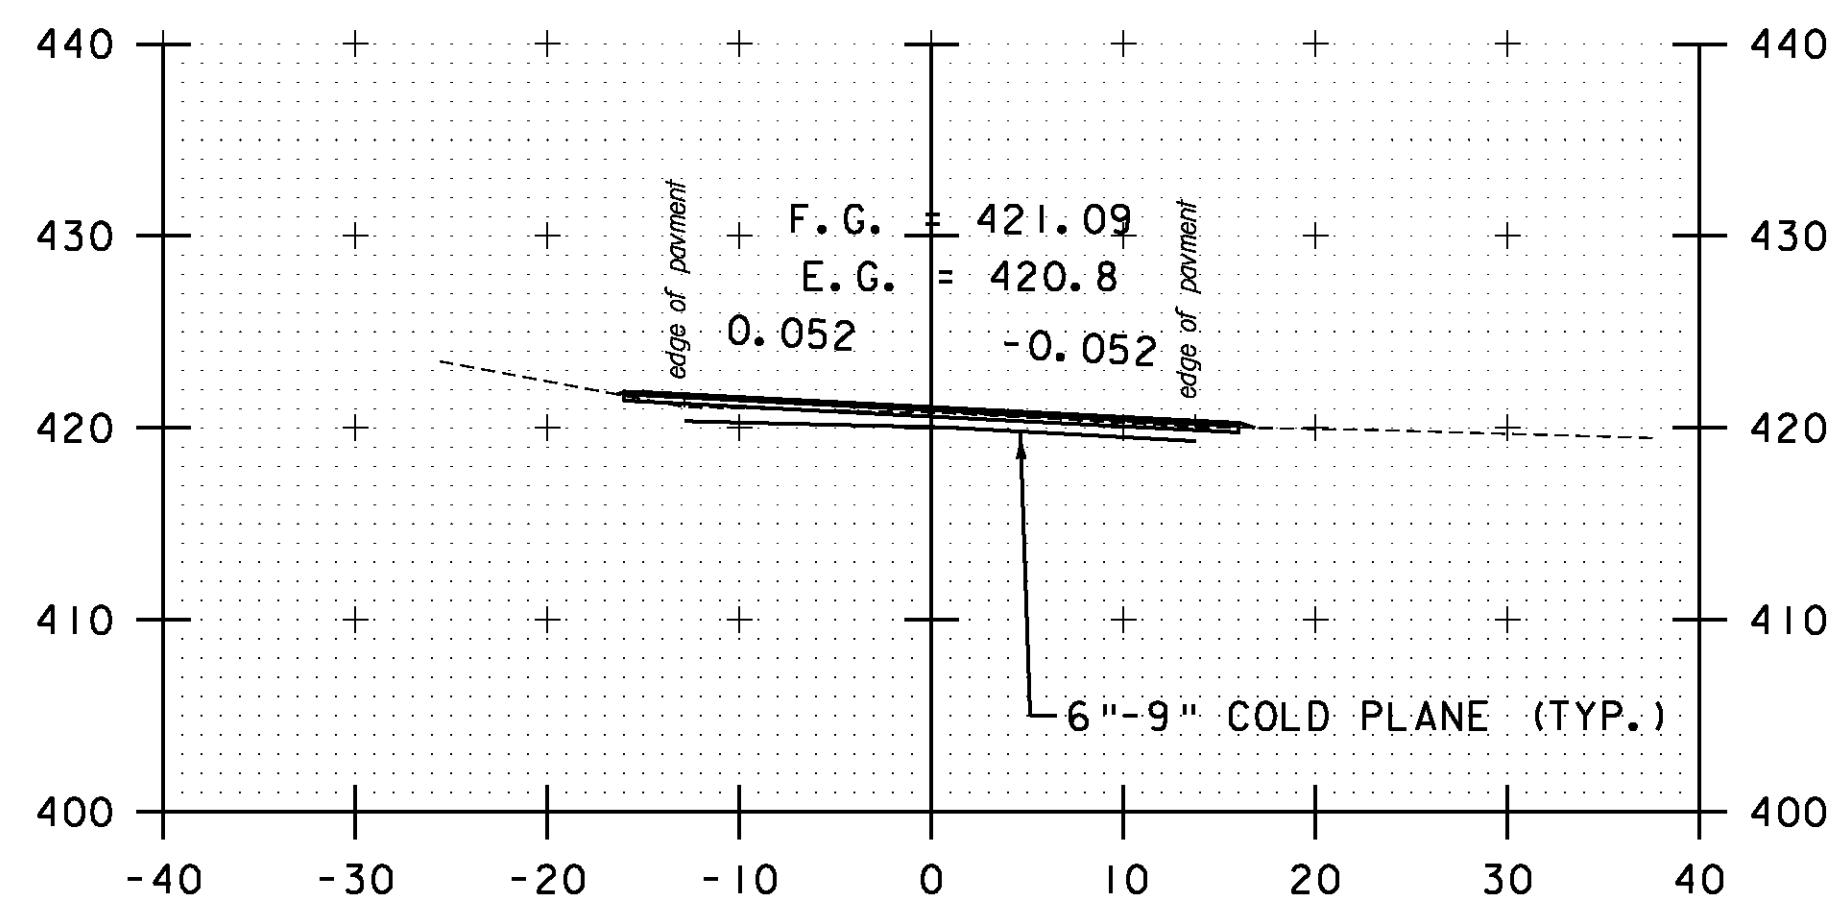


A 75+50

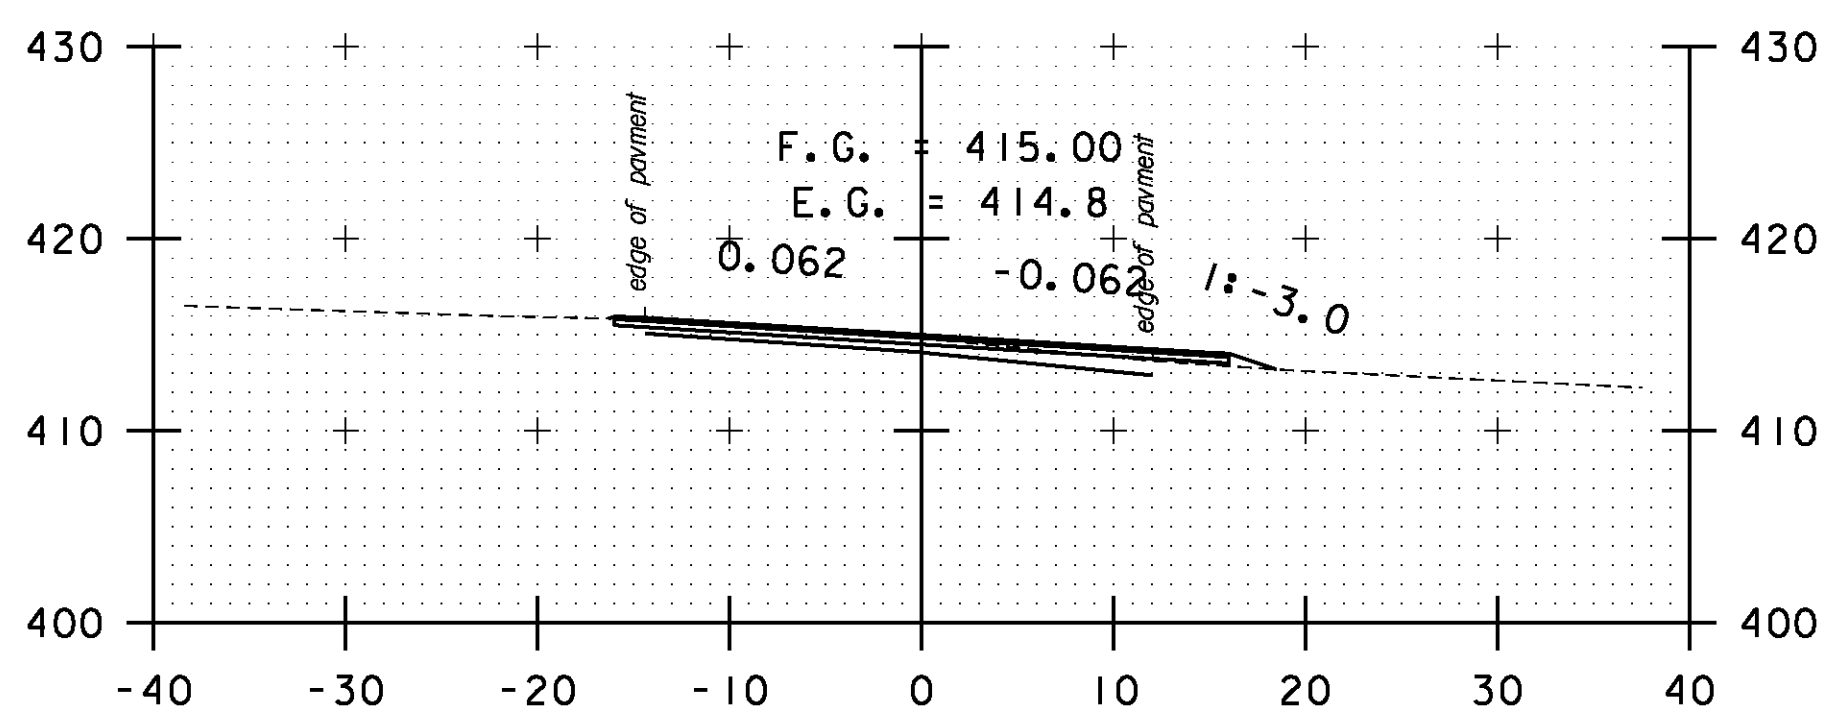


A 77+00

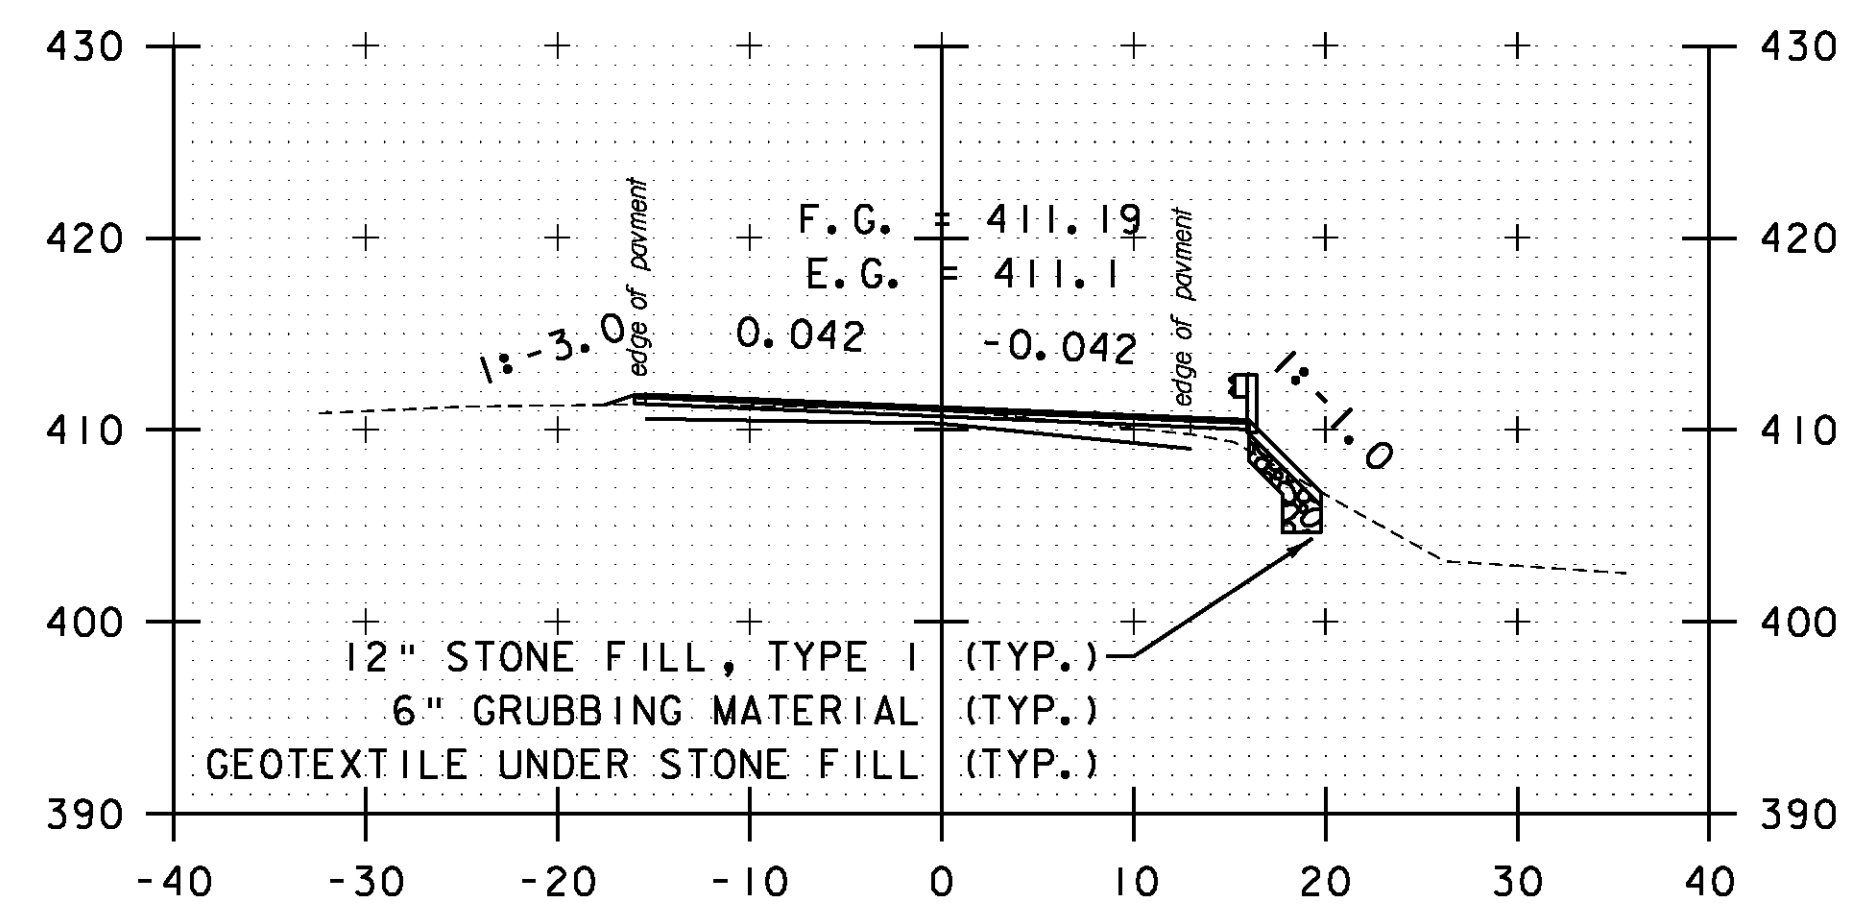


A 78+50

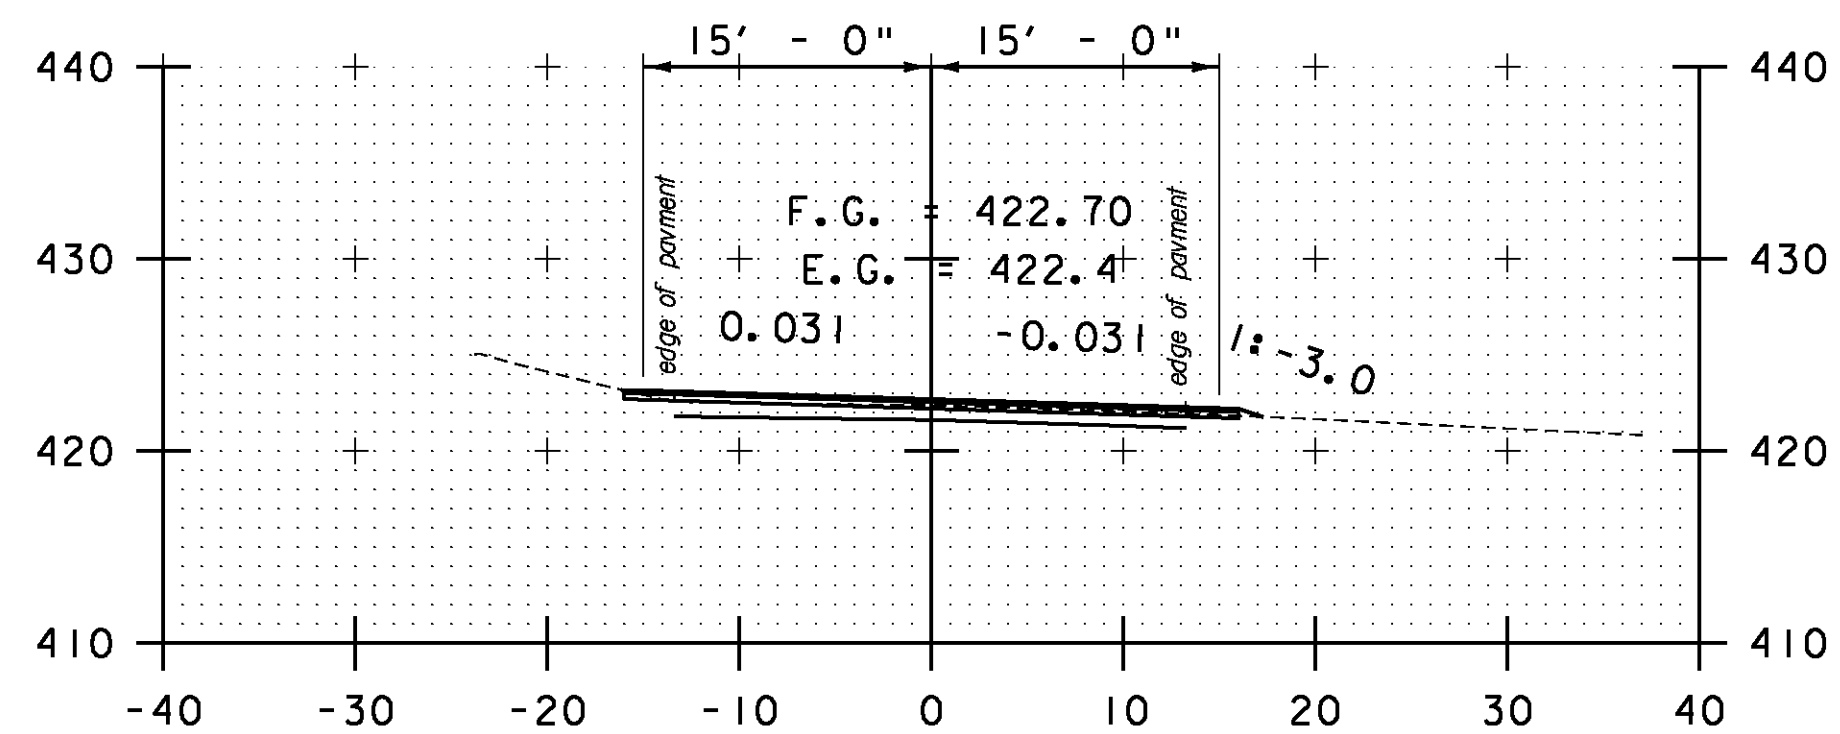

A 75+00

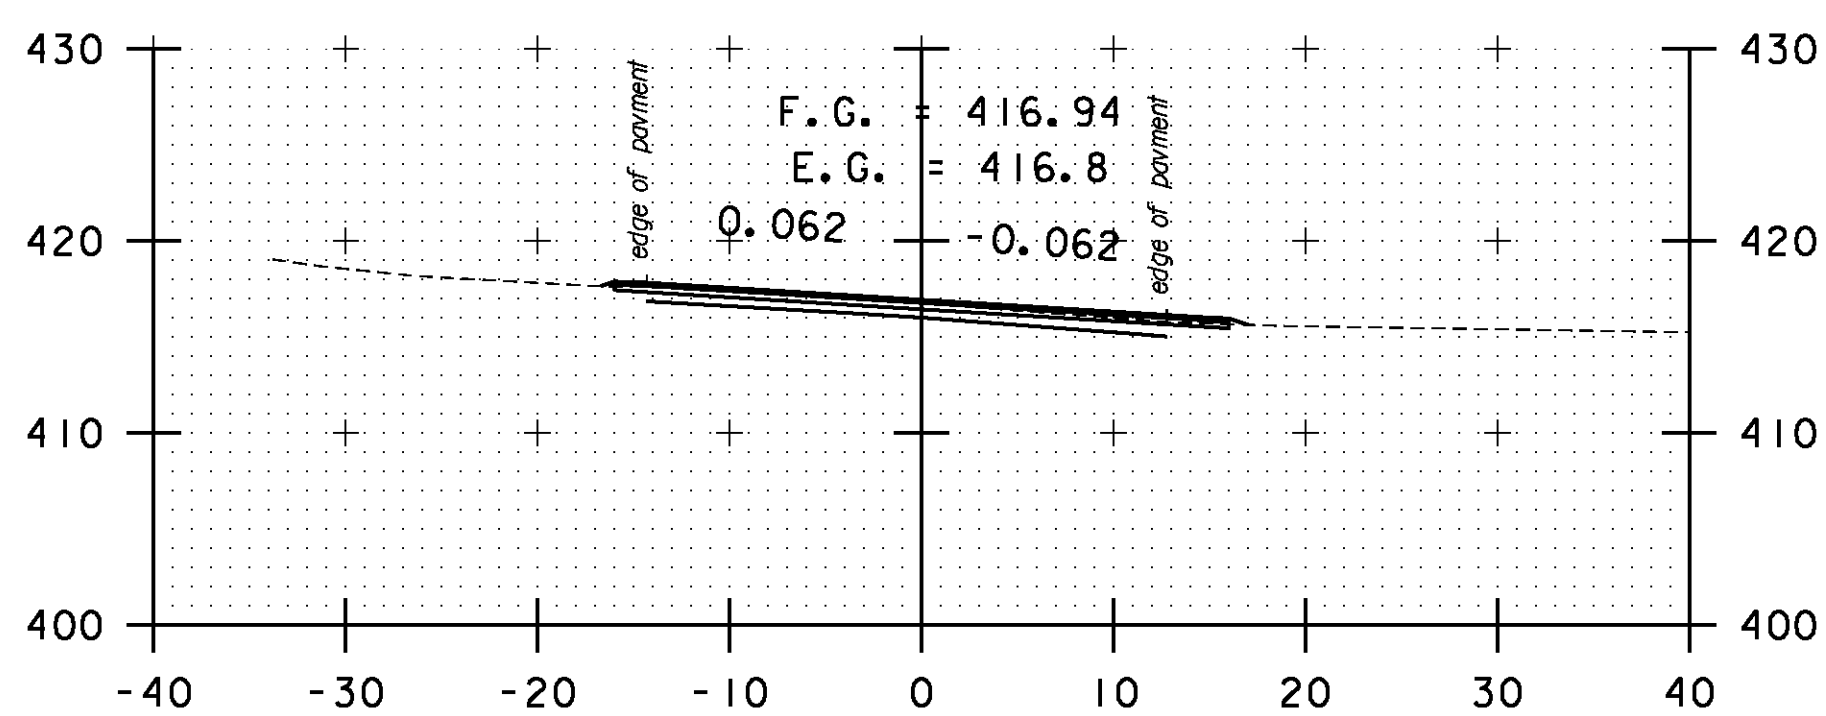

A 76+50

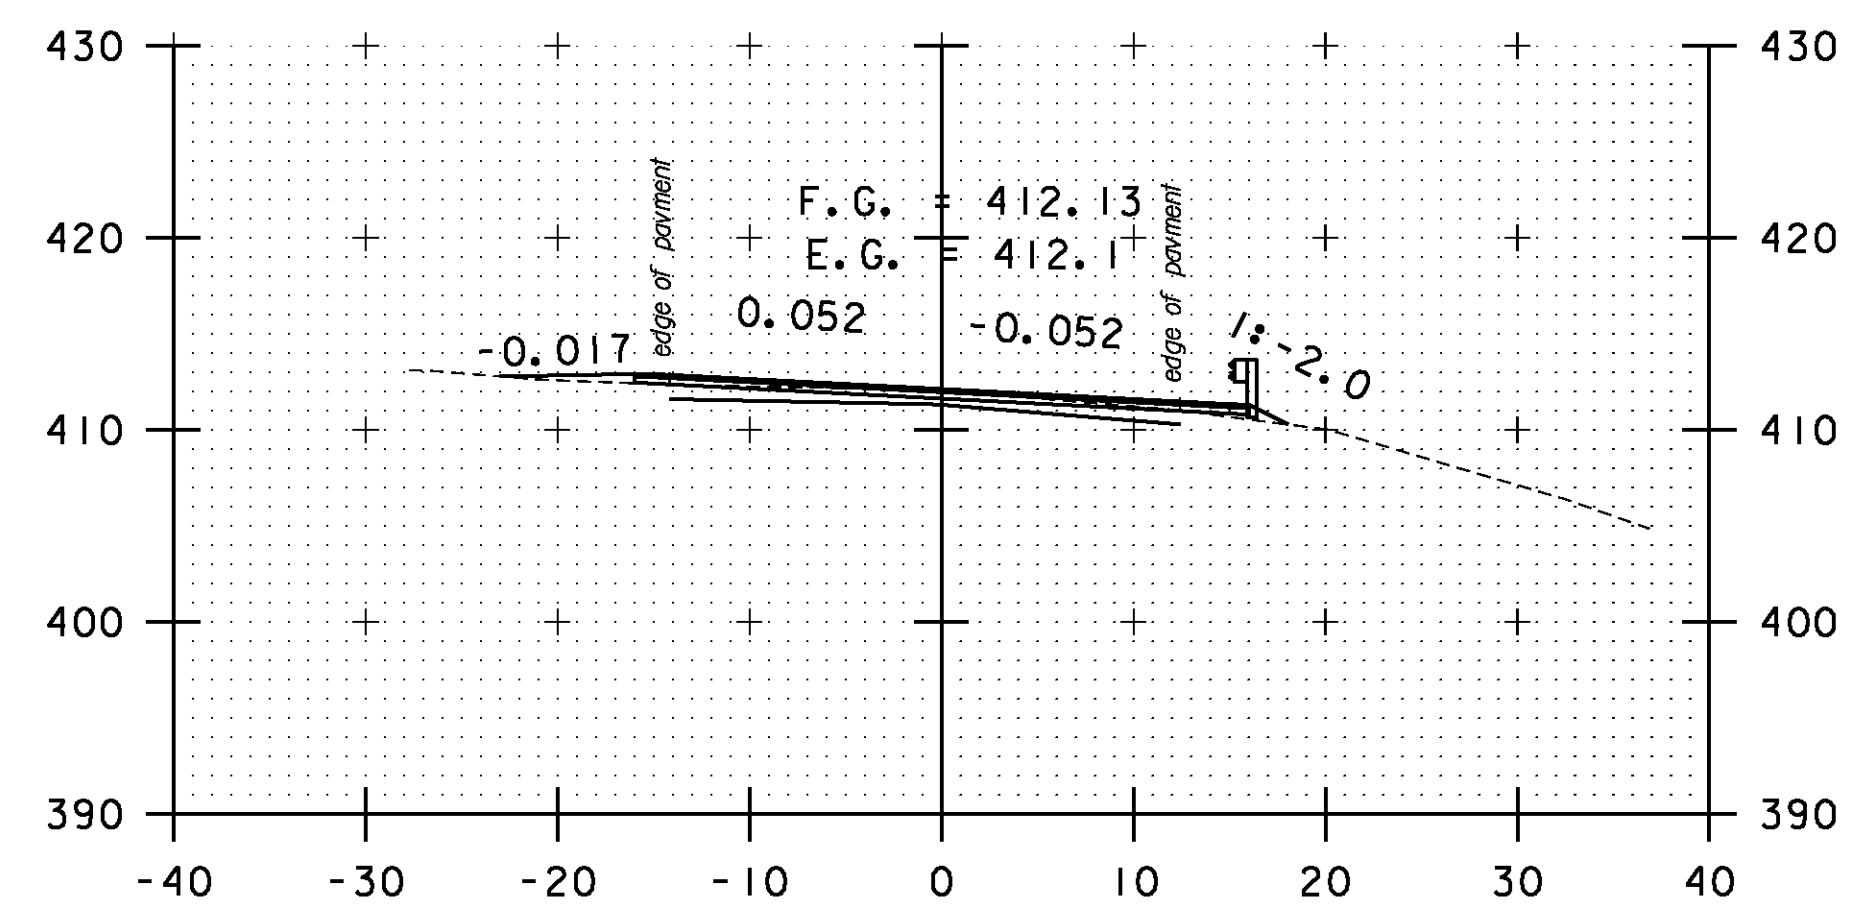

DRIVE LT
A 78+00

STA. A 75+00 TO STA. A 79+00

SCALE 1" = 10'-0"

CROSS SECTION SHEET 64

PROJECT NAME: BOLTON-WATERBURY

PROJECT NUMBER: STP 2709(1)

FILE NAME: p07C172.dgn

PROJECT LEADER: CDL

DESIGNED BY: BMB

PLOT FILE: p07C172.190.1

PLOT DATE: 4/16/2013

DRAWN BY: BMB

CHECKED BY: CDL

SHEET 190 OF 217