




DRIVE RT
A 85+00

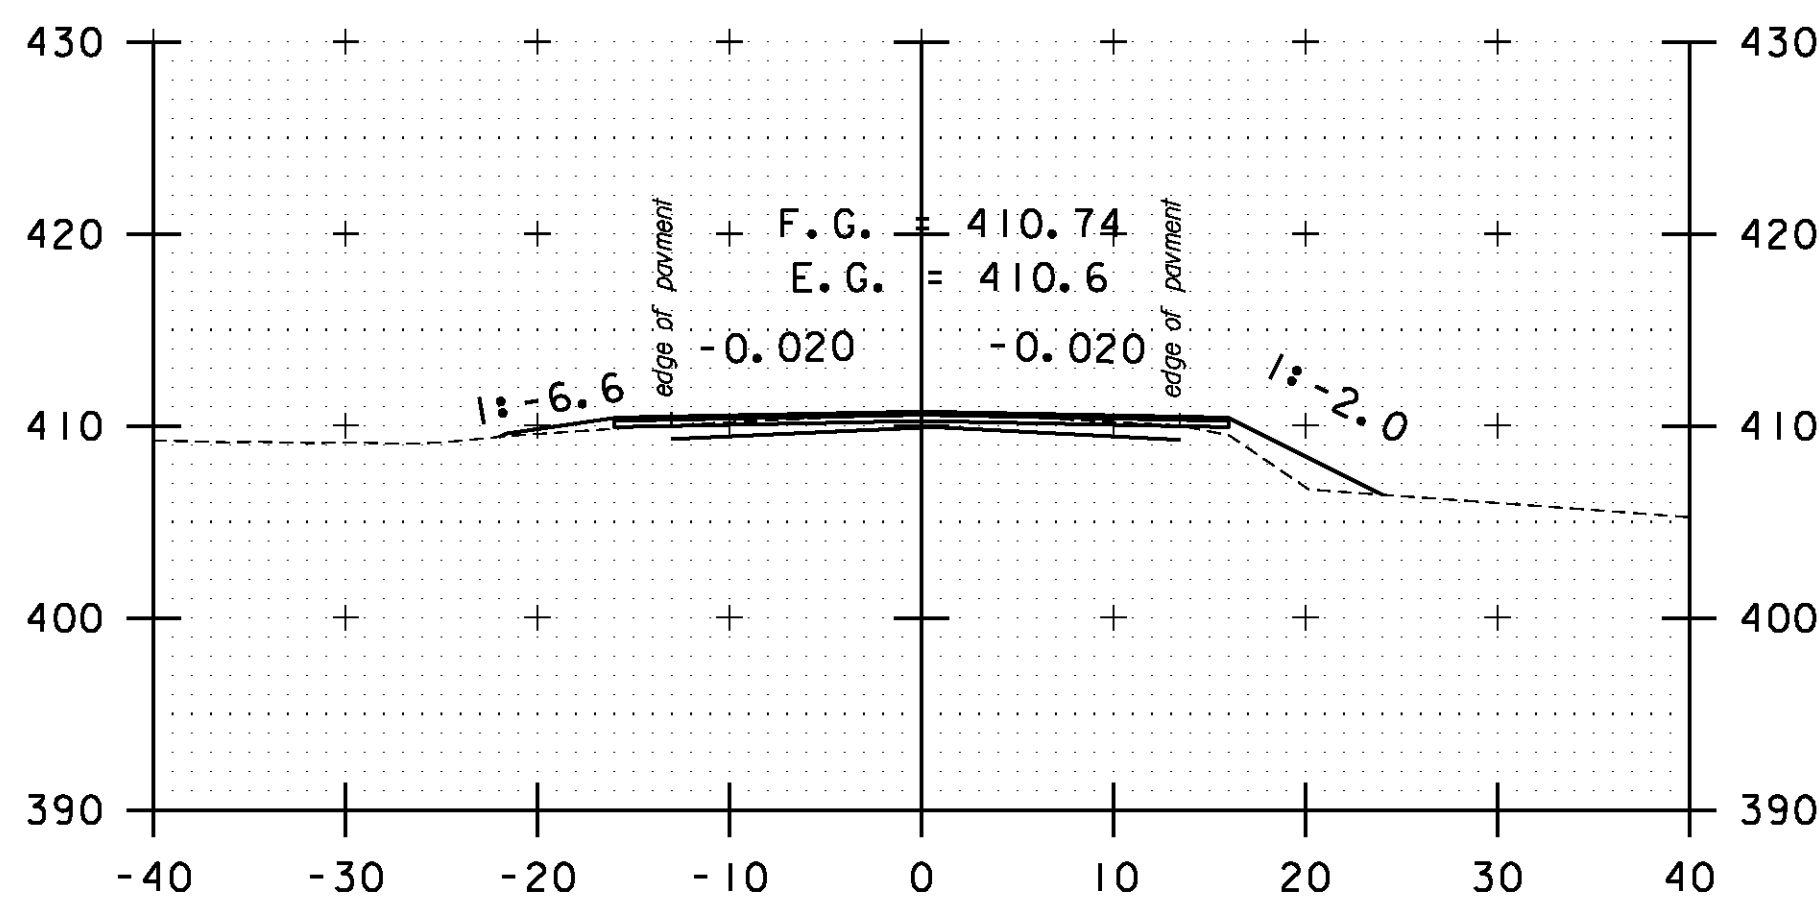


DRIVE LT
A 86+50

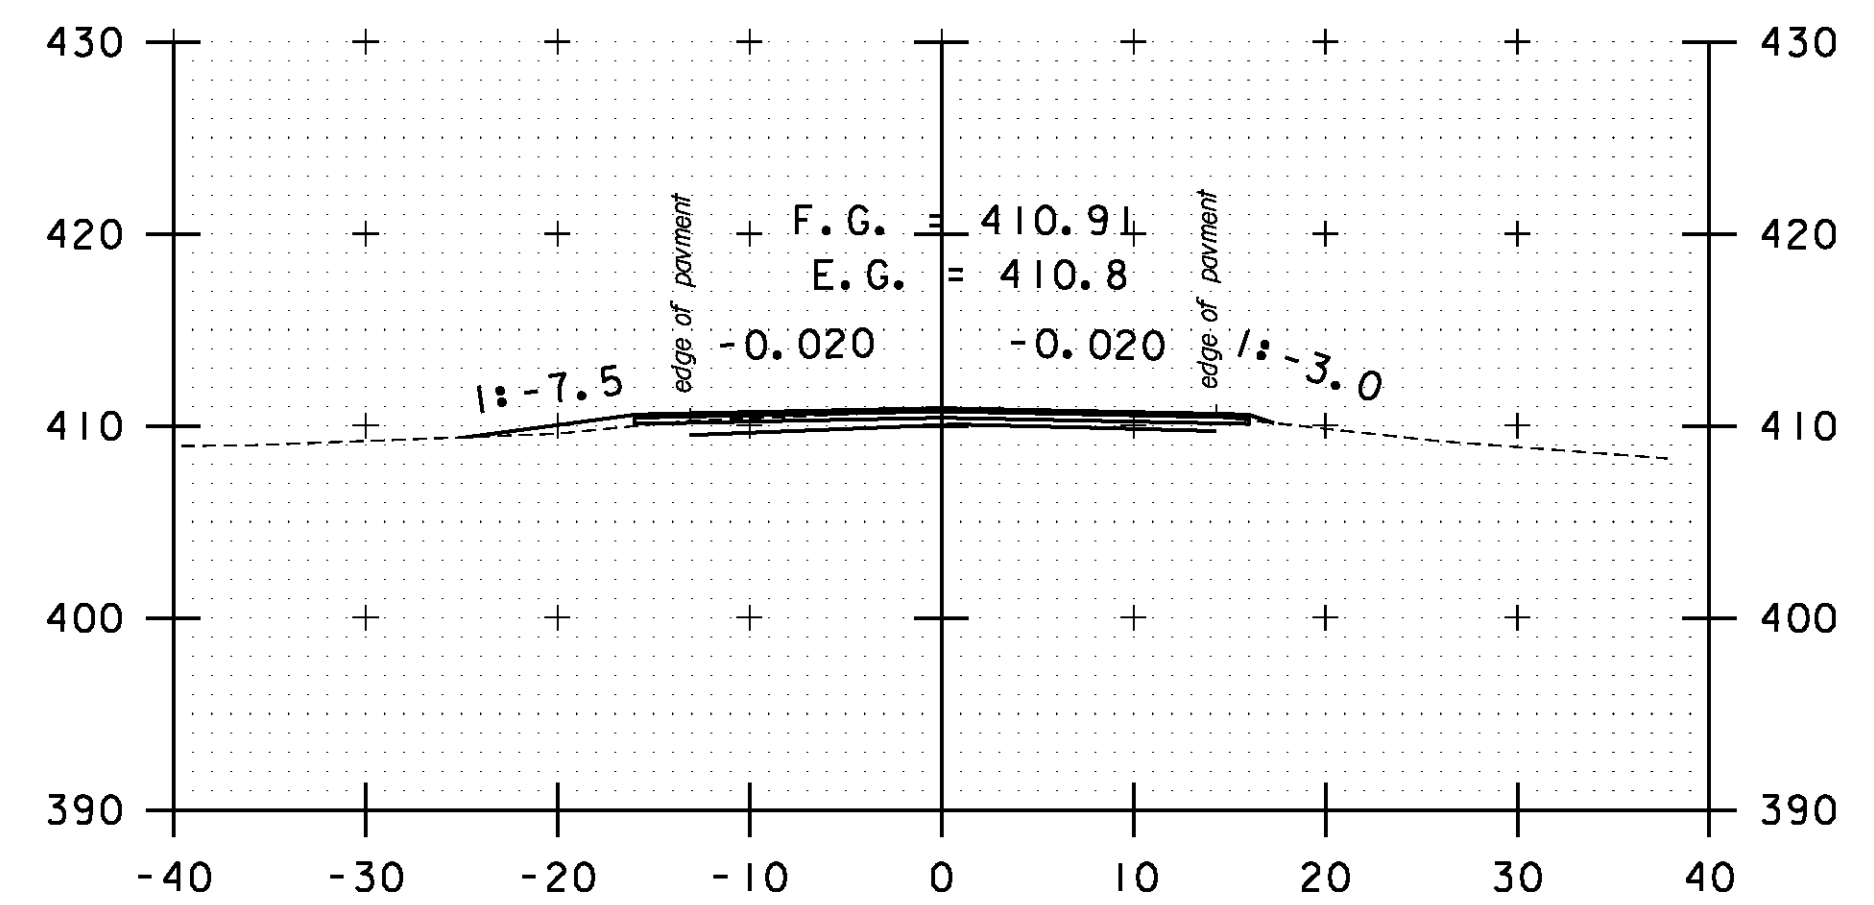


DRIVE LT
A 88+00

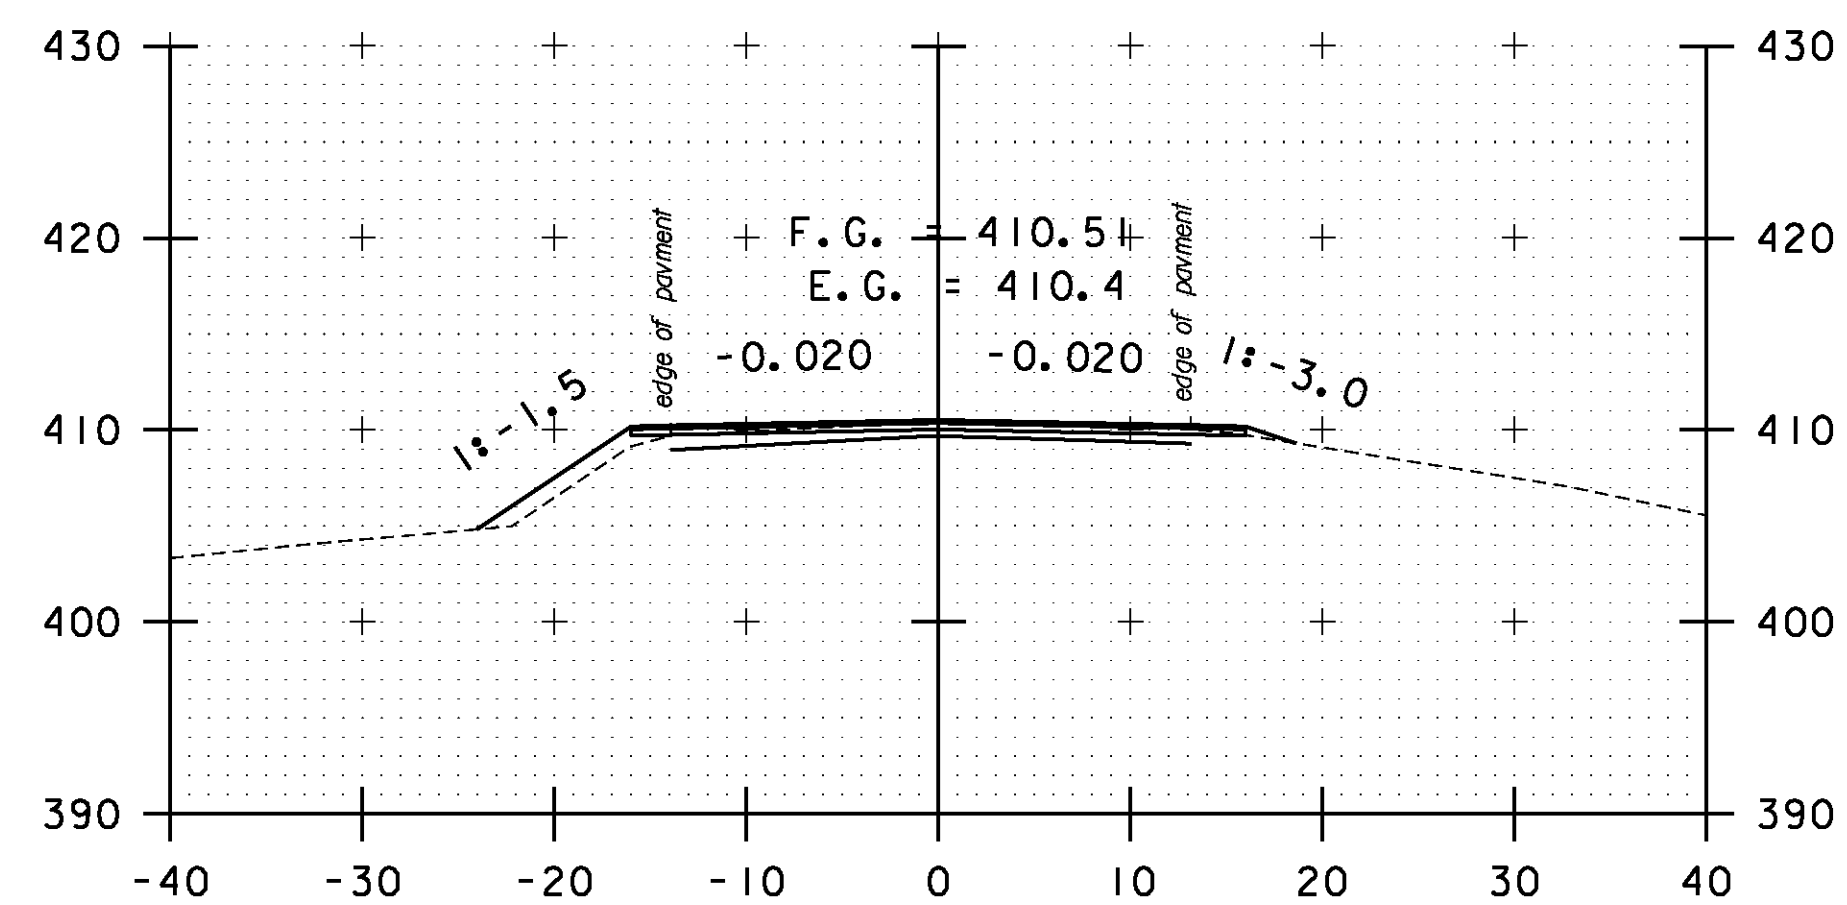


A 84+50

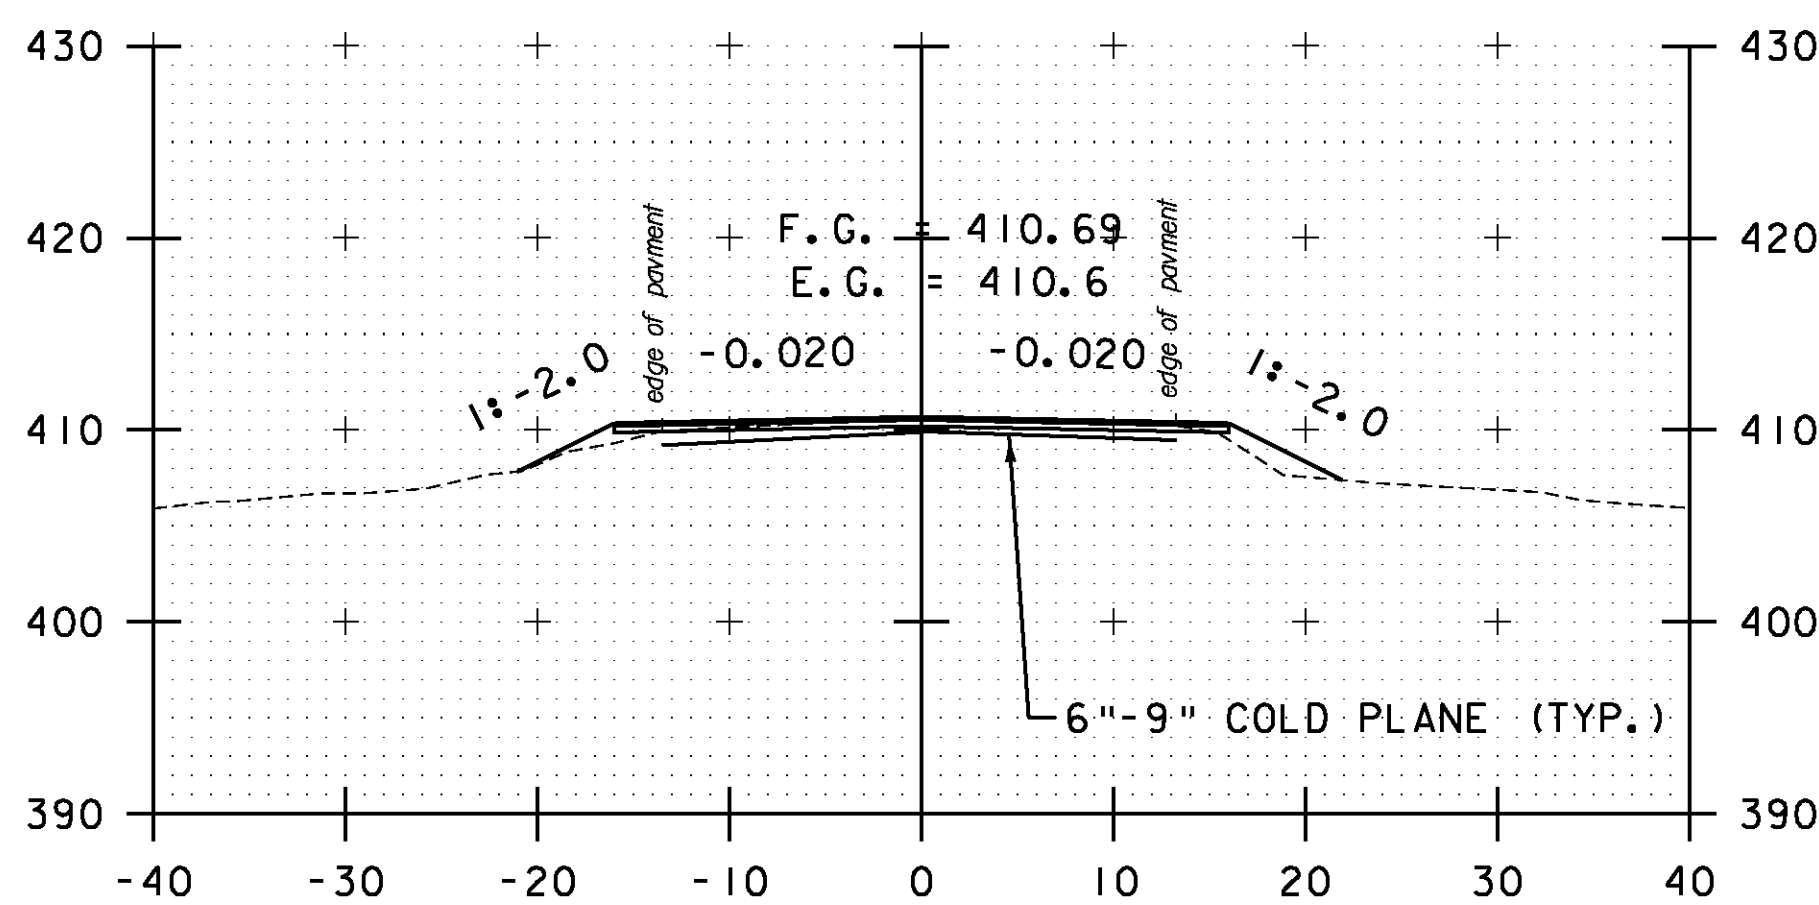


A 86+00

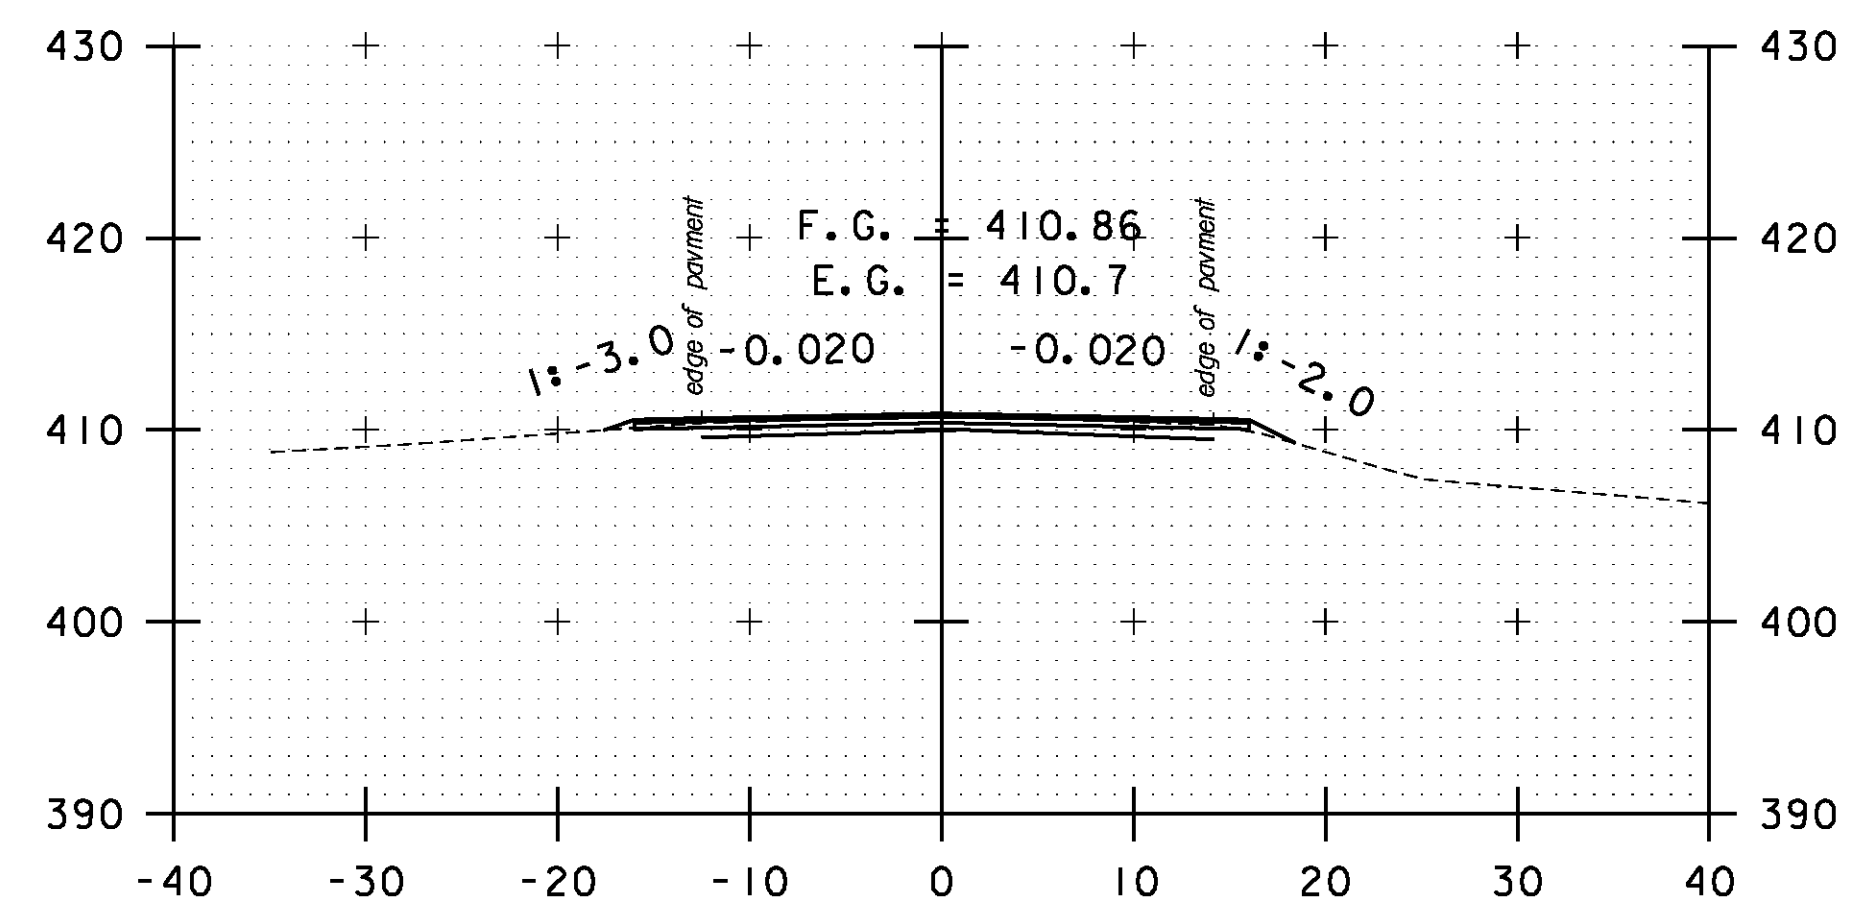


A 87+50

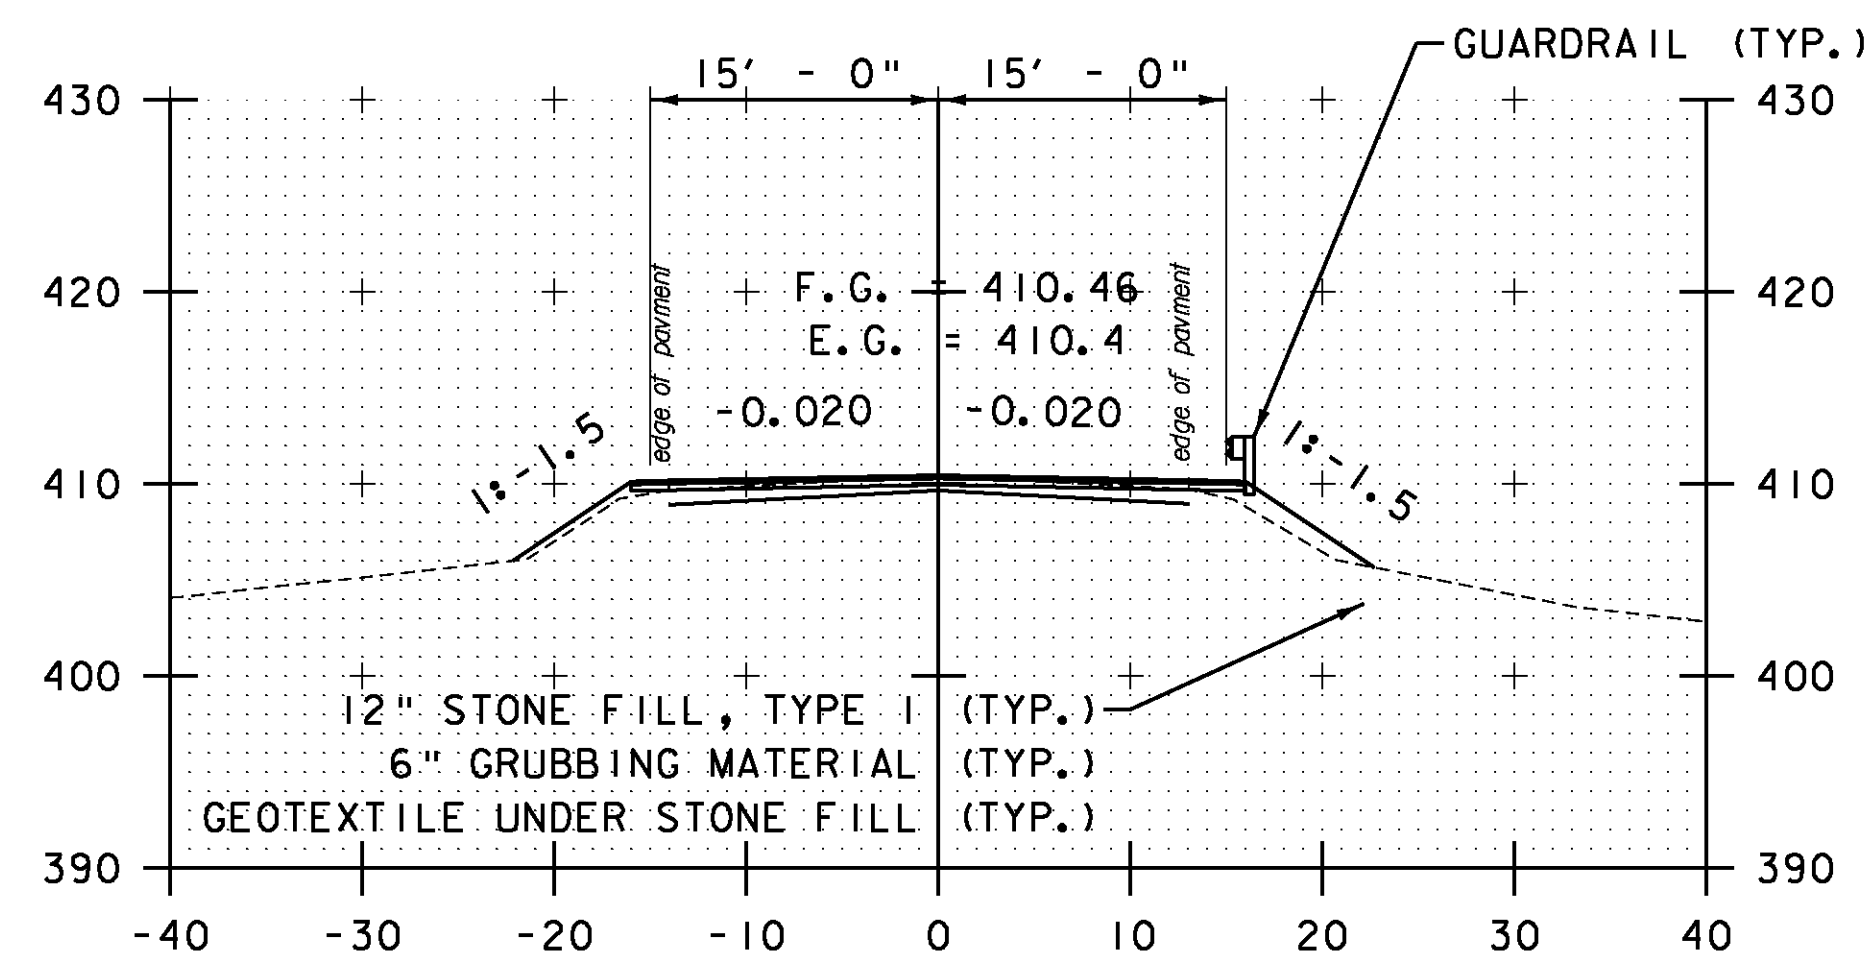

A 84+00

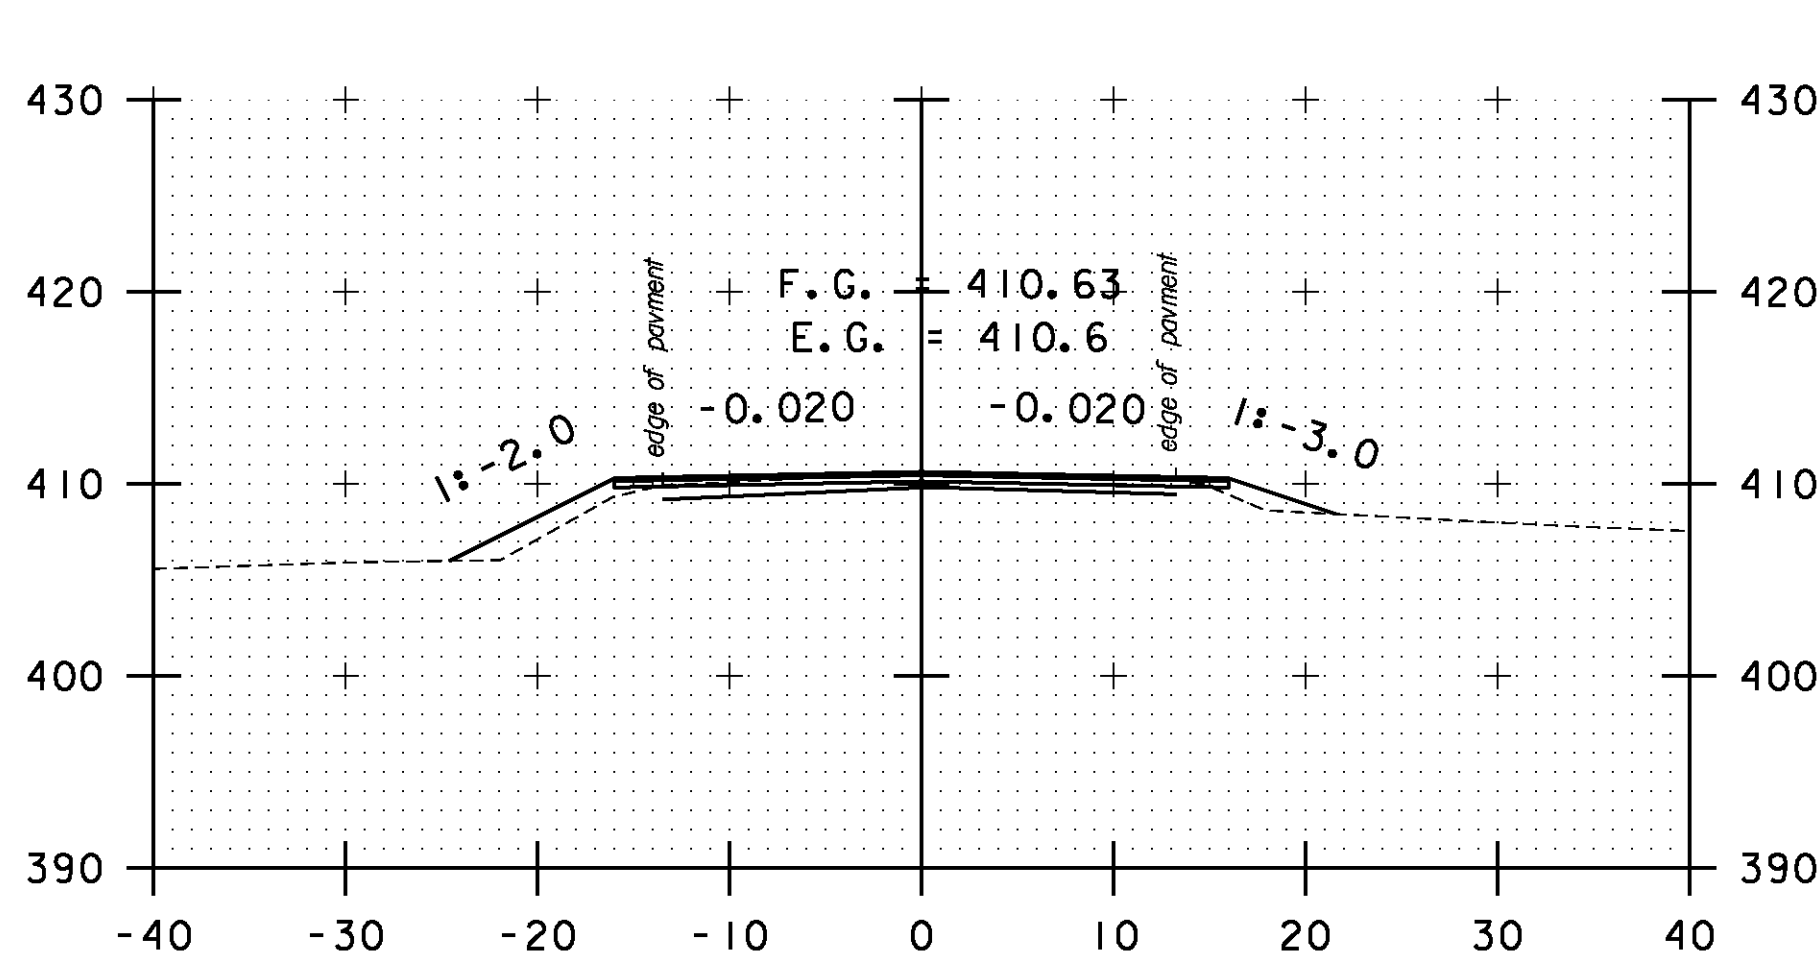

A 85+50

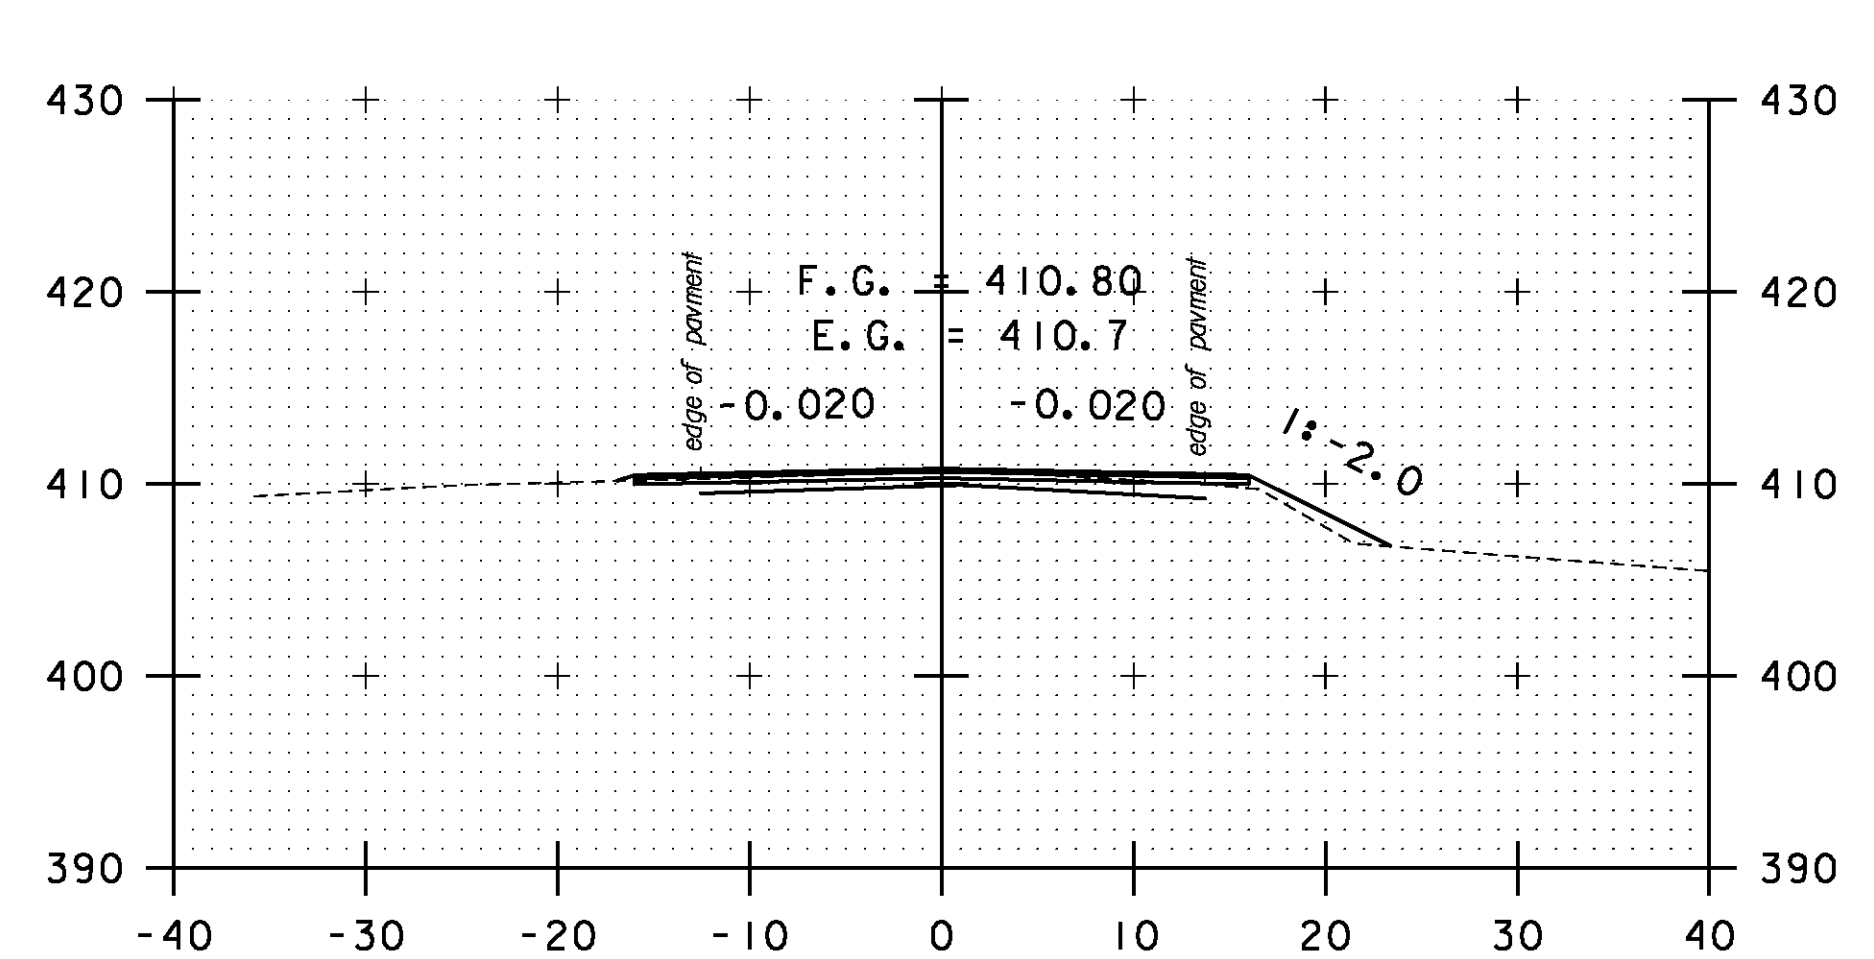

A 87+00

STA. A 84+00 TO STA. A 88+00

SCALE 1" = 10'-0"
0 10

CROSS SECTION SHEET 66

PROJECT NAME: BOLTON-WATERBURY

PROJECT NUMBER: STP 2709(I)

FILE NAME: p07C172.dgn

PROJECT LEADER: CDL

DESIGNED BY: BMB

PLOT FILE: p07C172.192.1

PLOT DATE: 4/16/2013

DRAWN BY: BMB

CHECKED BY: CDL

SHEET 192 OF 217