




A 89+50

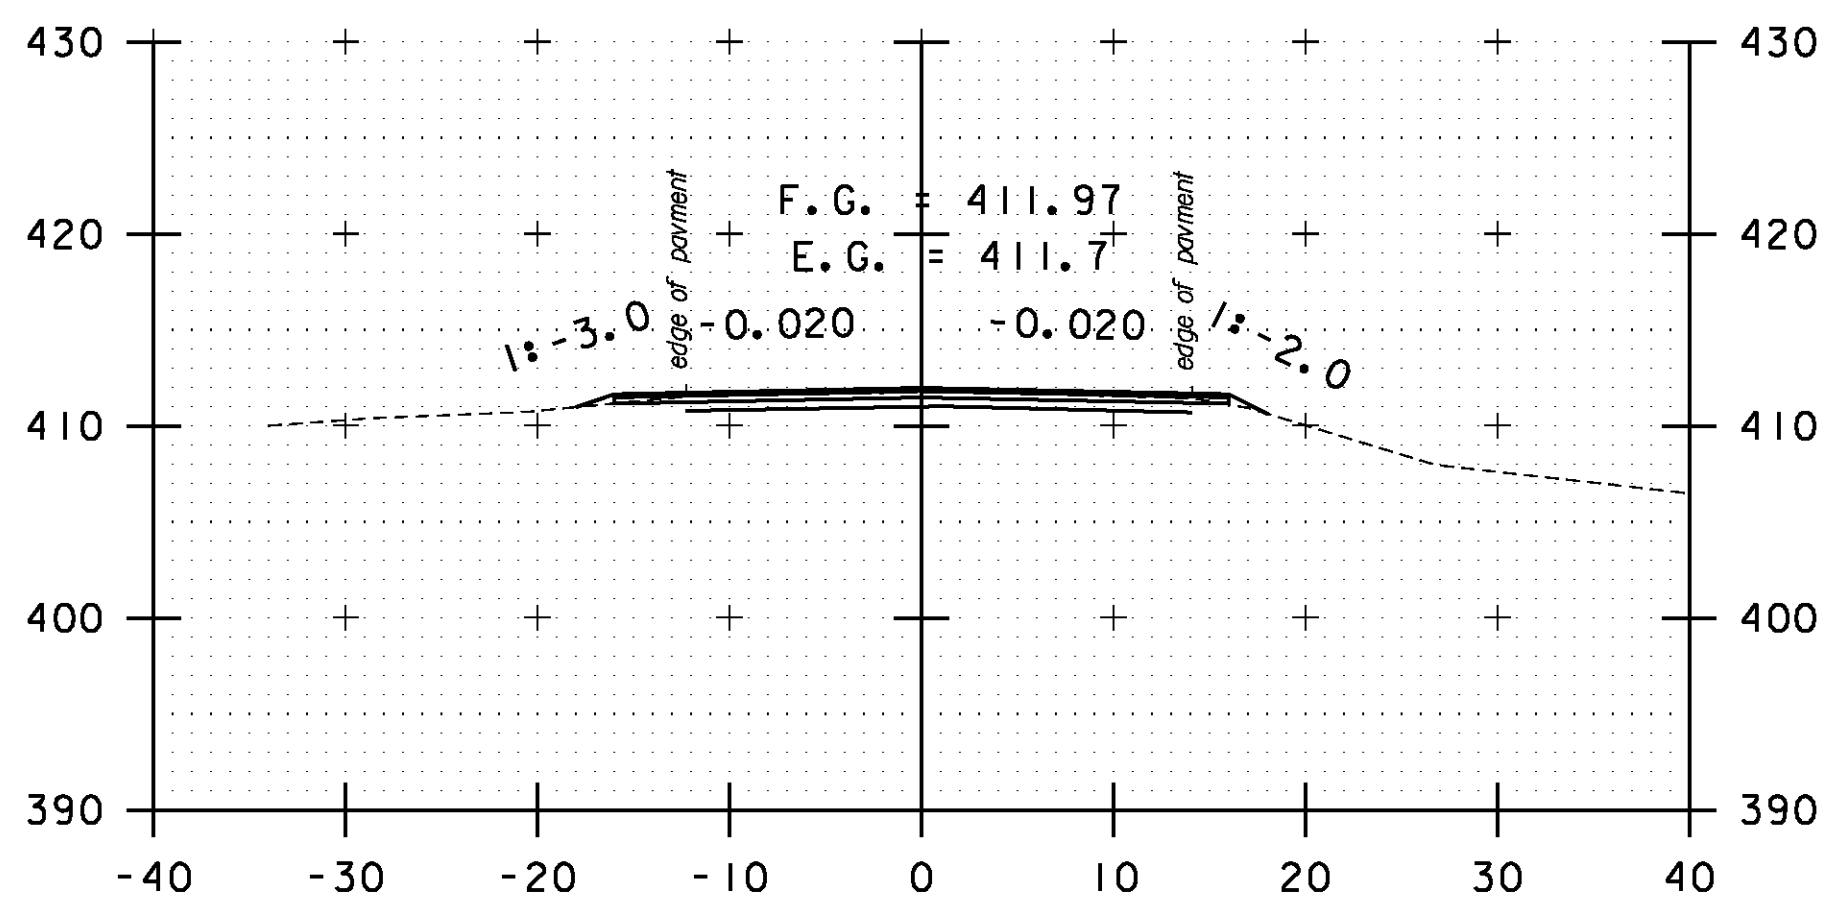


A 91+00

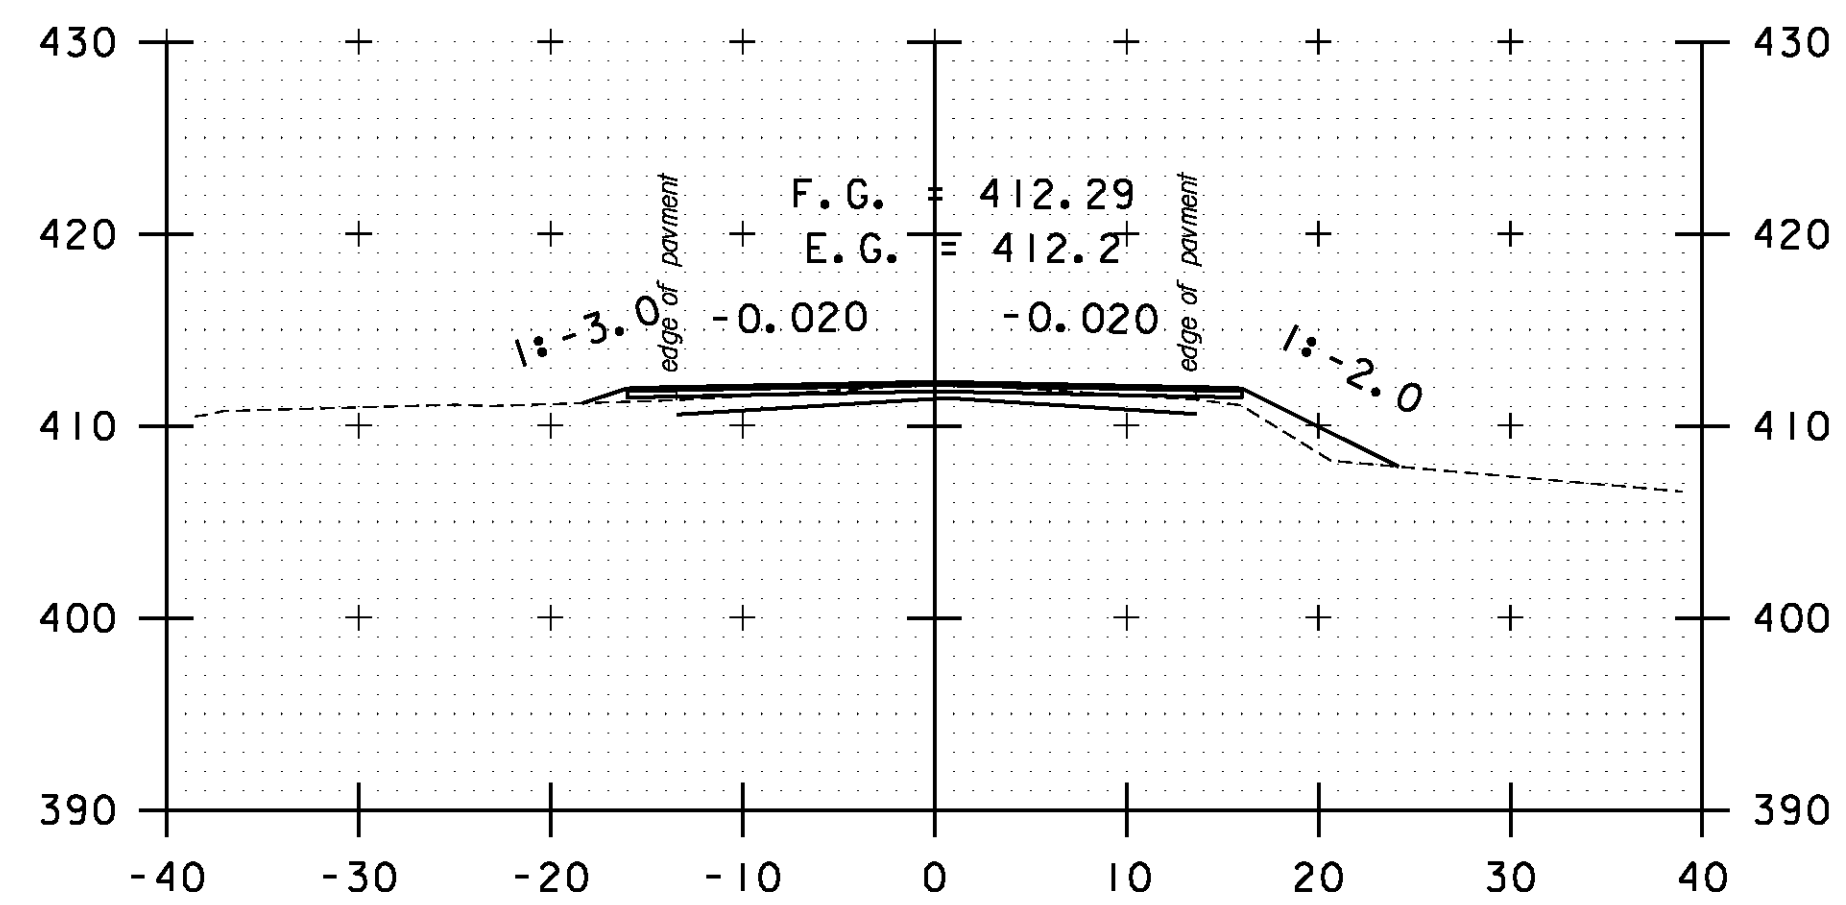


A 92+50

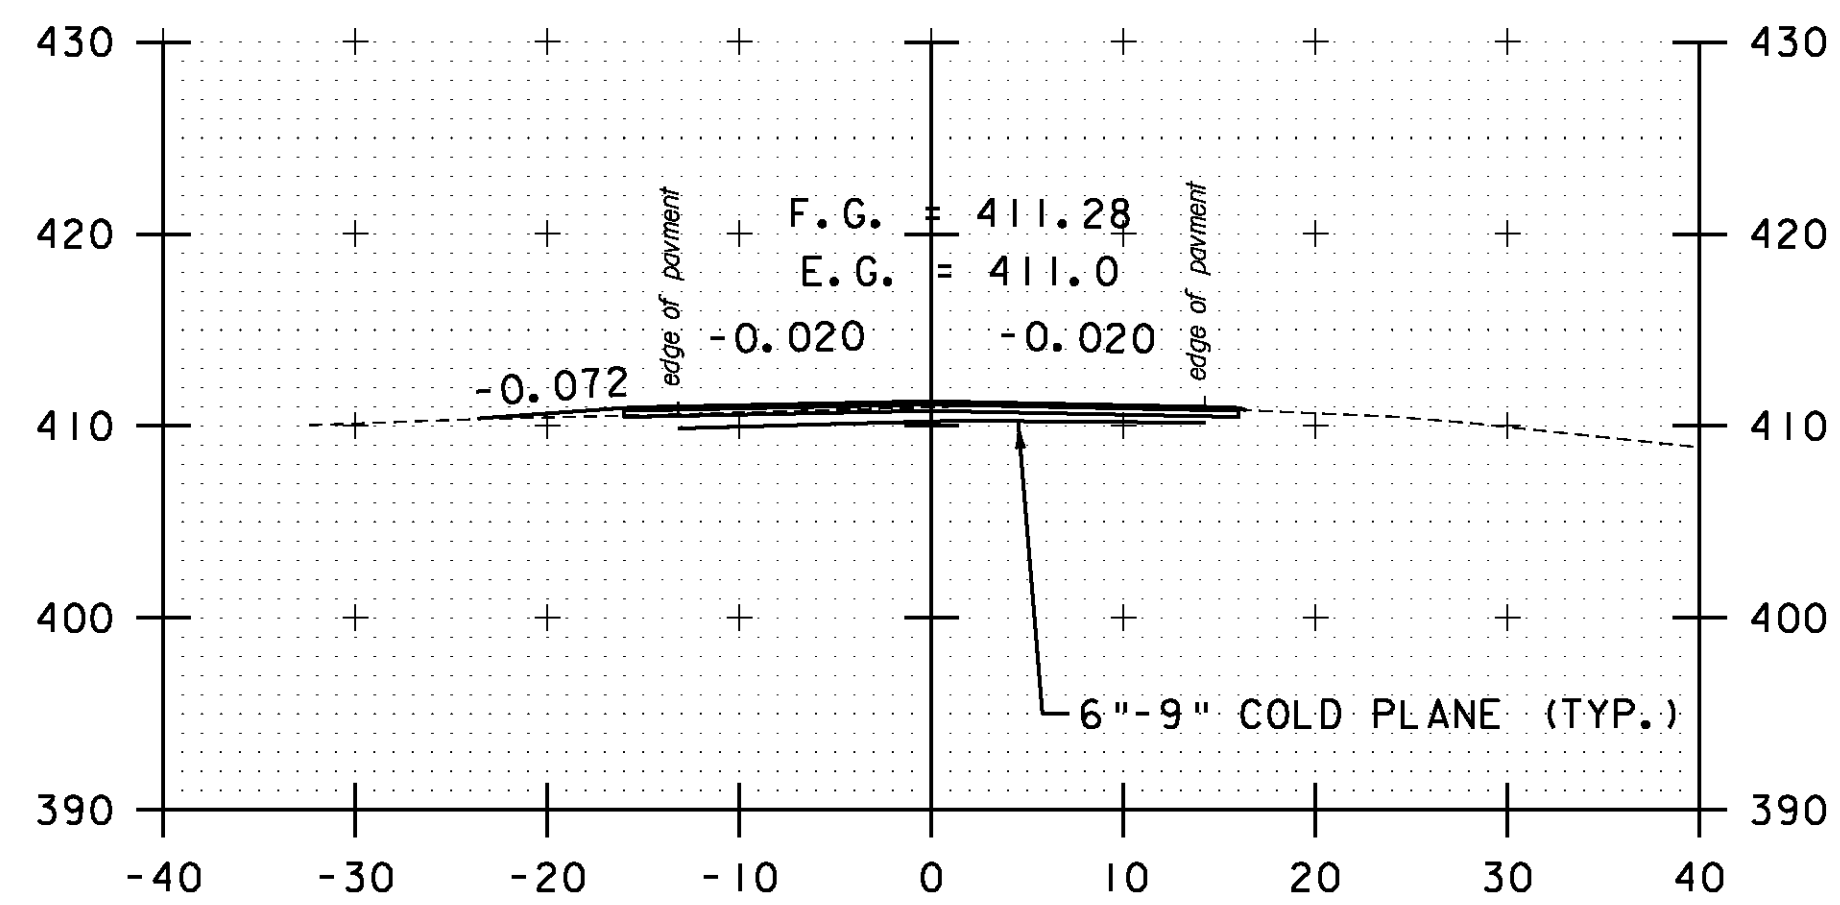


DRIVE LT
A 89+00

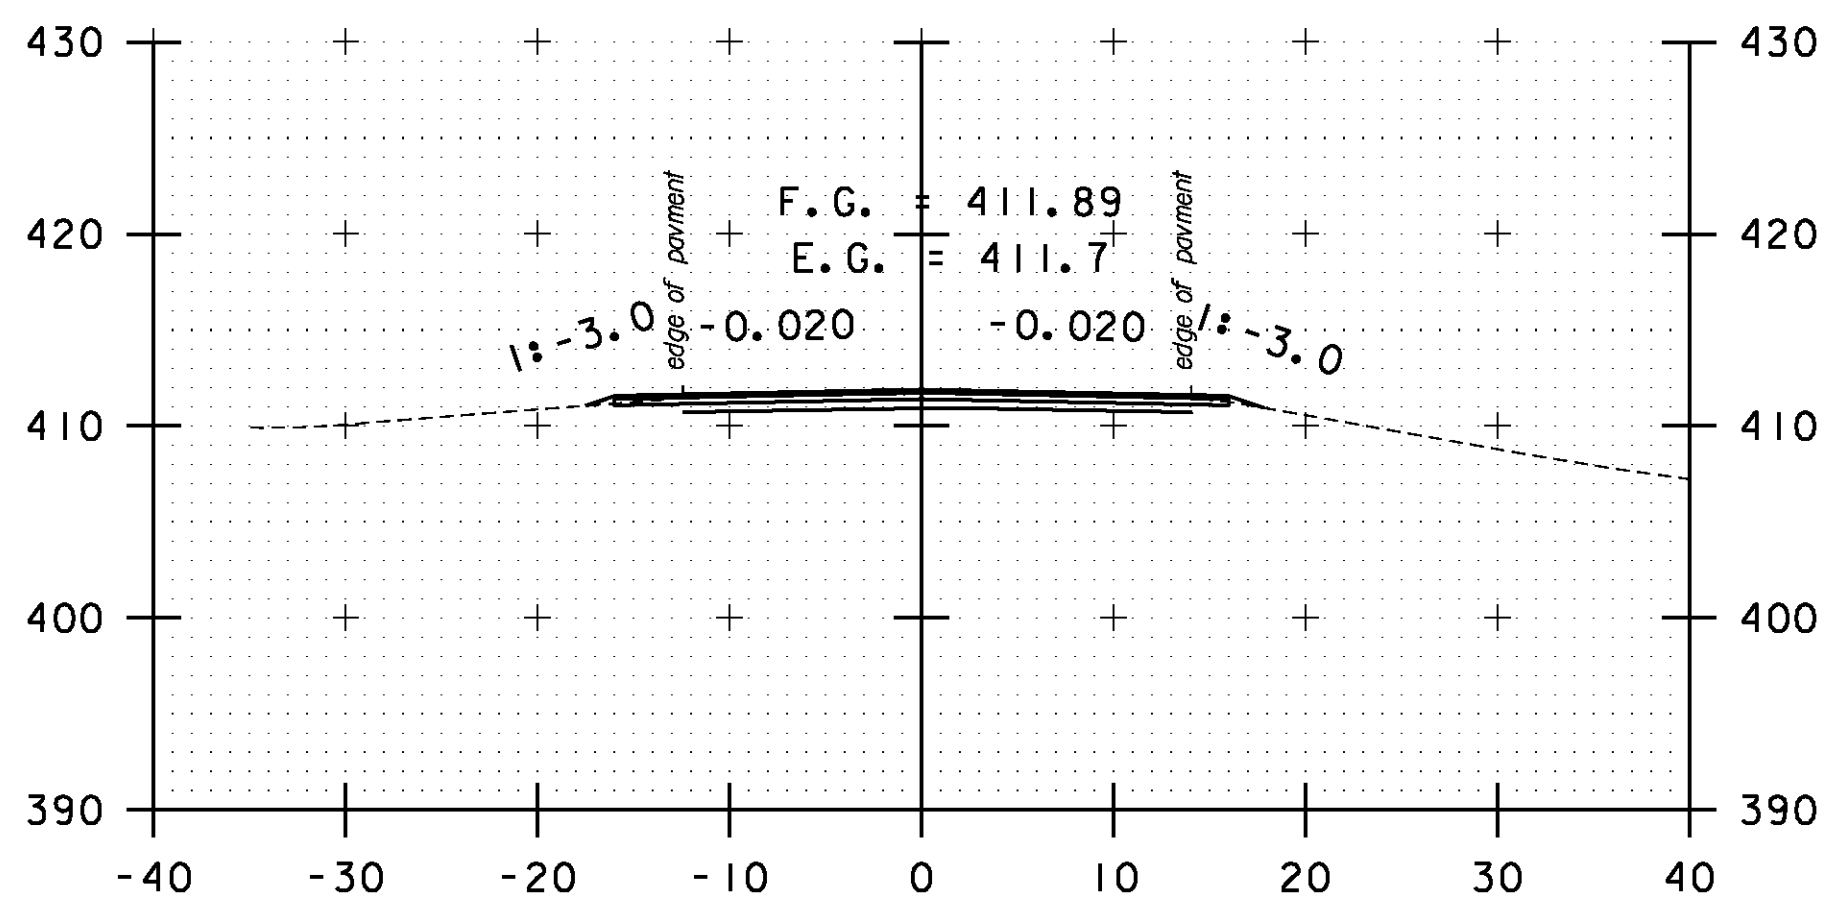


A 90+50

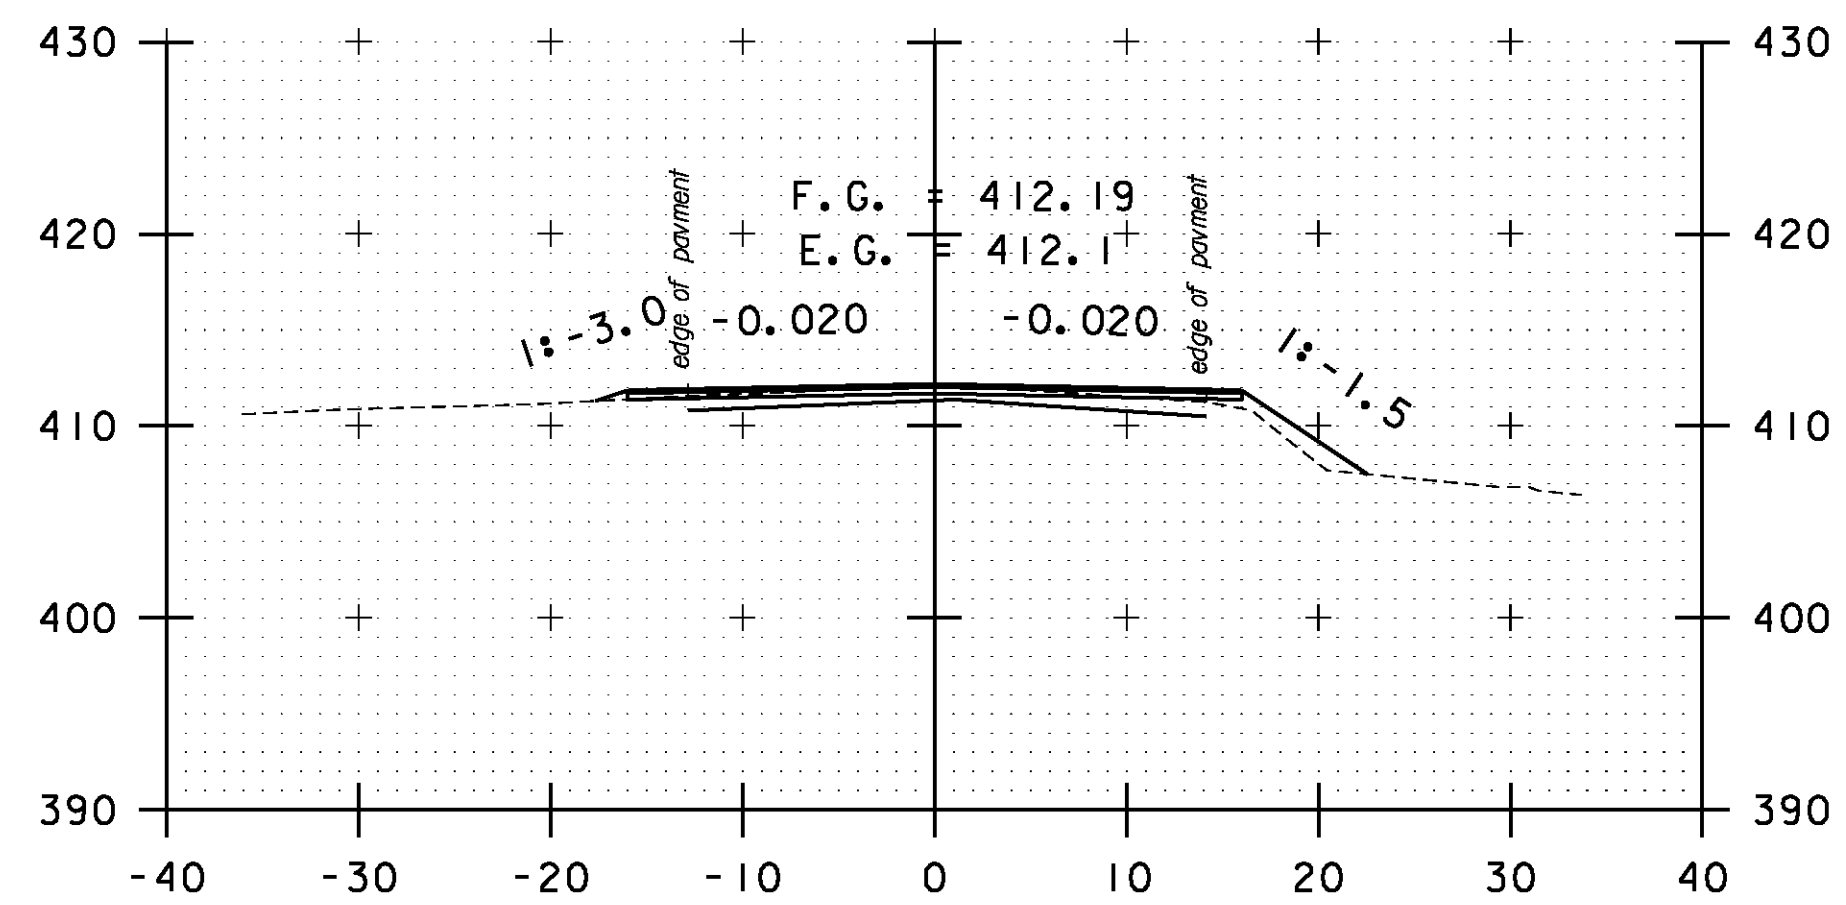


A 92+00

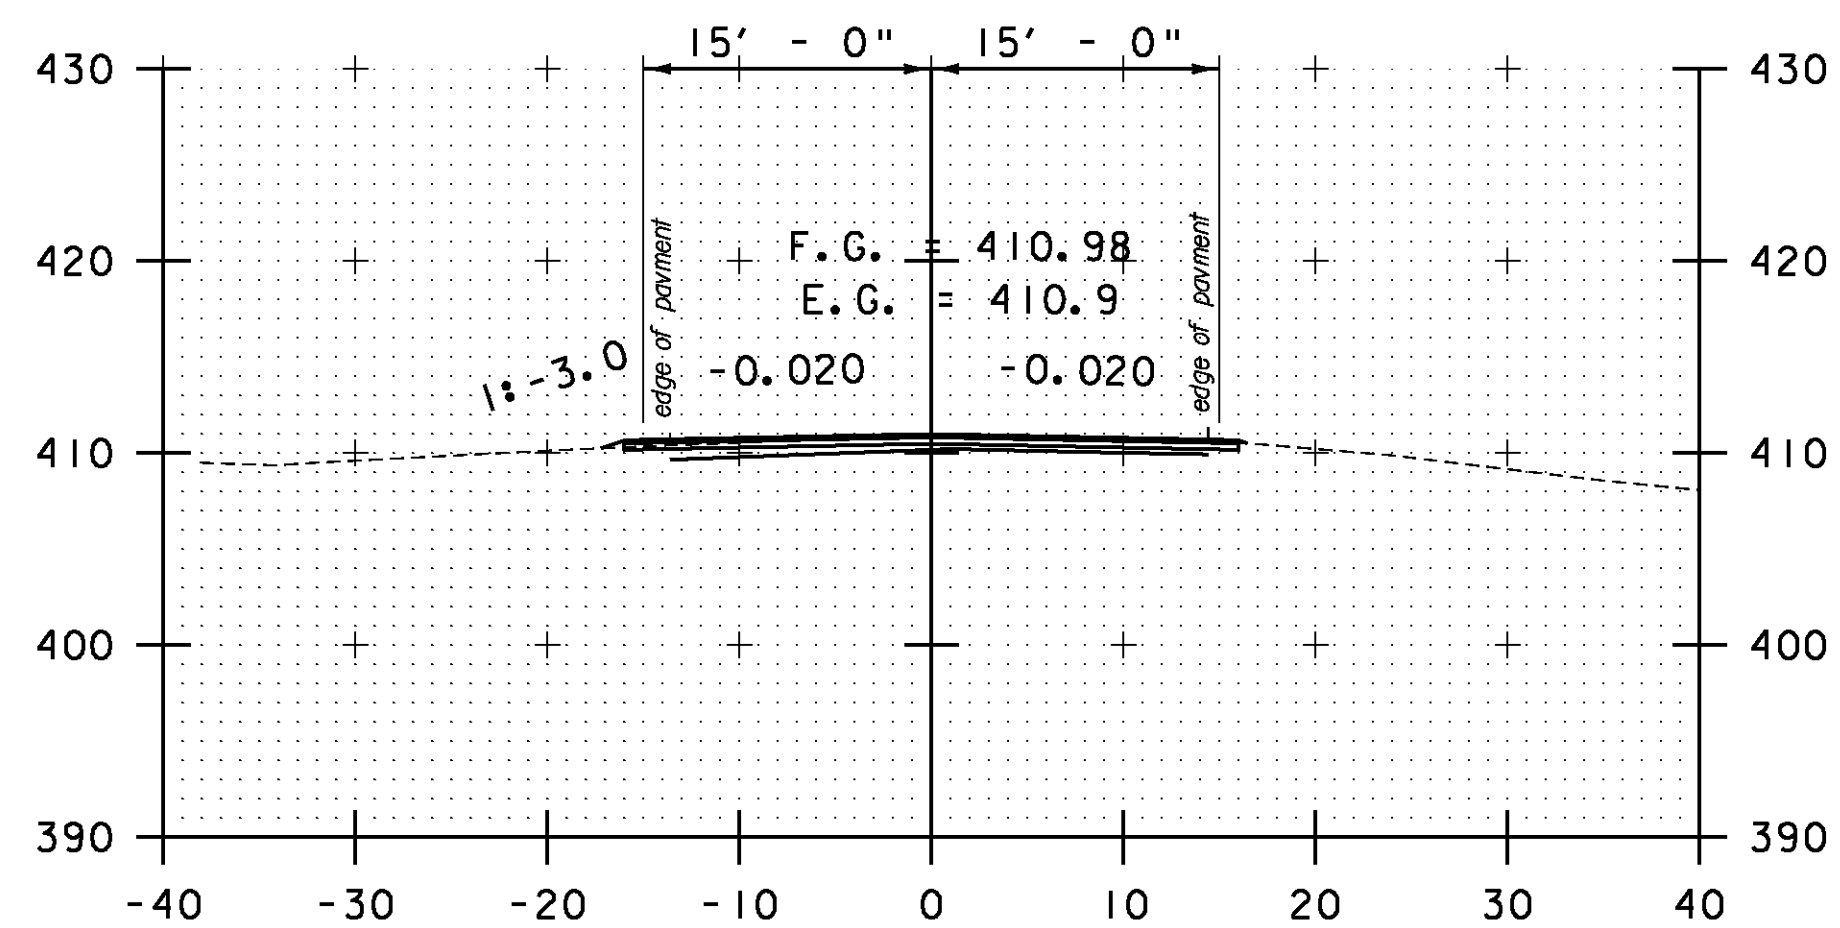

A 88+50

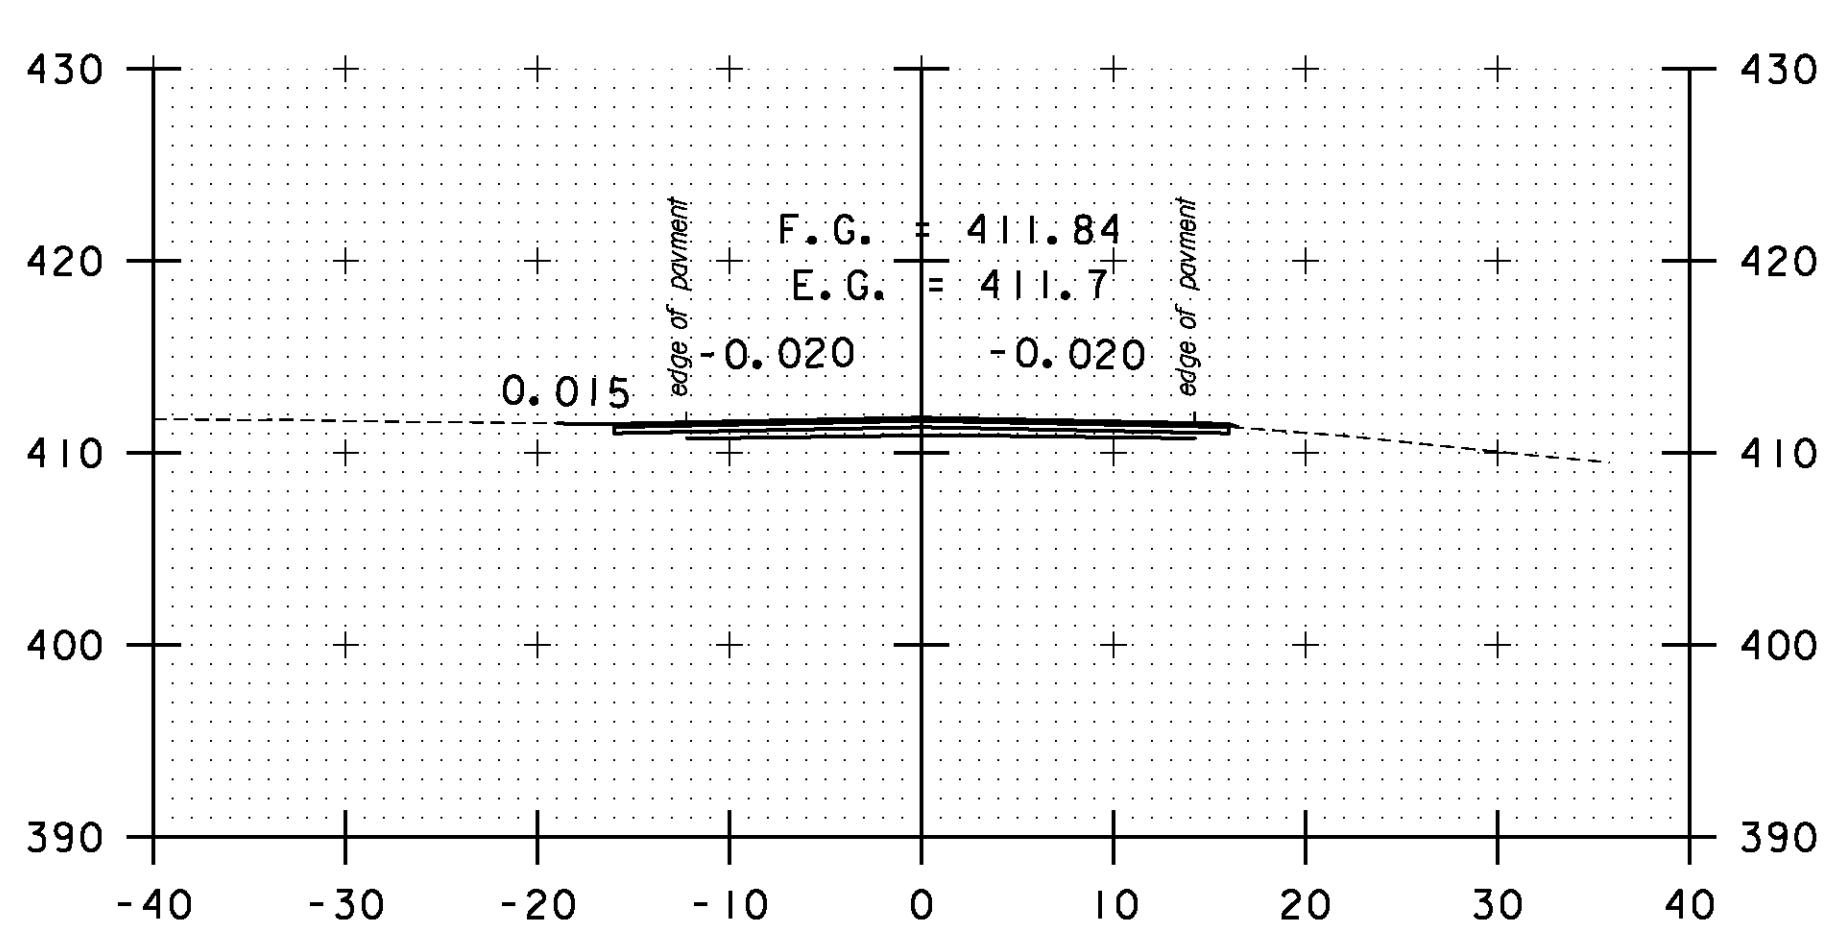


DRIVE LT
A 90+00

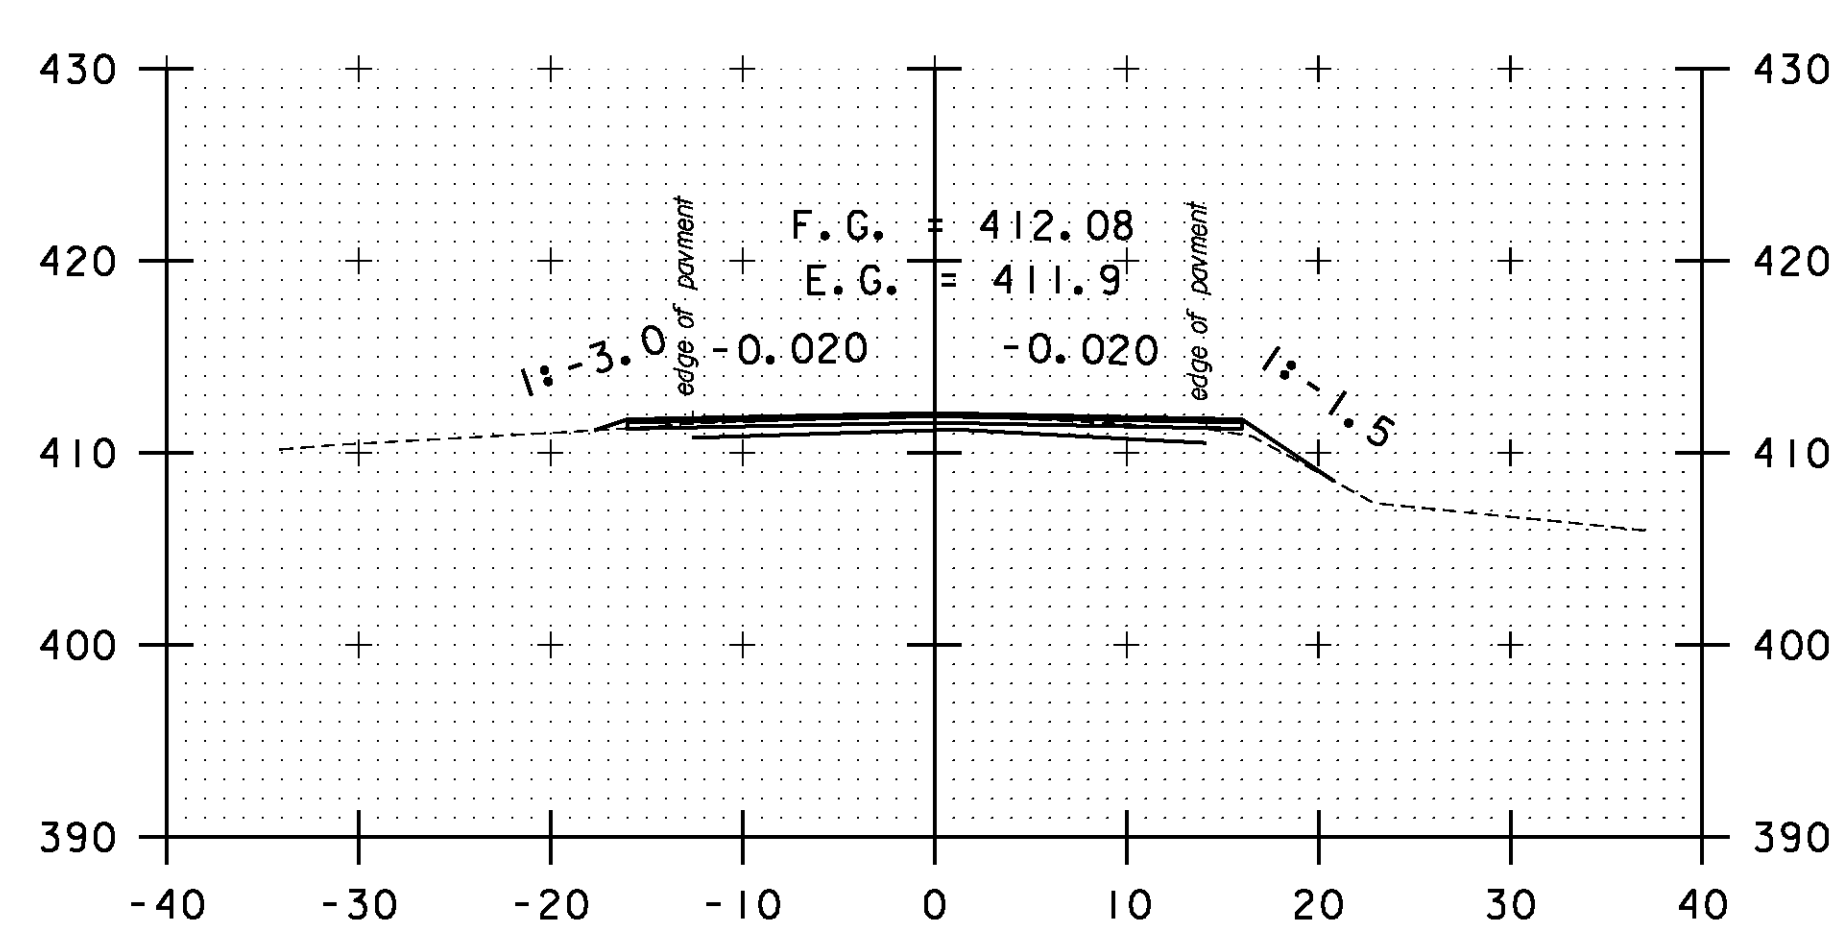

A 91+50

STA. A 88+50 TO STA. A 92+50

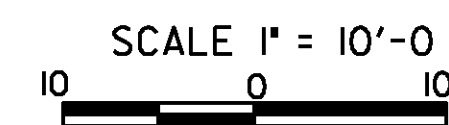

CROSS SECTION SHEET 67

PROJECT NAME: BOLTON-WATERBURY

PROJECT NUMBER: STP 2709(I)

FILE NAME: p07C172.dgn

PROJECT LEADER: CDL

DESIGNED BY: BMB

PLOT FILE: p07C172_193.1

PLOT DATE: 4/16/2013

DRAWN BY: BMB

CHECKED BY: CDL

SHEET 193 OF 217