




A 94+00

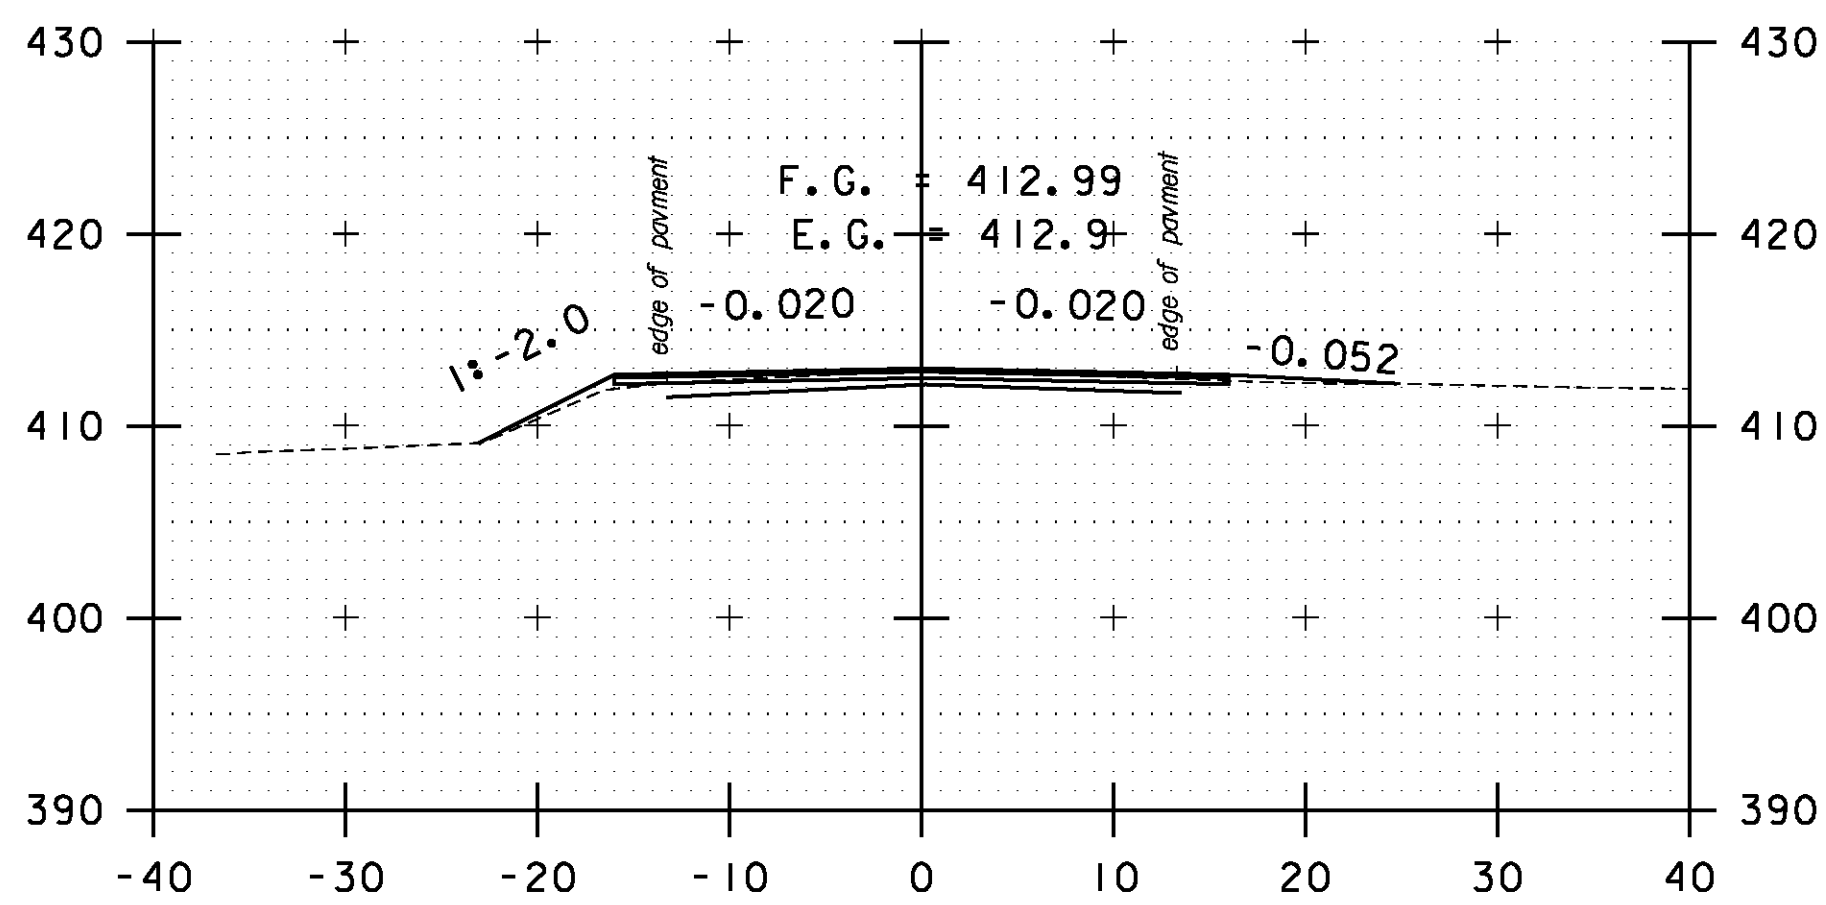


DRIVE RT  
A 95+50

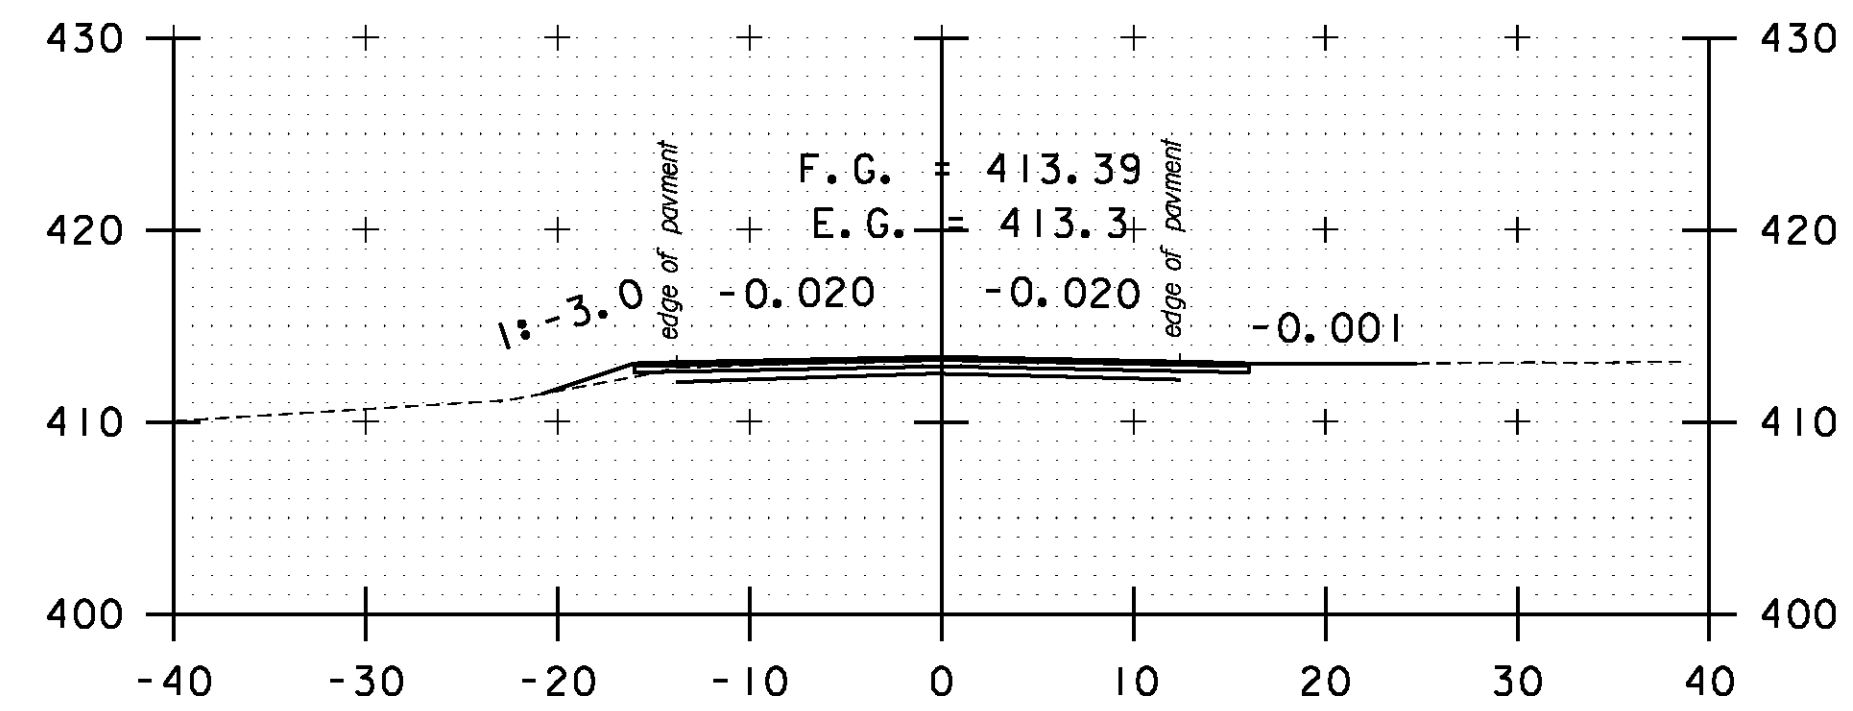


DRIVE RT  
A 97+00

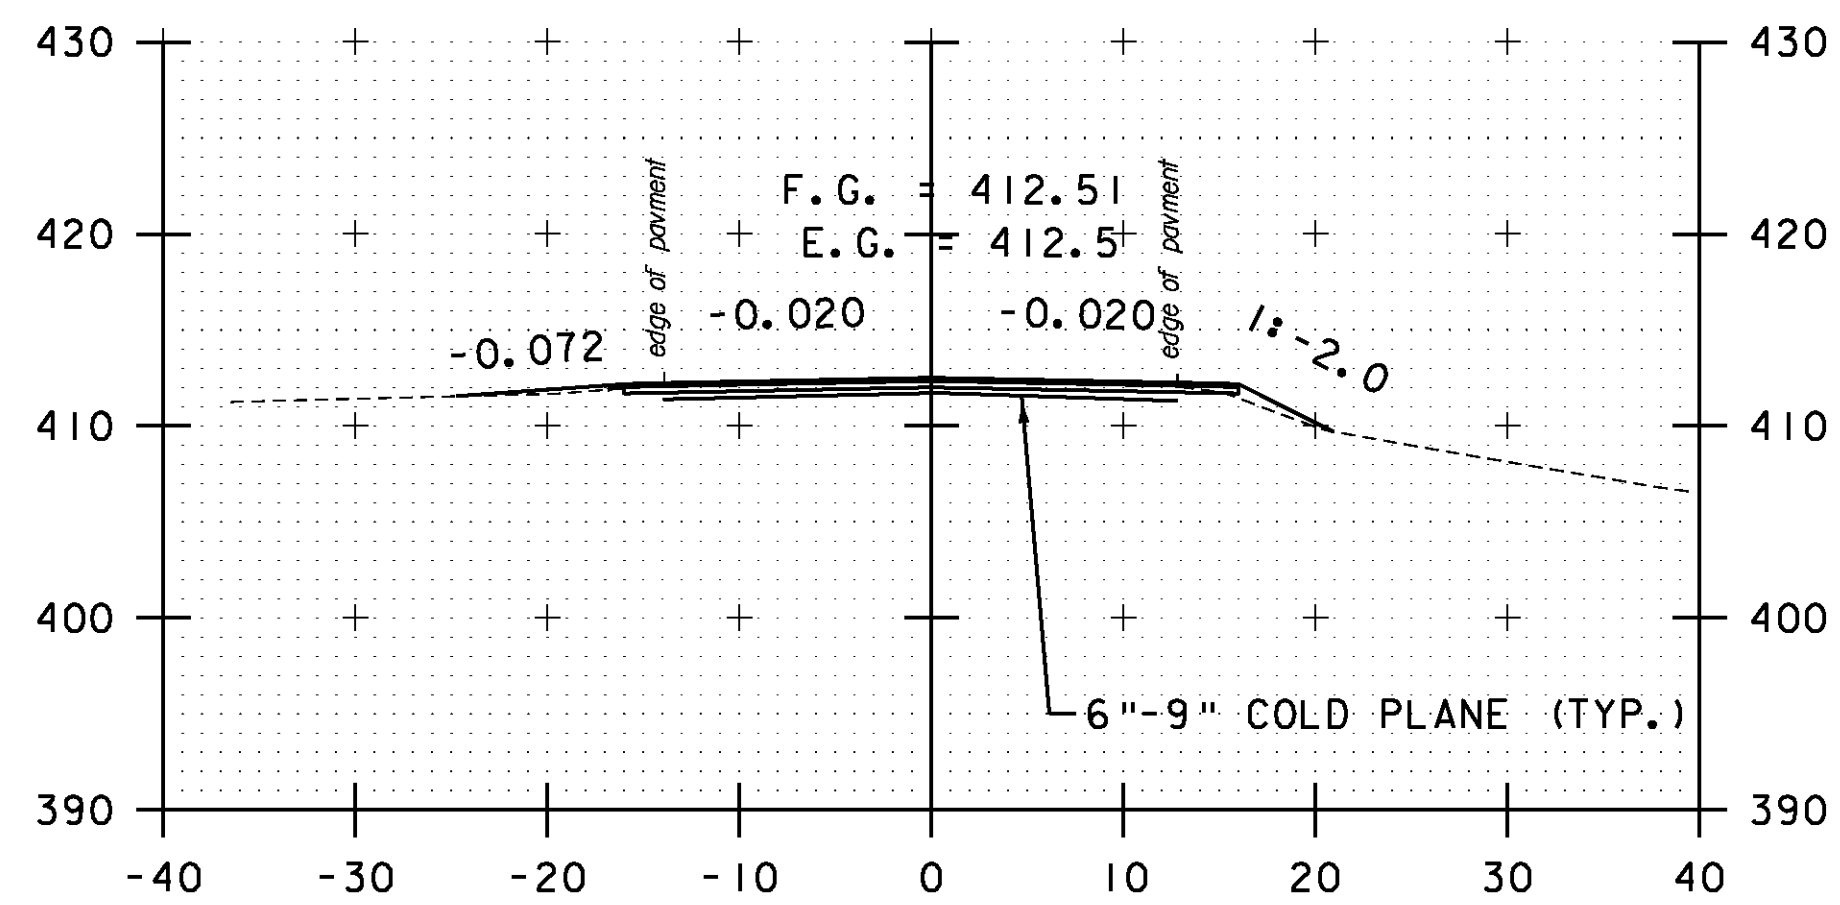


A 93+50

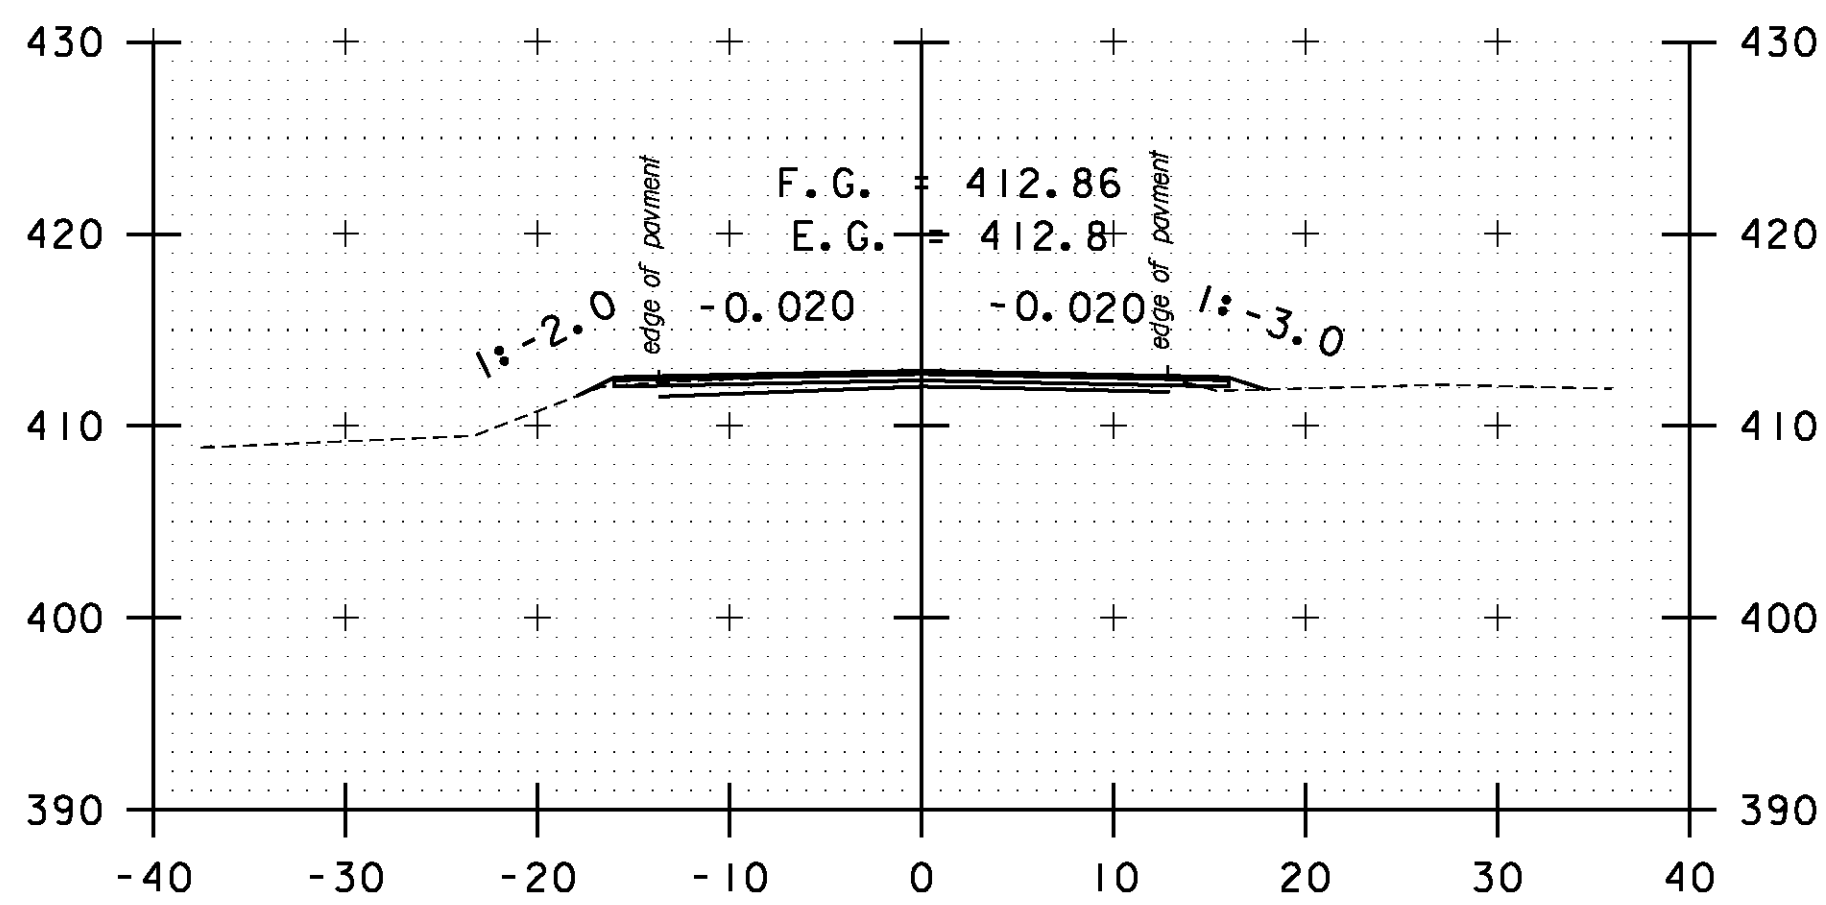


A 95+00

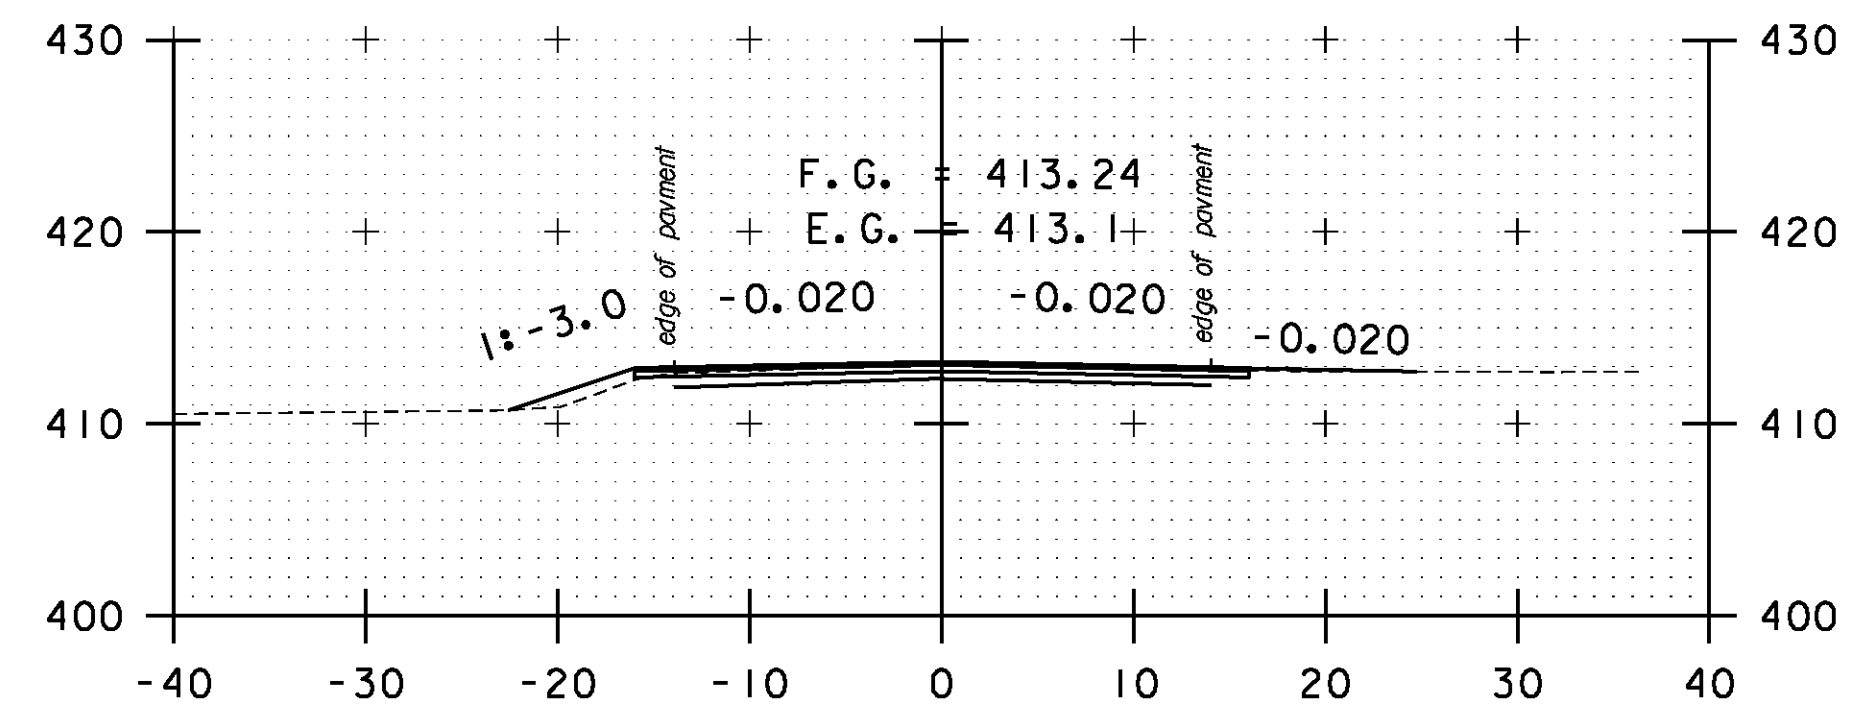


DRIVE RT  
A 96+50

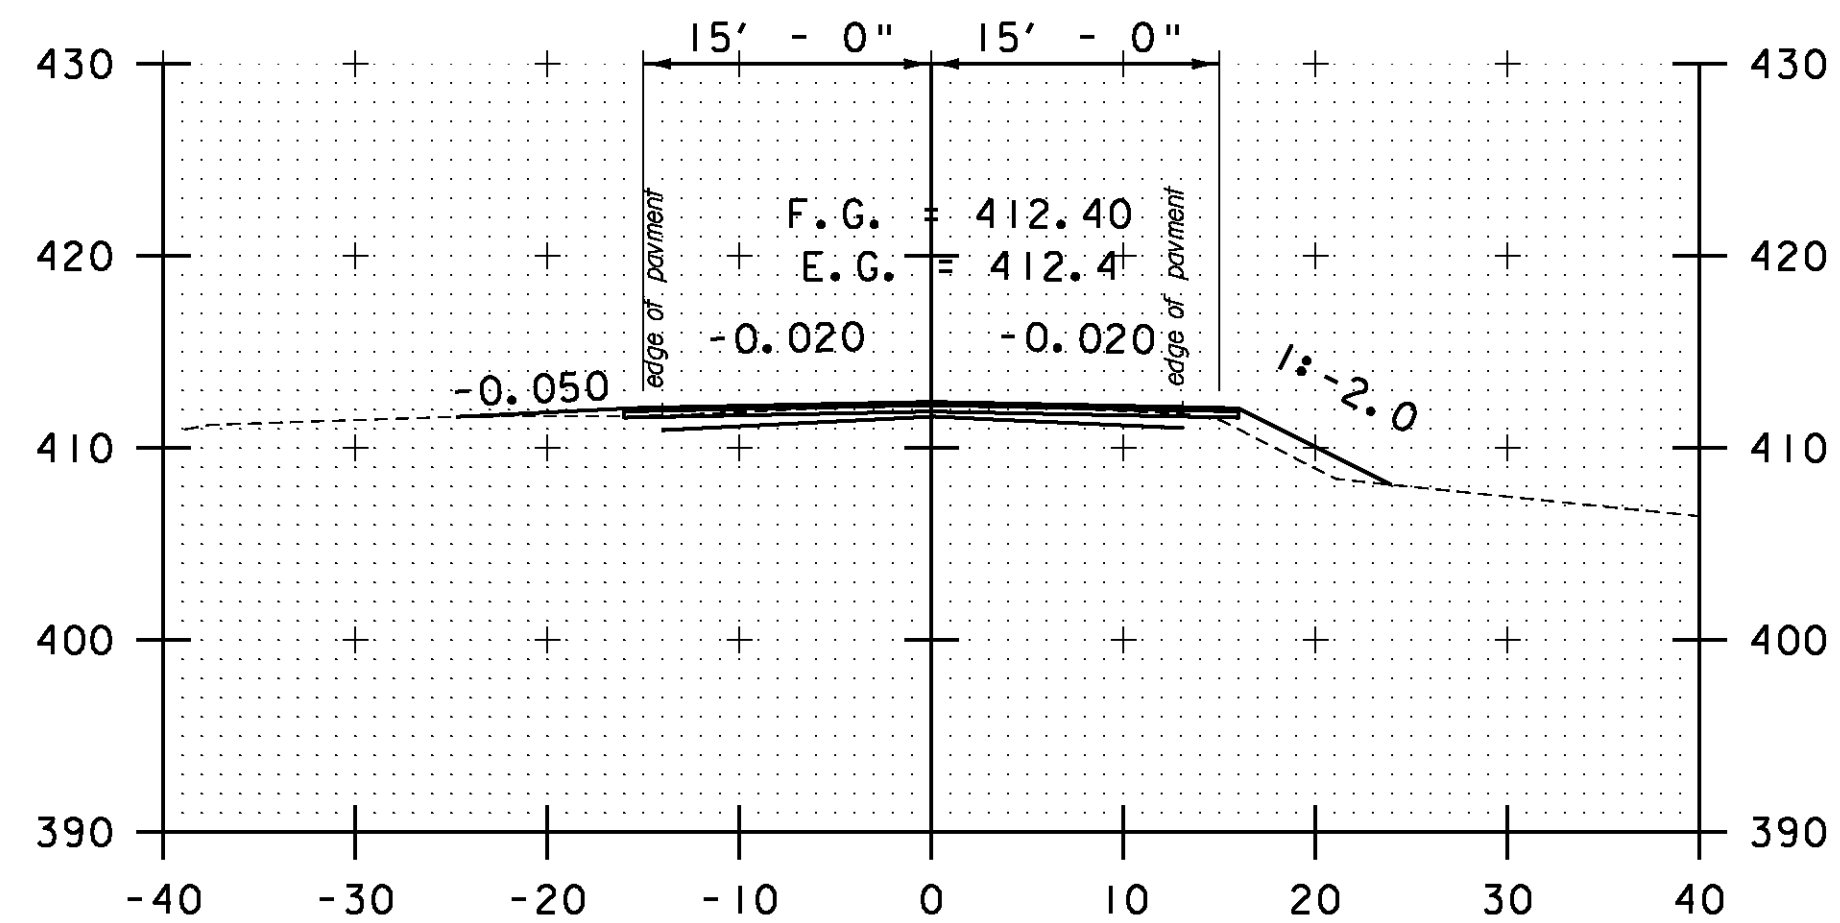

DRIVE LT  
A 93+00

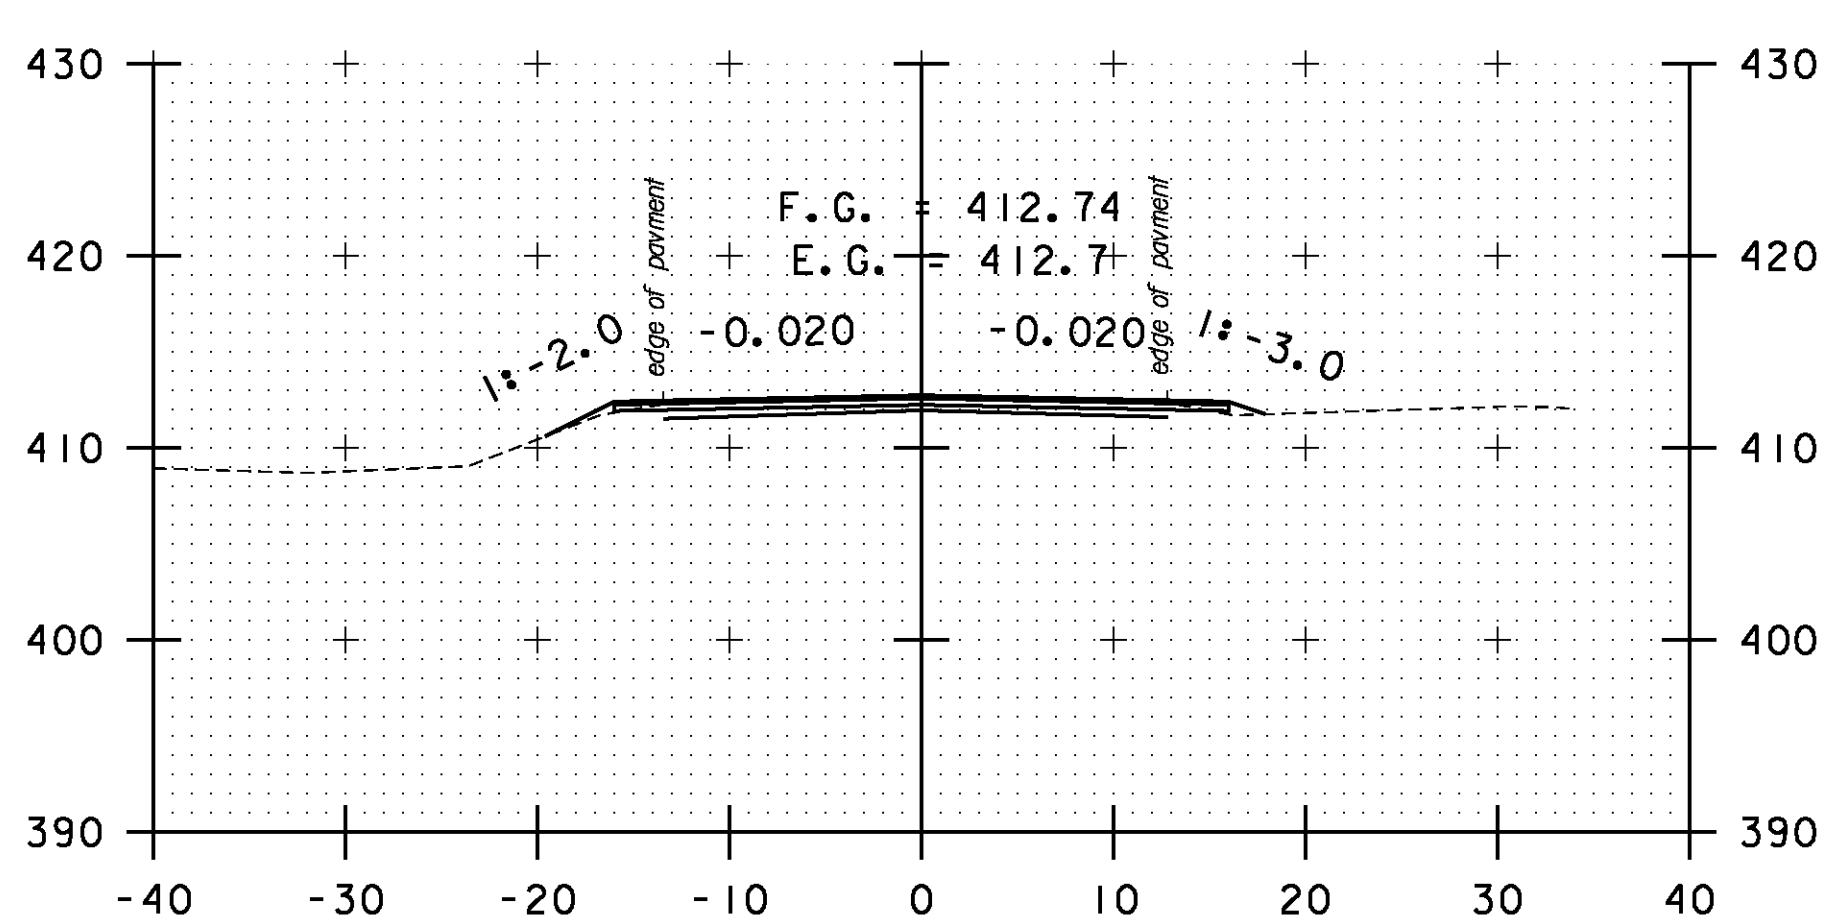

A 94+50

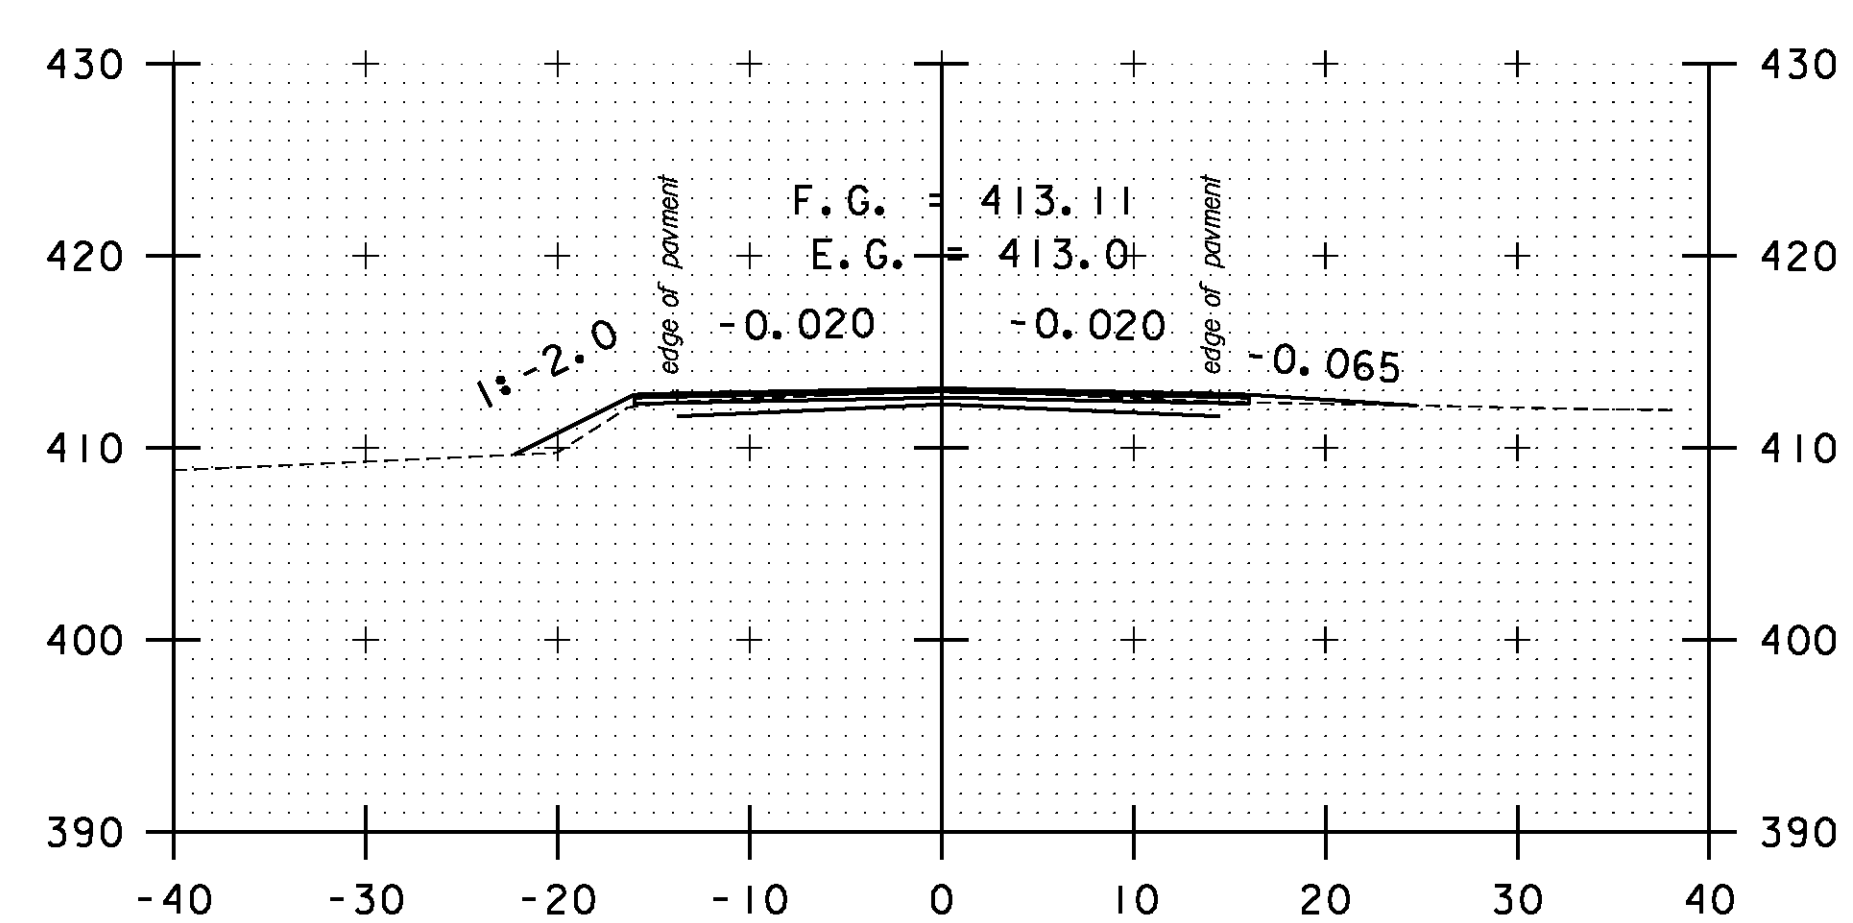

DRIVE RT  
A 96+00

STA. A 93+00 TO STA. A 97+00

SCALE 1" = 10'-0"

**CROSS SECTION SHEET 68**

PROJECT NAME: BOLTON-WATERBURY

PROJECT NUMBER: STP 2709(I)

FILE NAME: p07C172.dgn

PROJECT LEADER: CDL

DESIGNED BY: BMB

PLOT FILE: p07C172.194.1

PLOT DATE: 4/16/2013

DRAWN BY: BMB

CHECKED BY: CDL

SHEET 194 OF 217