




A 107+50

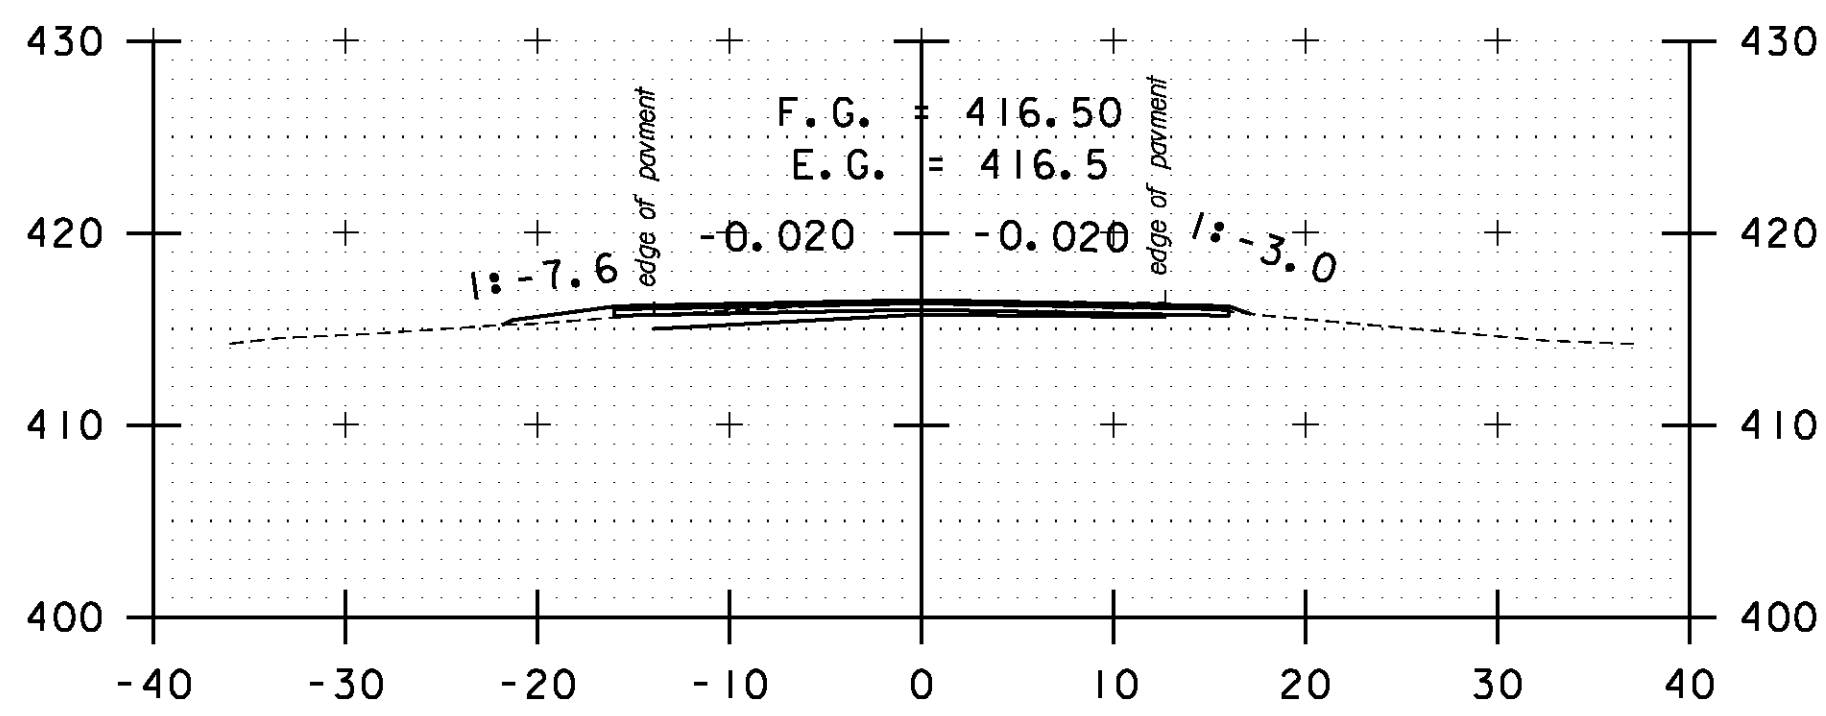


DRIVE LT
A 109+00

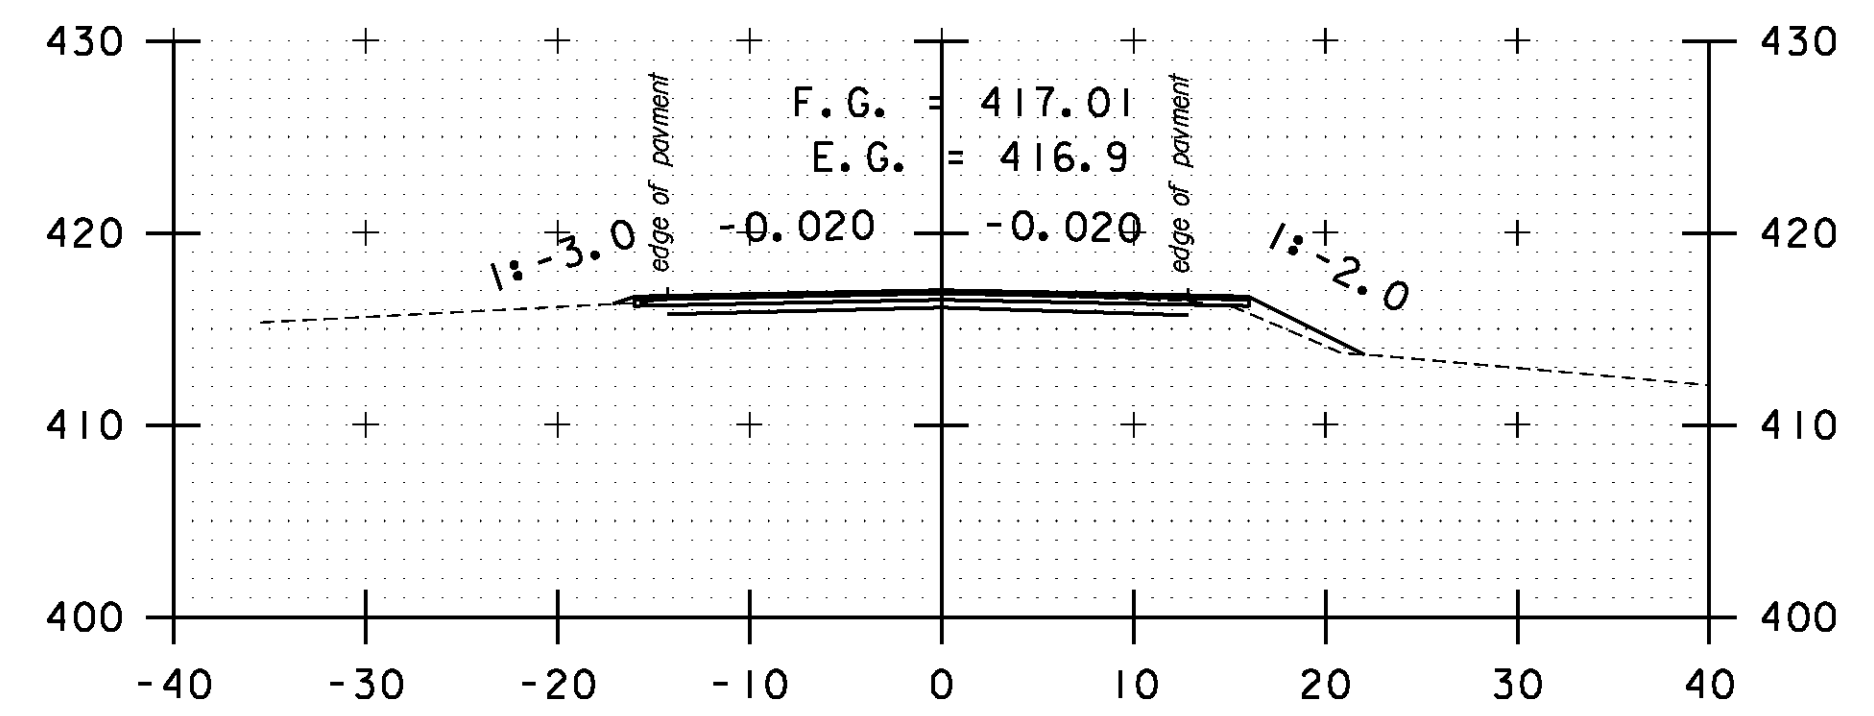


A 110+50

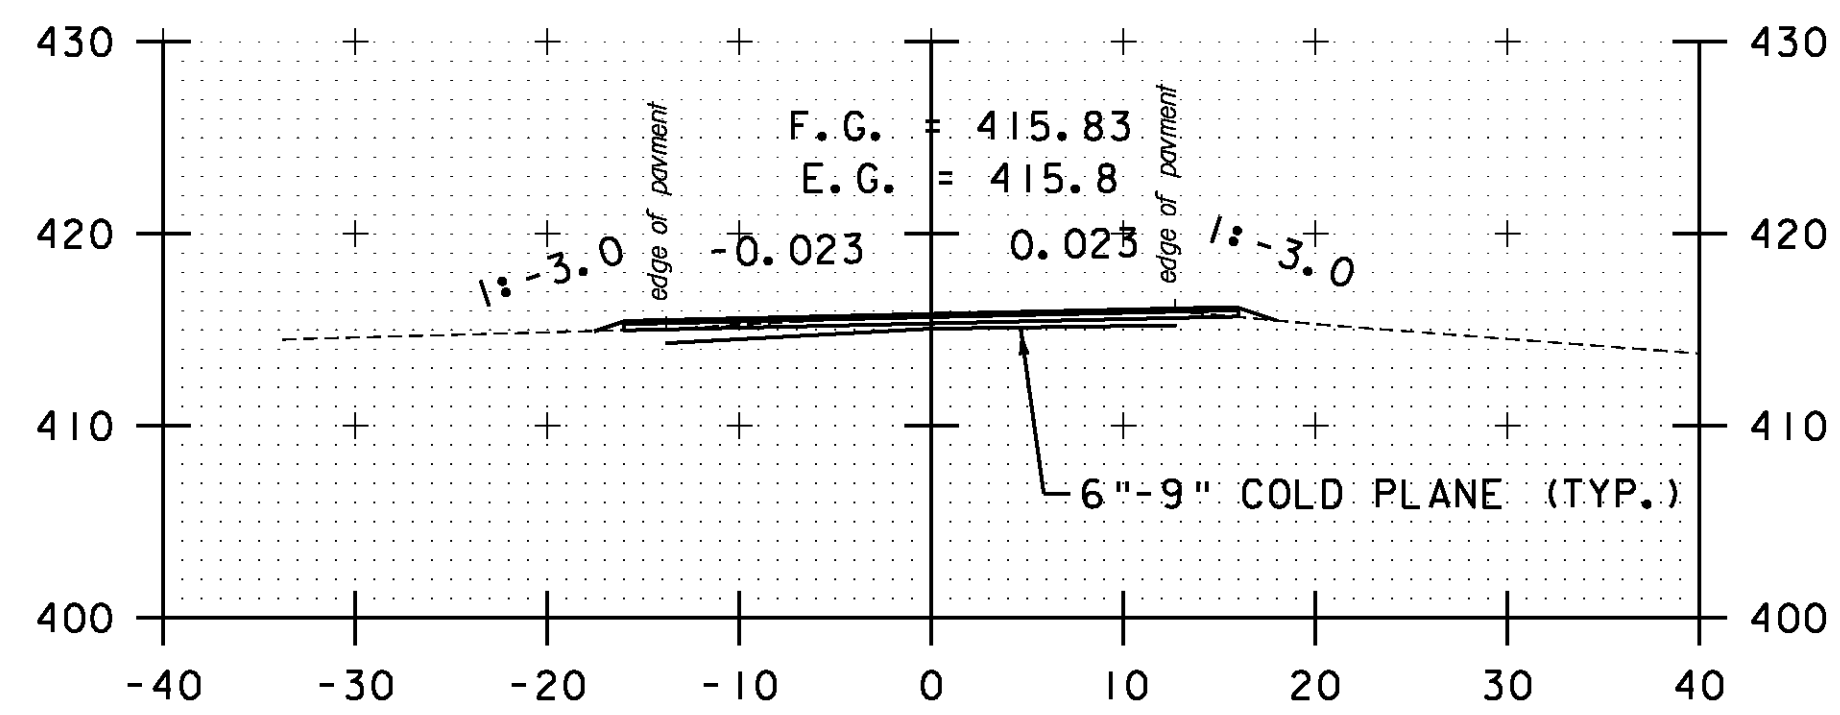


A 107+00

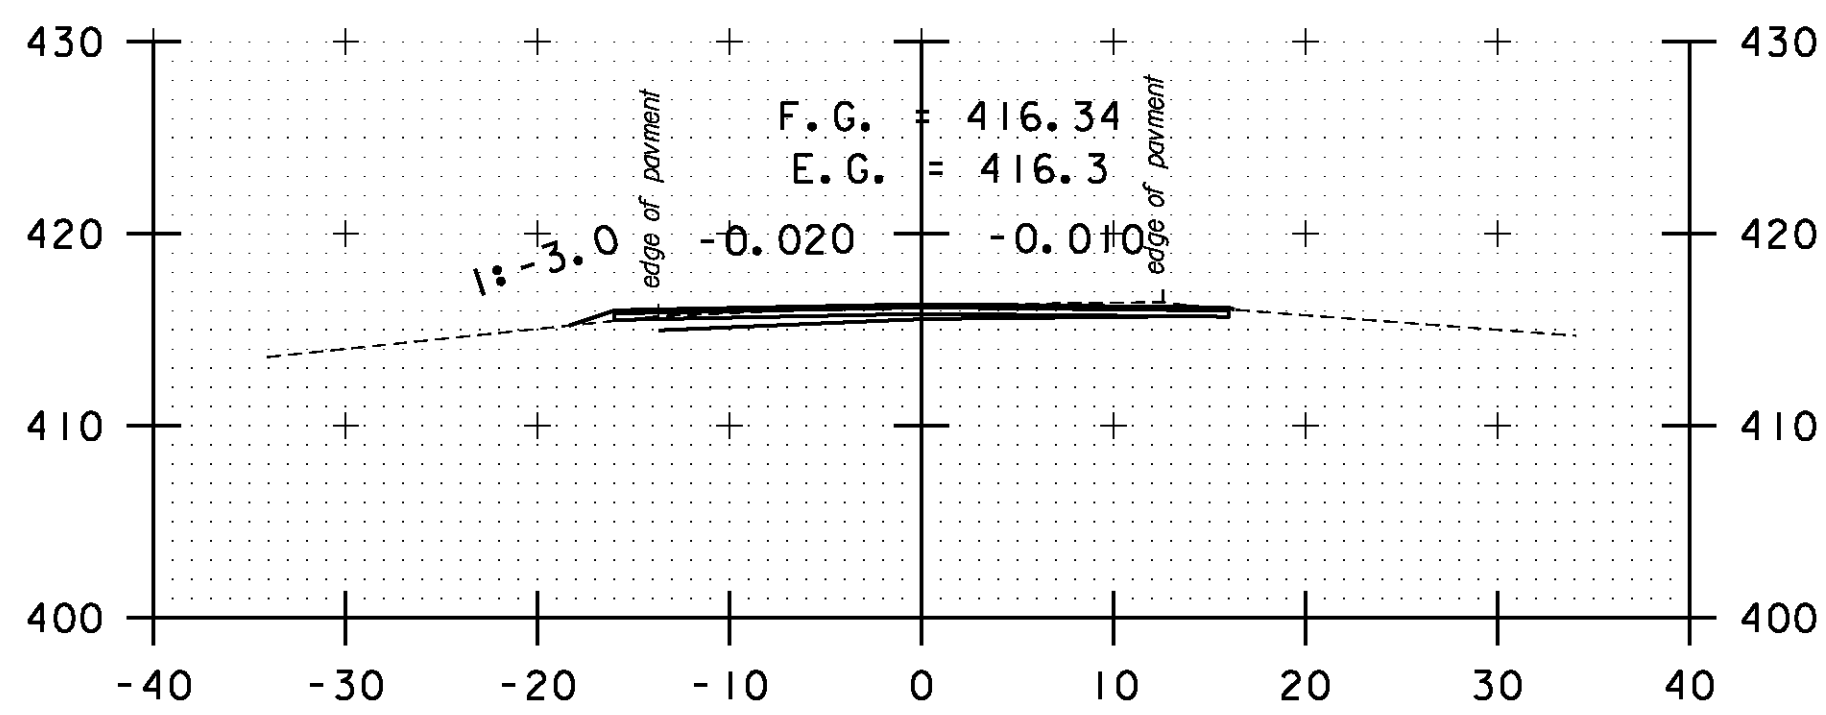


A 108+50

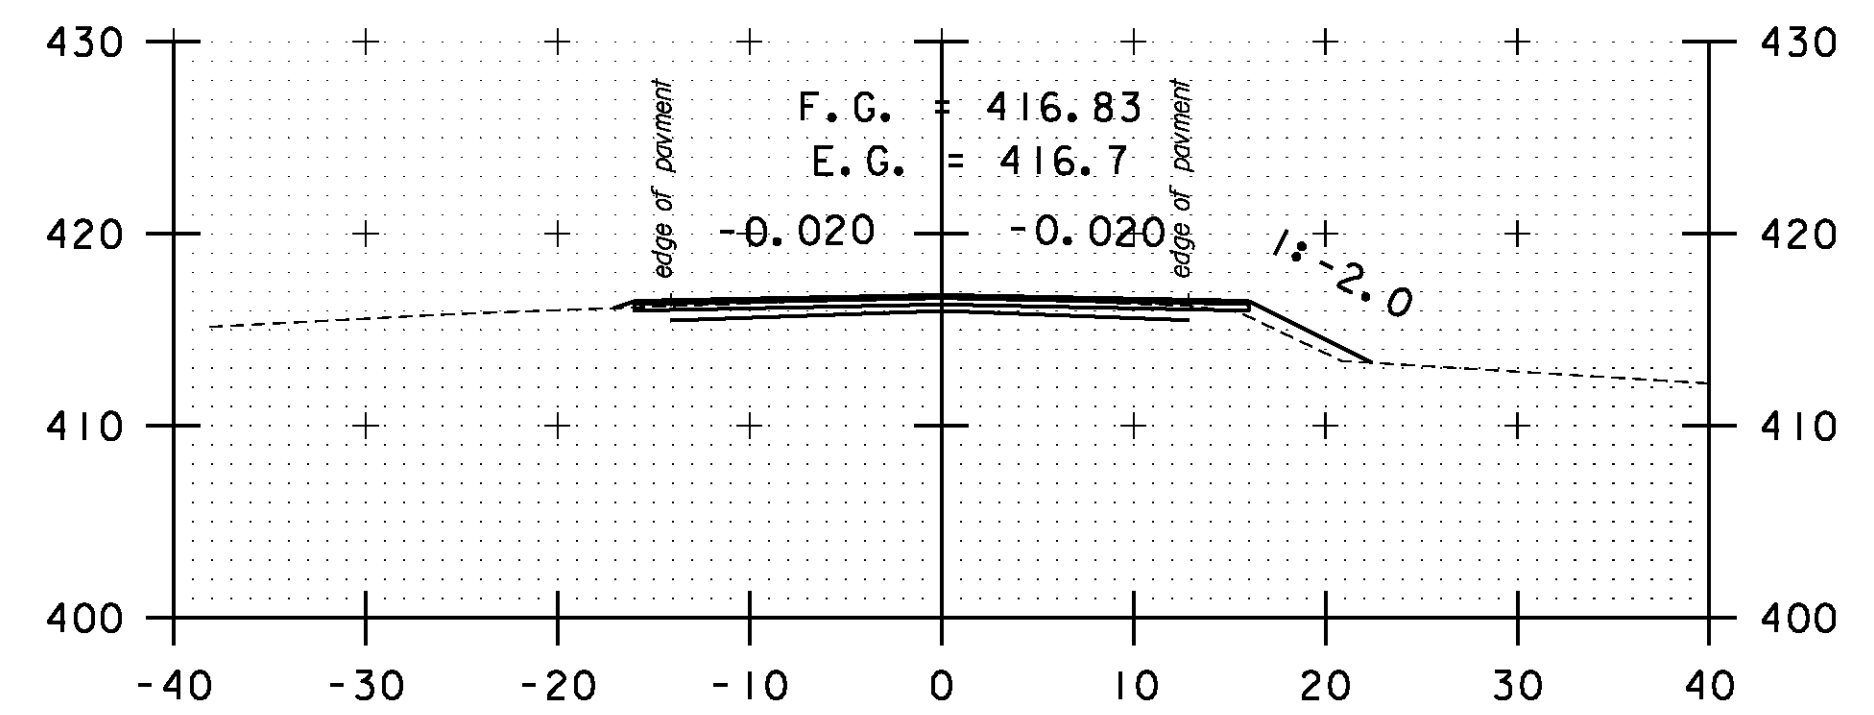


A 110+00

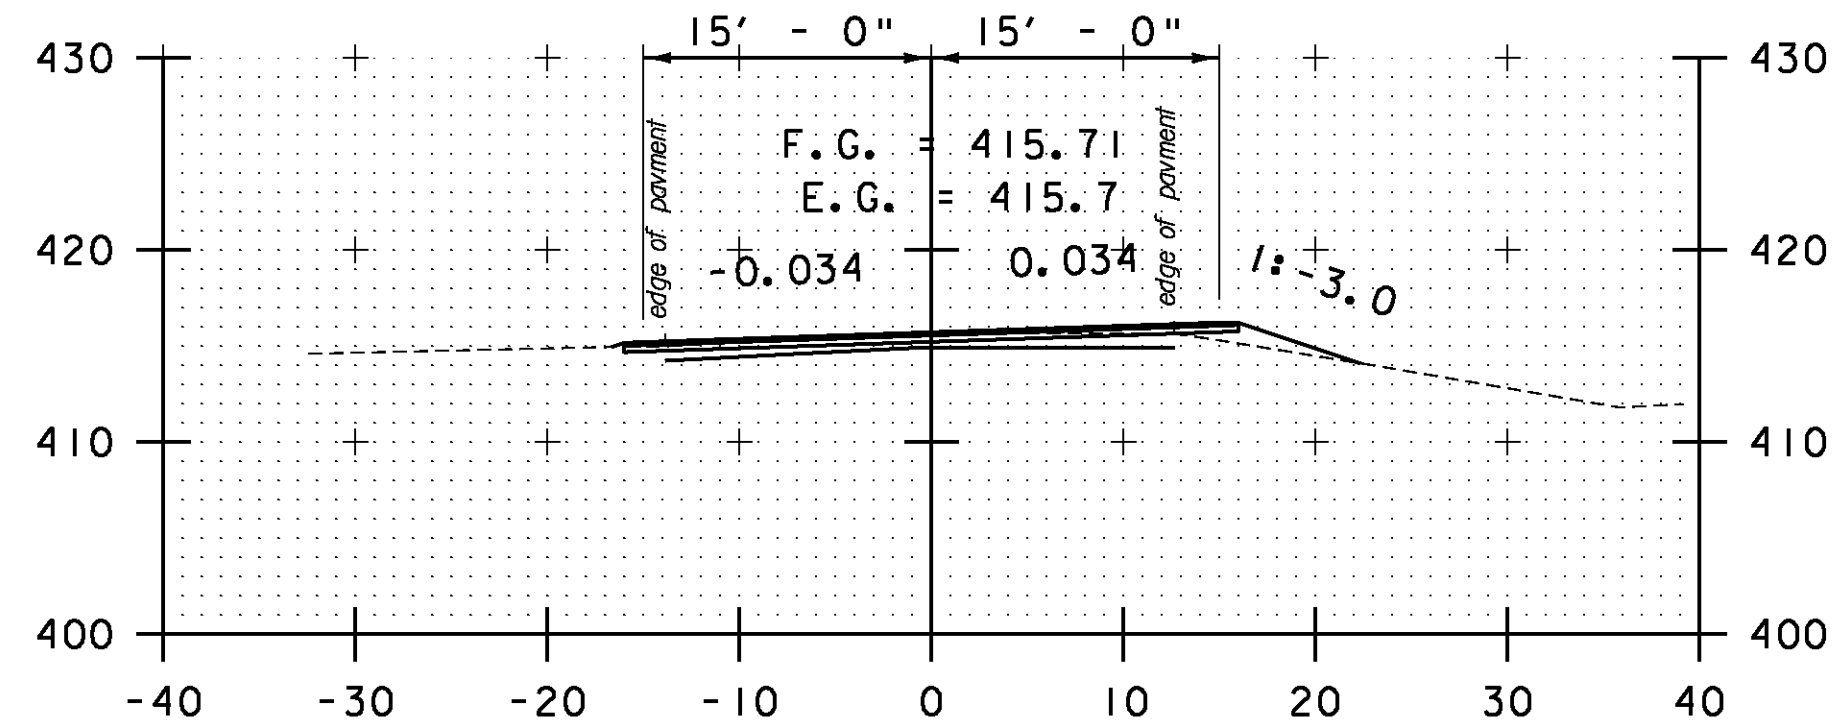

A 106+50

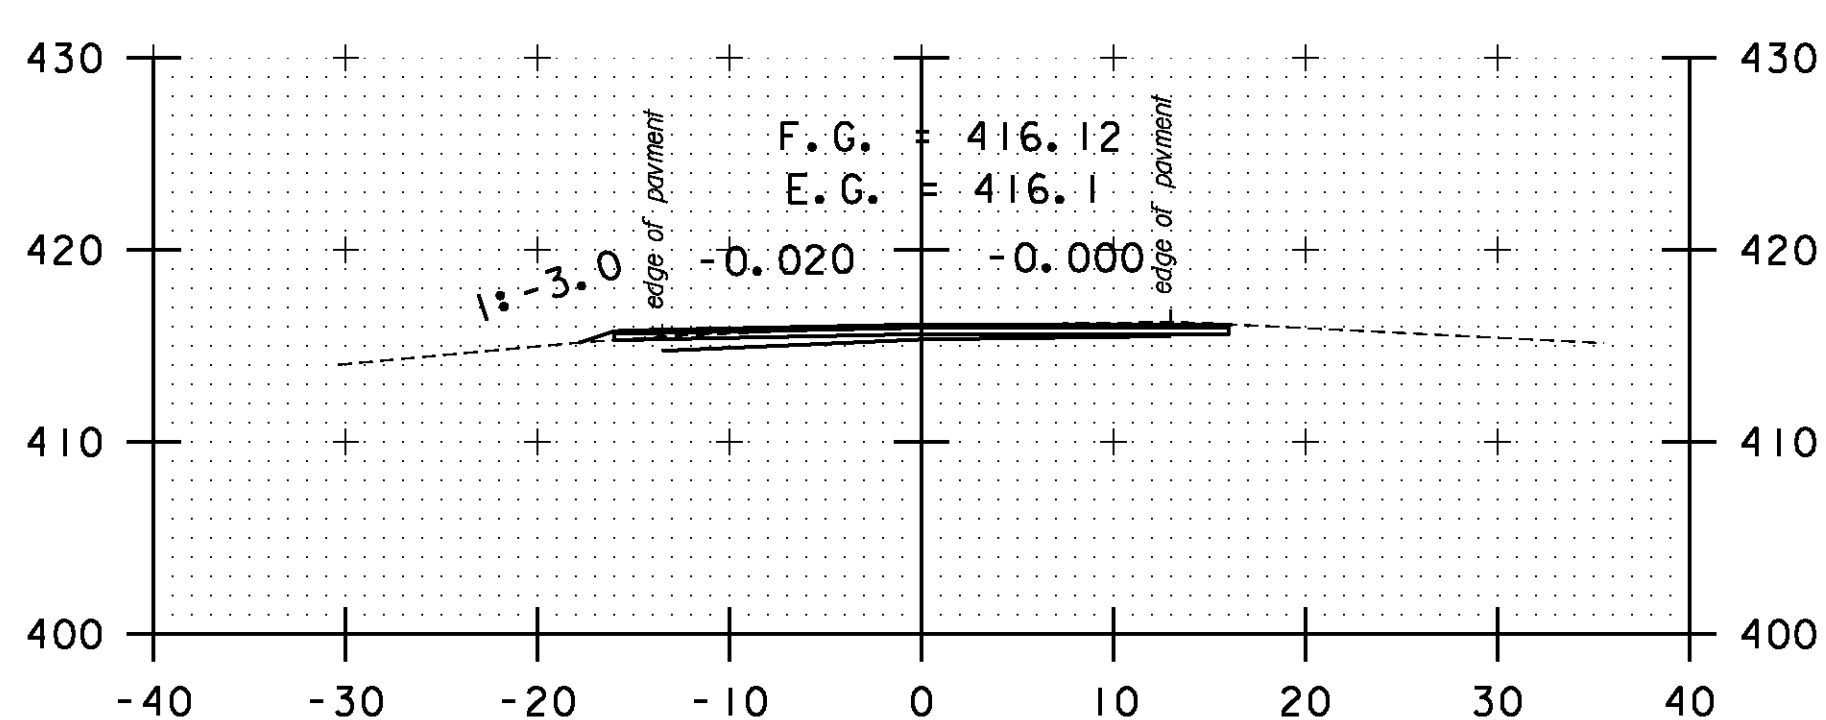

A 108+00

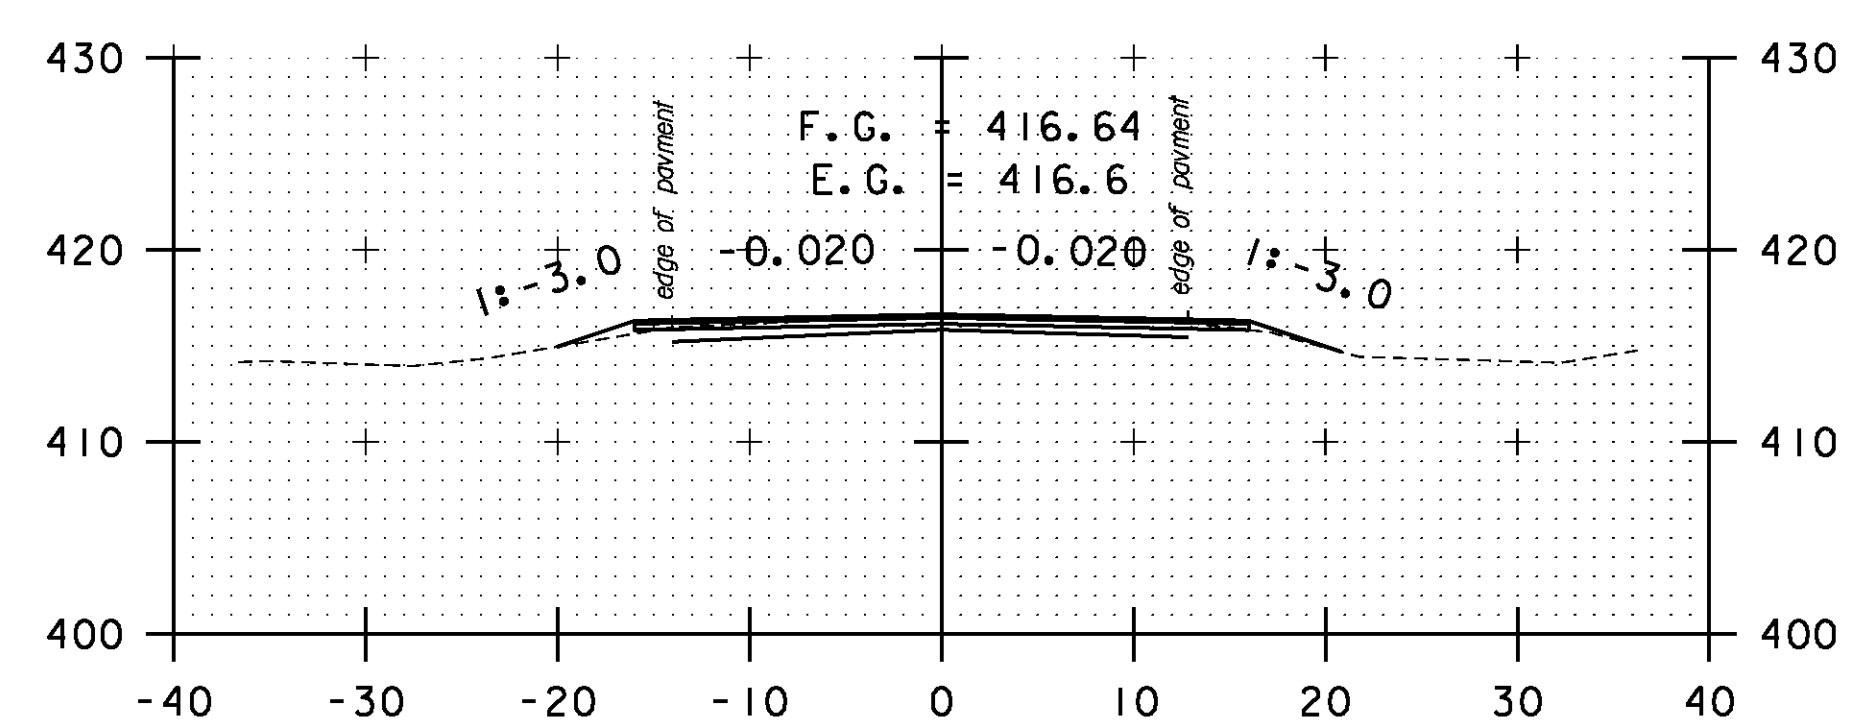

A 109+50

STA. A 106+50 TO STA. A 110+50

SCALE 1" = 10'-0"

CROSS SECTION SHEET 71

PROJECT NAME: BOLTON-WATERBURY

PROJECT NUMBER: STP 2709(1)

FILE NAME: p07c172.dgn

PROJECT LEADER: CDL

DESIGNED BY: BMB

PLOT FILE: p07c172_197.1

PLOT DATE: 4/16/2013

DRAWN BY: BMB

CHECKED BY: CDL

SHEET 197 OF 217