




A 121+00

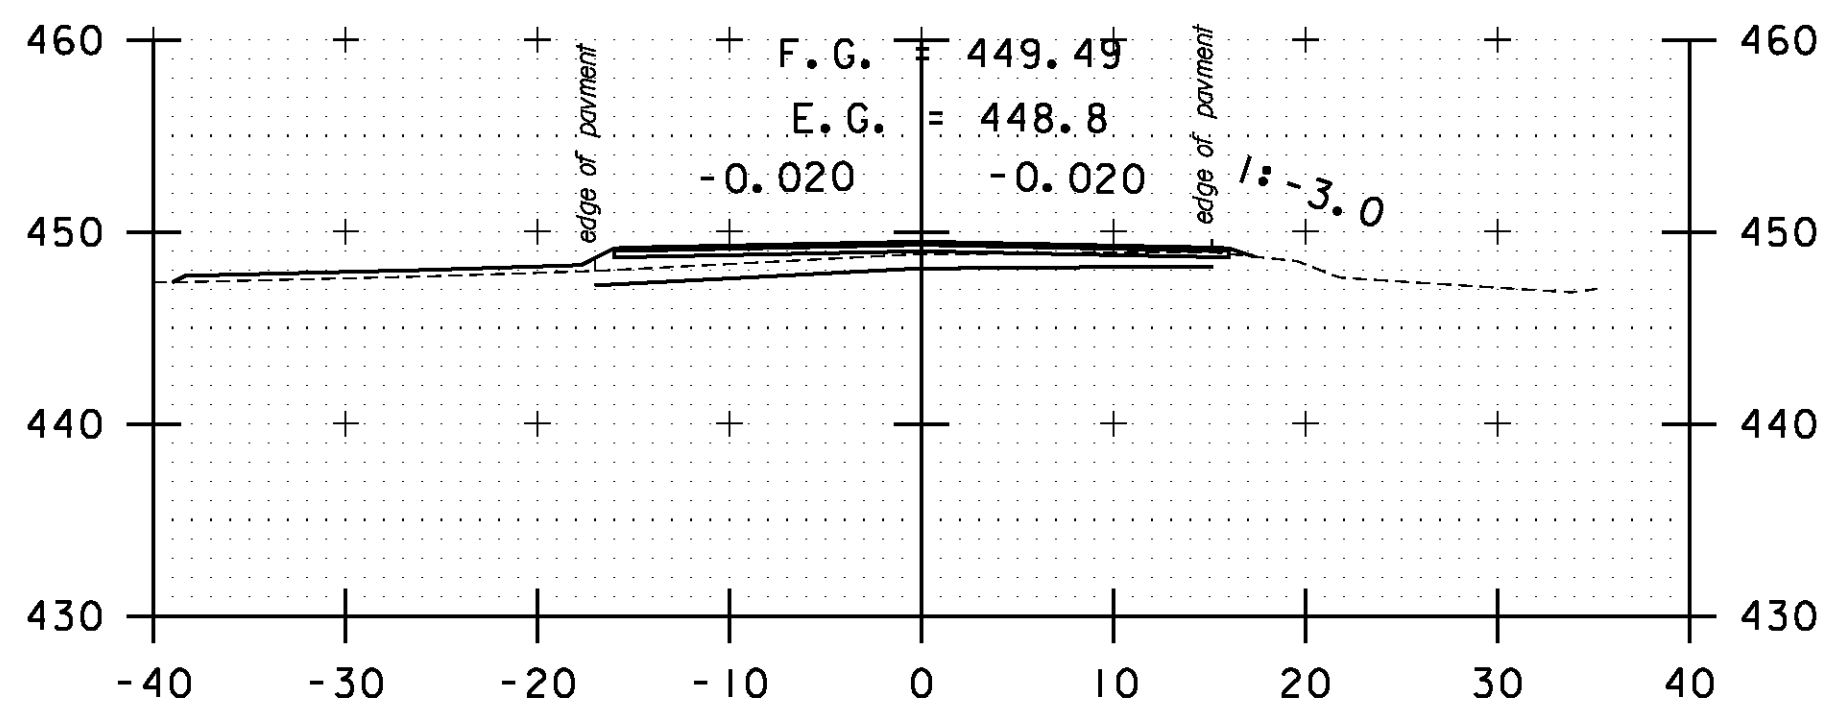


PULL OFF LT
A 122+50

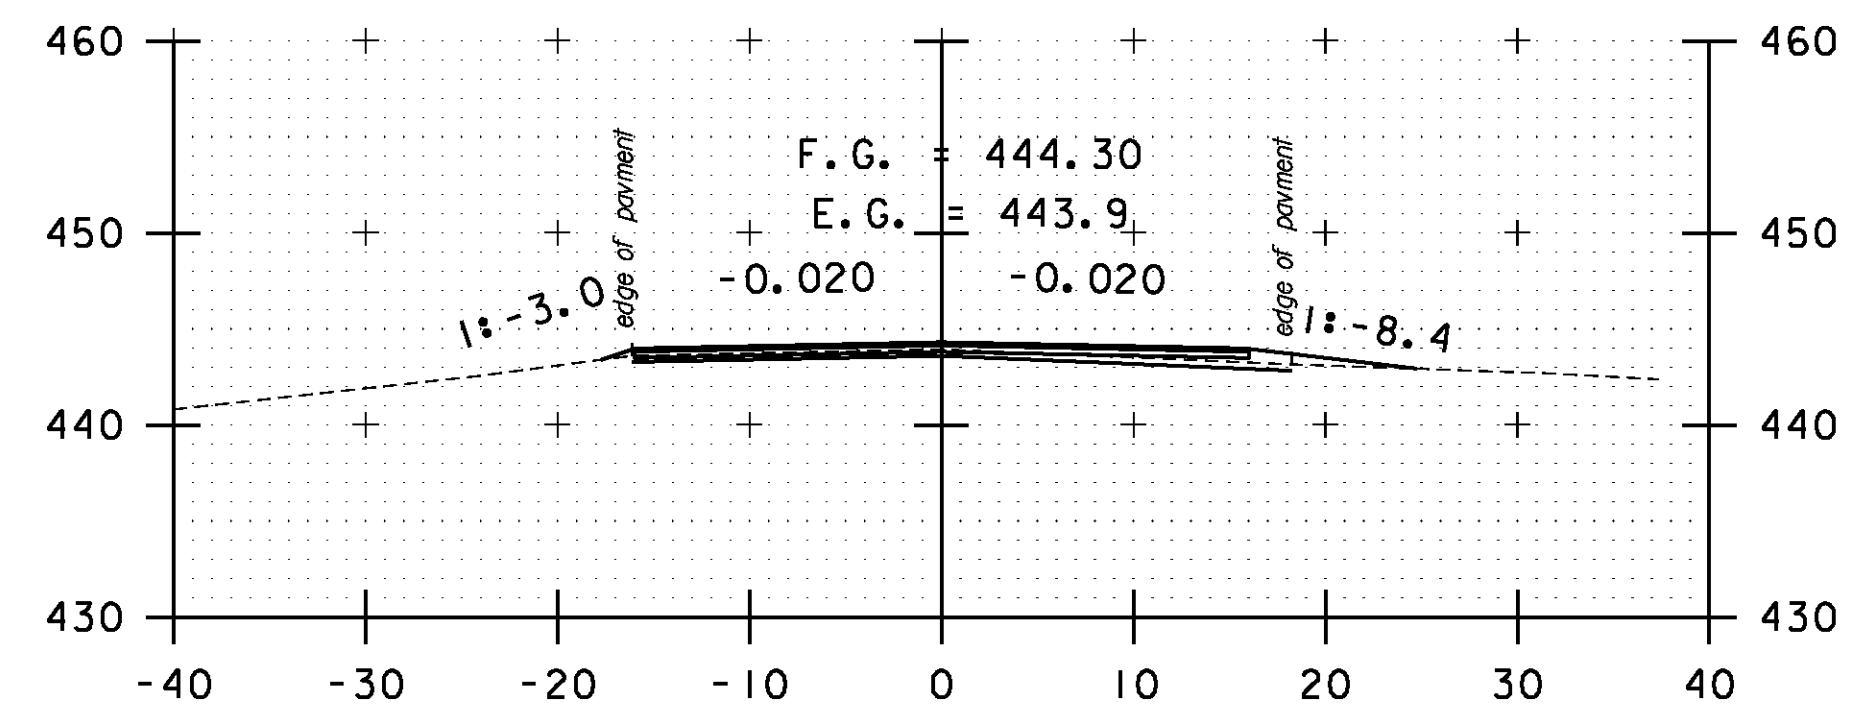


DRIVE RT
A 124+00

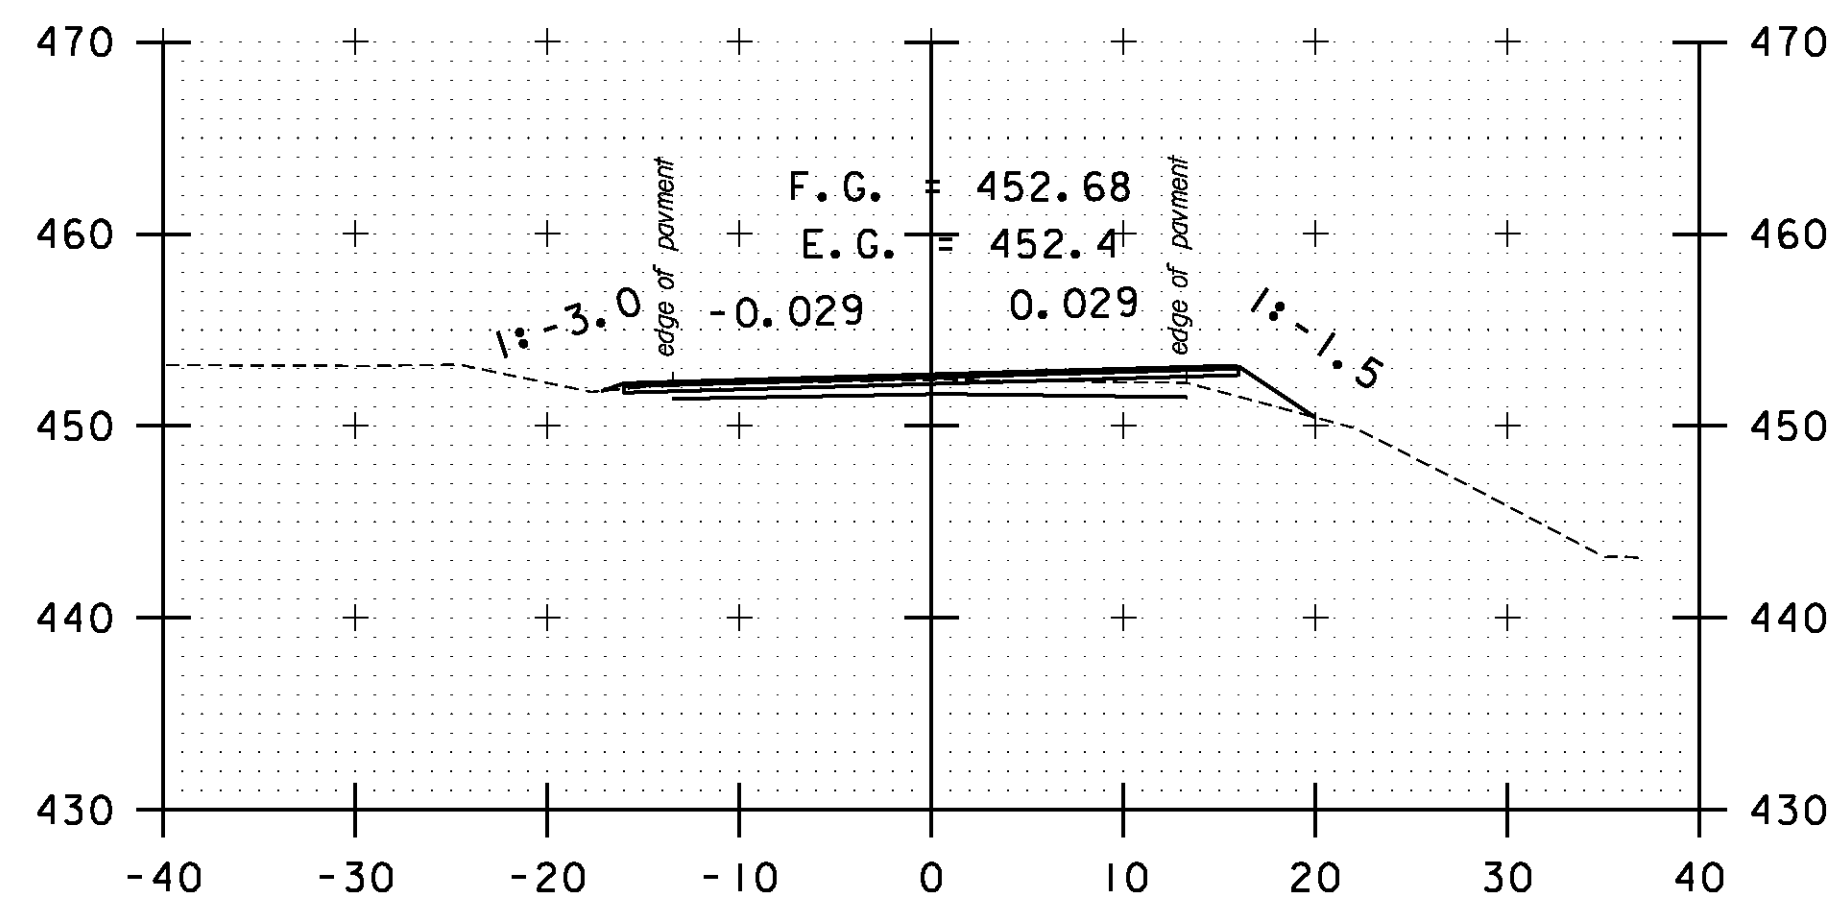


A 120+50

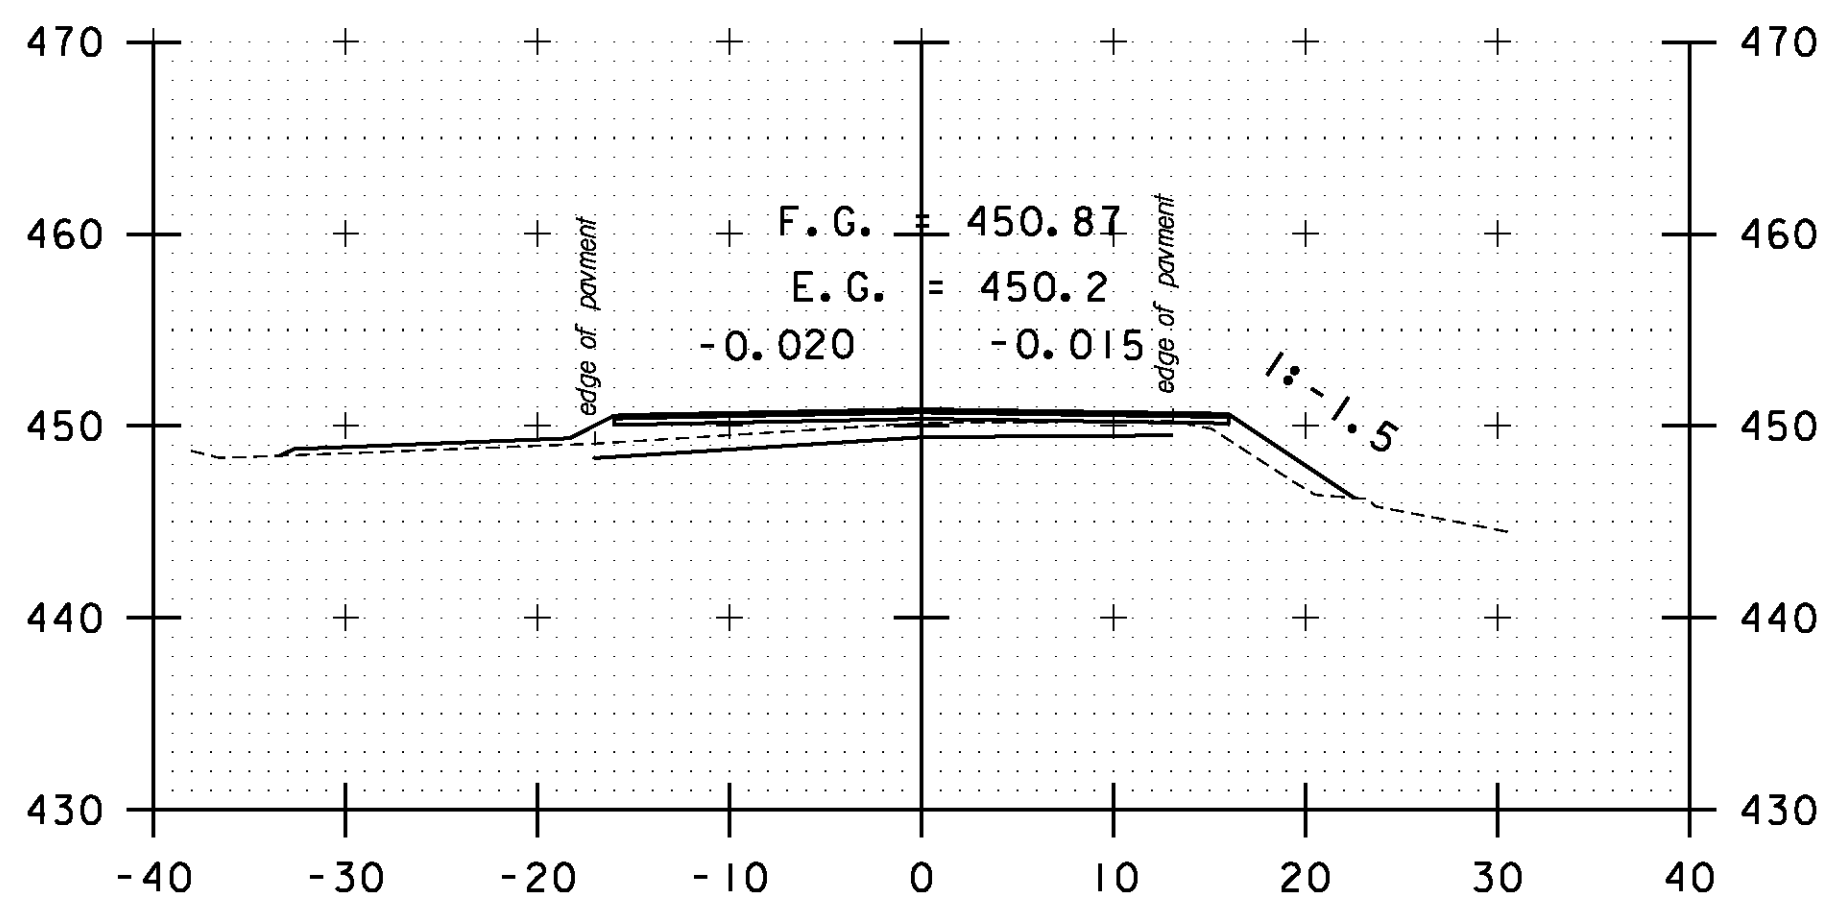


PULL OFF LT
A 122+00

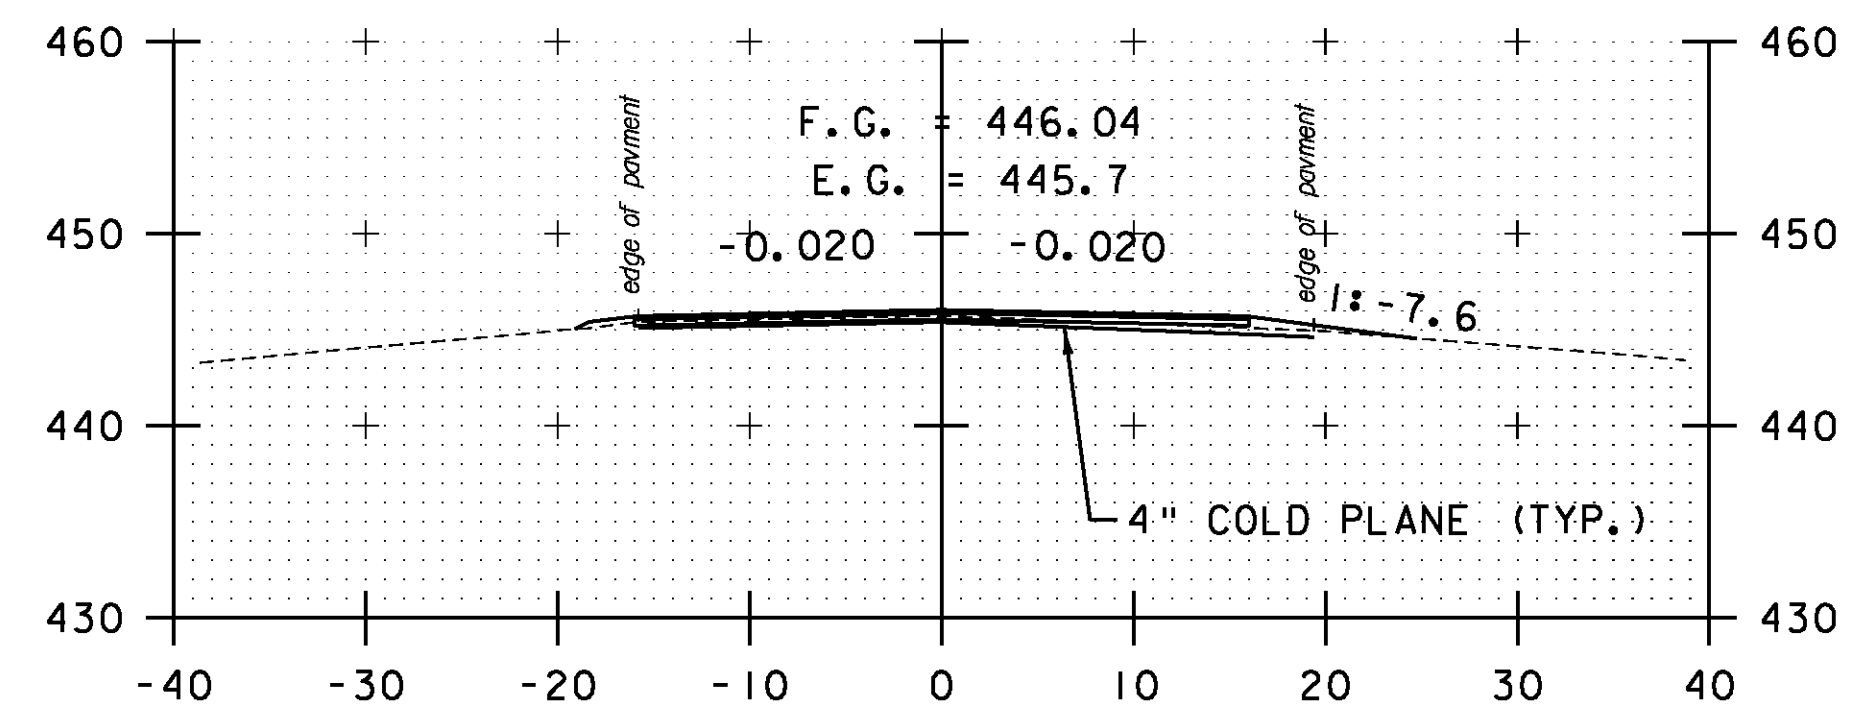


PULL OFF LT / DRIVE RT
A 123+50

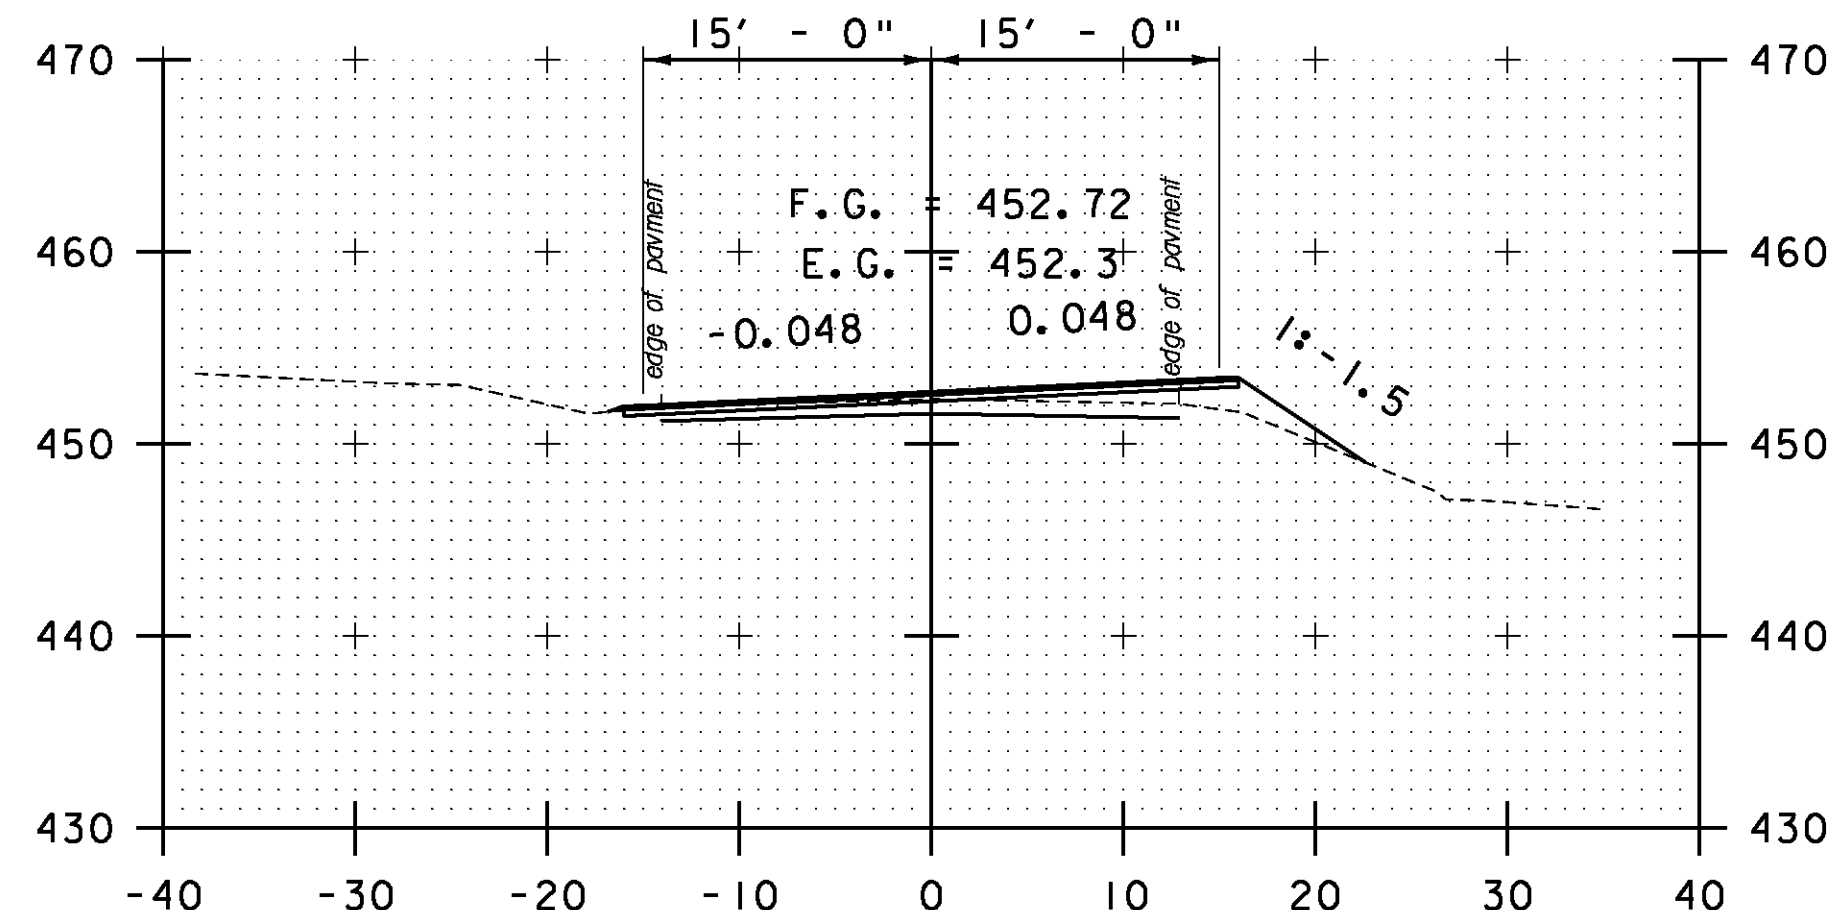

A 120+00

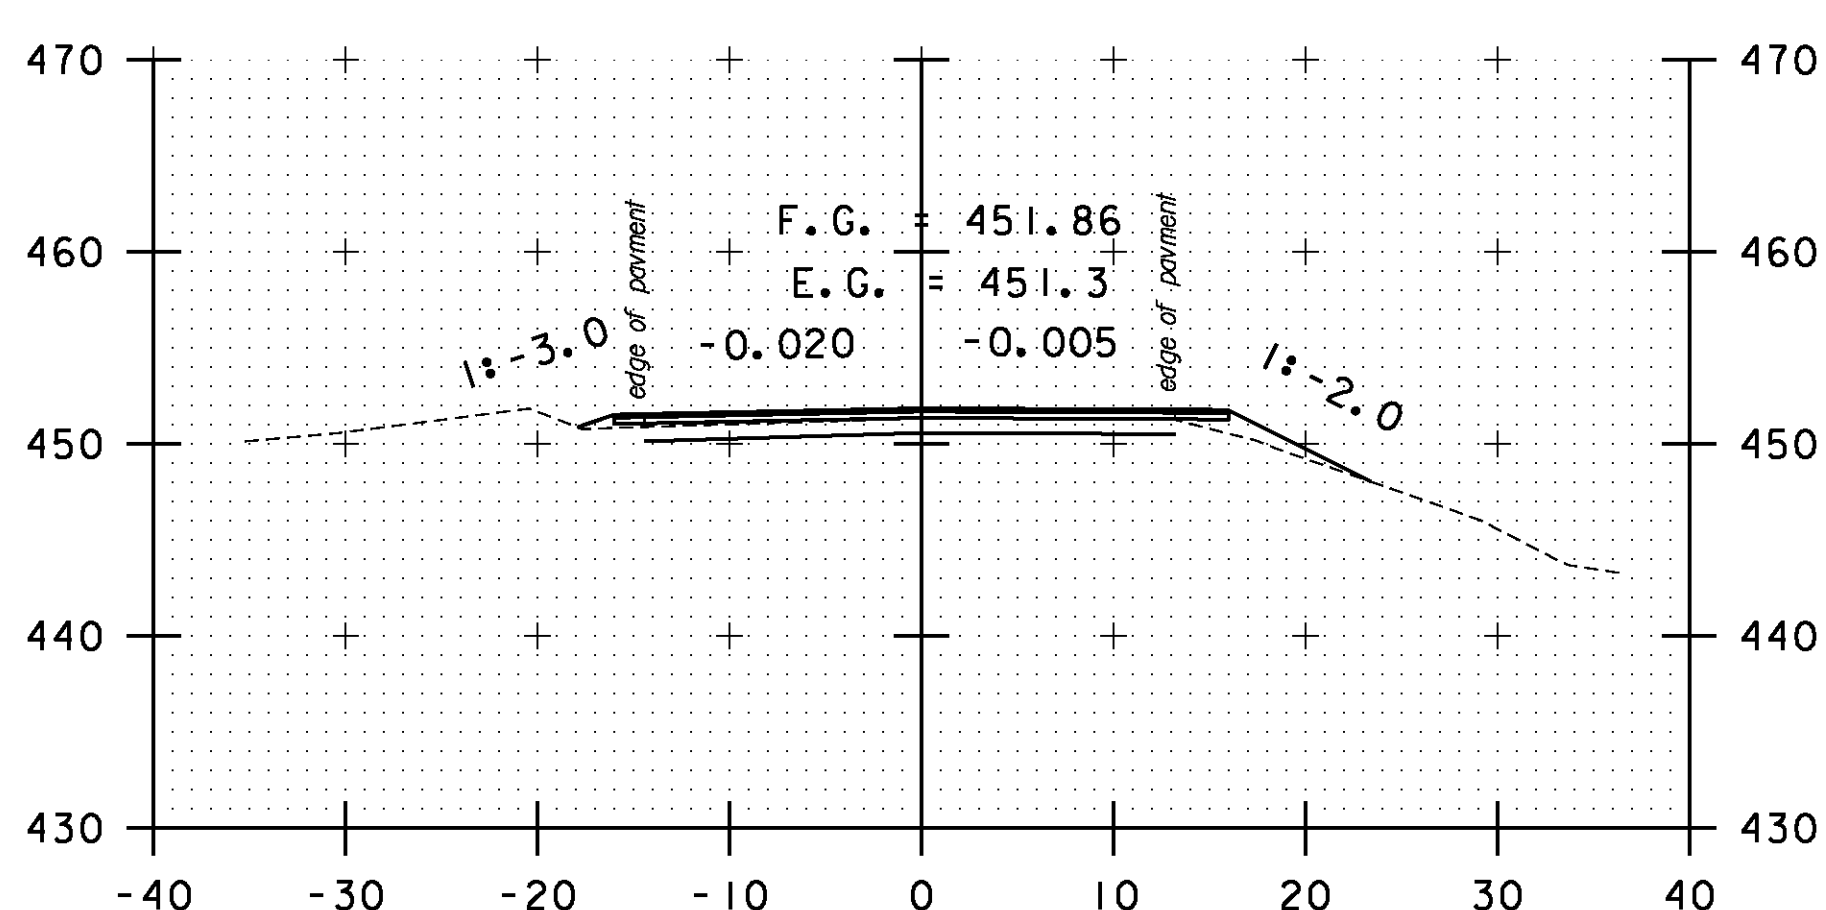


A 121+50

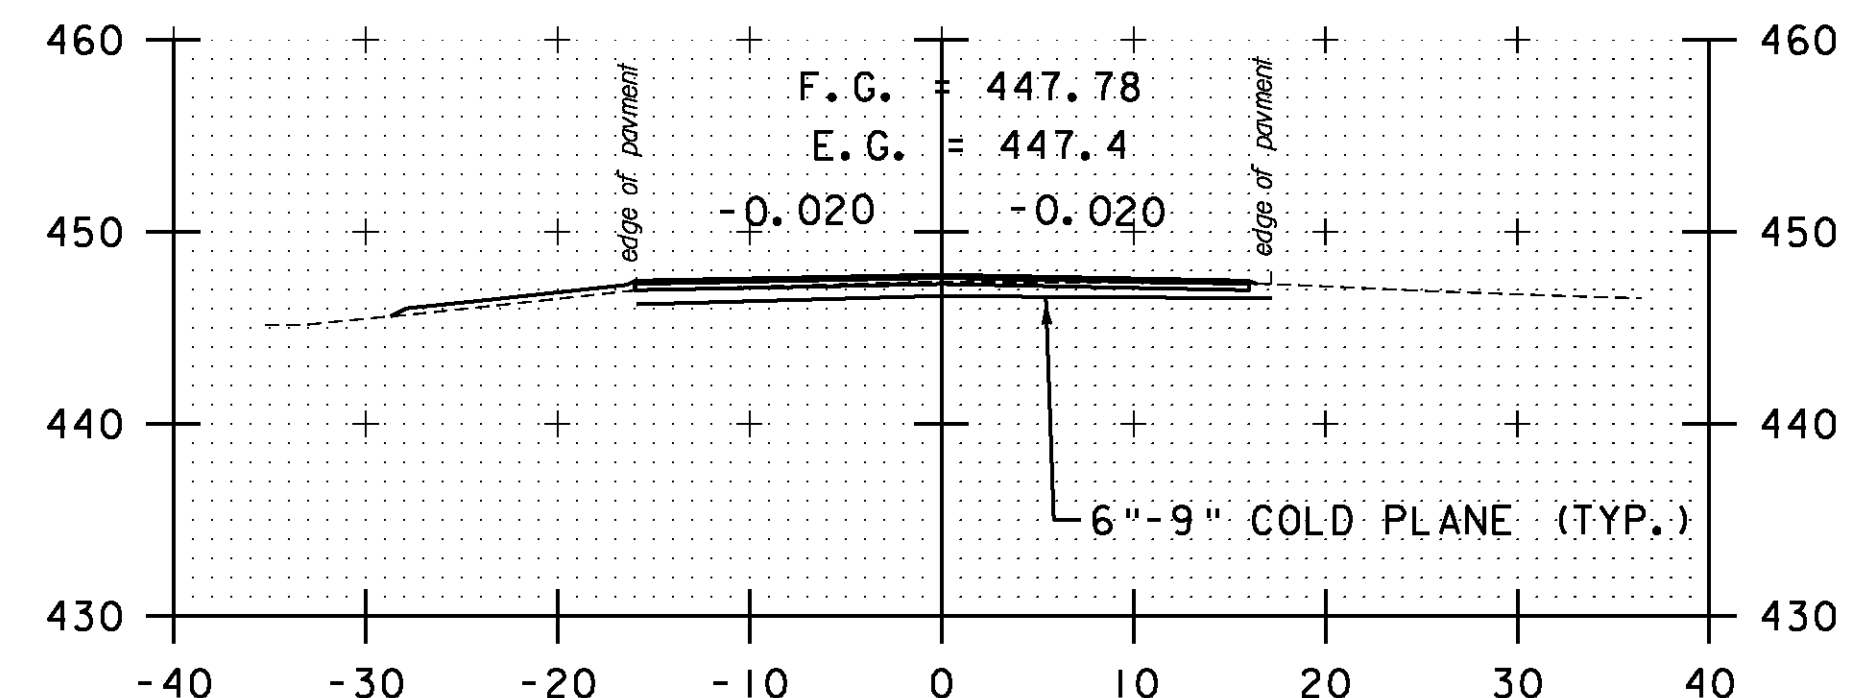

PULL OFF LT
A 123+00

STA. A 120+00 TO STA. A 124+00

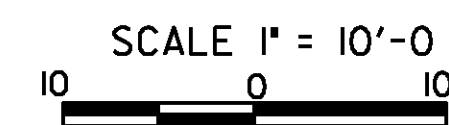

CROSS SECTION SHEET 74

PROJECT NAME: BOLTON-WATERBURY

PROJECT NUMBER: STP 2709(1)

FILE NAME: p07C172.dgn

PROJECT LEADER: CDL

DESIGNED BY: BMB

PLOT FILE: p07C172-200.l

PLOT DATE: 4/16/2013

DRAWN BY: BMB

CHECKED BY: CDL

SHEET 200 OF 217