




A 125+50

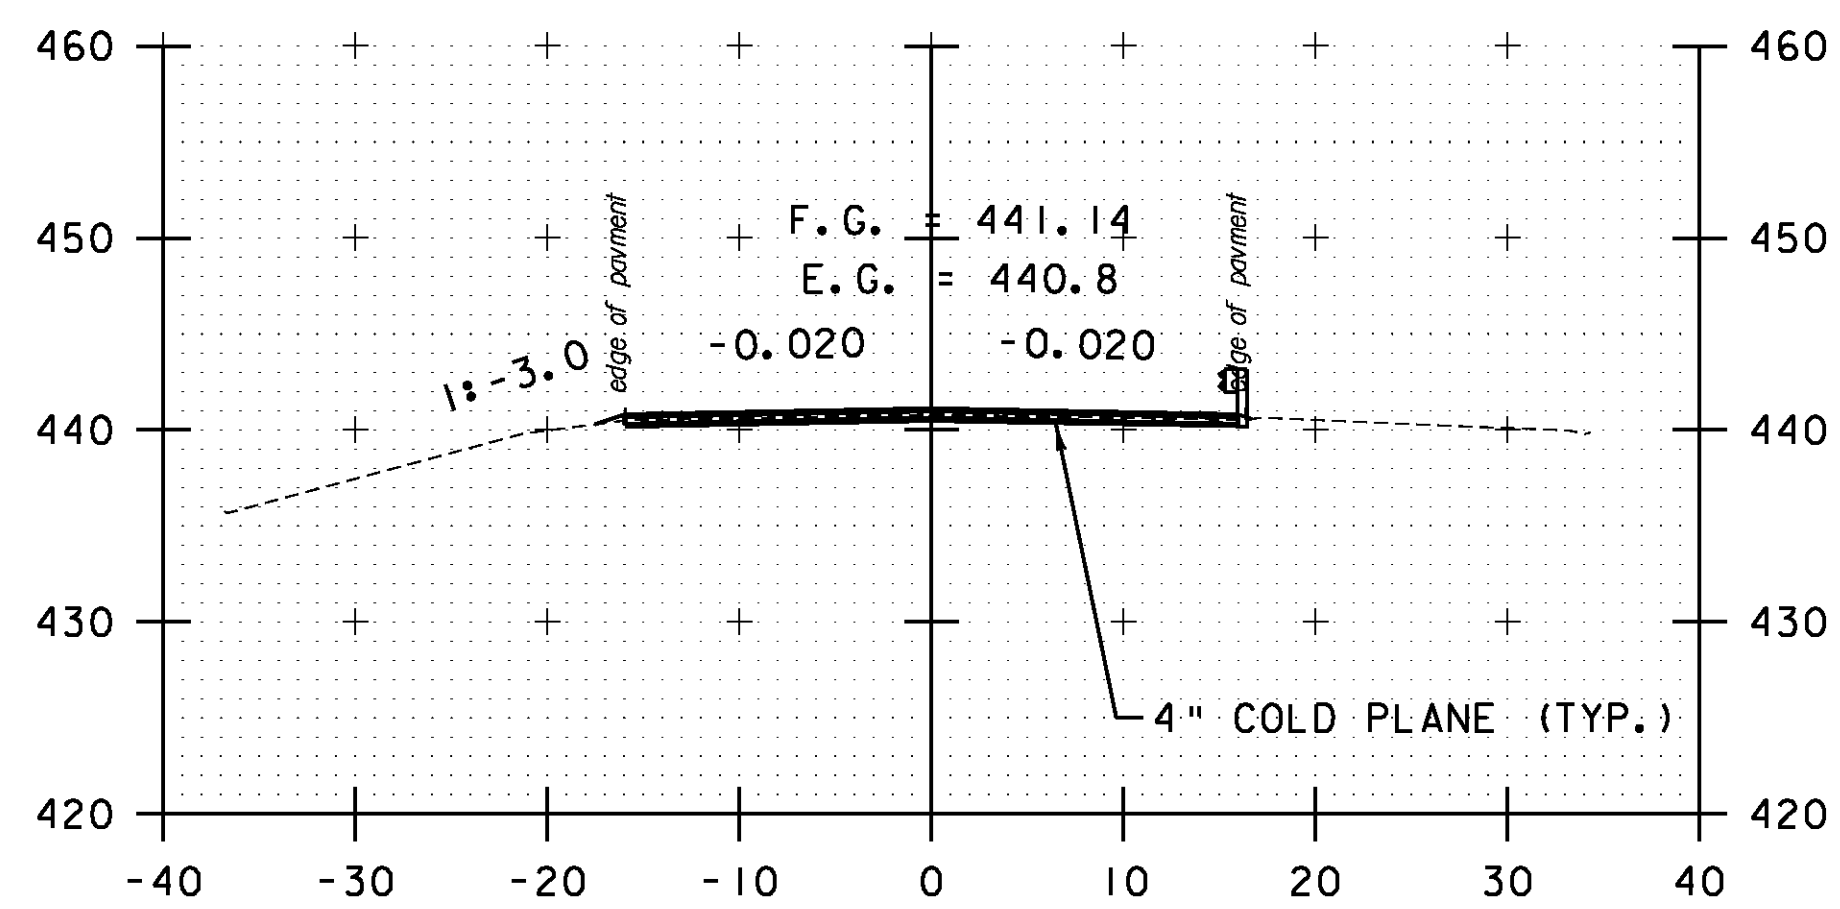


A 125+00

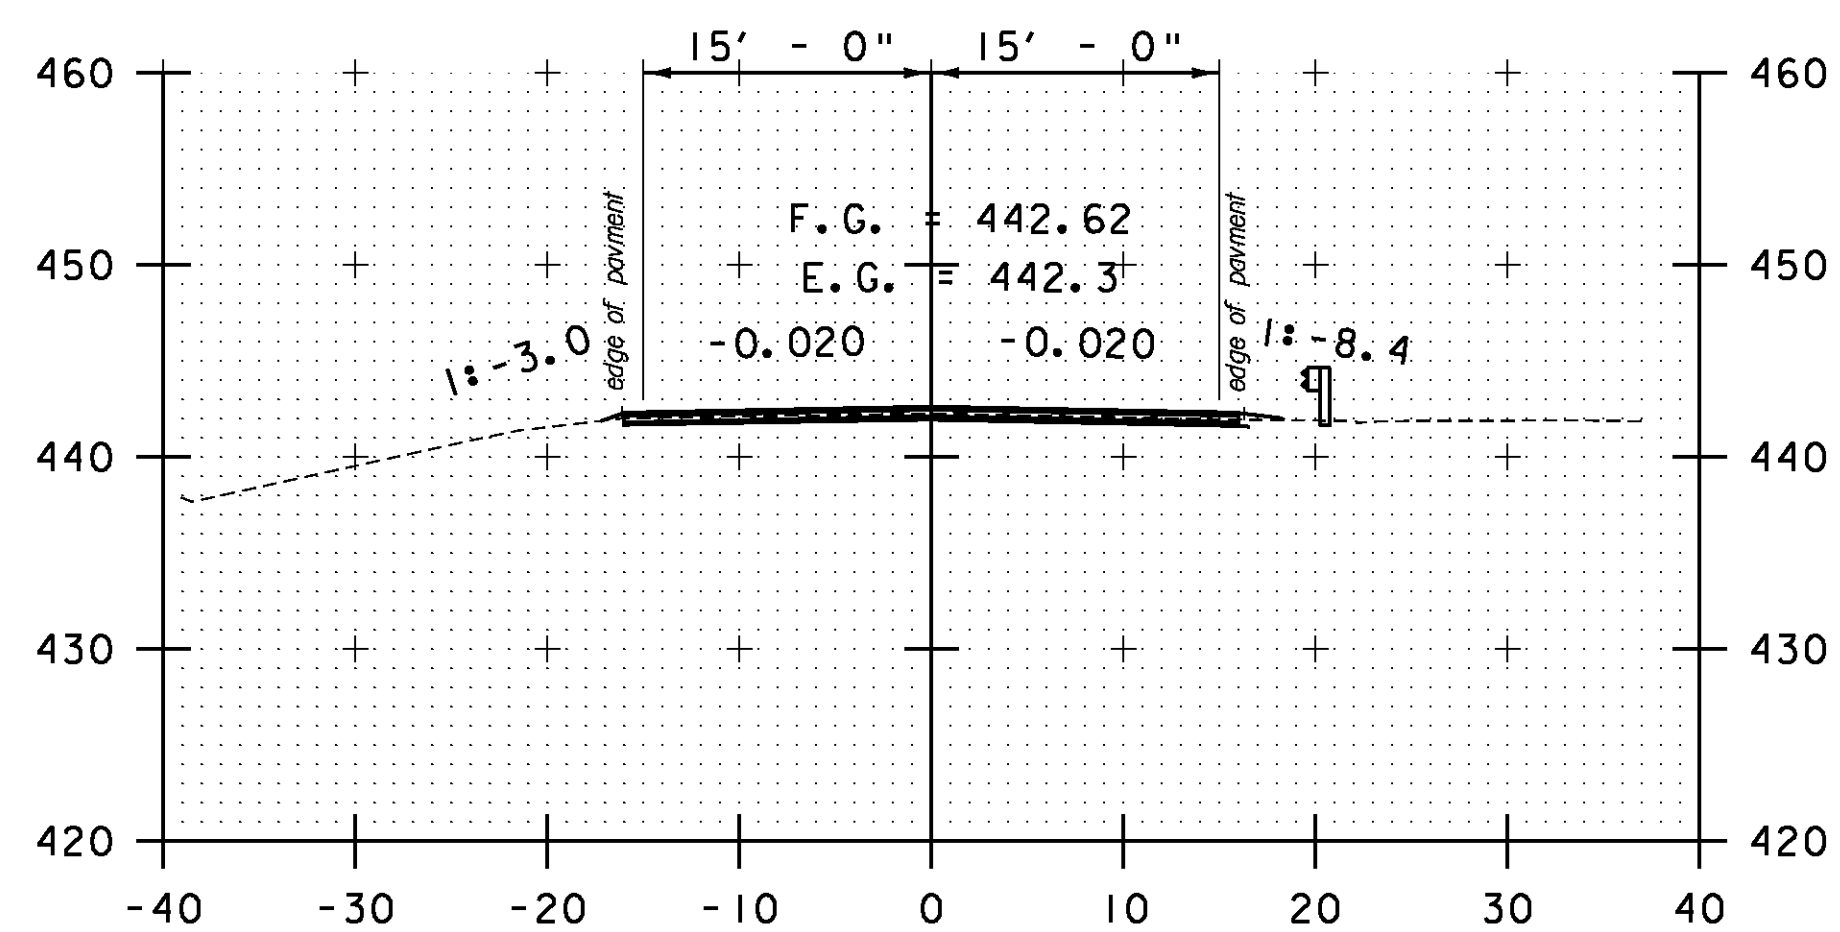


DRIVE RT
A 124+50

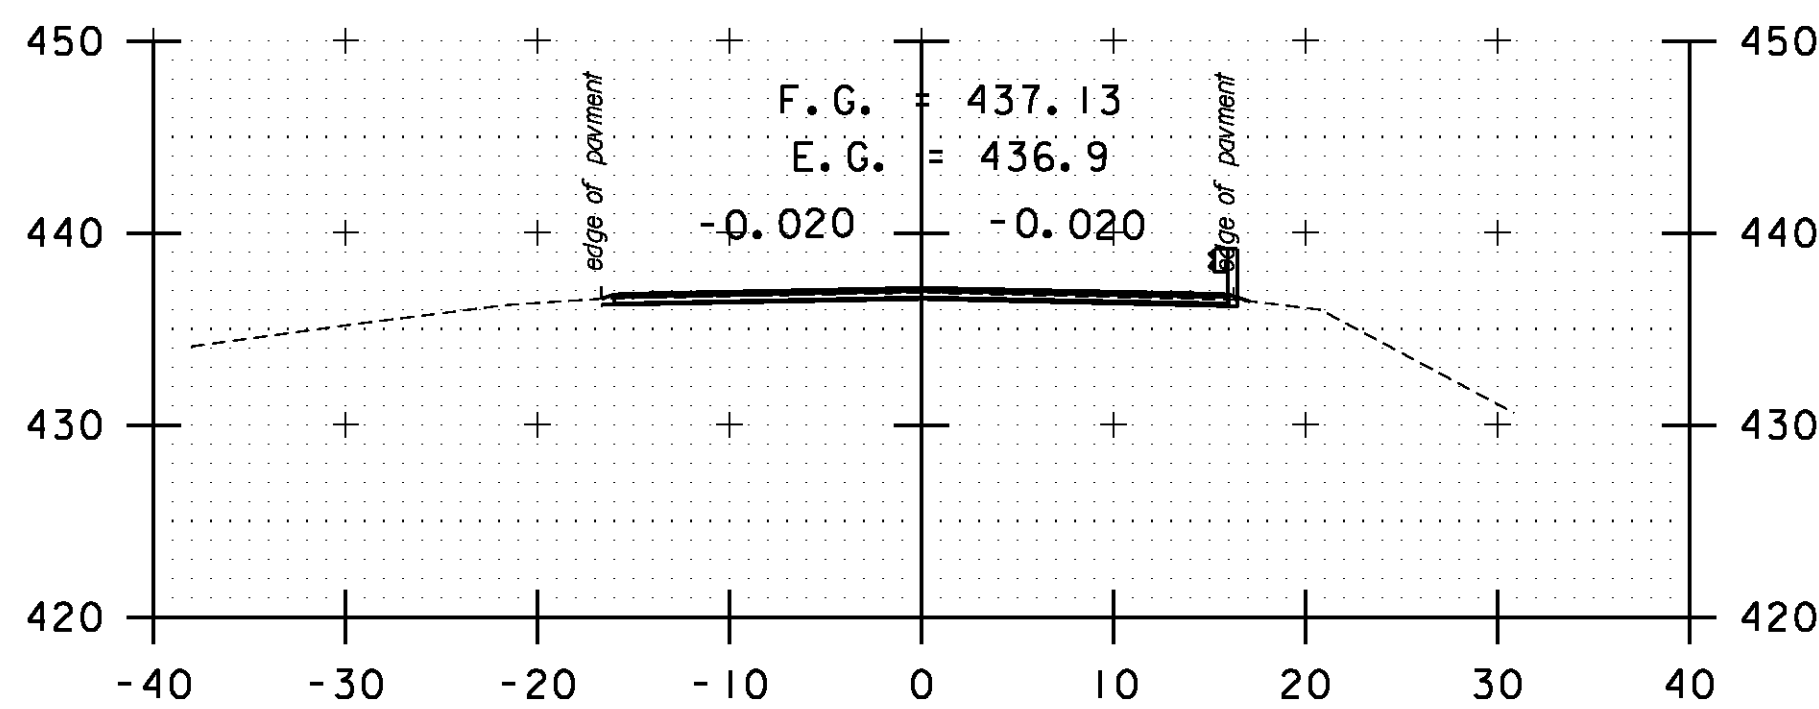


A 127+00

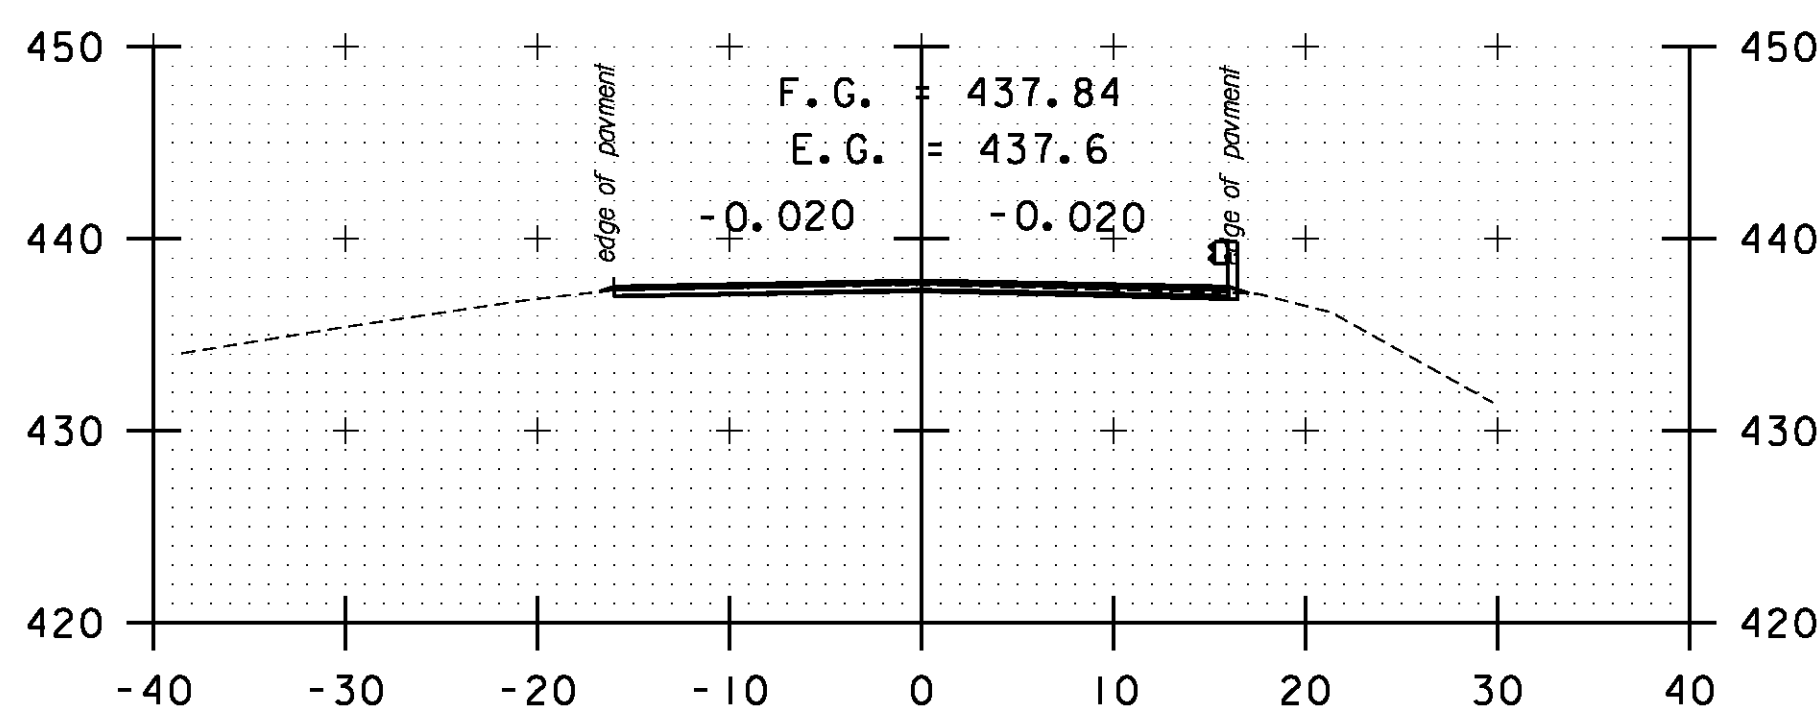


A 126+50

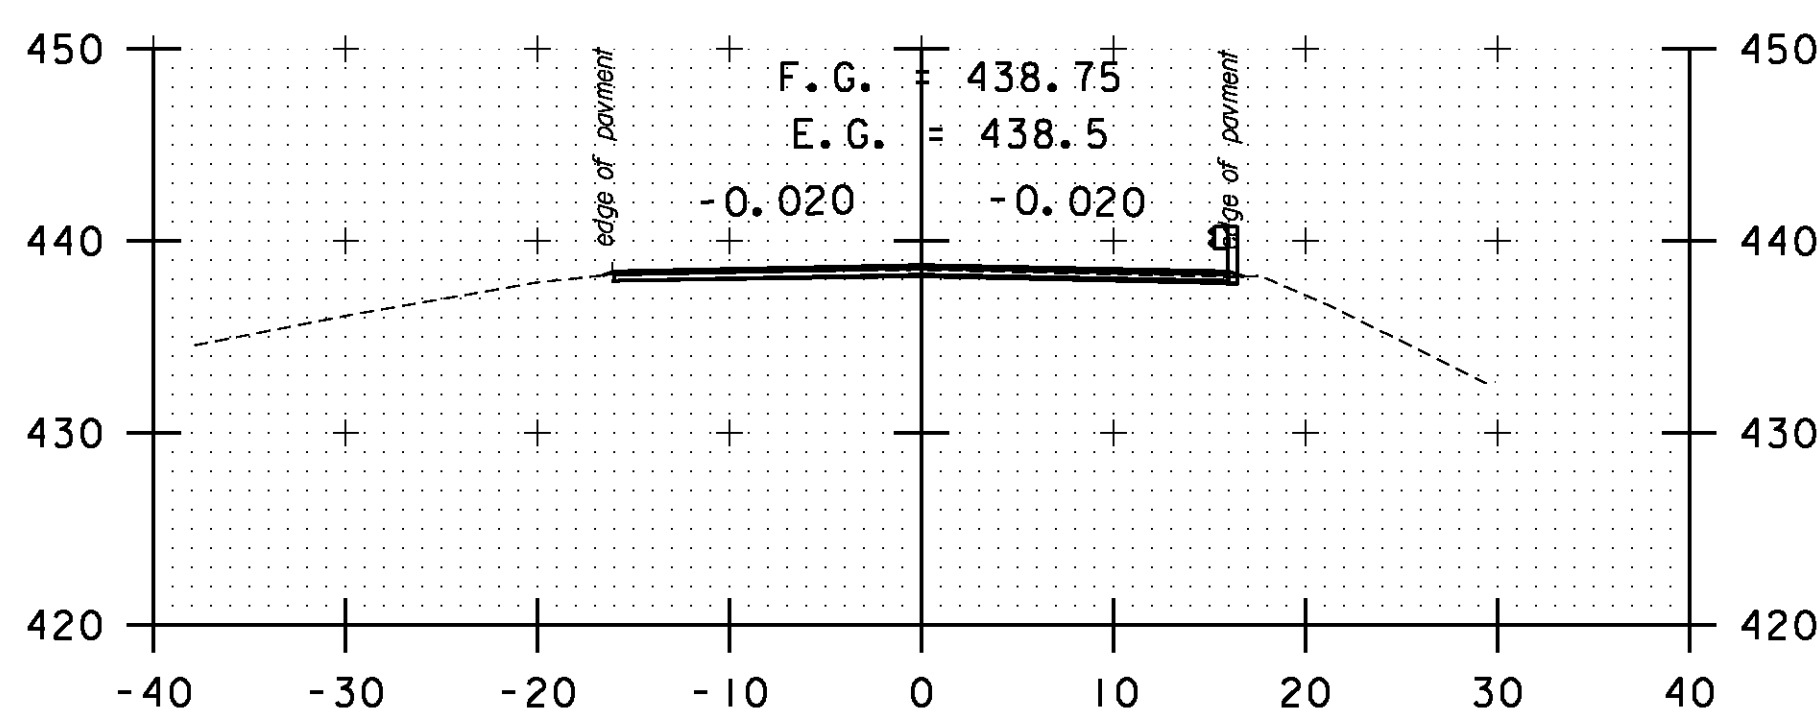


A 126+00

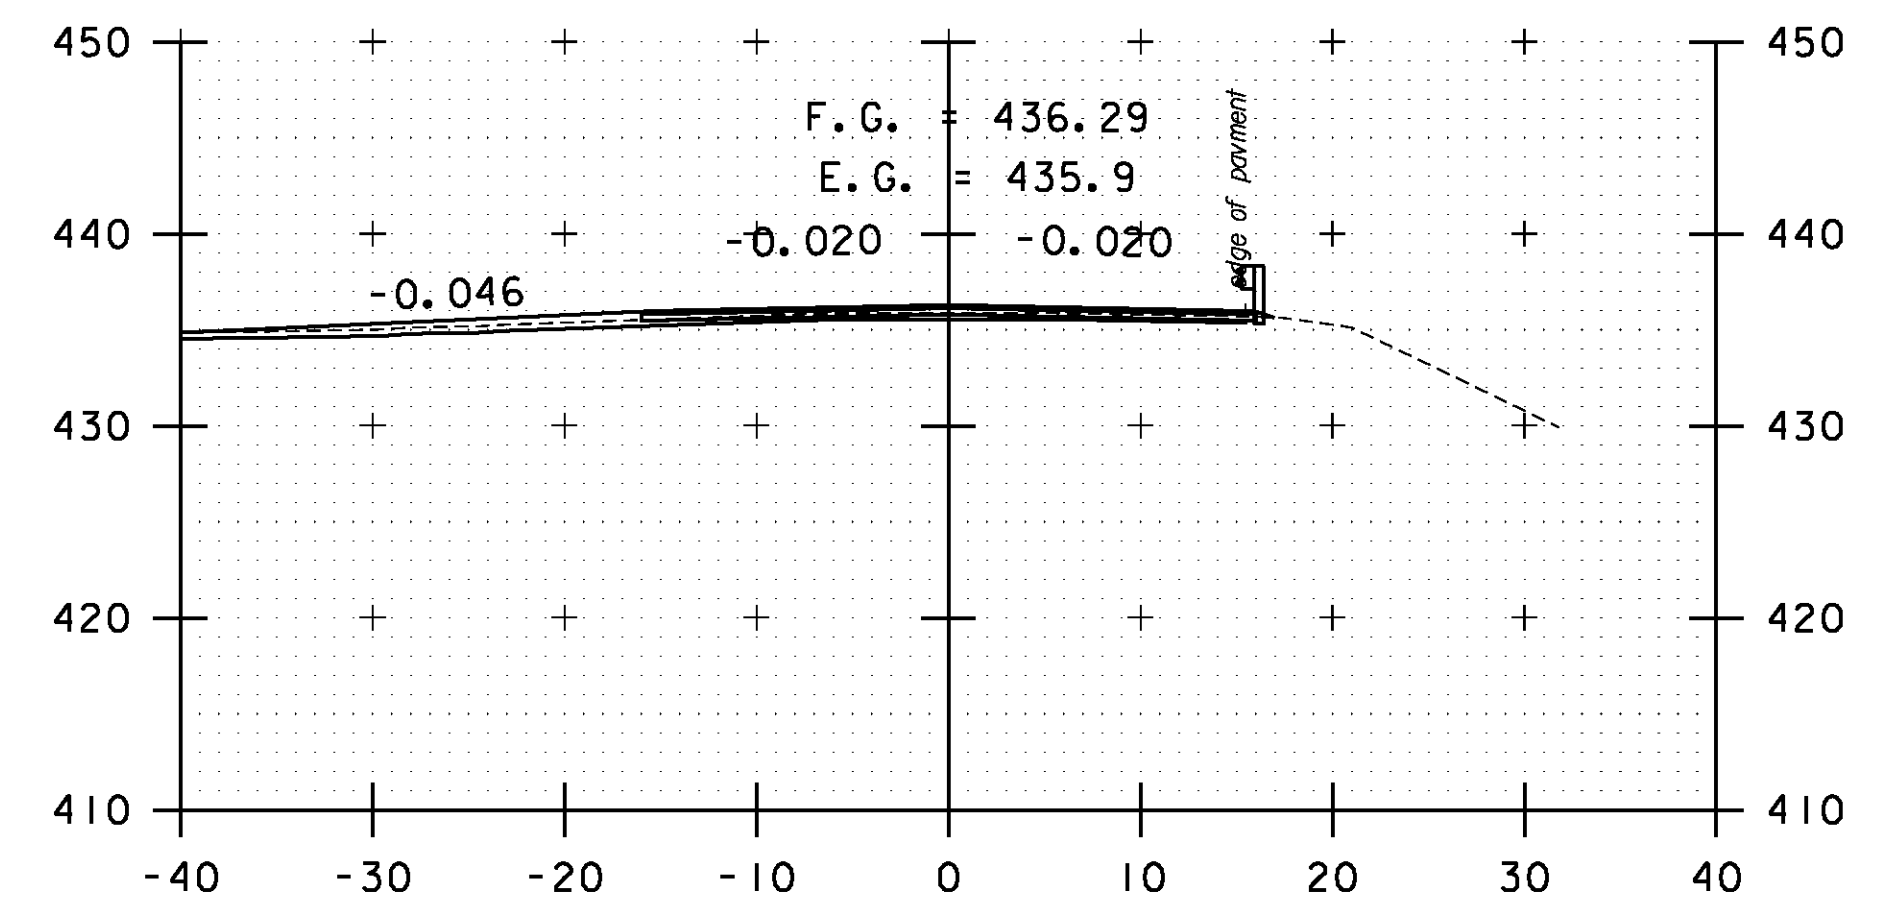

TH#7 LT
A 128+00

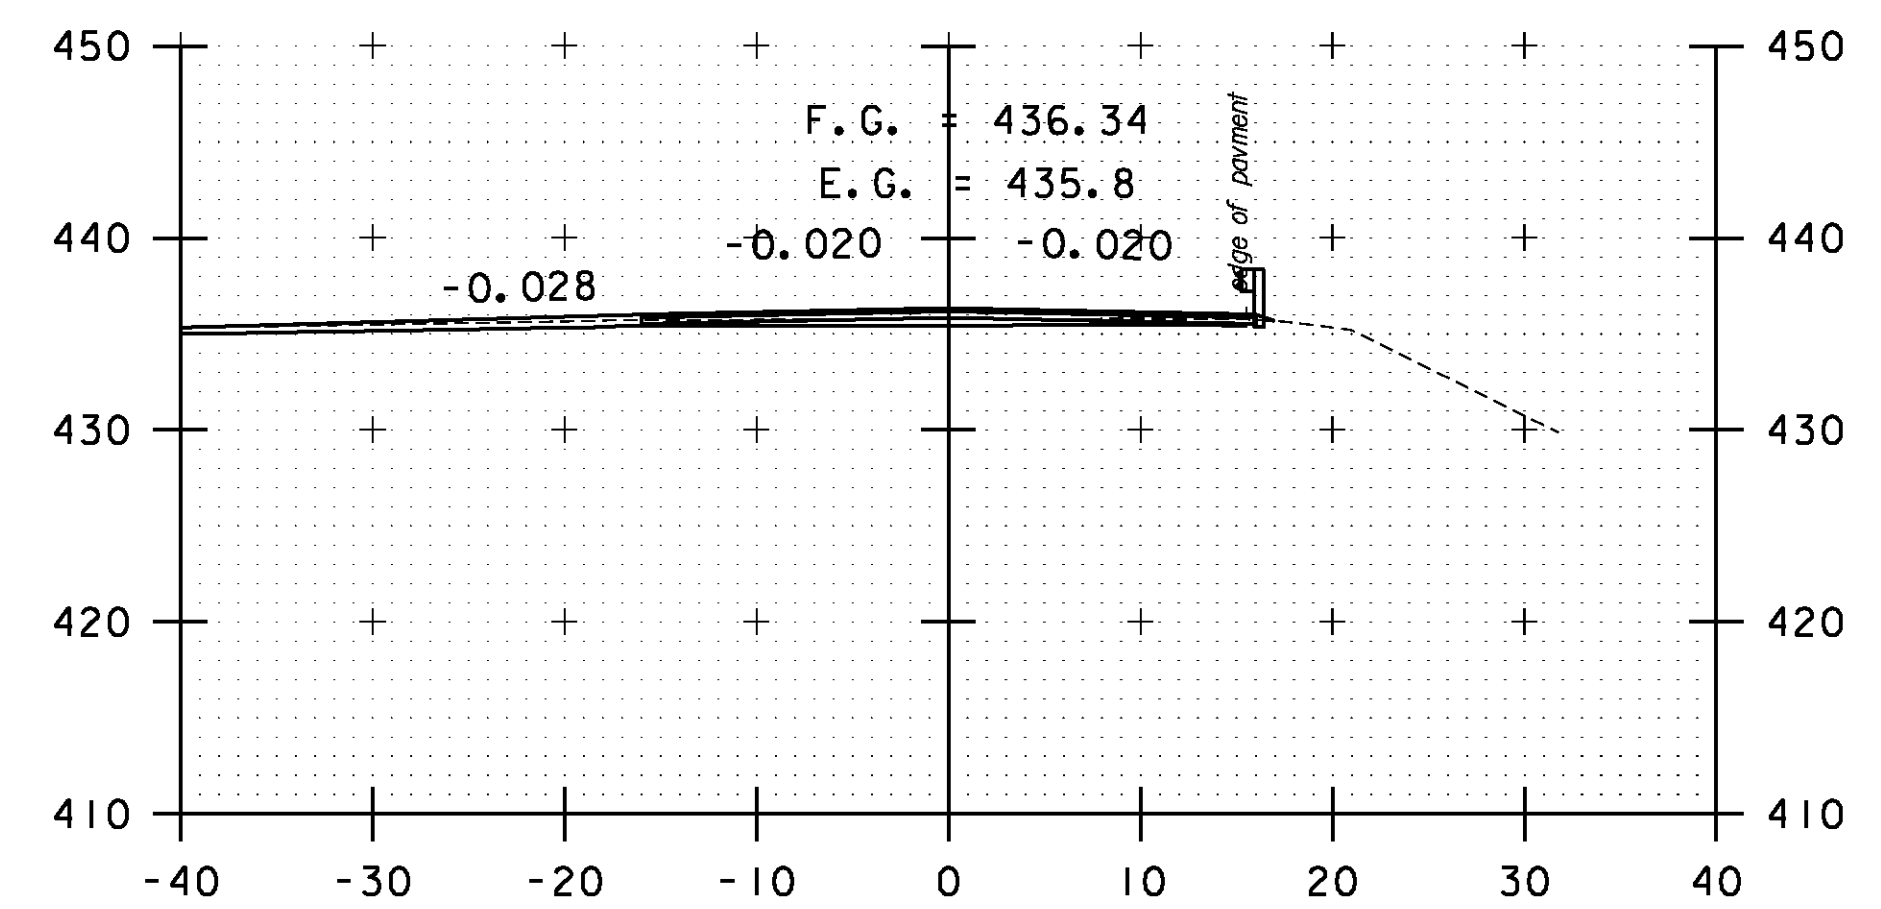

TH#7 LT
A 127+90

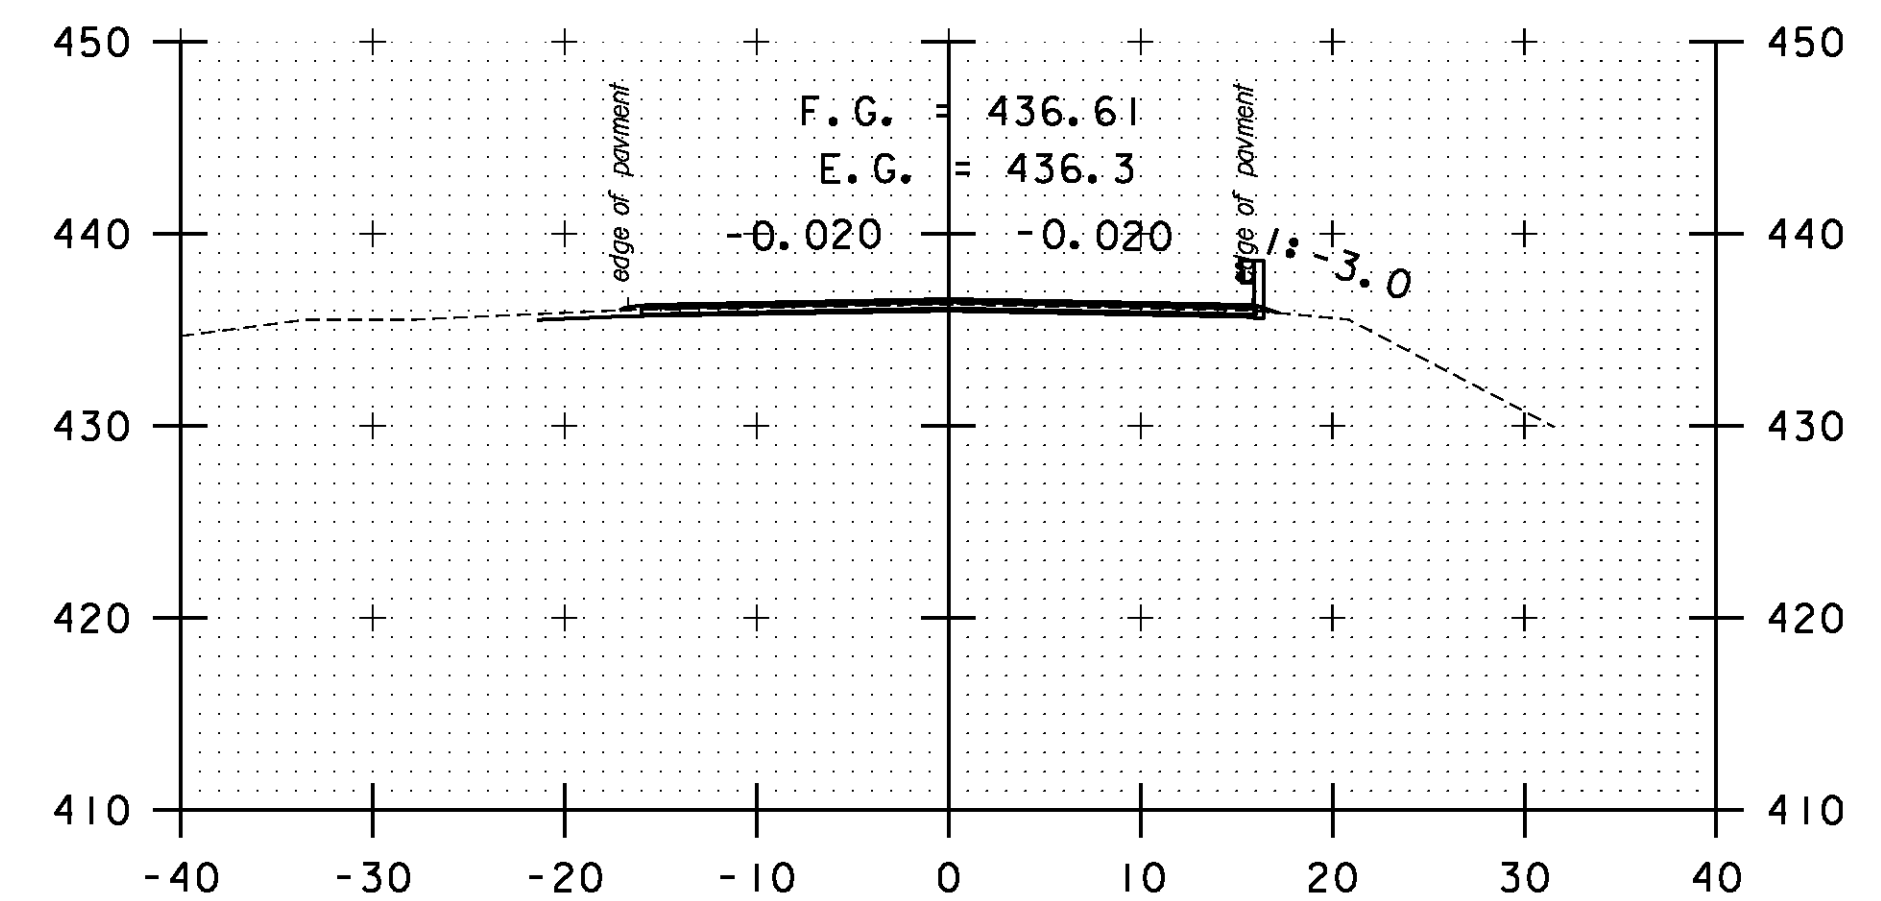

TH#7 LT
A 127+50

STA. A 124+50 TO STA. A 128+00

SCALE 1" = 10'-0"
0 10

CROSS SECTION SHEET 75

PROJECT NAME: BOLTON-WATERBURY

PROJECT NUMBER: STP 2709(1)

FILE NAME: p07C172.dgn

PROJECT LEADER: CDL

DESIGNED BY: BMB

PLOT FILE: p07C172_201

PLOT DATE: 4/16/2013

DRAWN BY: BMB

CHECKED BY: CDL

SHEET 201 OF 217