




A 129+50

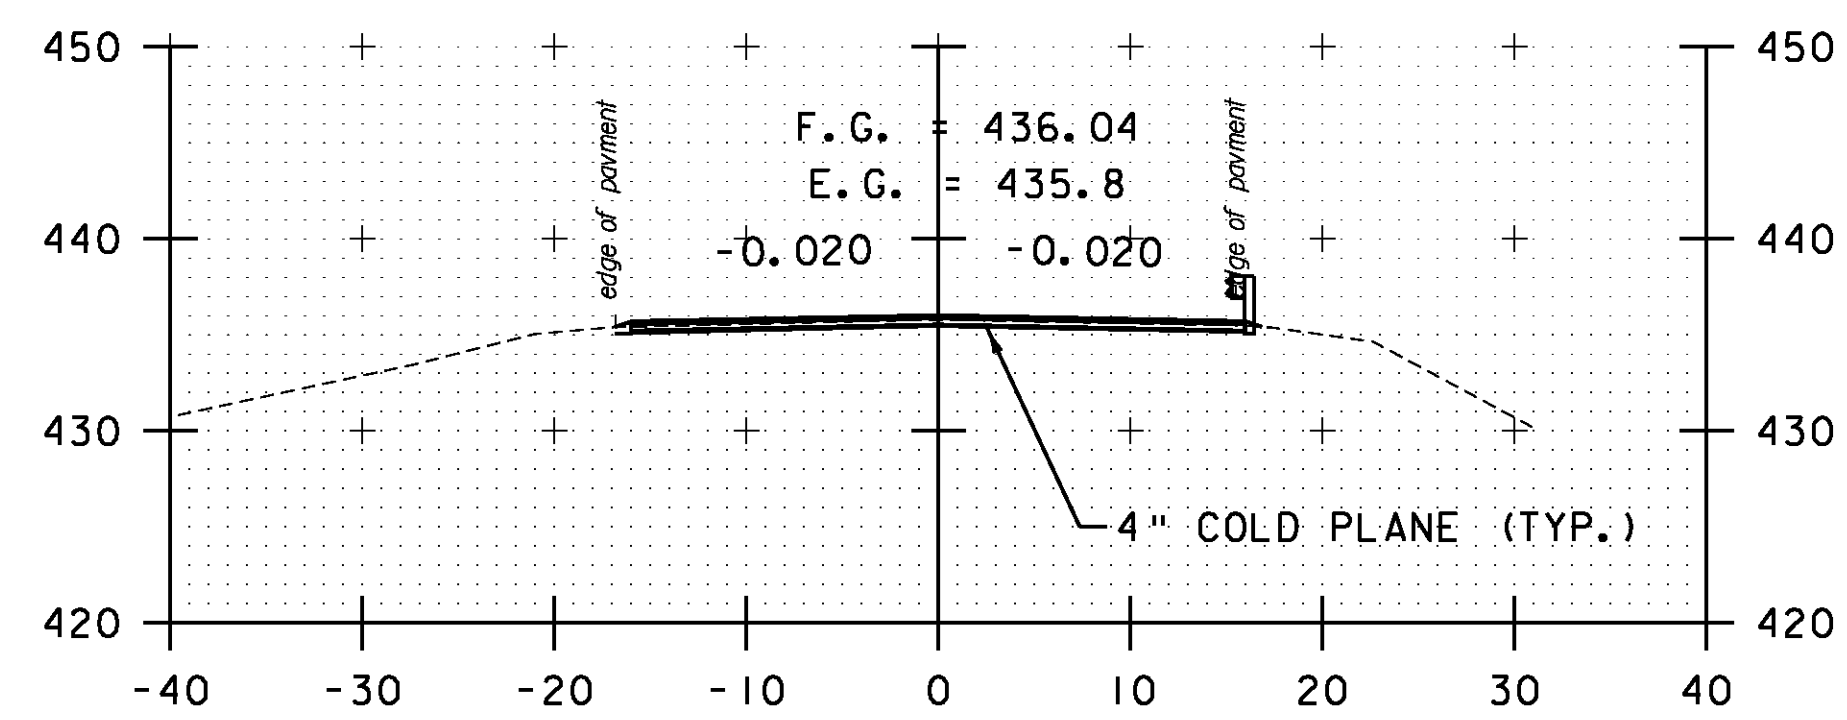


A 129+00

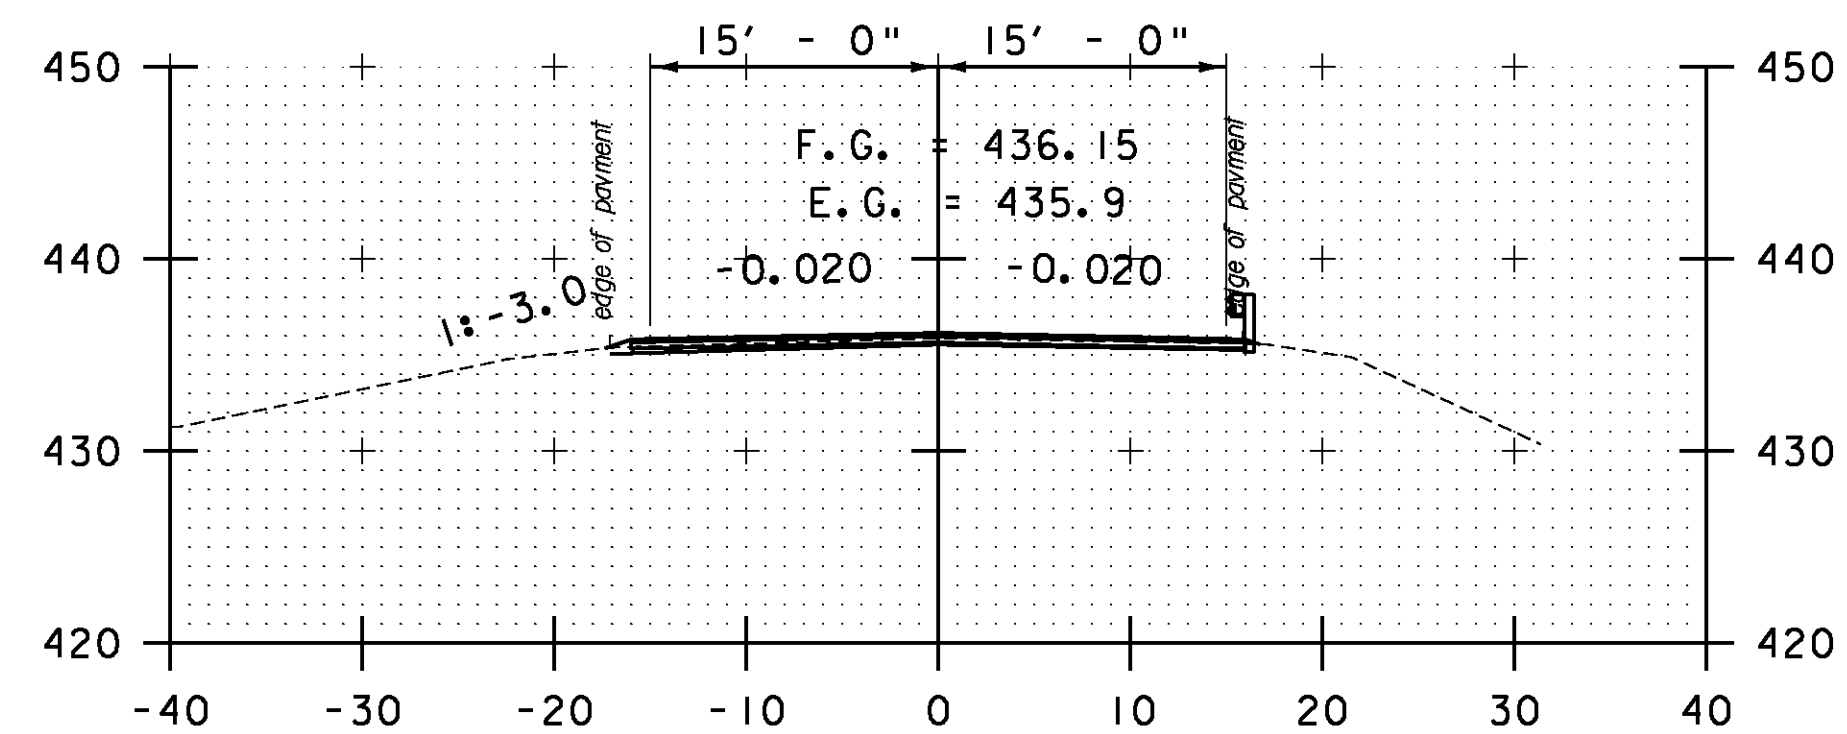


A 128+50

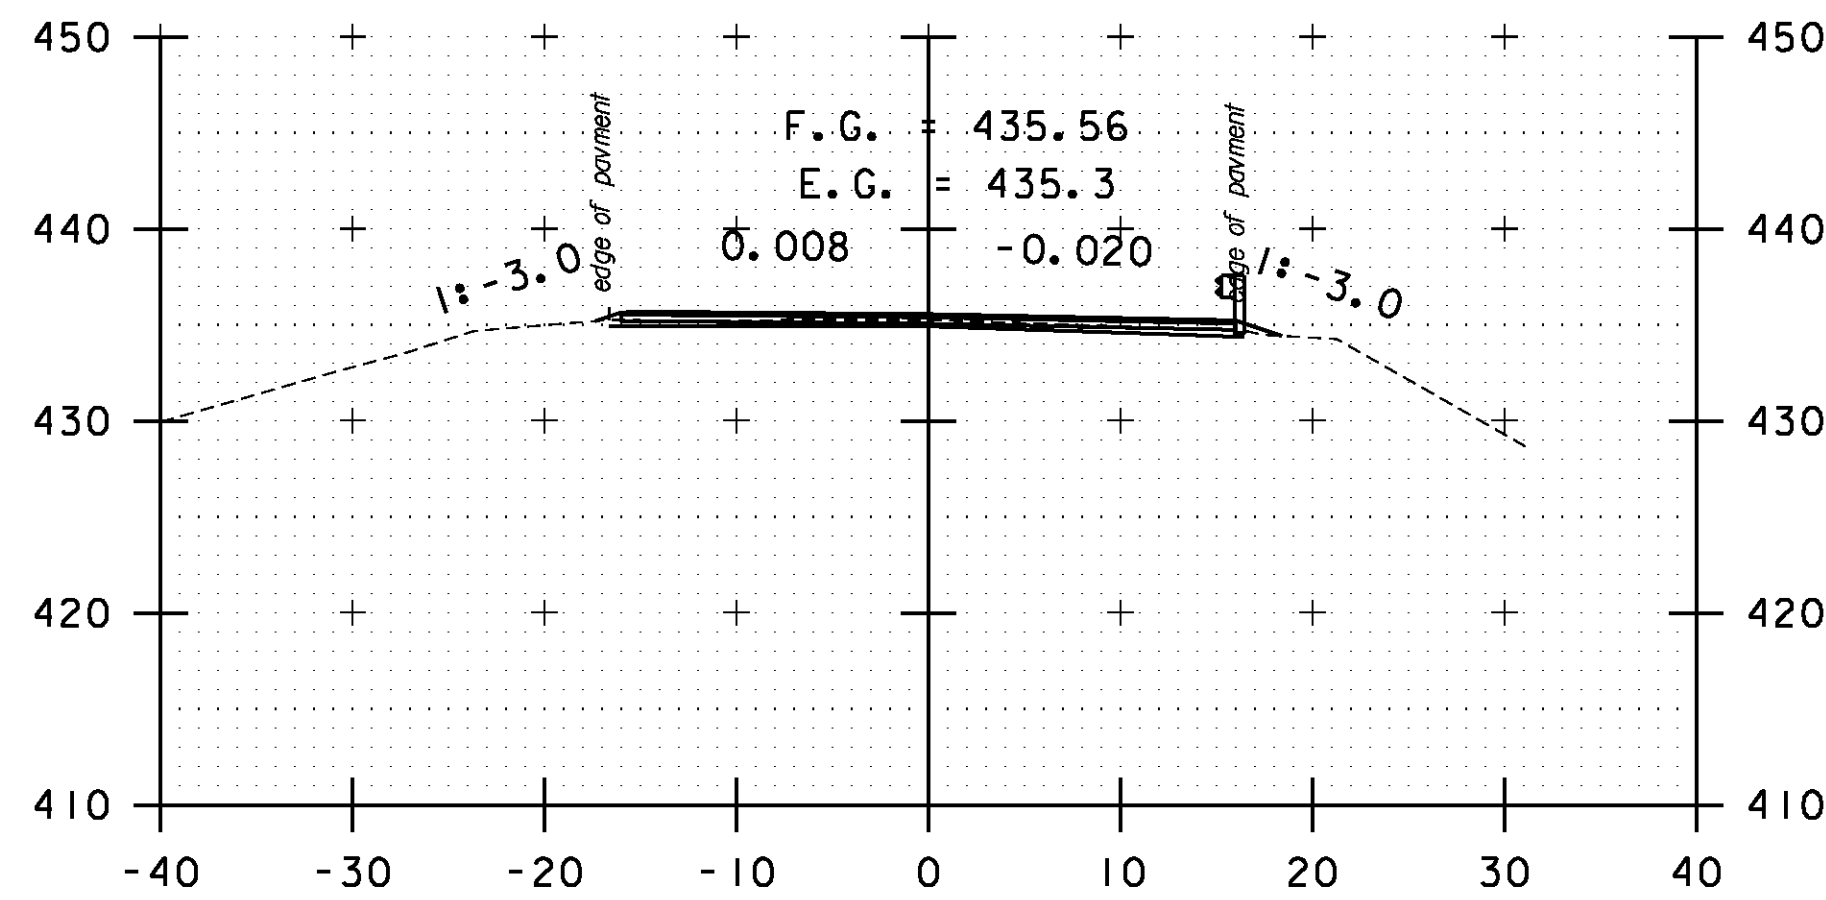


A 131+00

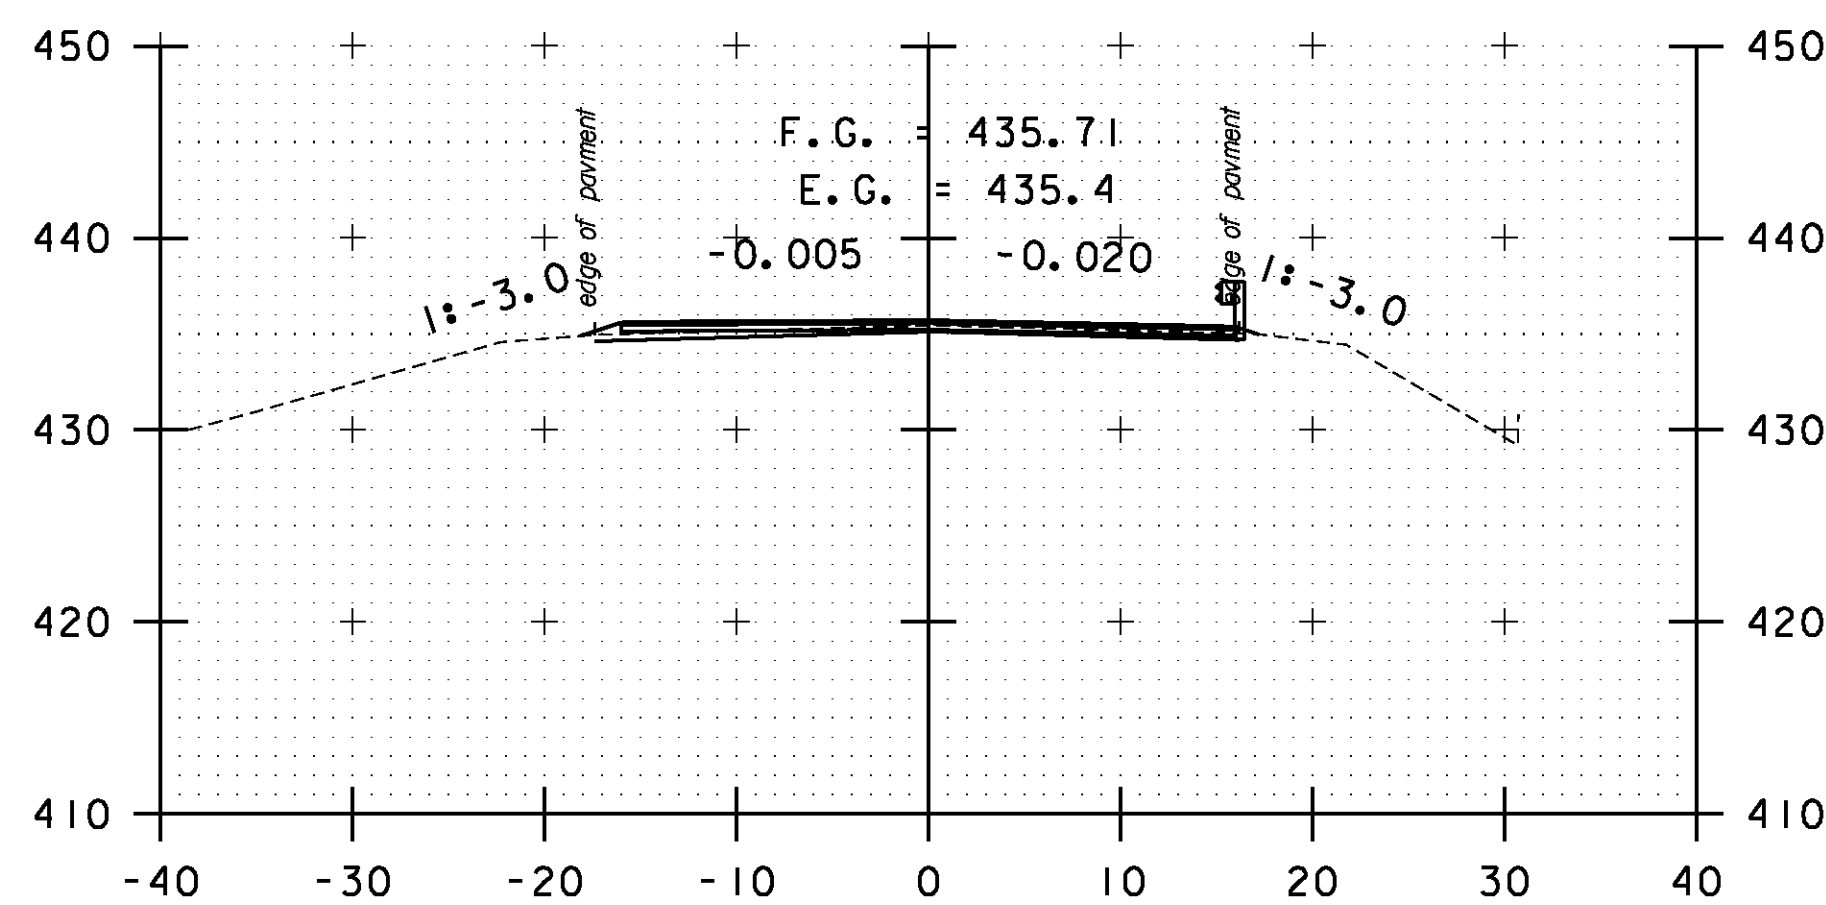


A 130+50

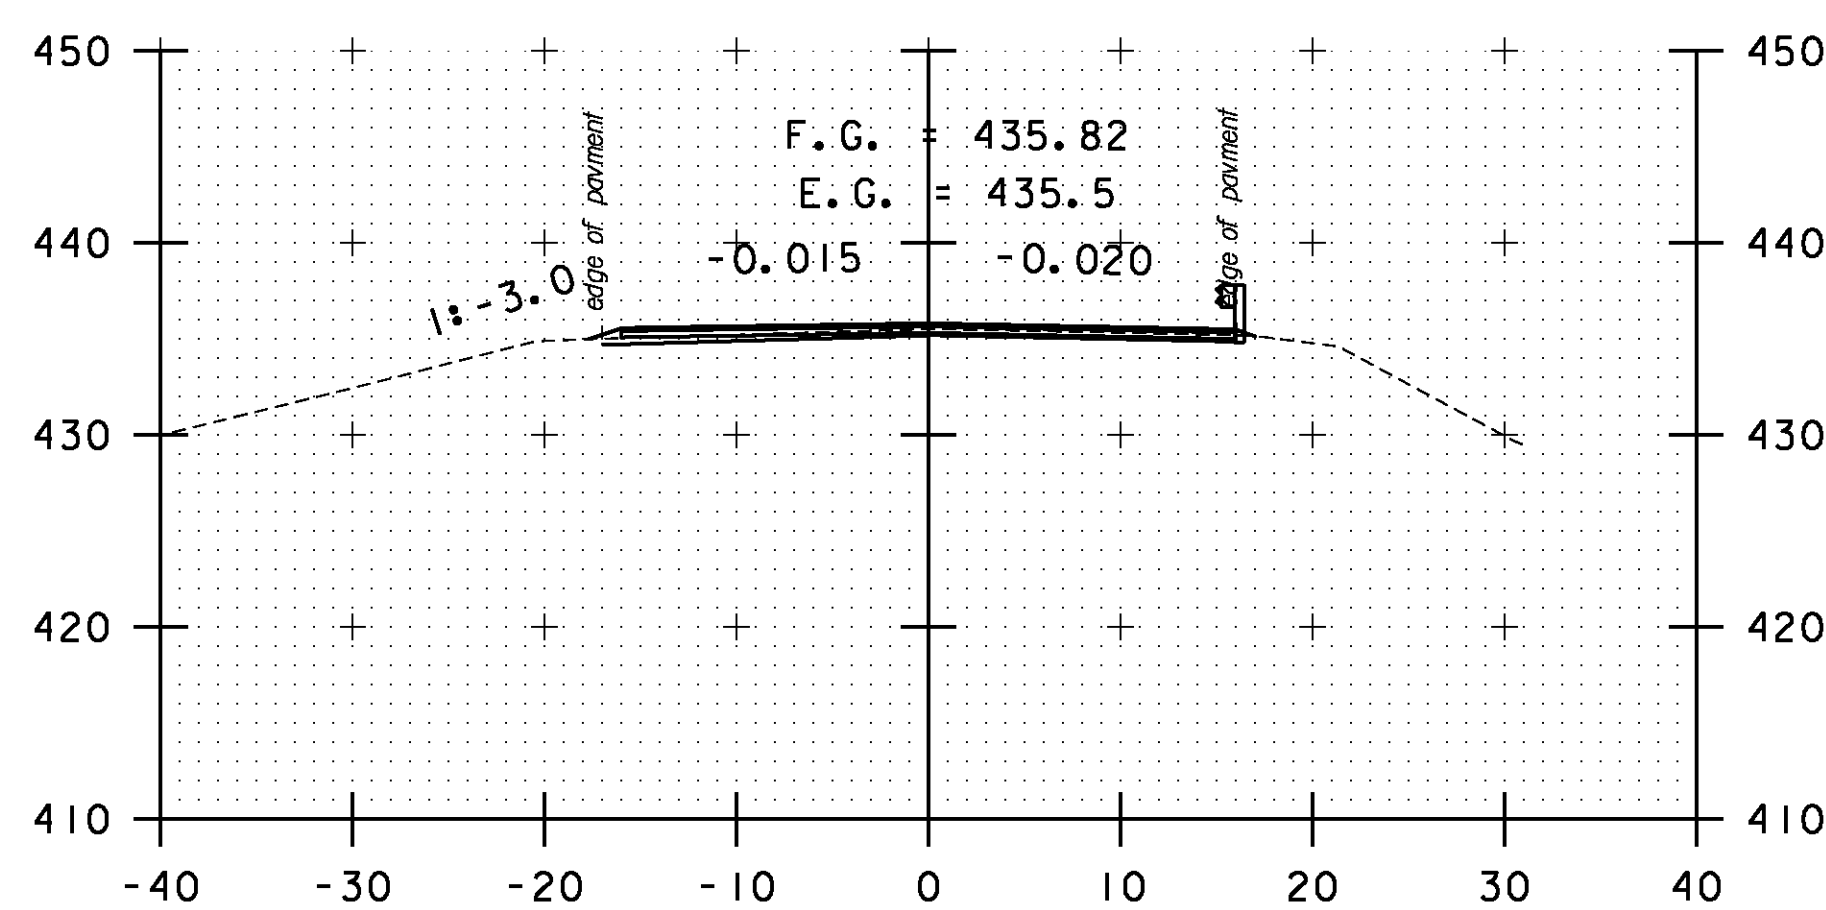


A 130+00

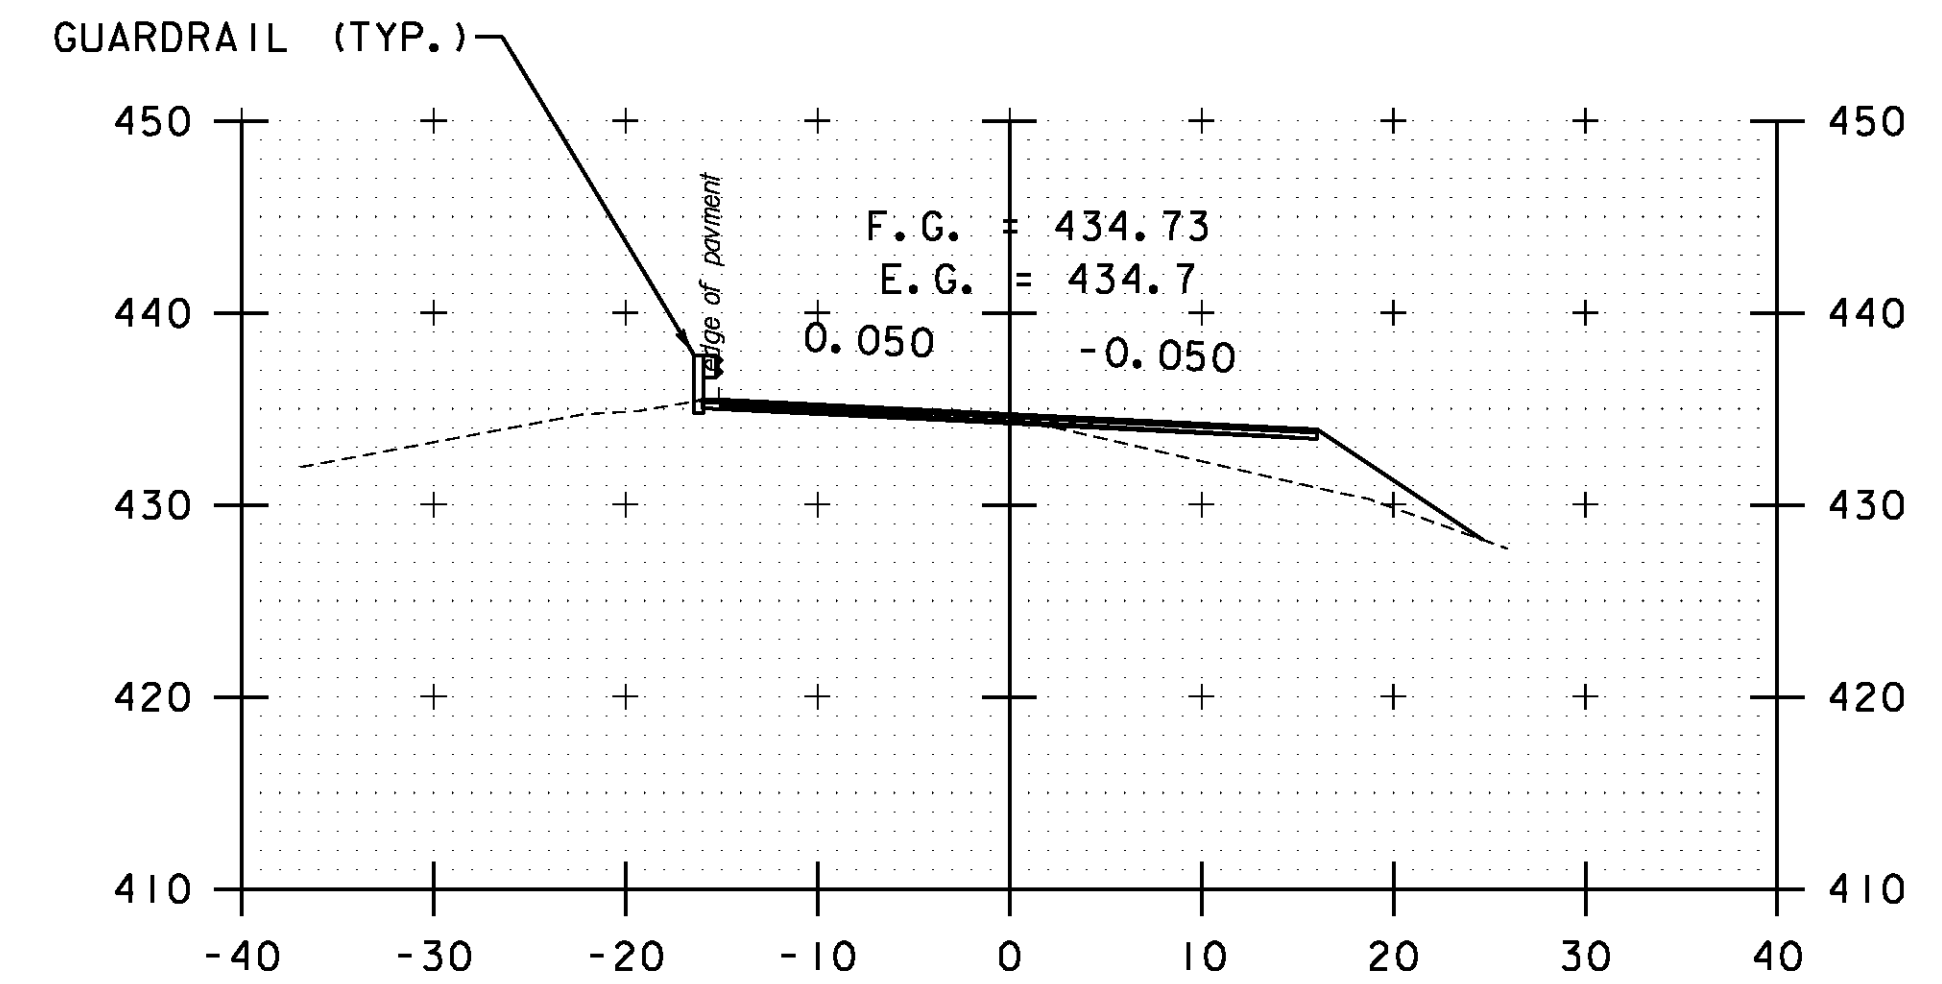

A 132+50

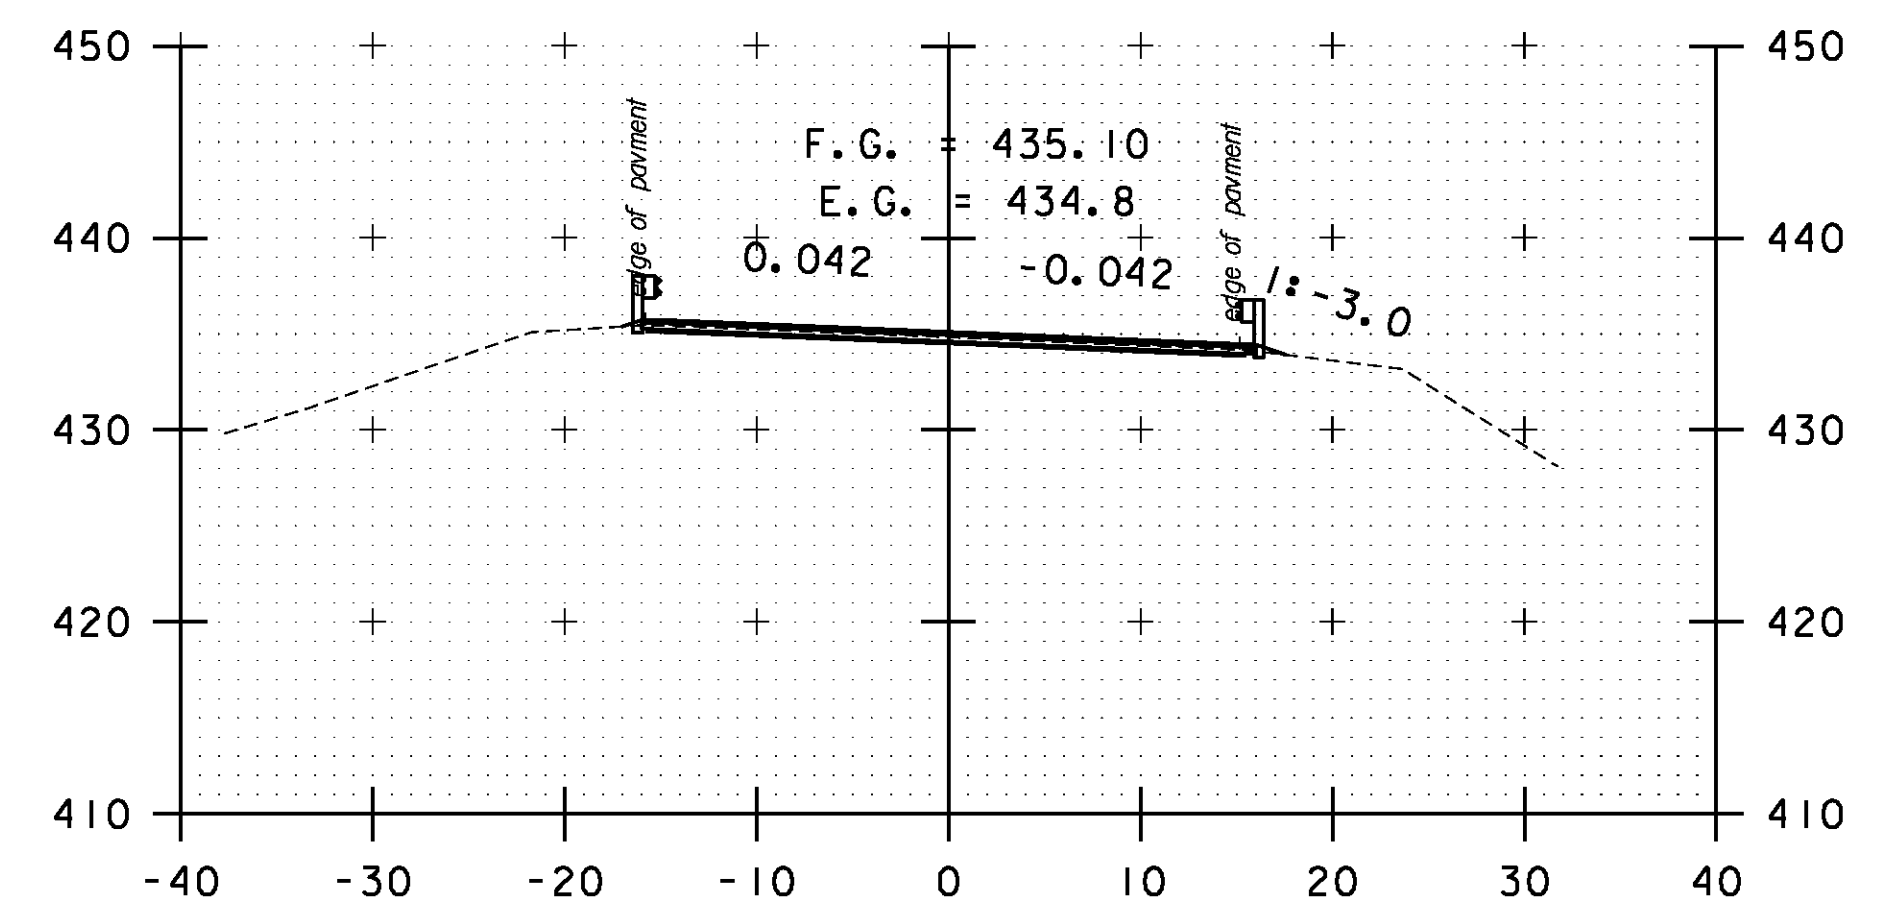

A 132+00

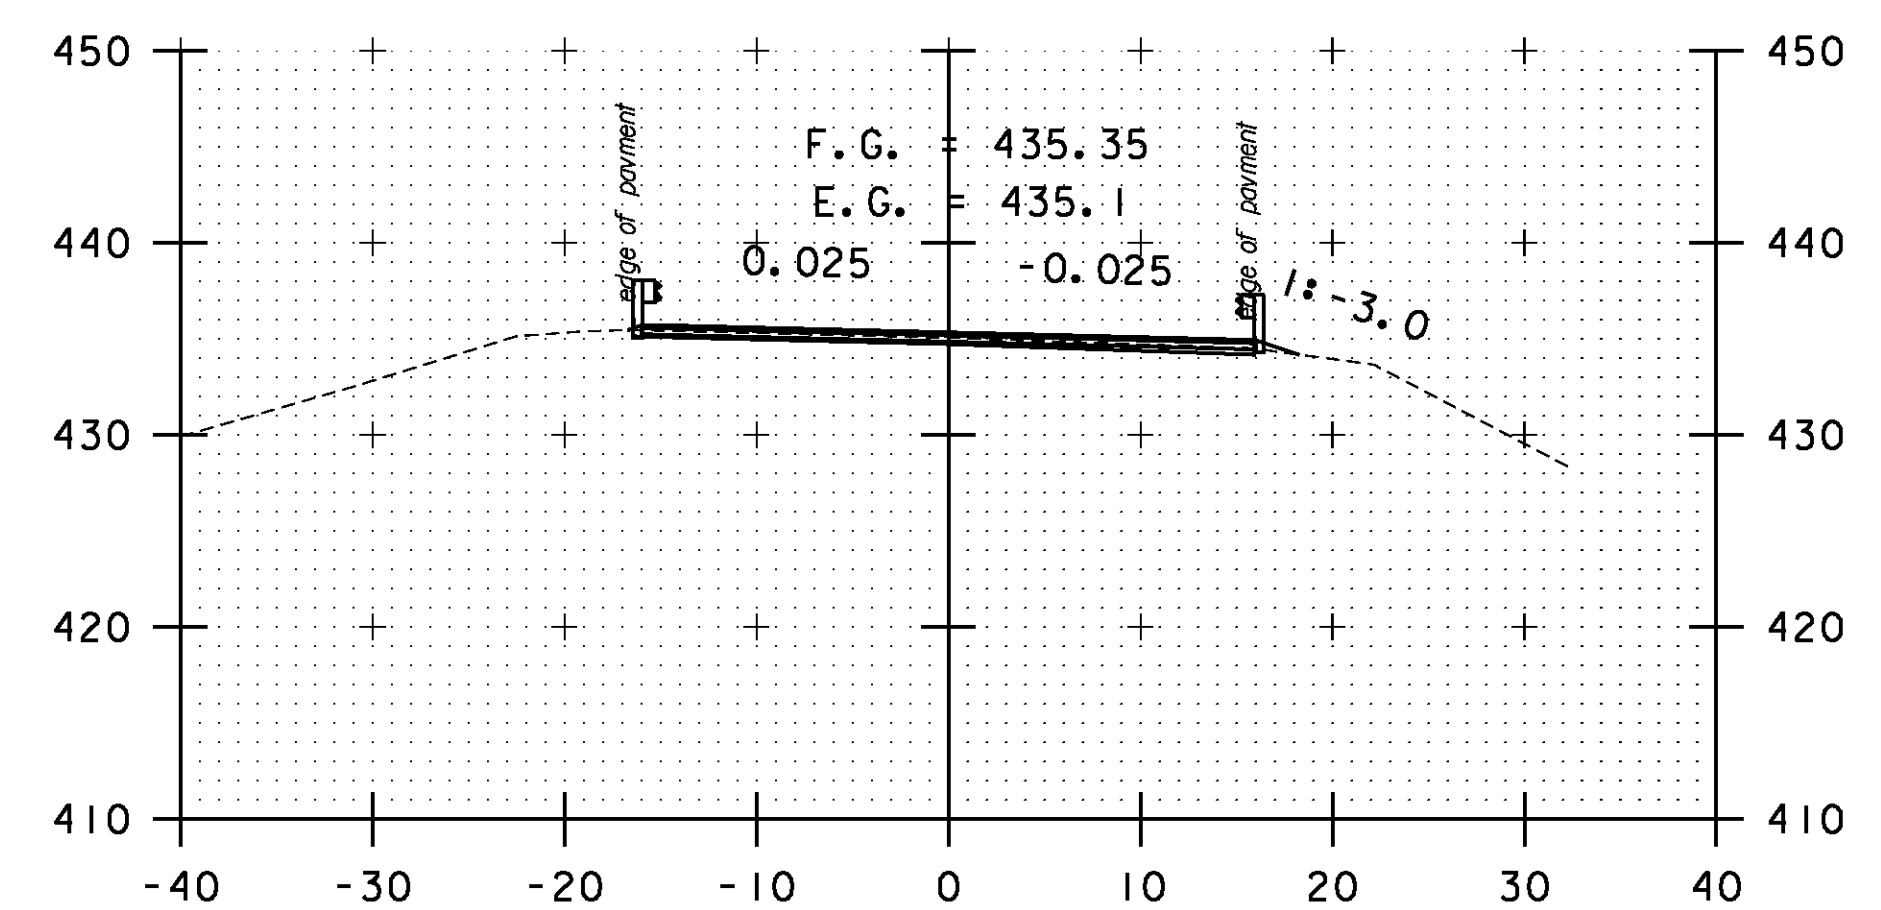

A 131+50

STA. A 128+50 TO STA. A 132+50

SCALE 1" = 10'-0"

CROSS SECTION SHEET 76

PROJECT NAME: BOLTON-WATERBURY

PROJECT NUMBER: STP 2709(I)

FILE NAME: p07C172.dgn

PROJECT LEADER: CDL

DESIGNED BY: BMB

PLOT FILE: p07C172_202.i

PLOT DATE: 4/16/2013

DRAWN BY: BMB

CHECKED BY: CDL

SHEET 202 OF 217