


STA. A 136+50 TO STA. A 140+50

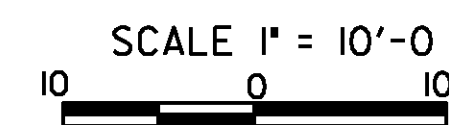

CROSS SECTION SHEET 78

PROJECT NAME: BOLTON-WATERBURY
PROJECT NUMBER: STP 2709(I)

FILE NAME: p07C172.dgn
PROJECT LEADER: CDL
DESIGNED BY: BMB
PLOT FILE: p07C172_204.i

PLOT DATE: 4/16/2013
DRAWN BY: BMB
CHECKED BY: CDL
SHEET 204 OF 217