




A 146+50

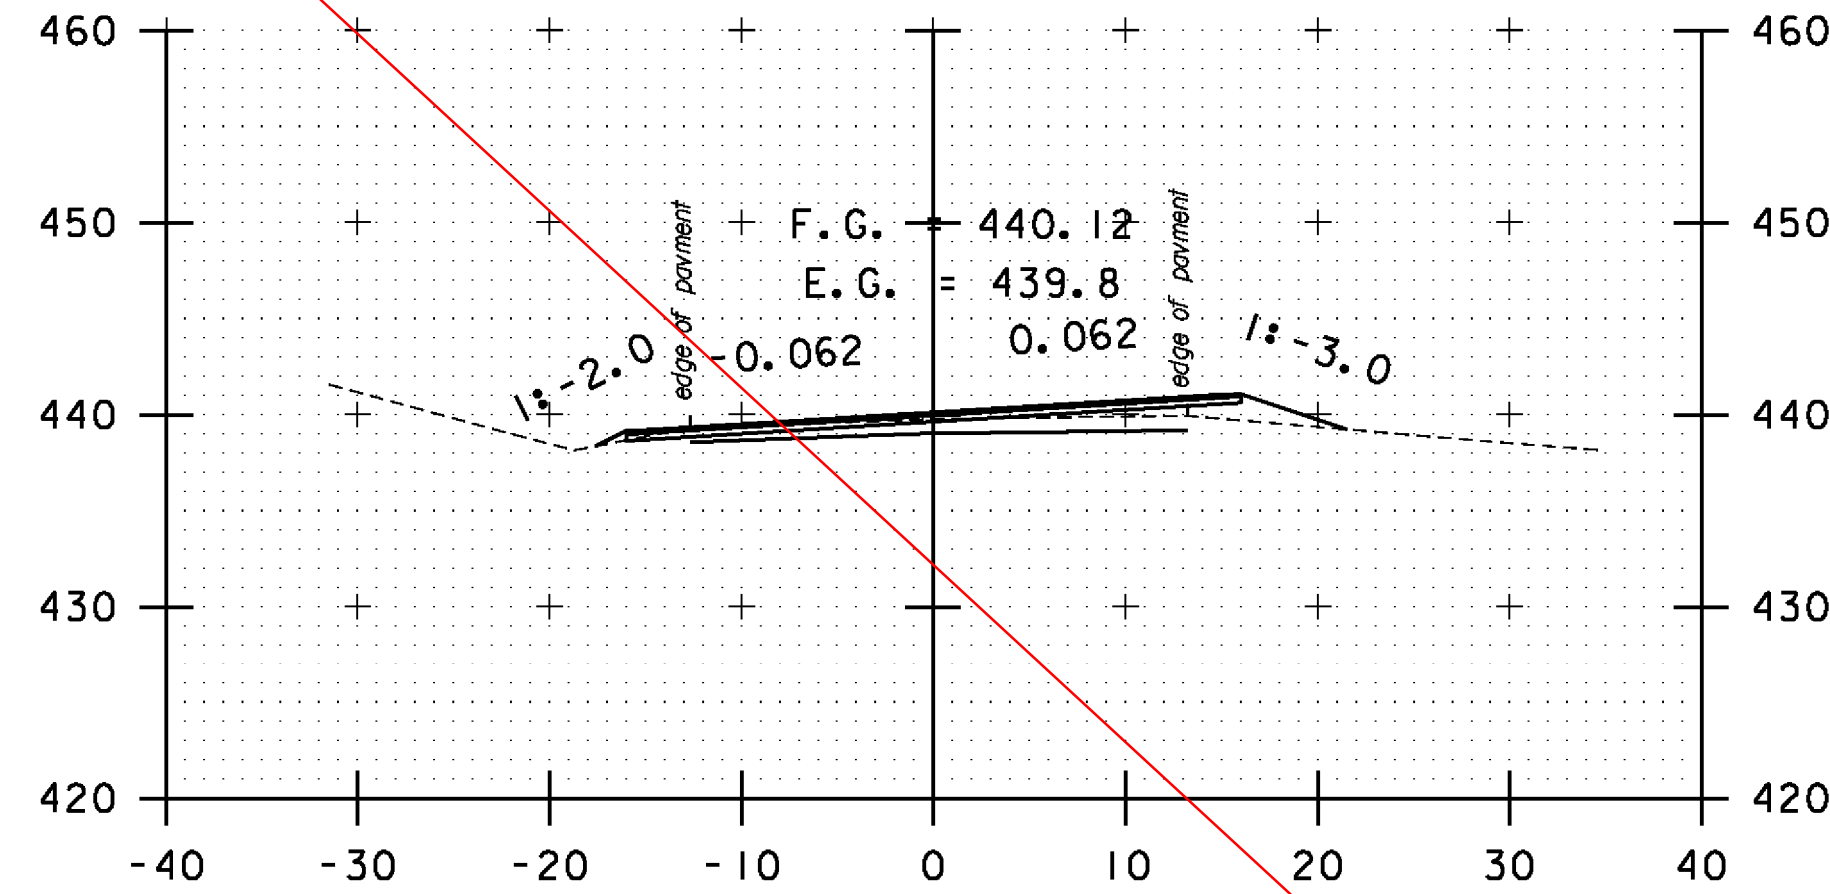


A 148+00

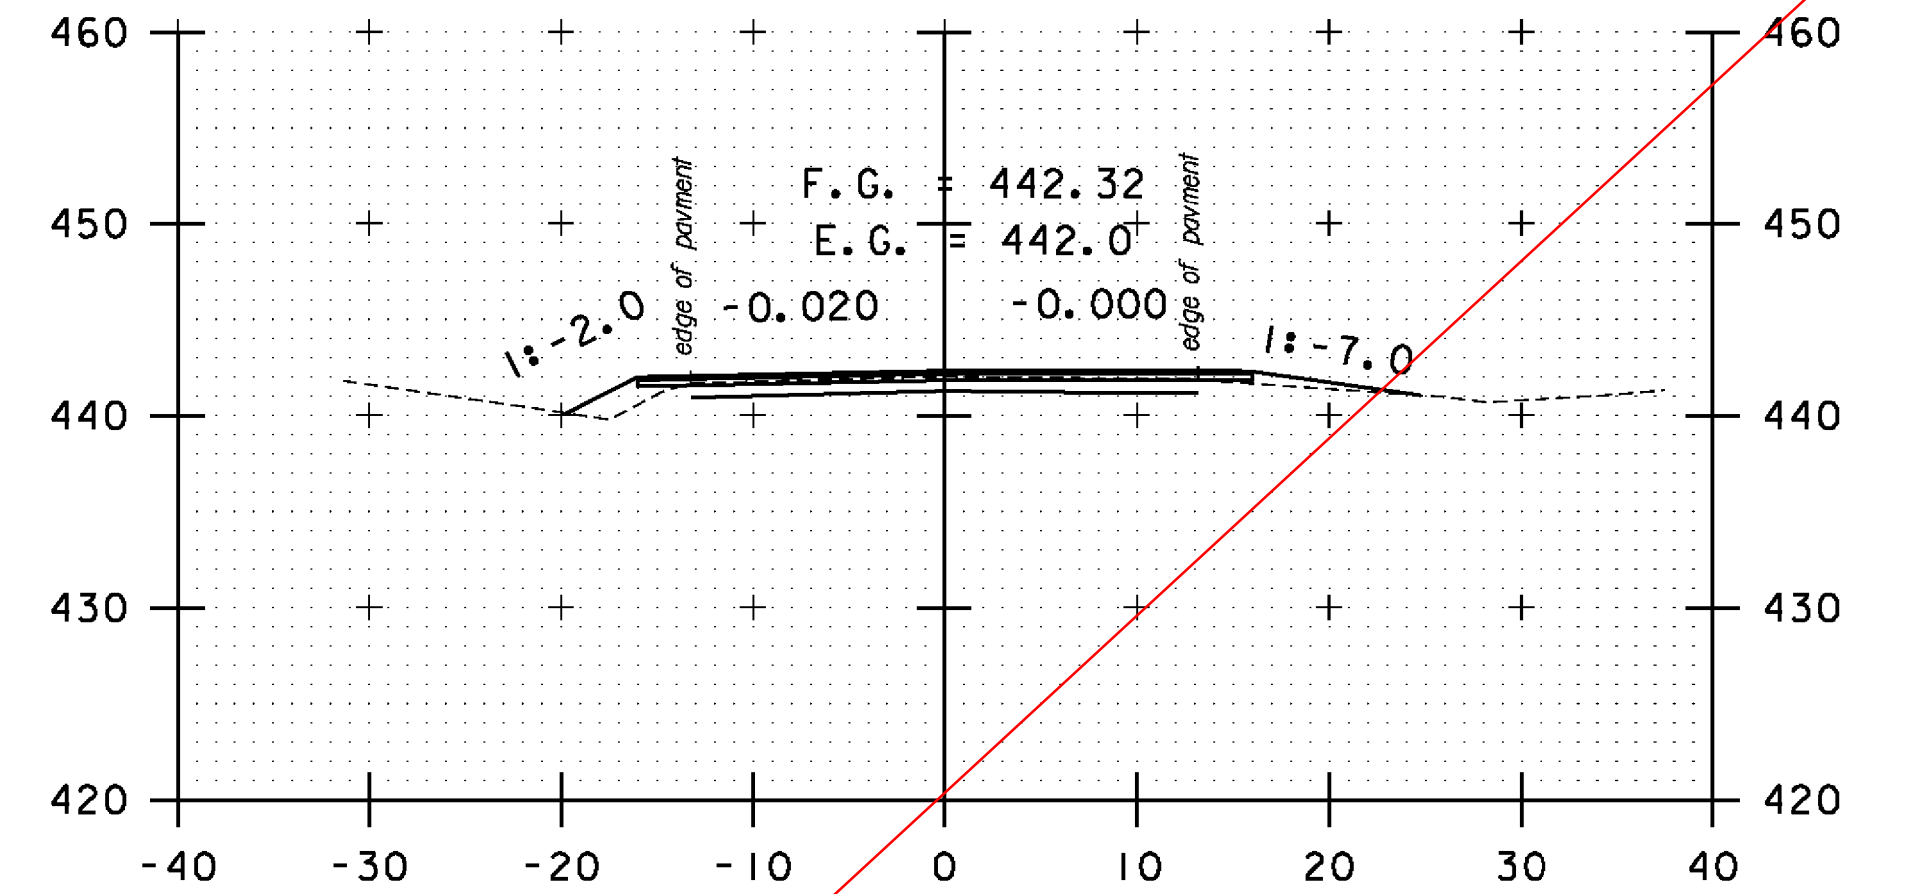


DRIVE RT
A 149+50

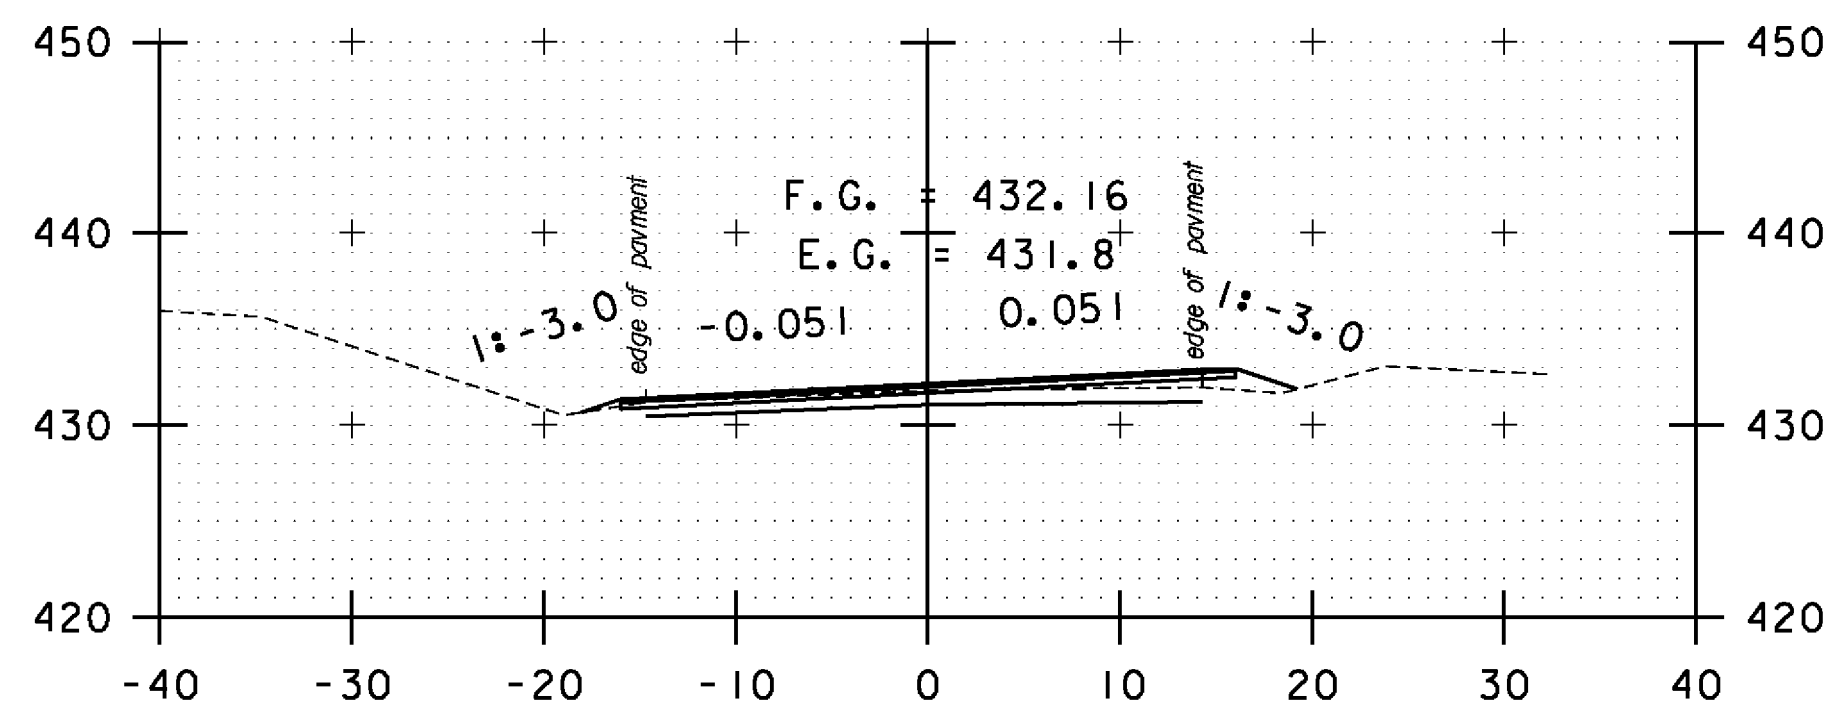


A 146+00

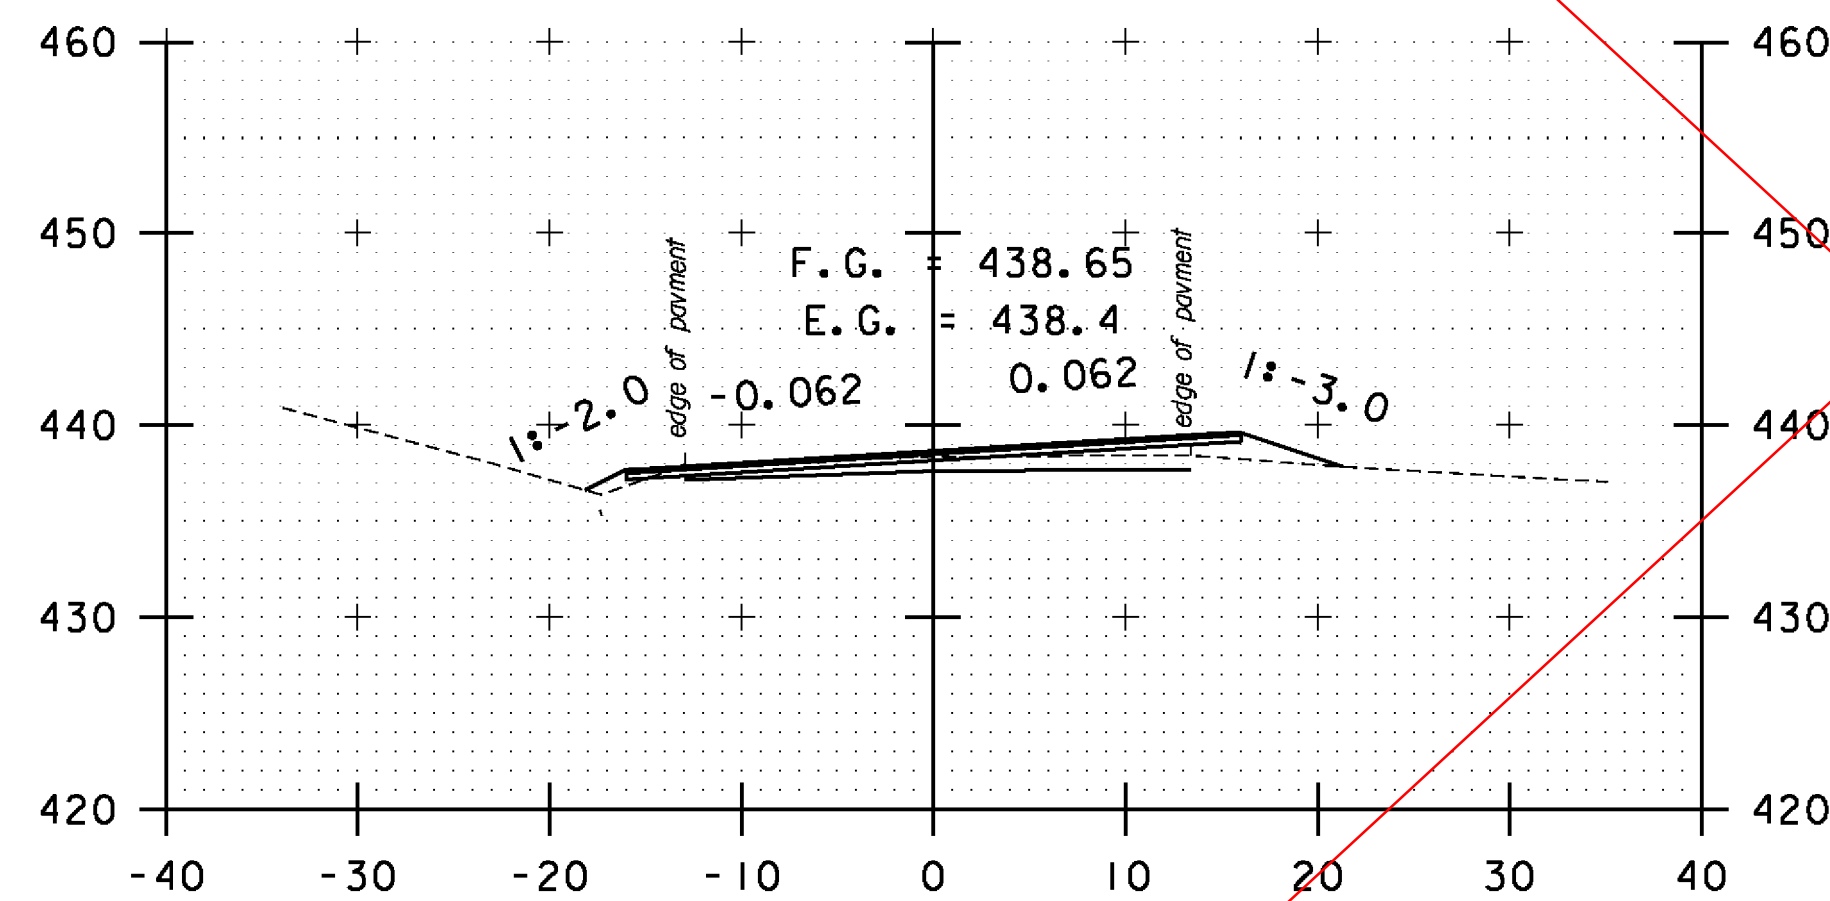


A 147+50

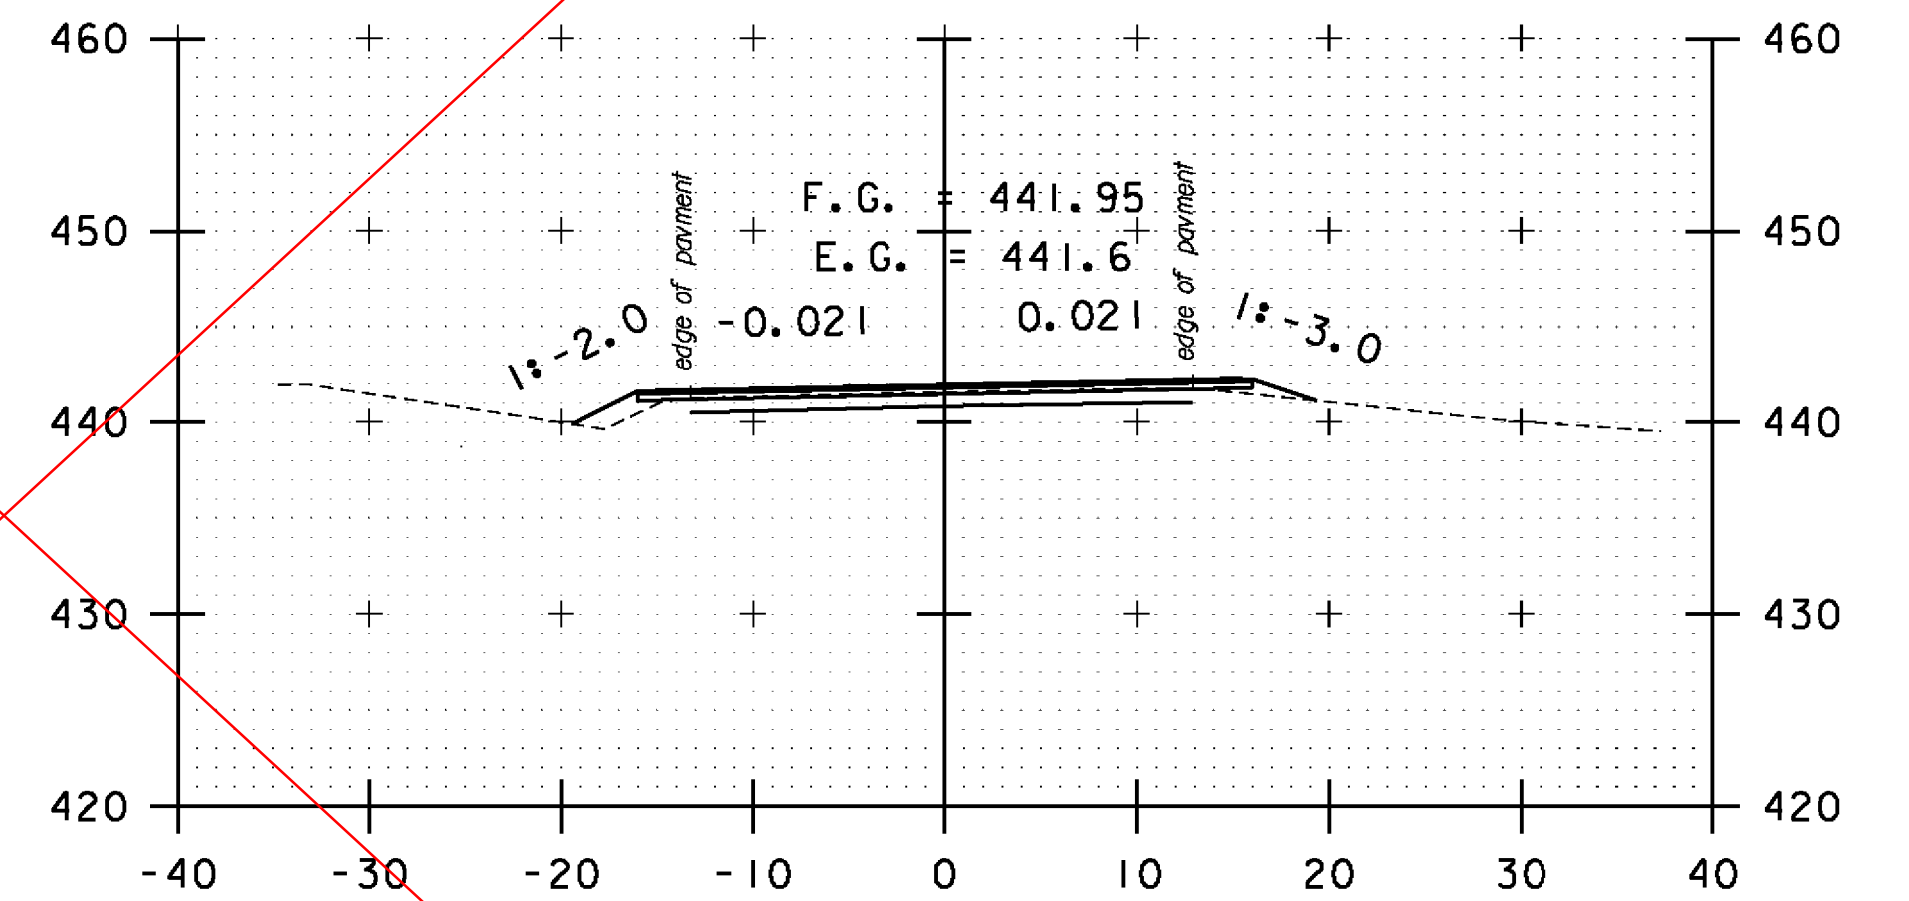


A 149+00

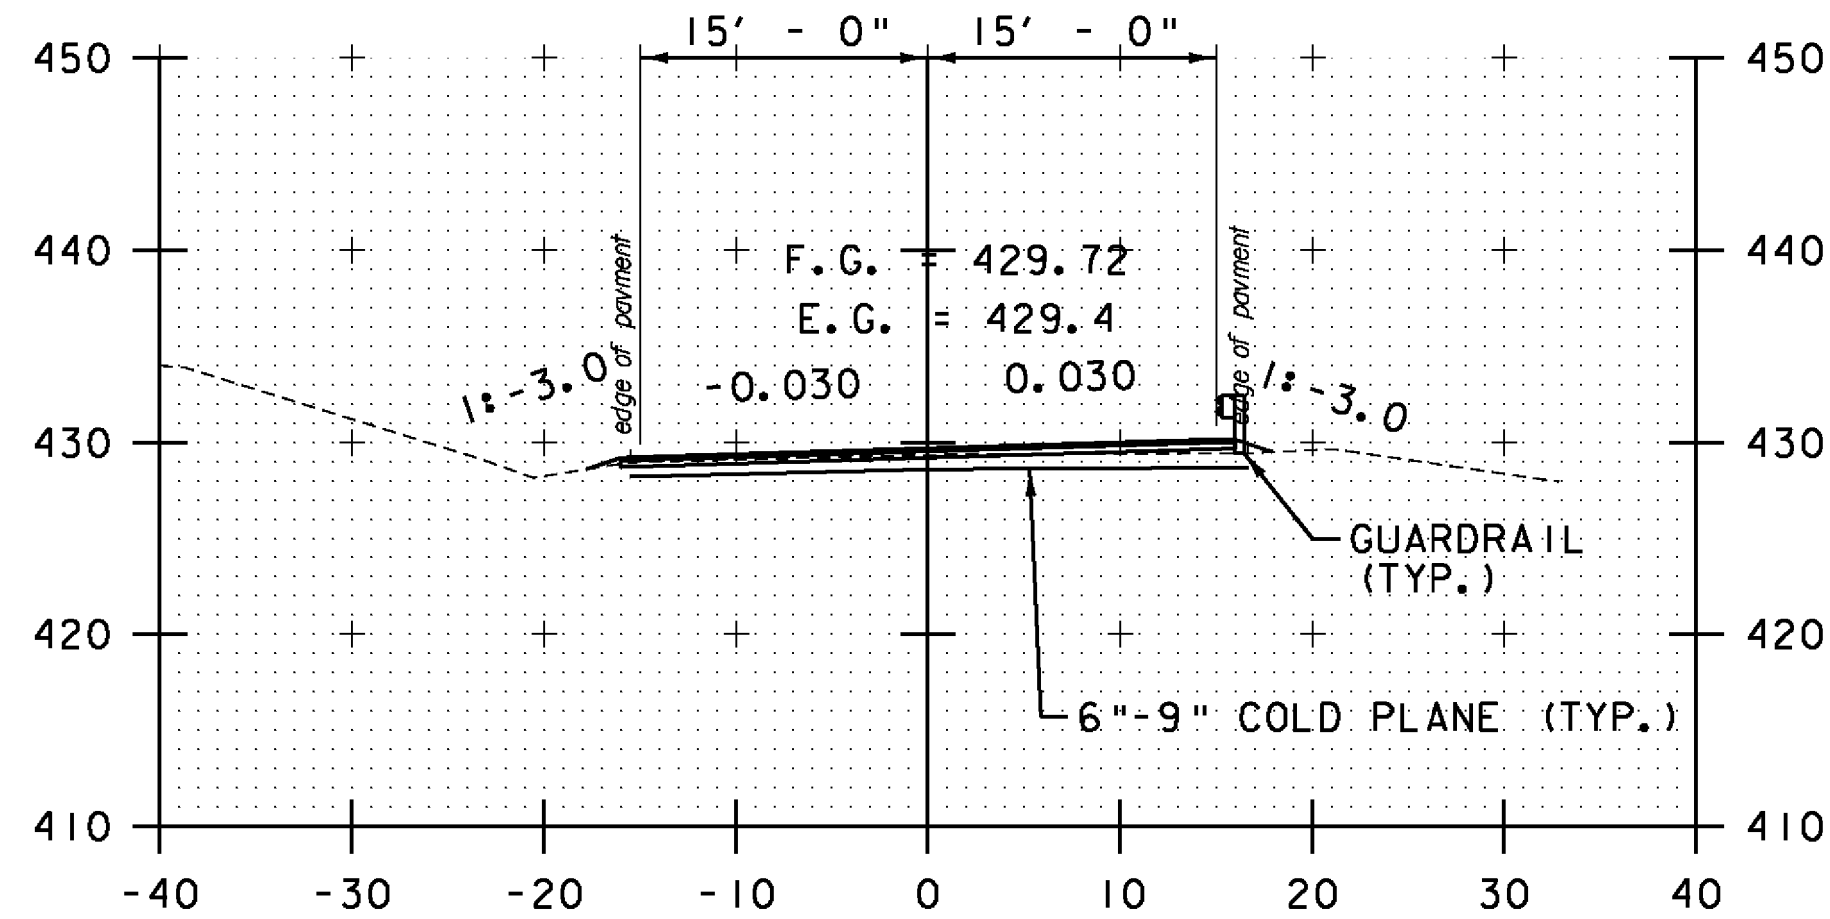

A 145+50

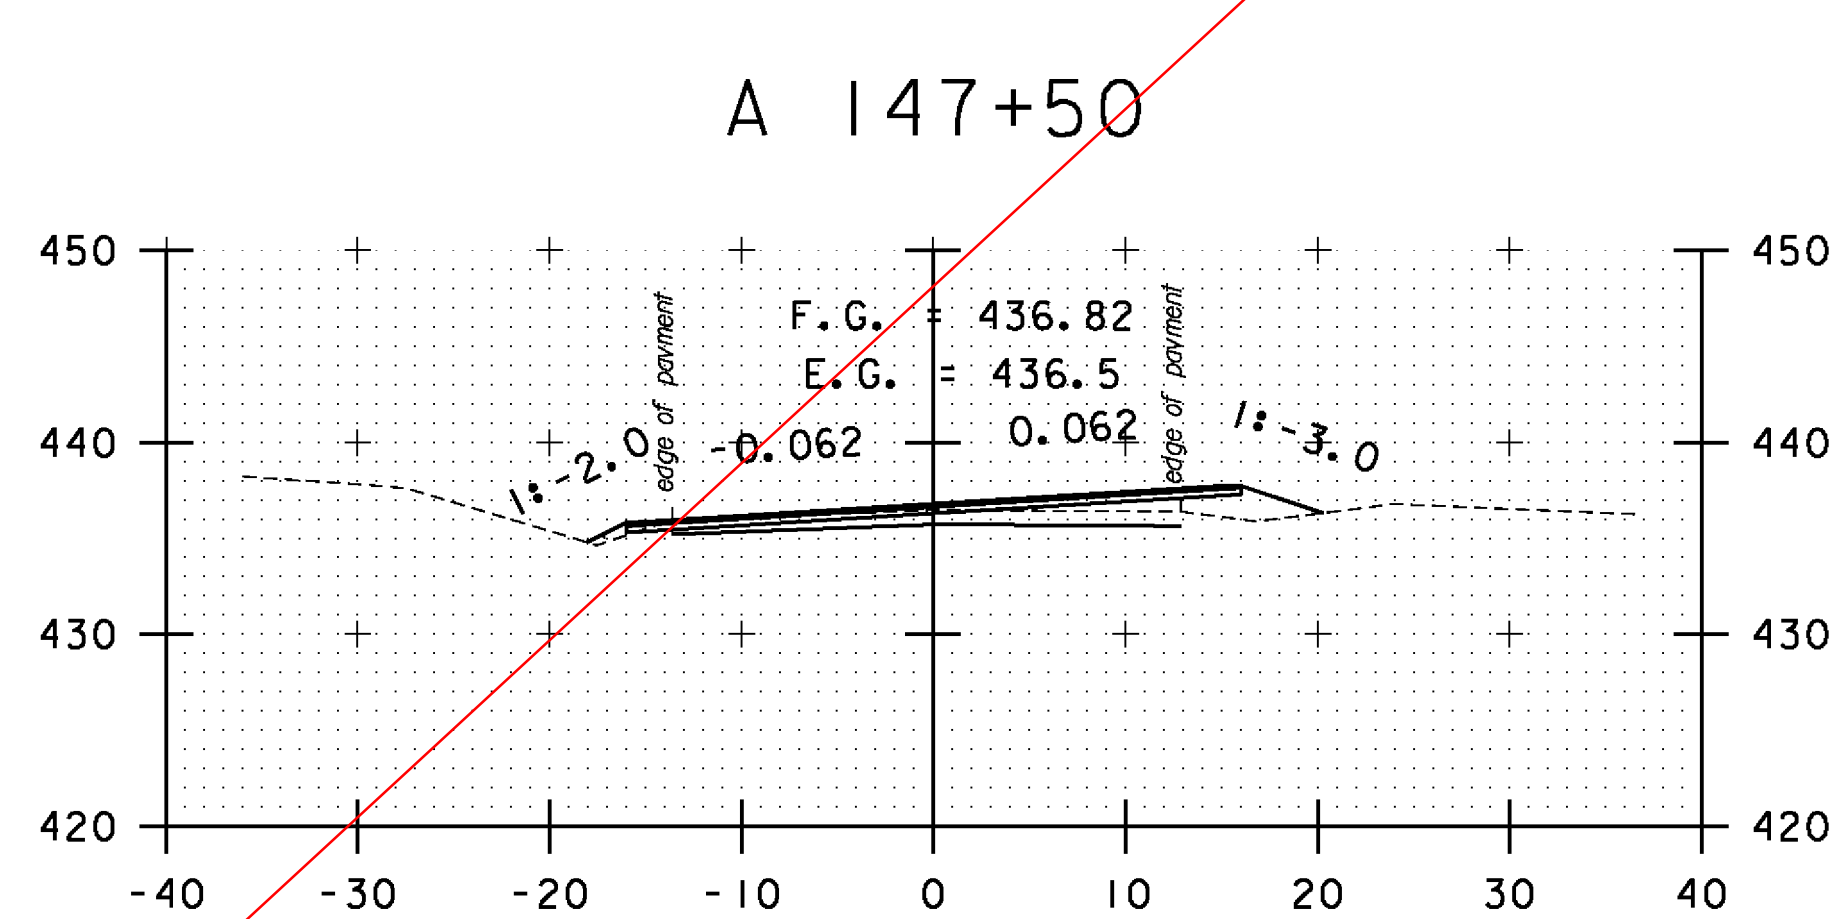


A 147+00

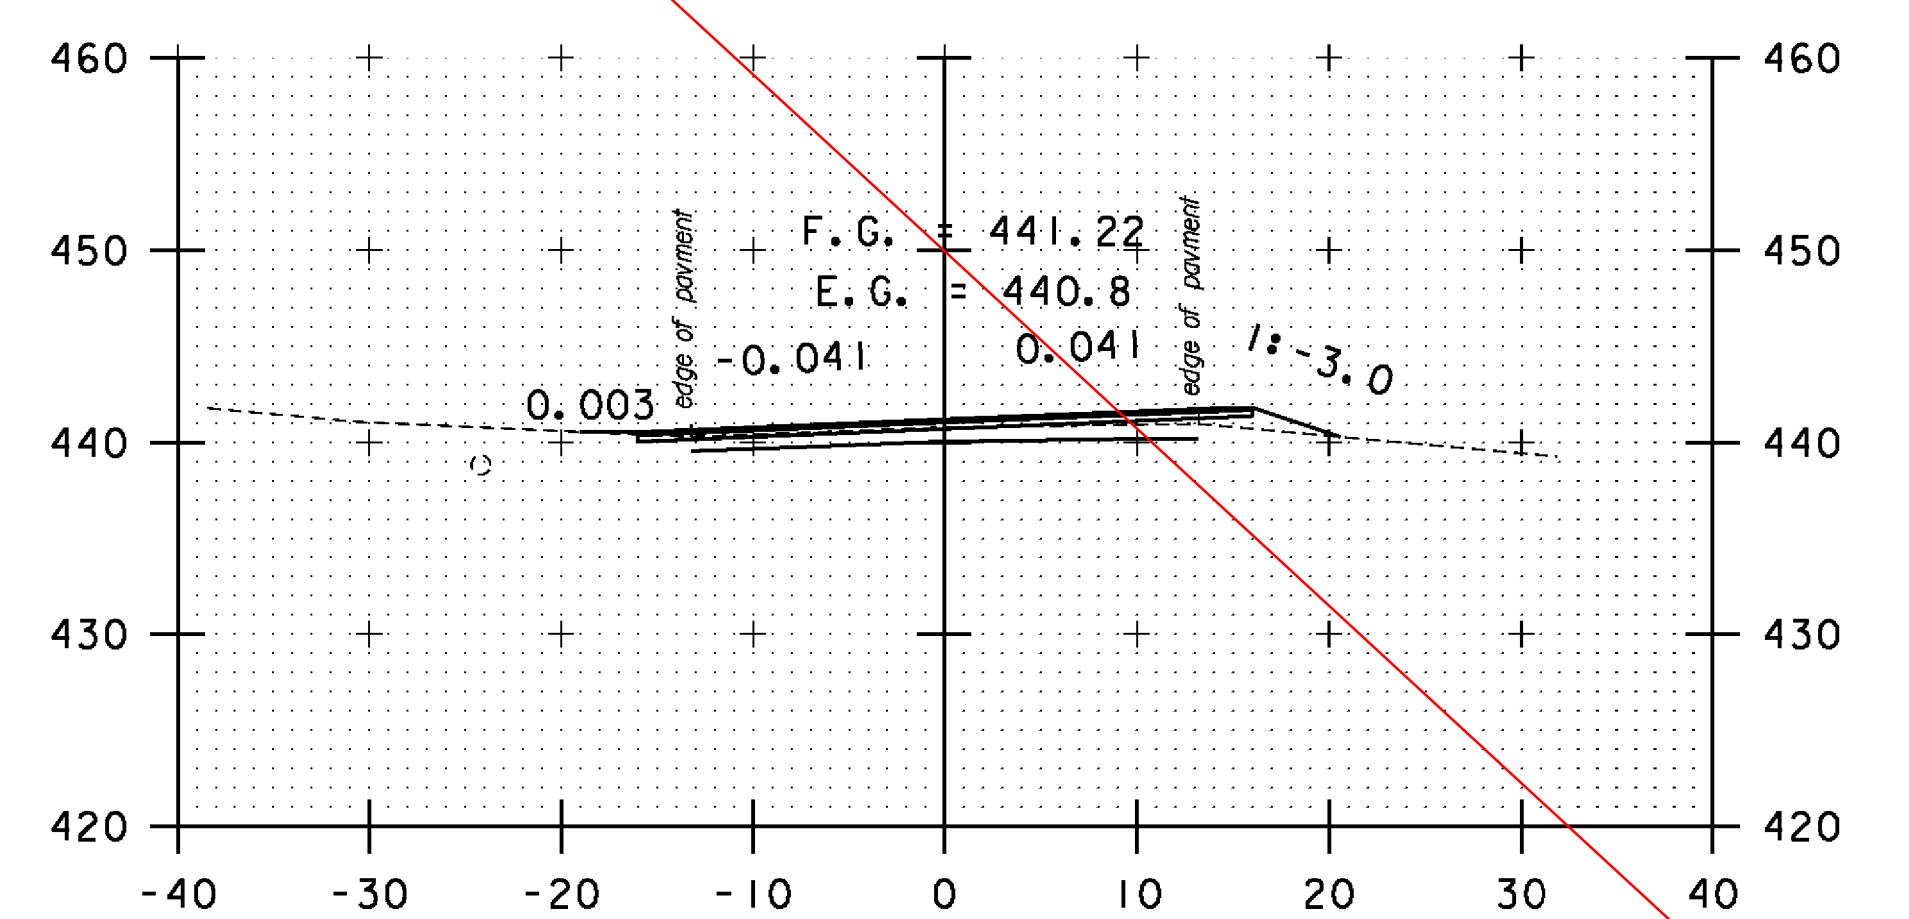

DRIVE LT
A 148+50

SEE SHEETS 206A1-206A6 & 207A1
FOR AMENDED CROSS SECTIONS
A 147+00 - A 149+50

STA. A 145+50 TO STA. A 149+50

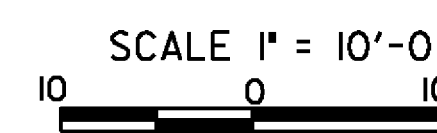

CROSS SECTION SHEET 80

PROJECT NAME:	BOLTON-WATERBURY	PLOT DATE:	4/16/2013
PROJECT NUMBER:	STP 2709(I)	DRAWN BY:	BMB
FILE NAME:	p07C172.dgn	CHECKED BY:	CDL
PROJECT LEADER:	CDL	SHEET	206 OF 217
DESIGNED BY:	BMB		
PLOT FILE:	p07C172-206.I		