


A 147+25

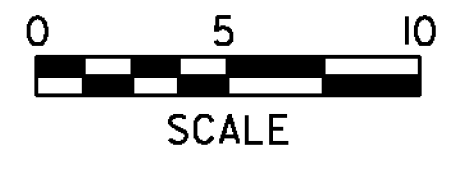

PROJECT NAME:	BOLTON-WATERBURY	PLOT DATE:	17-JUL-2014
PROJECT NUMBER:	STP 2709(I)	DRAWN BY:	L. BULLOCK
FILE NAME:	p07c172xs.dgn	CHECKED BY:	M. FOWLER
PROJECT LEADER:	M. FOWLER	SHEET	4 OF 12
DESIGNED BY:	L. BULLOCK		