



A 147+75

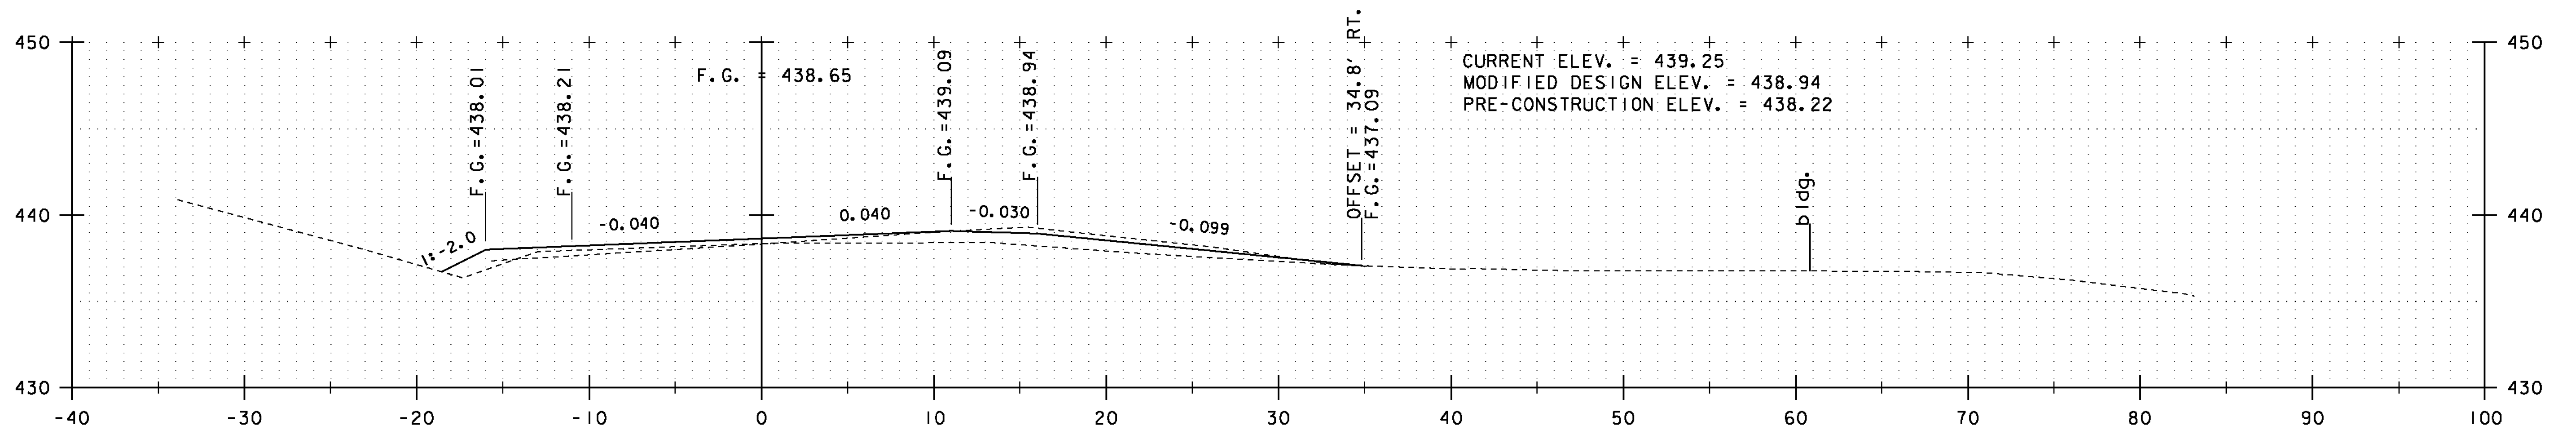

A 147+50

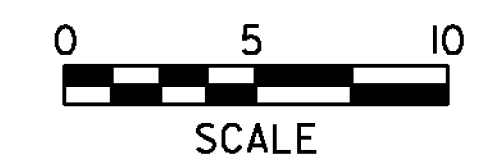

| | | | |
|-----------------|------------------|-------------|-------------|
| PROJECT NAME: | BOLTON-WATERBURY | PLOT DATE: | 17-JUL-2014 |
| PROJECT NUMBER: | STP 2709(I) | DRAWN BY: | L. BULLOCK |
| FILE NAME: | p07c172xs.dgn | CHECKED BY: | M. FOWLER |
| PROJECT LEADER: | M. FOWLER | SHEET | 5 OF 12 |
| DESIGNED BY: | L. BULLOCK | | |