


A 149+25



A 149+00

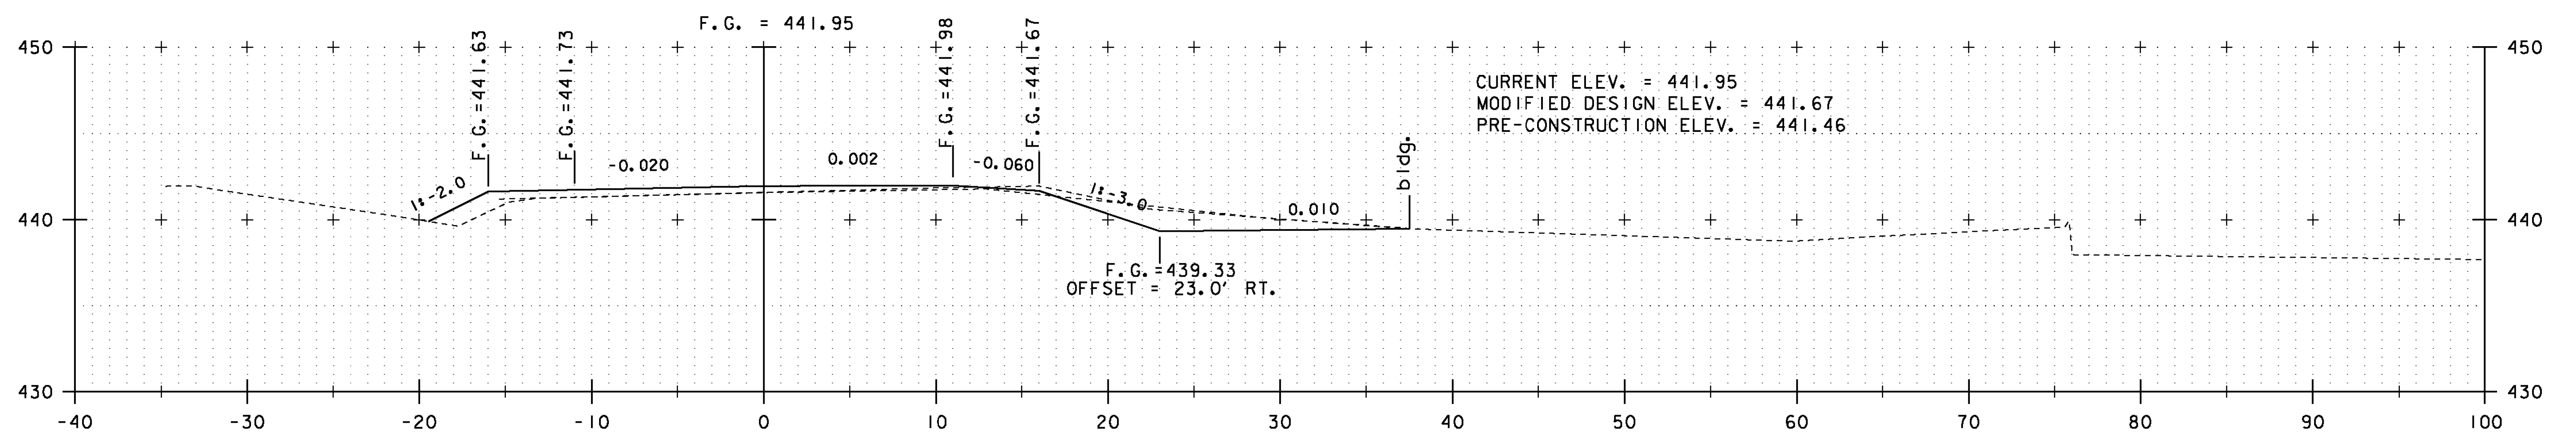

PROJECT NAME: BOLTON-WATERBURY	PLOT DATE: 17-JUL-2014
PROJECT NUMBER: STP 2709(I)	DRAWN BY: L. BULLOCK
FILE NAME: p07c172xs.dgn	CHECKED BY: M. FOWLER
PROJECT LEADER: M. FOWLER	SHEET 8 OF 12
DESIGNED BY: L. BULLOCK	