


SEE SHEETS 207A1-207A4
FOR AMENDED CROSS SECTIONS
A 149+75 - A 151+00

STA. A 150+00 TO STA. A 154+00

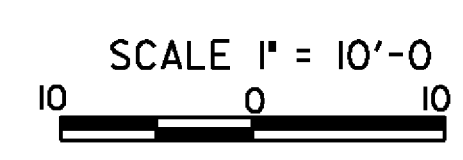

CROSS SECTION SHEET 81	PROJECT NAME: BOLTON-WATERBURY	PLOT DATE: 4/16/2013
	PROJECT NUMBER: STP 2709(1)	DRAWN BY: BMB
	FILE NAME: p07C172.dgn	CHECKED BY: CDL
	PROJECT LEADER: CDL	SHEET 207 OF 217
	DESIGNED BY: BMB	
	PLOT FILE: p07C172-207.1	