




A 164+50

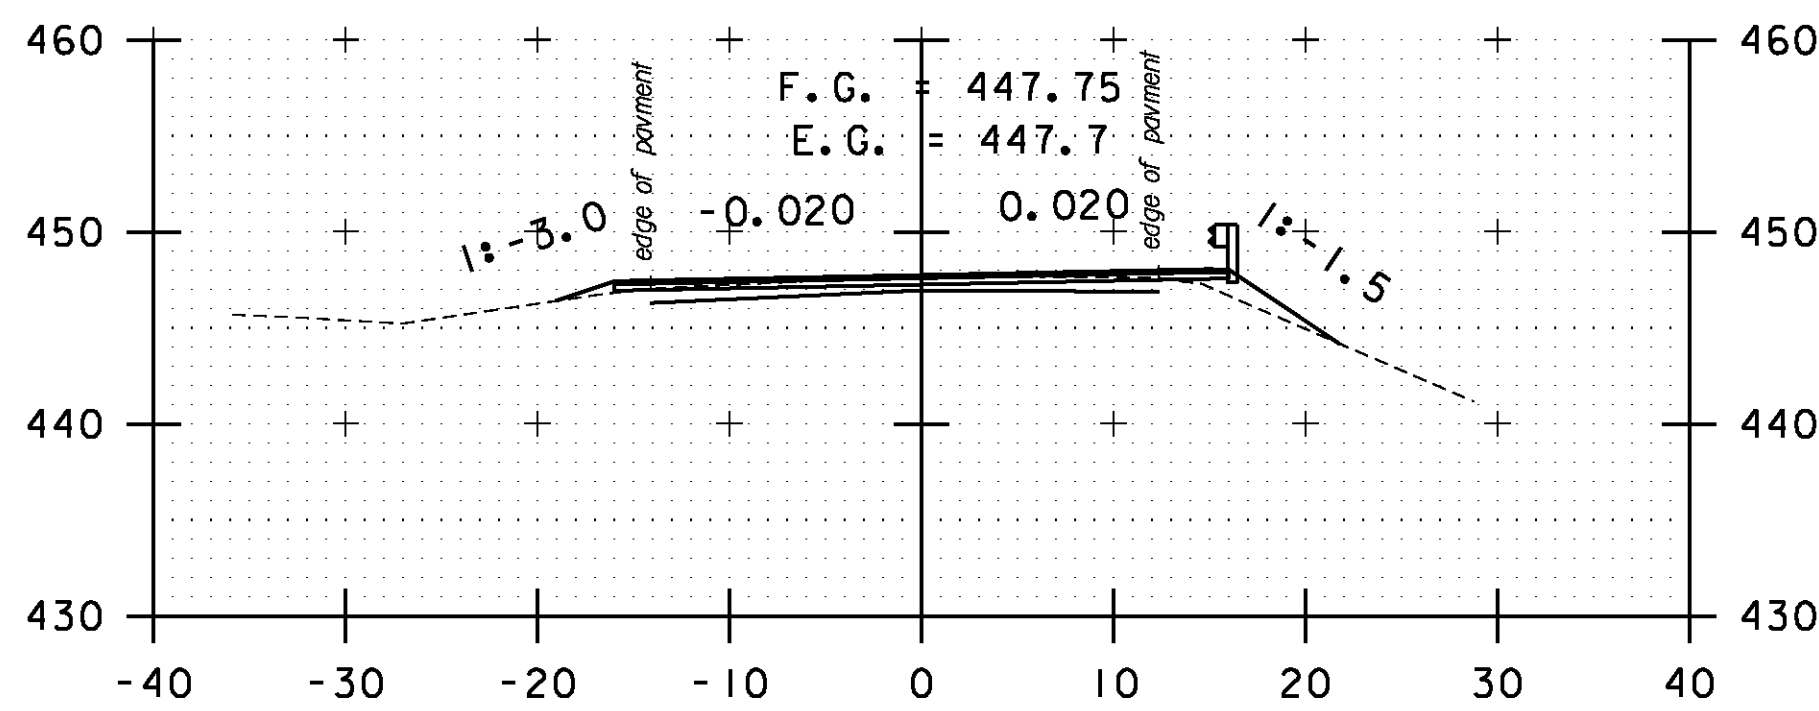


A 166+00

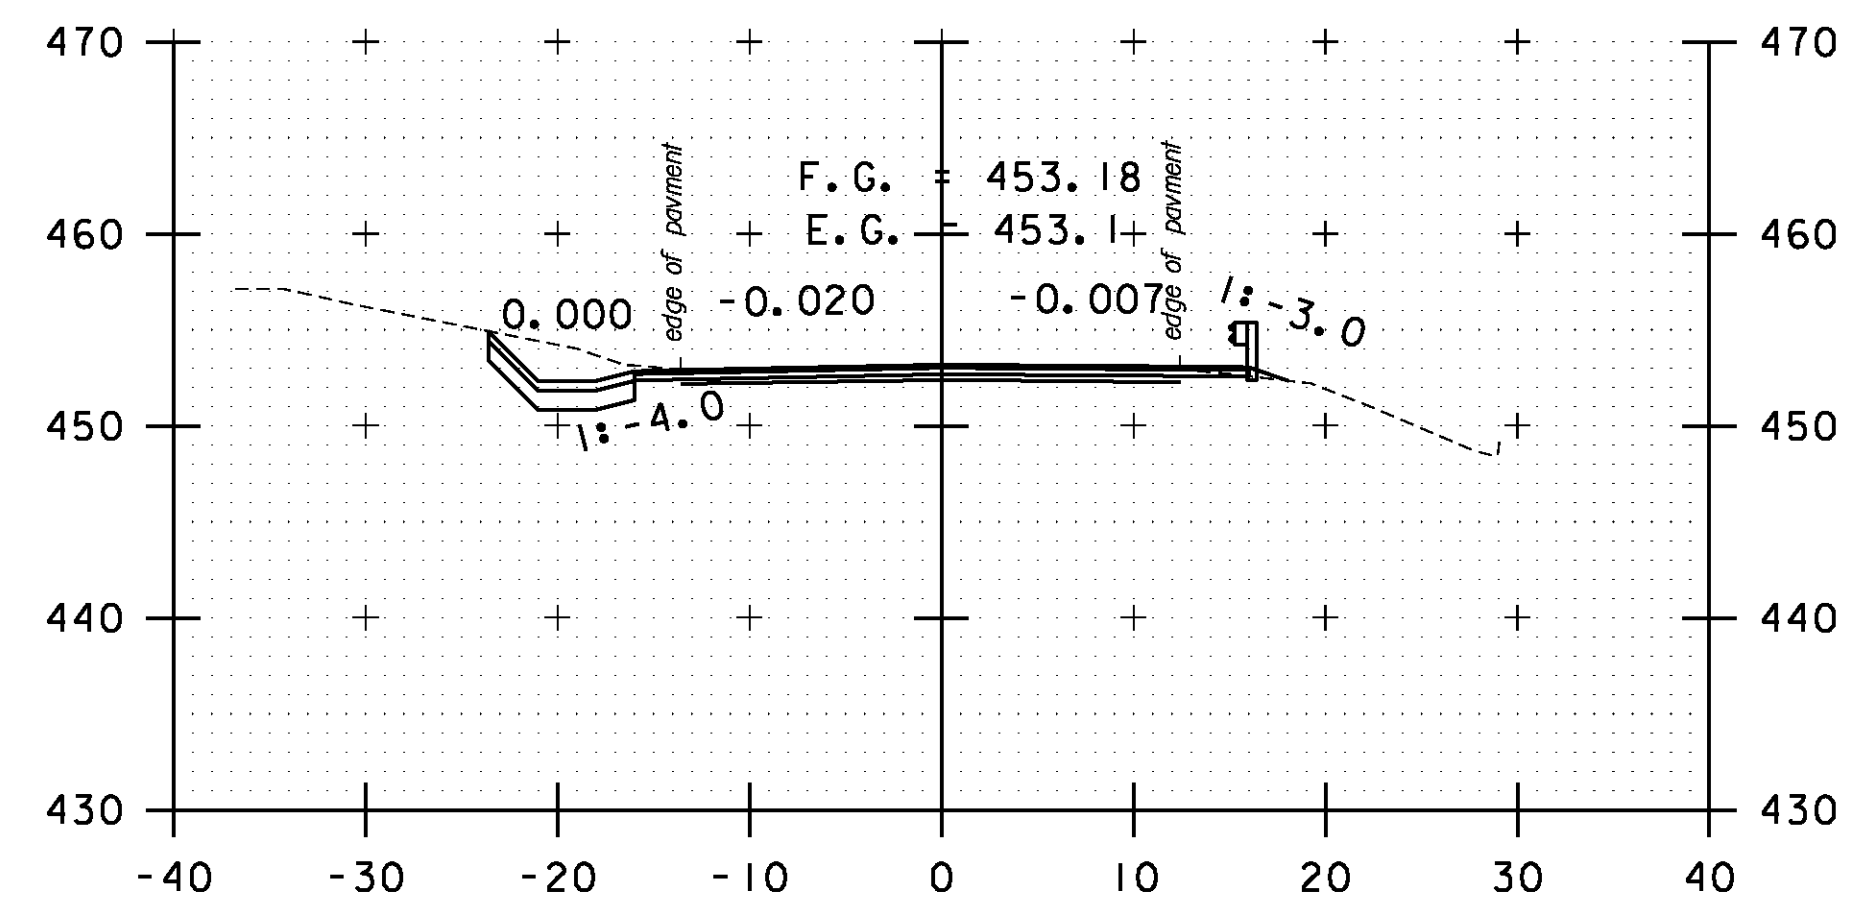


A 167+50

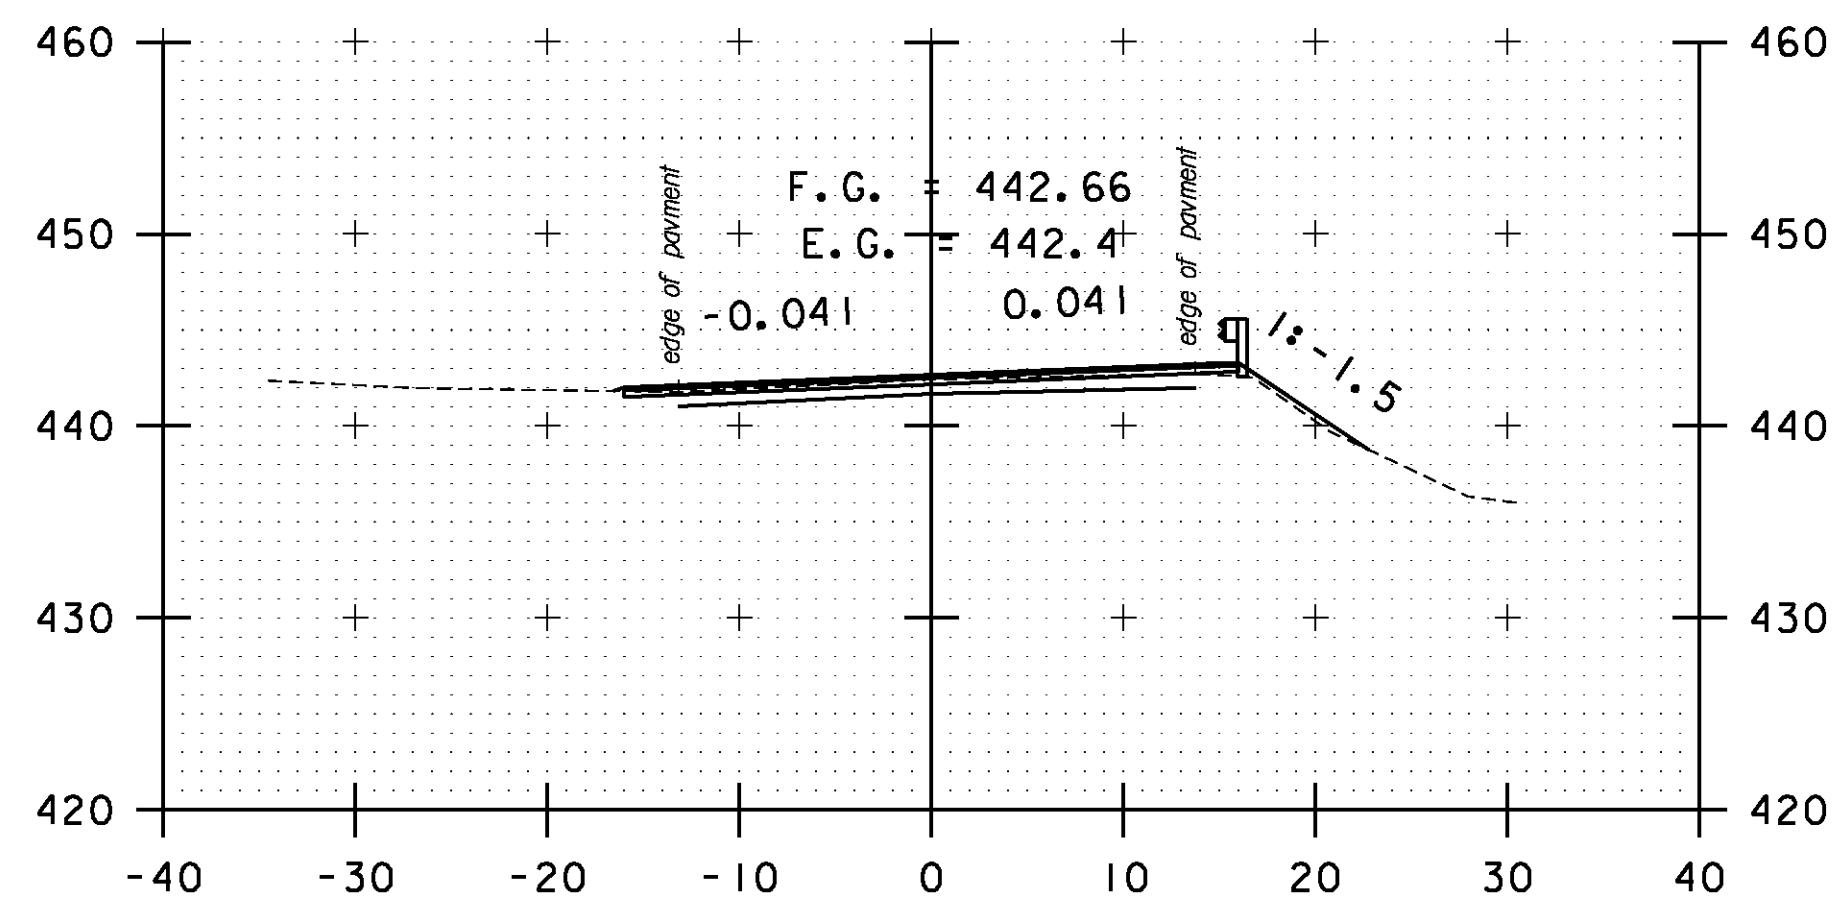


A 164+00

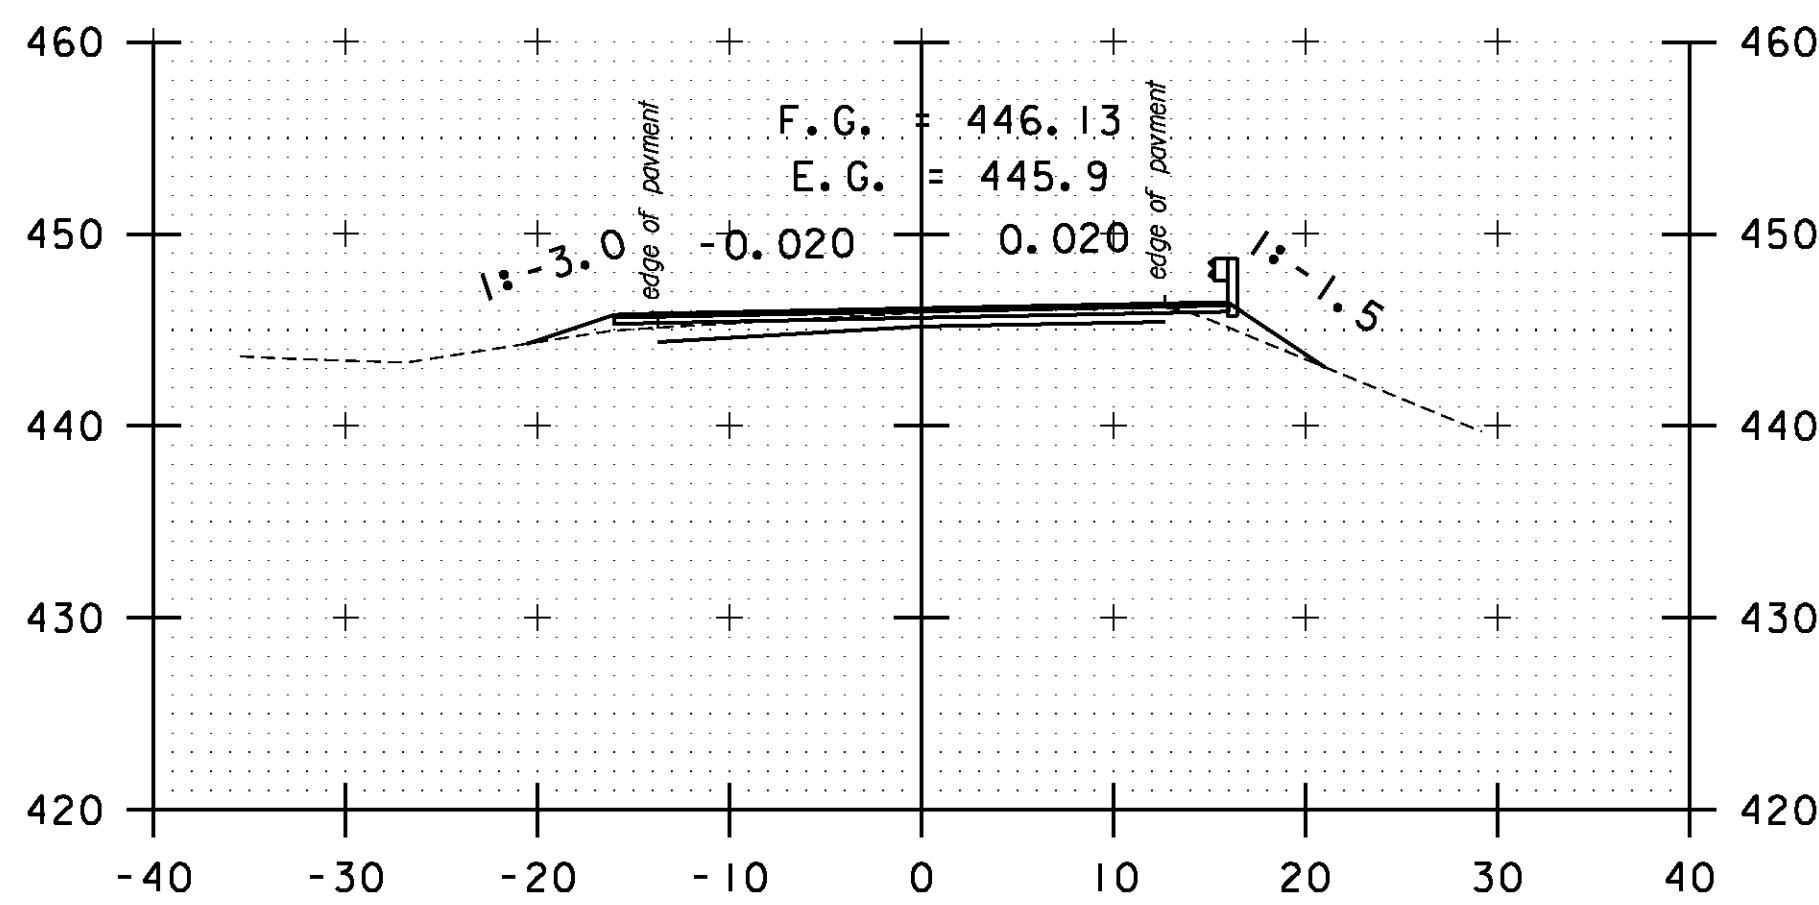


A 165+50

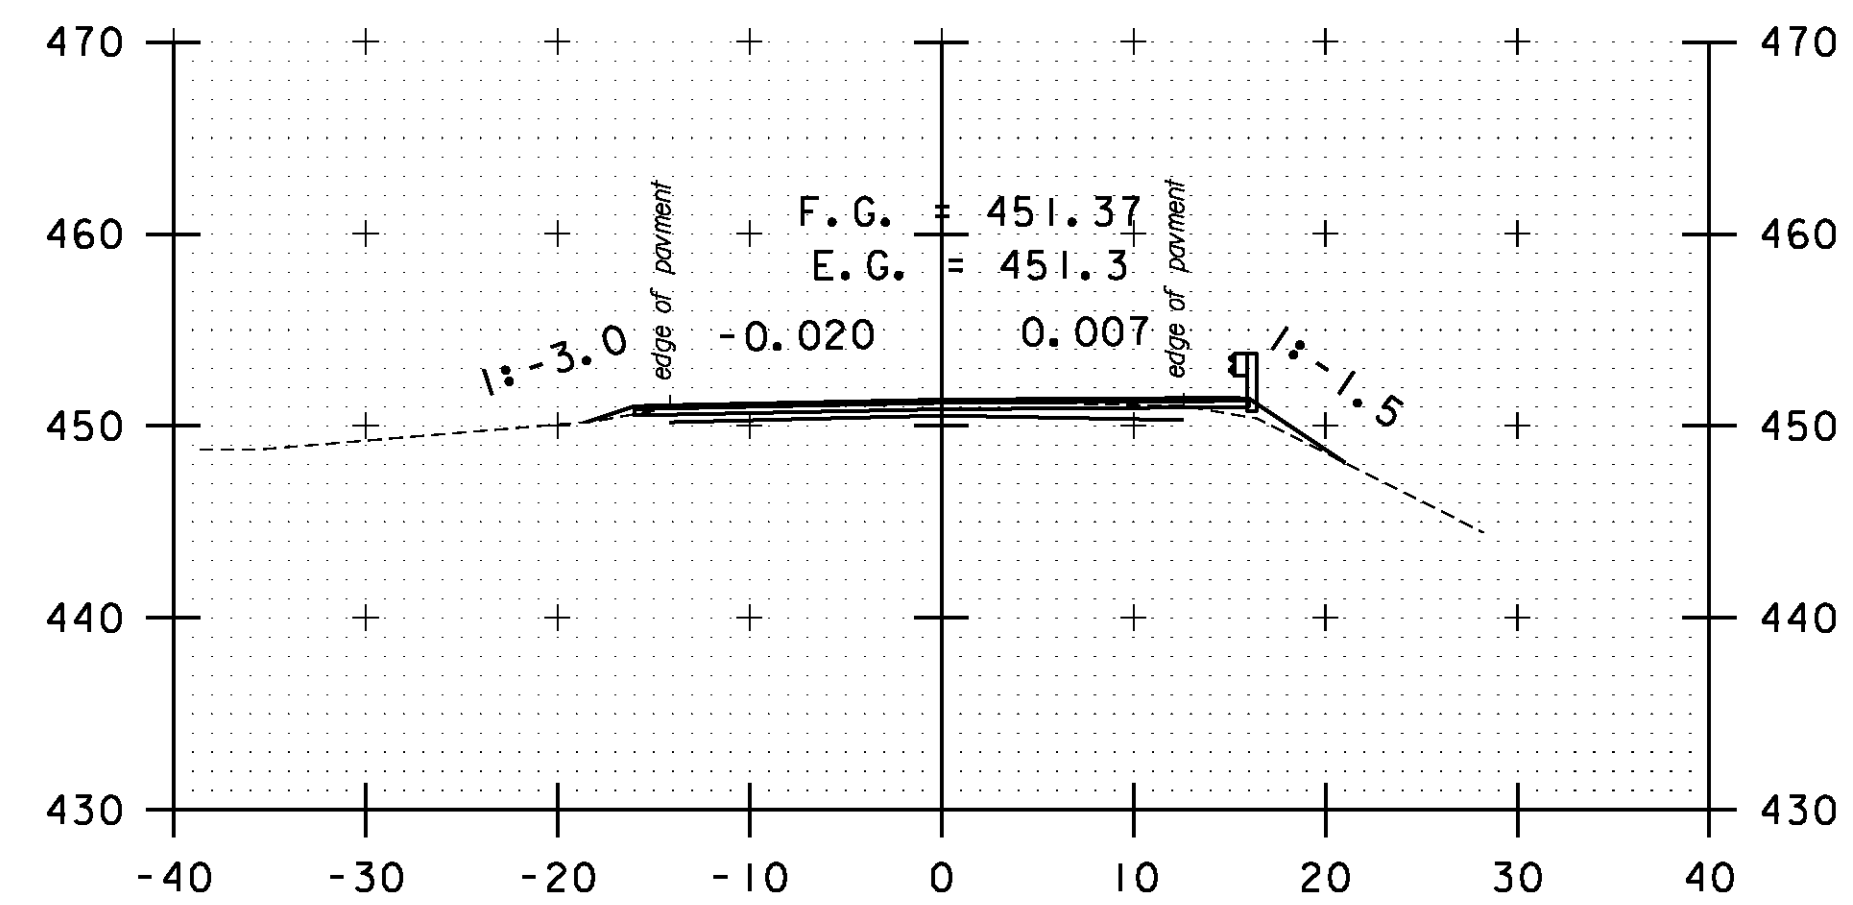


A 167+00

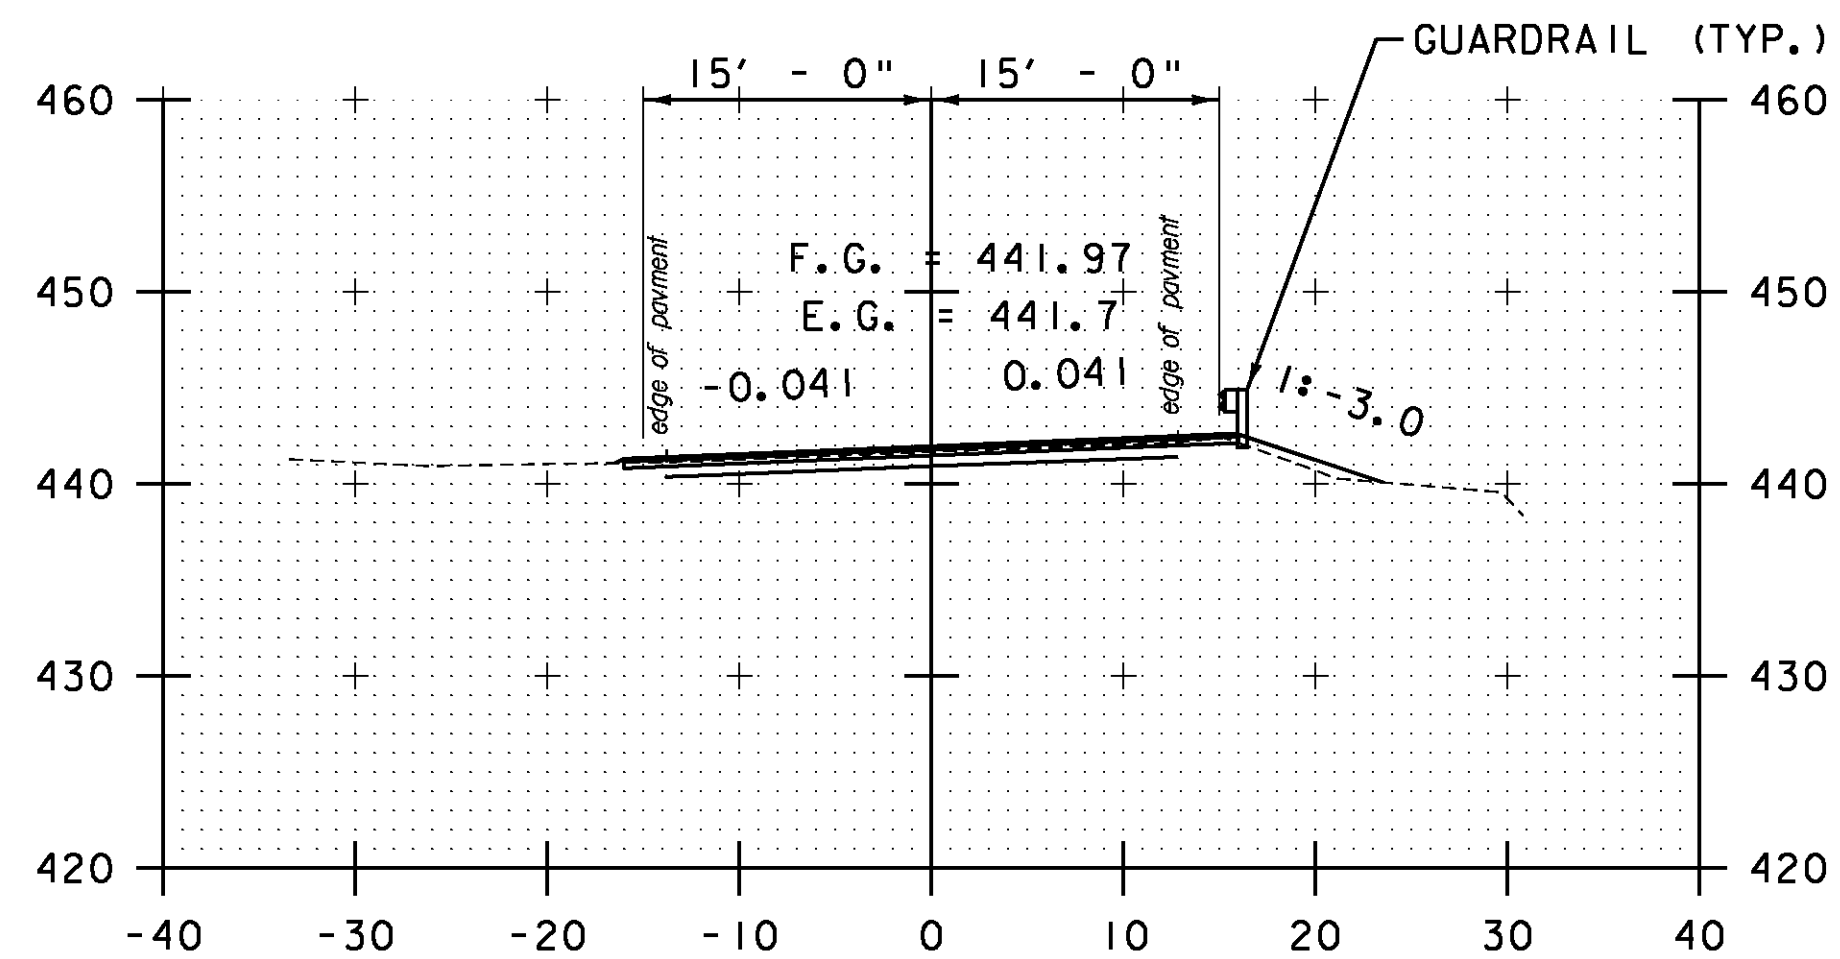

A 163+50

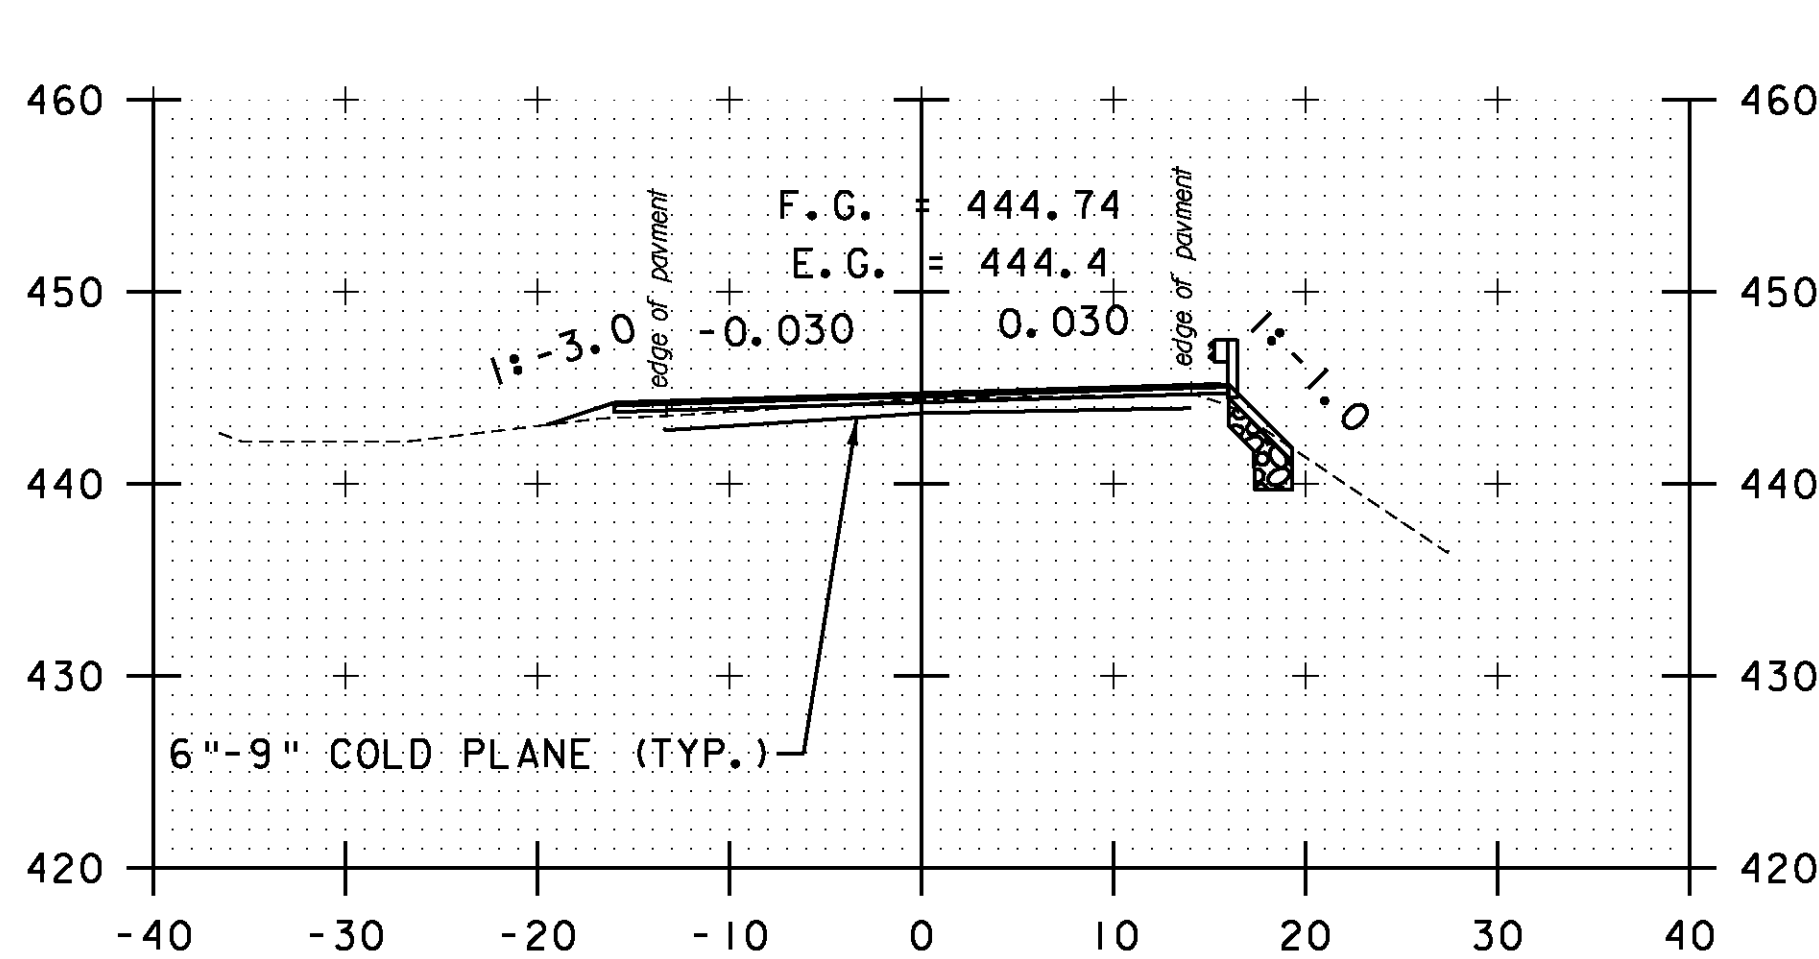


A 165+00

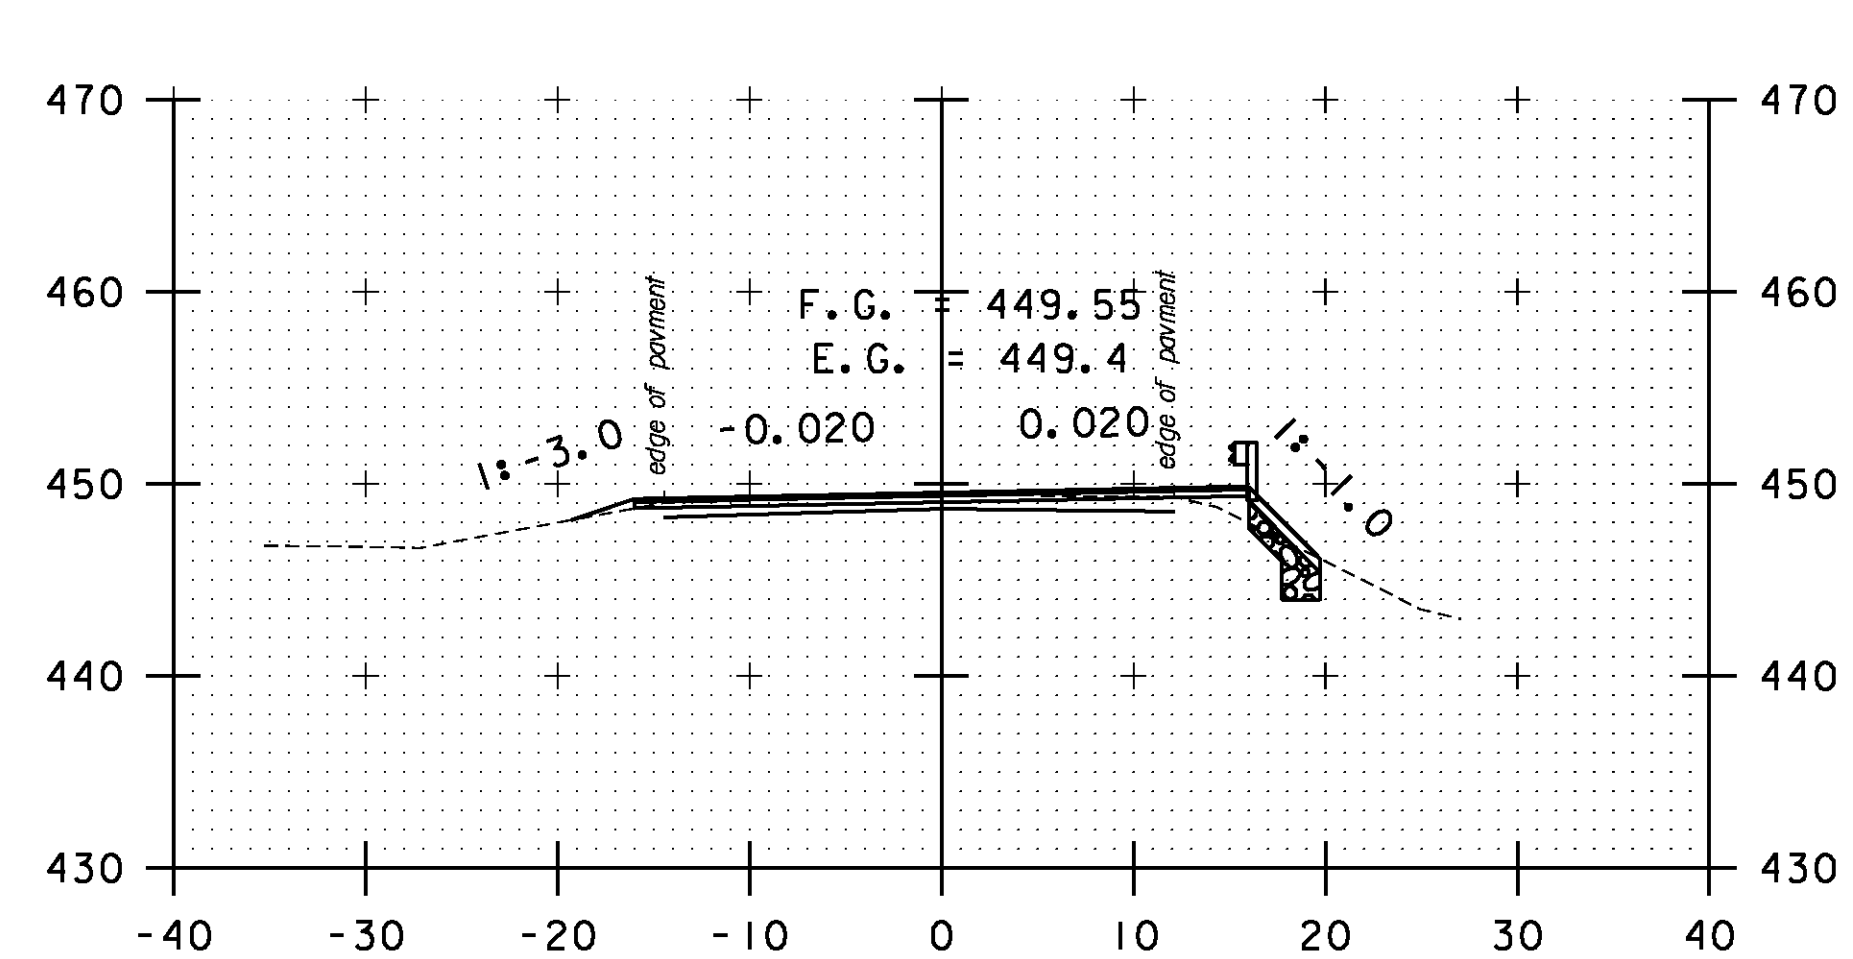

A 166+50

STA. A 163+50 TO STA. A 167+50

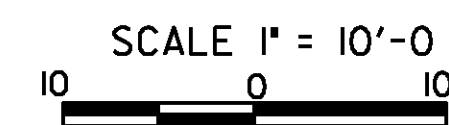

**CROSS SECTION SHEET 84**

PROJECT NAME: BOLTON-WATERBURY

PROJECT NUMBER: STP 2709(I)

FILE NAME: p07C172.dgn

PROJECT LEADER: CDL

DESIGNED BY: BMB

PLOT FILE: p07C172\_210.1

PLOT DATE: 4/16/2013

DRAWN BY: BMB

CHECKED BY: CDL

SHEET 210 OF 217