




A 169+00

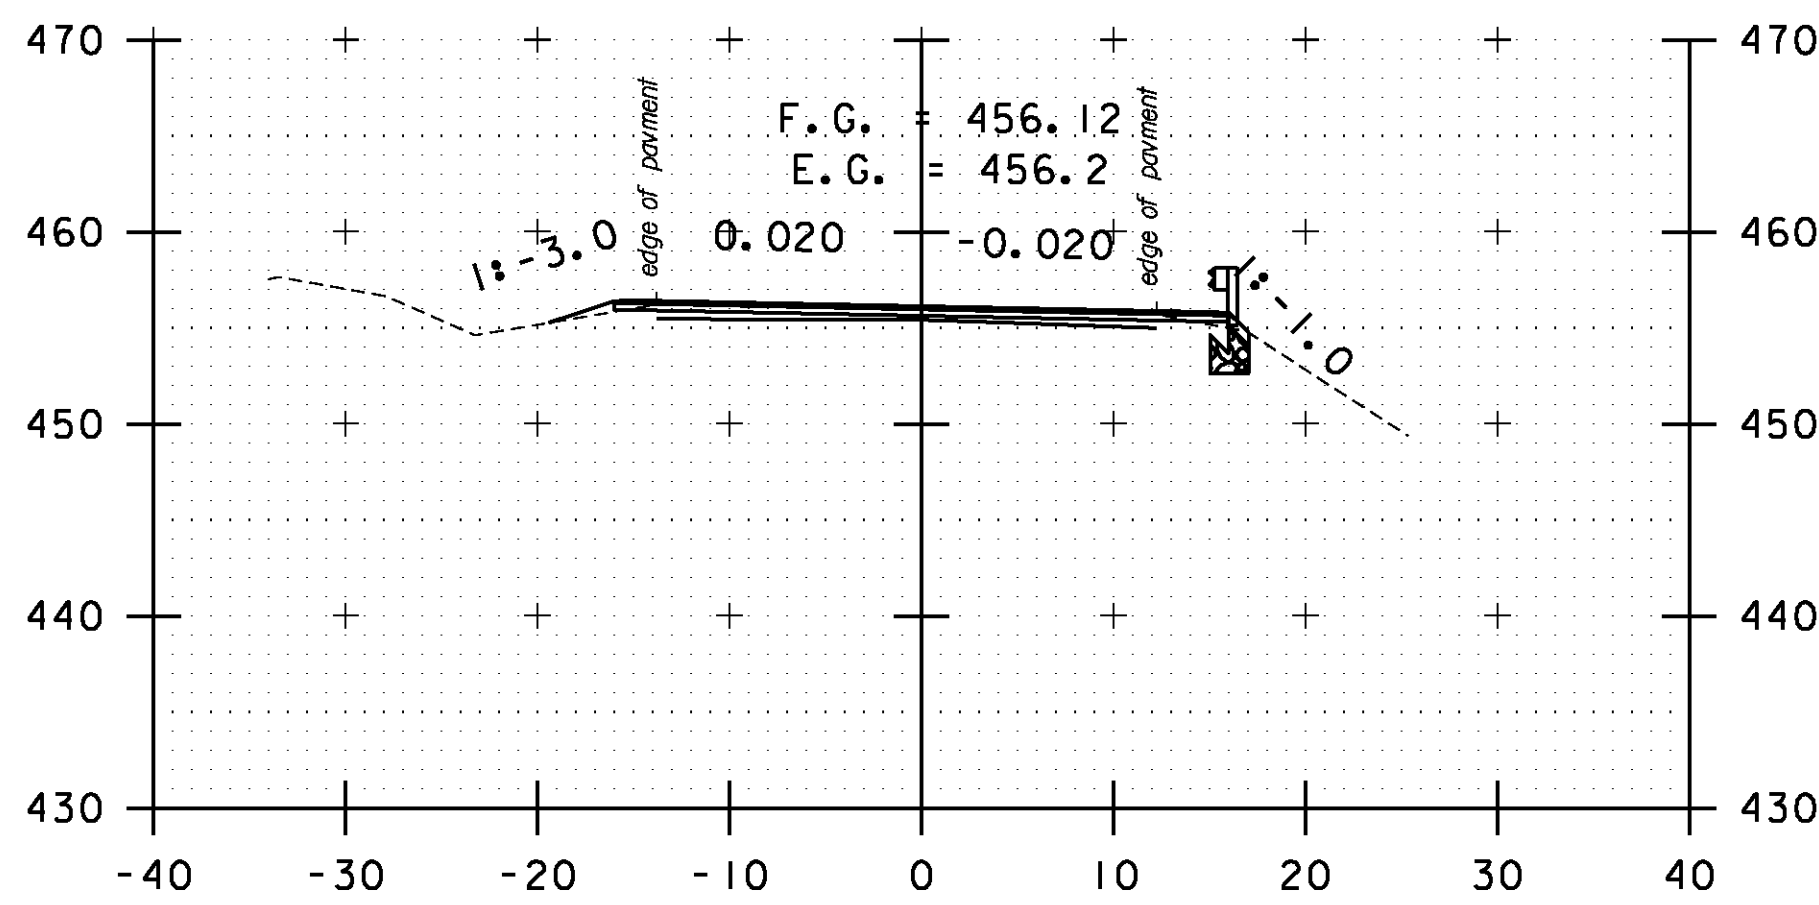


A 170+50

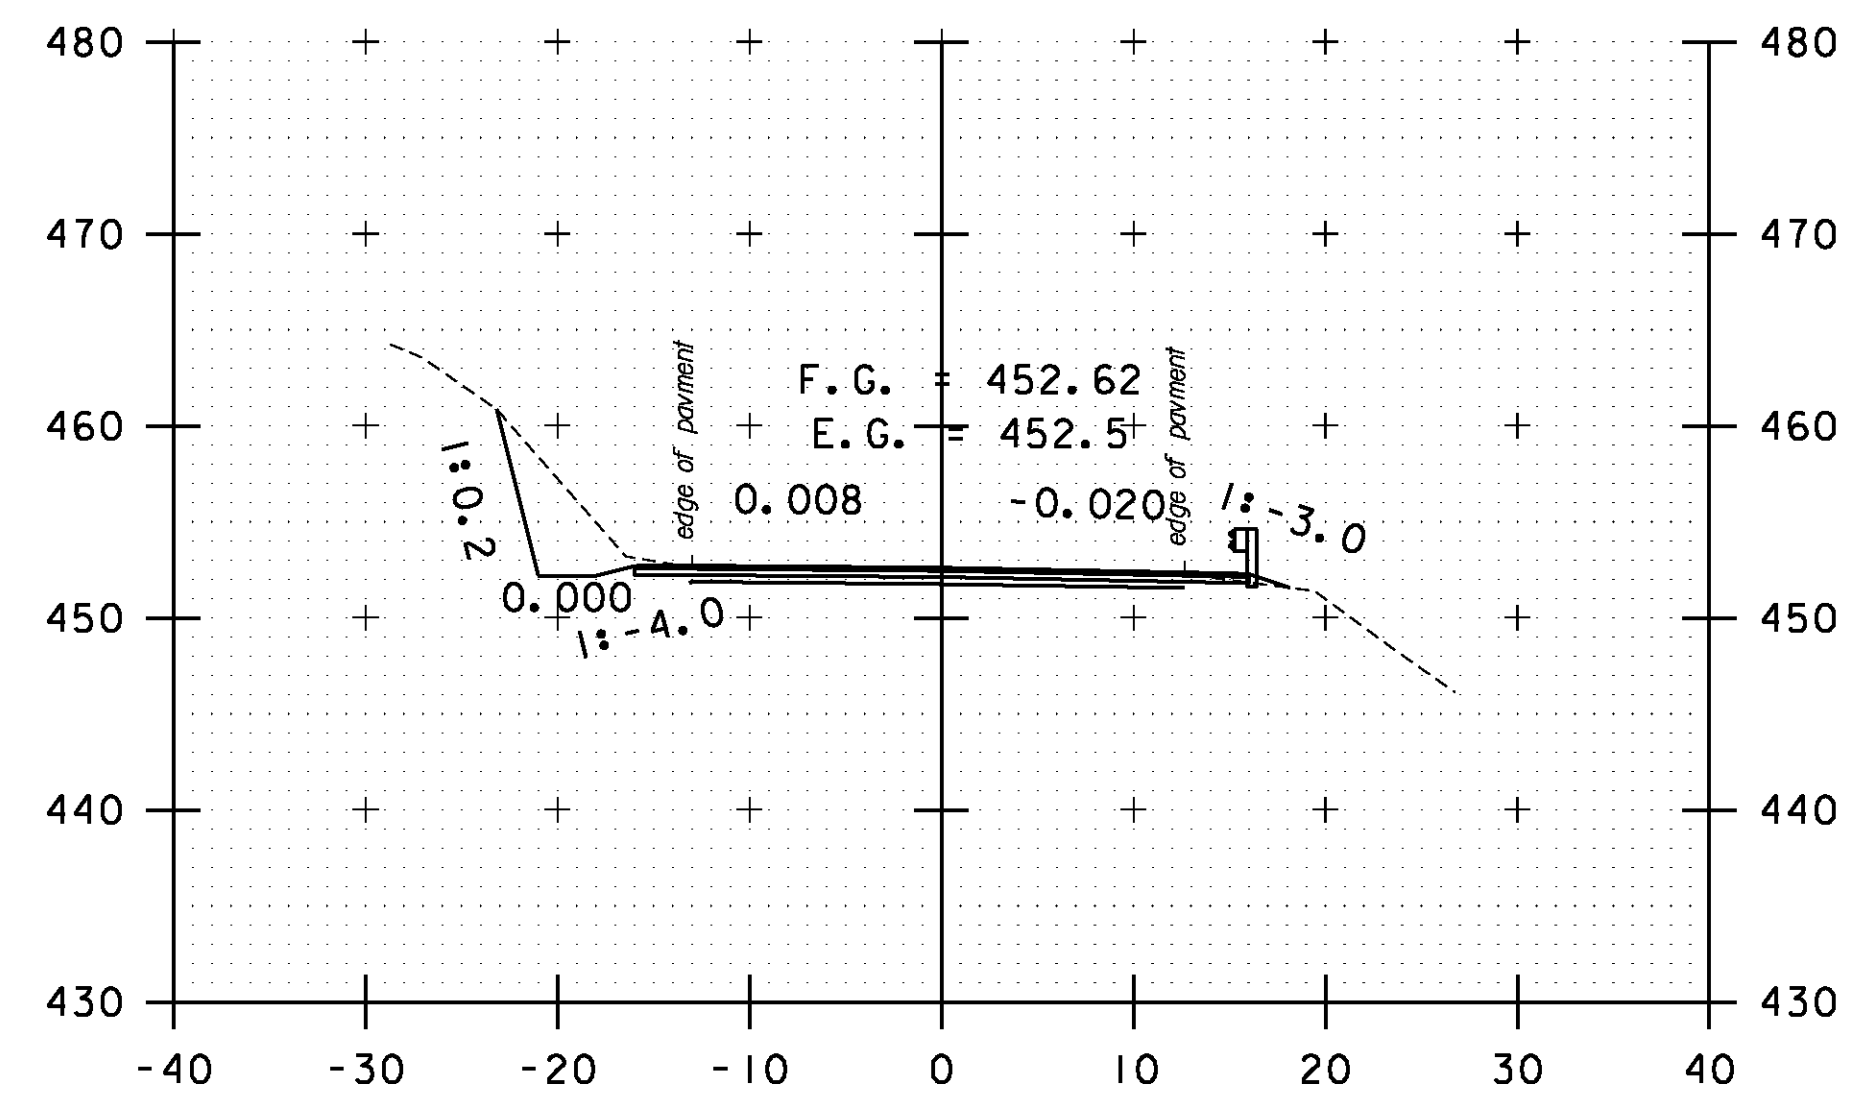


A 172+00

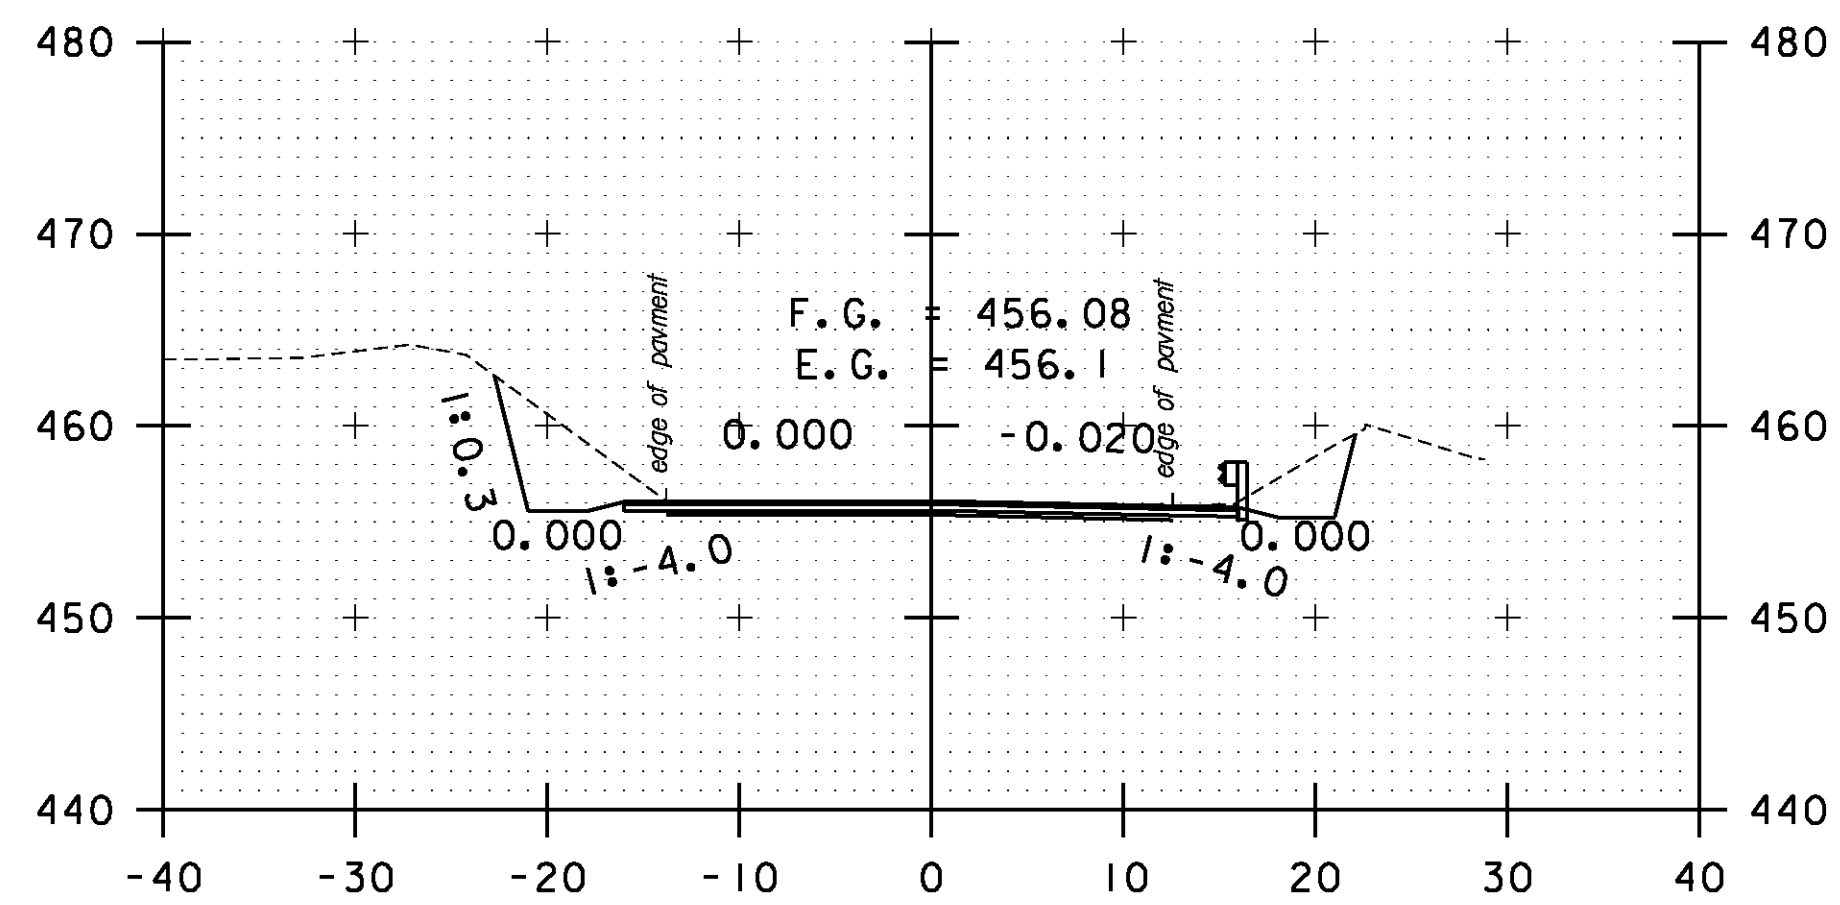


A 168+50

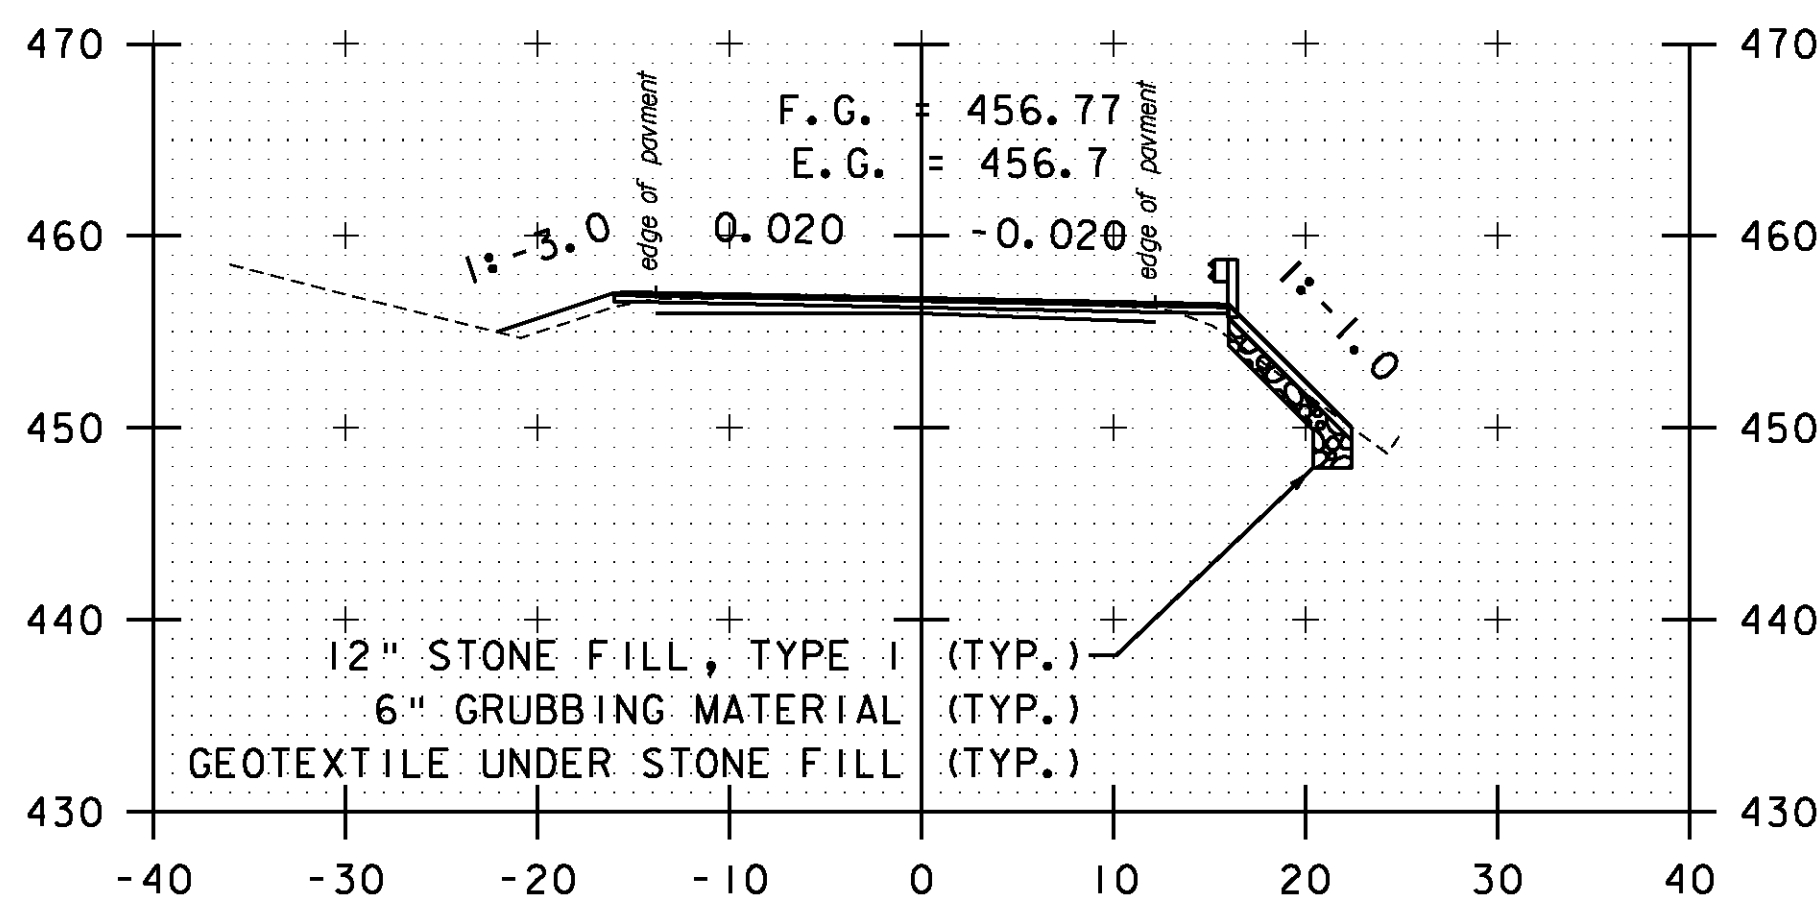


A 170+00

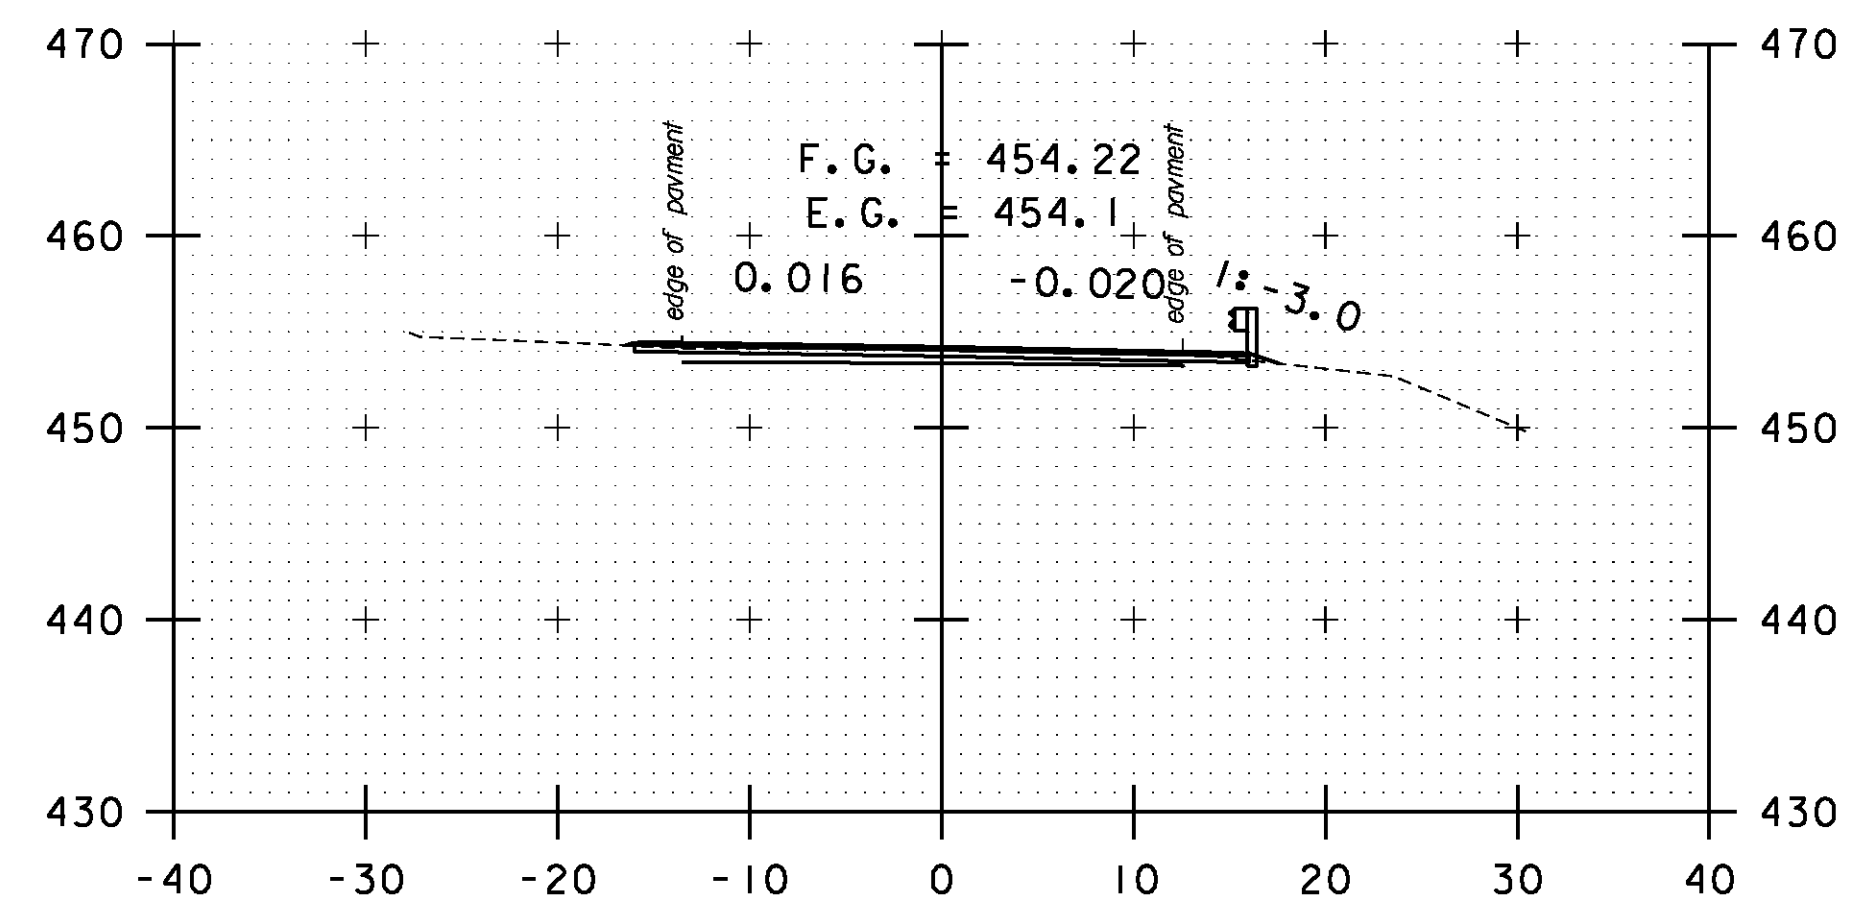


A 171+50

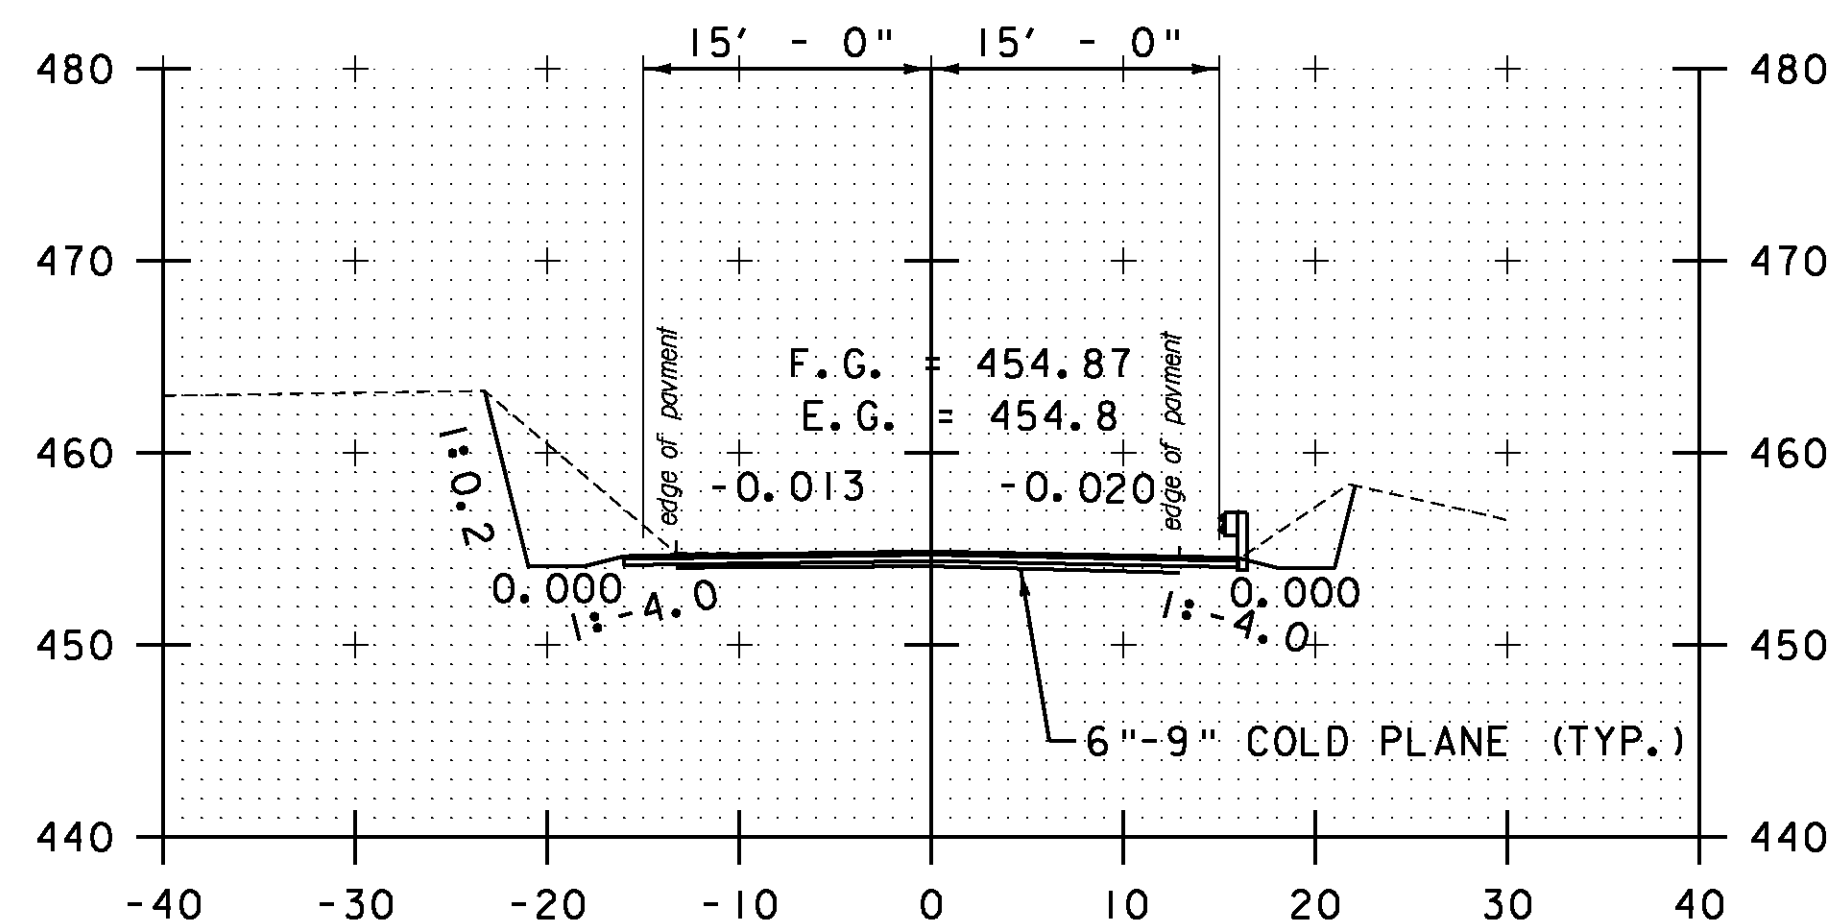

A 168+00

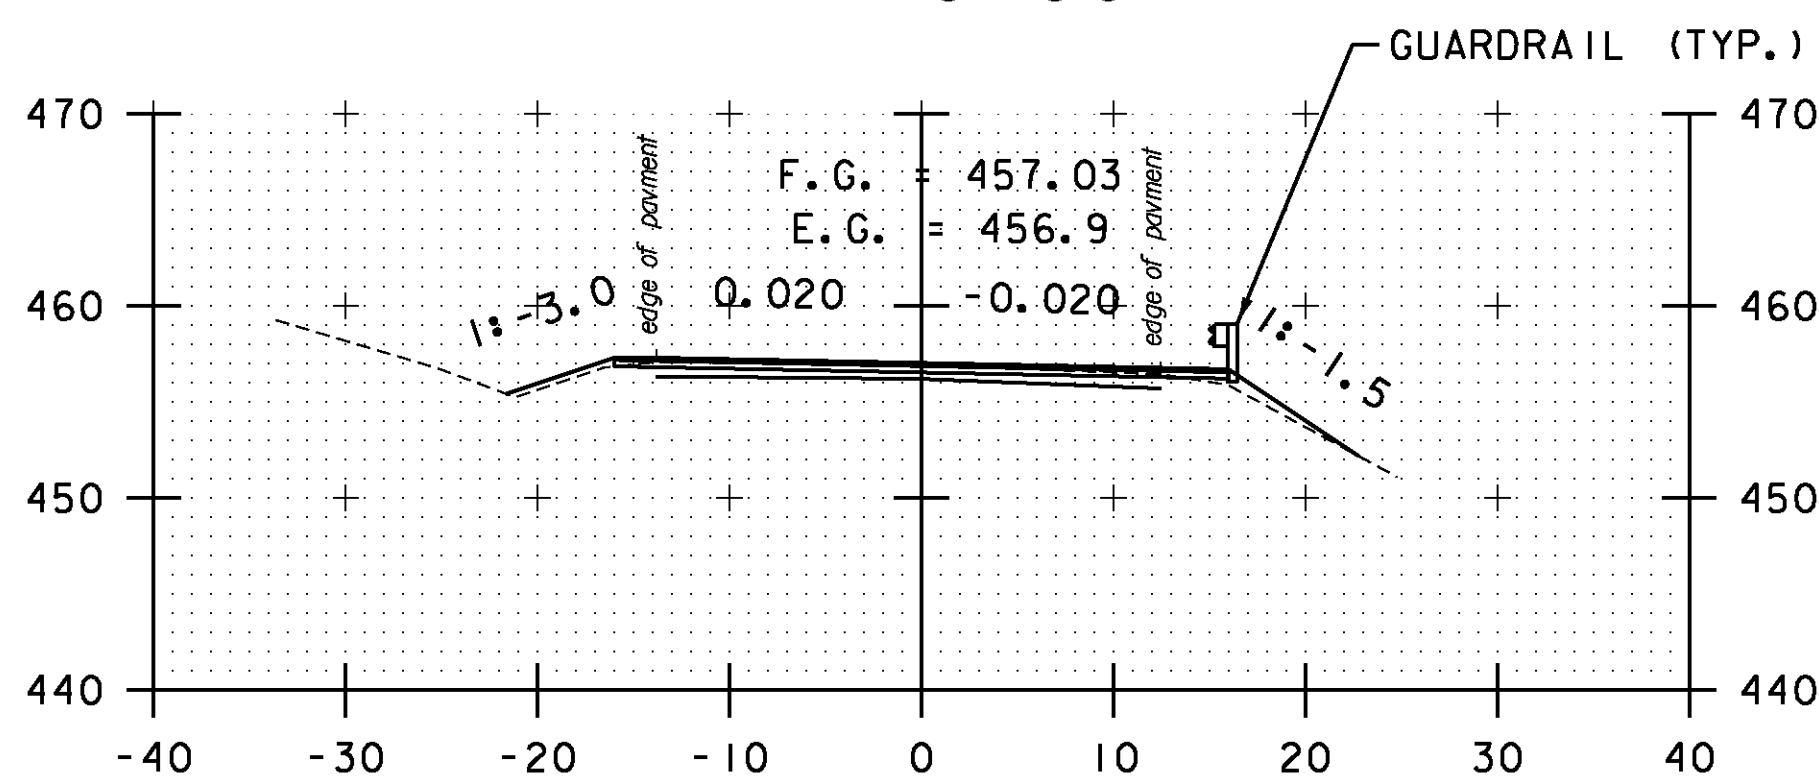

A 169+50

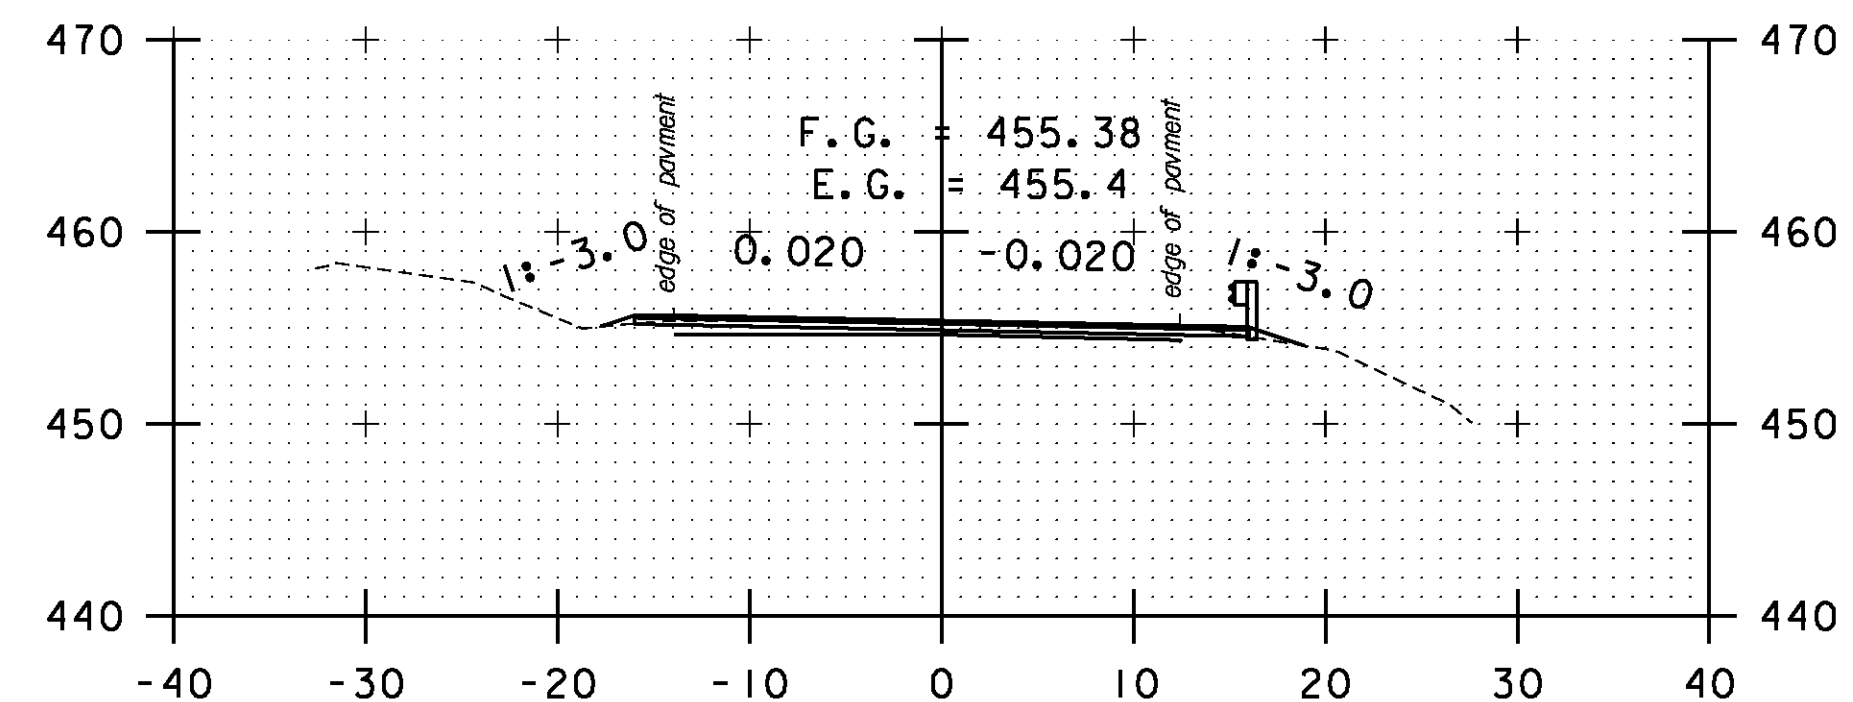

A 171+00

STA. A 168+00 TO STA. A 172+00



**CROSS SECTION SHEET 85**

PROJECT NAME: BOLTON-WATERBURY  
PROJECT NUMBER: STP 2709(1)

FILE NAME: p07C172.dgn  
PROJECT LEADER: CDL  
DESIGNED BY: BMB  
PLOT FILE: p07C172\_211.f

PLOT DATE: 4/16/2013  
DRAWN BY: BMB  
CHECKED BY: CDL  
SHEET 211 OF 217