




A 178+00

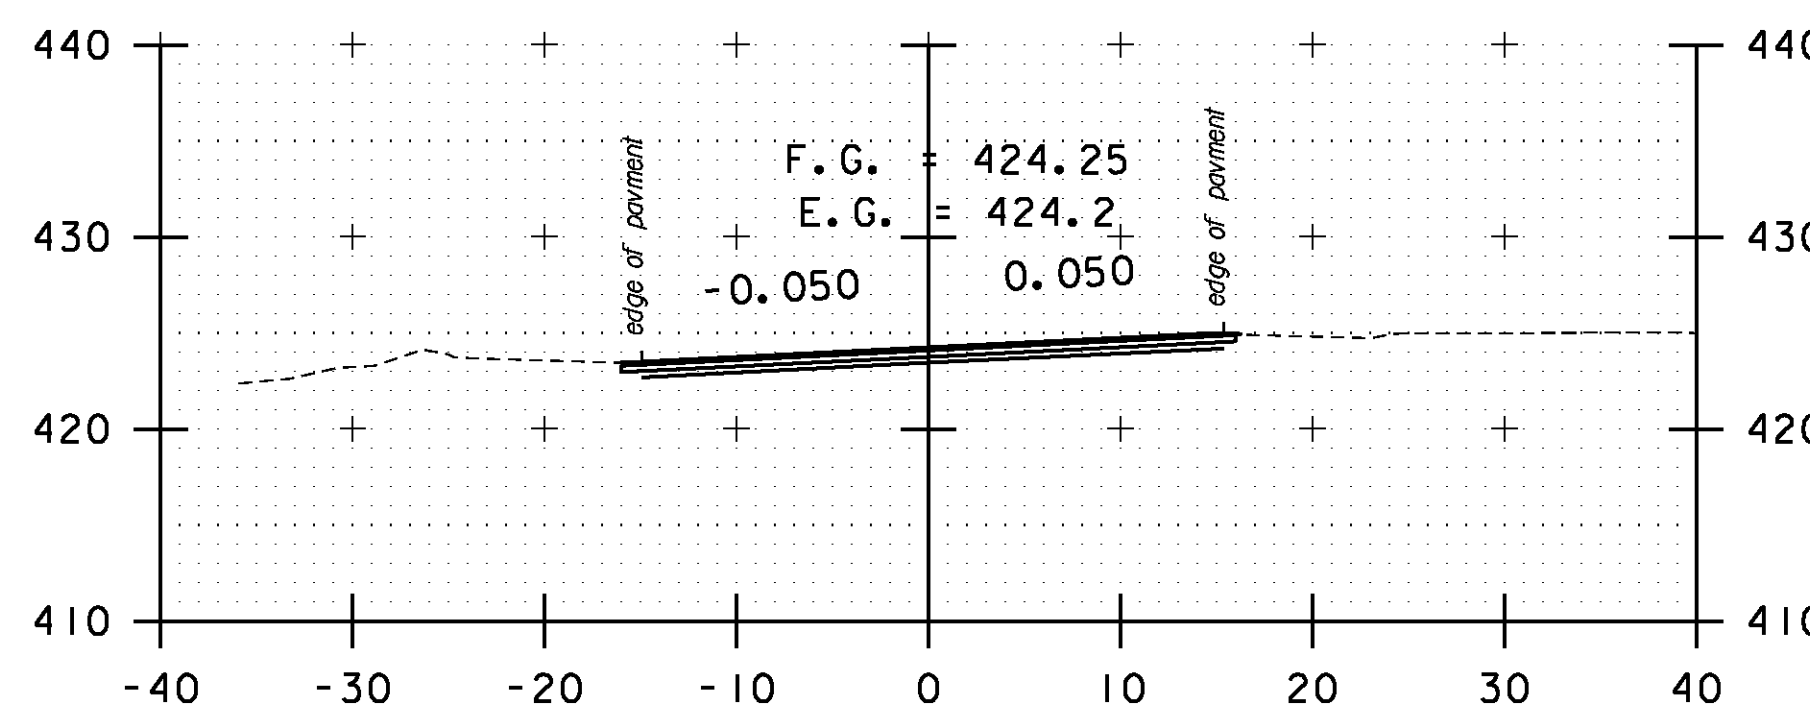


A 179+50

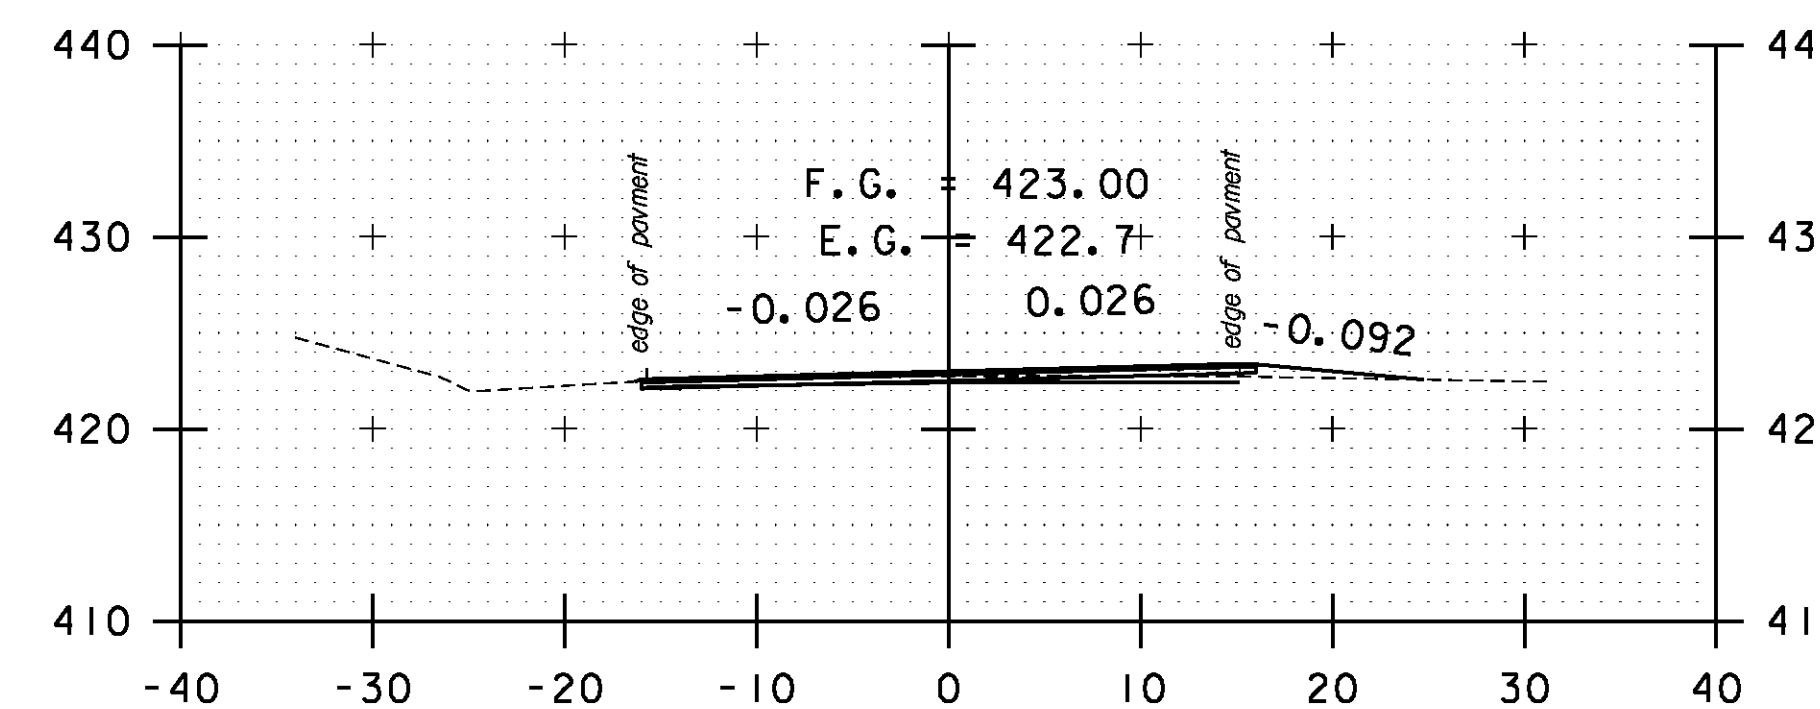


DRIVE RT  
A 181+00

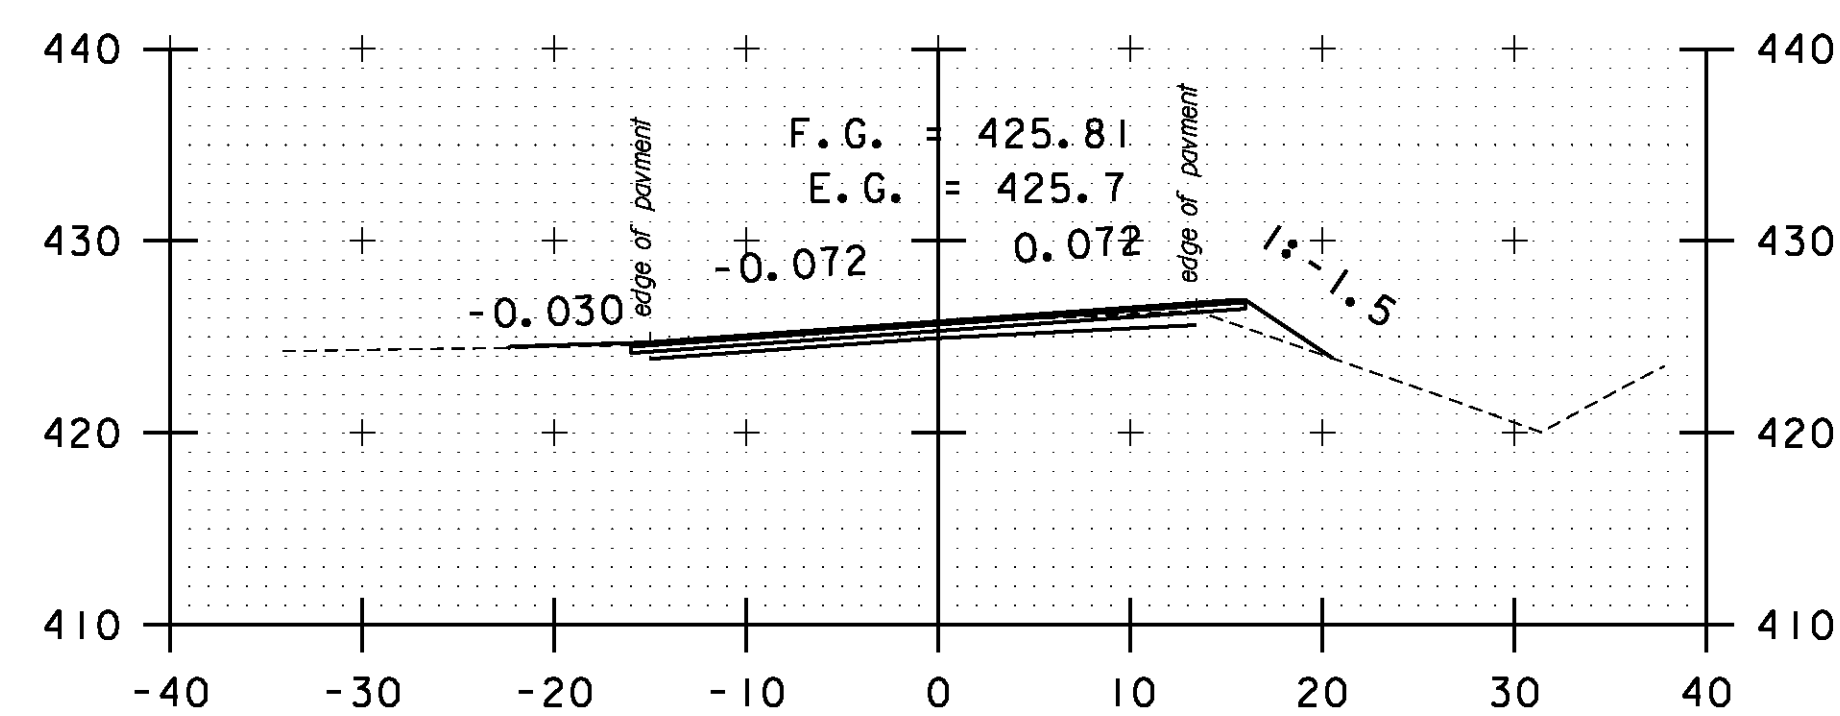


PULL OFF LT  
A 177+50

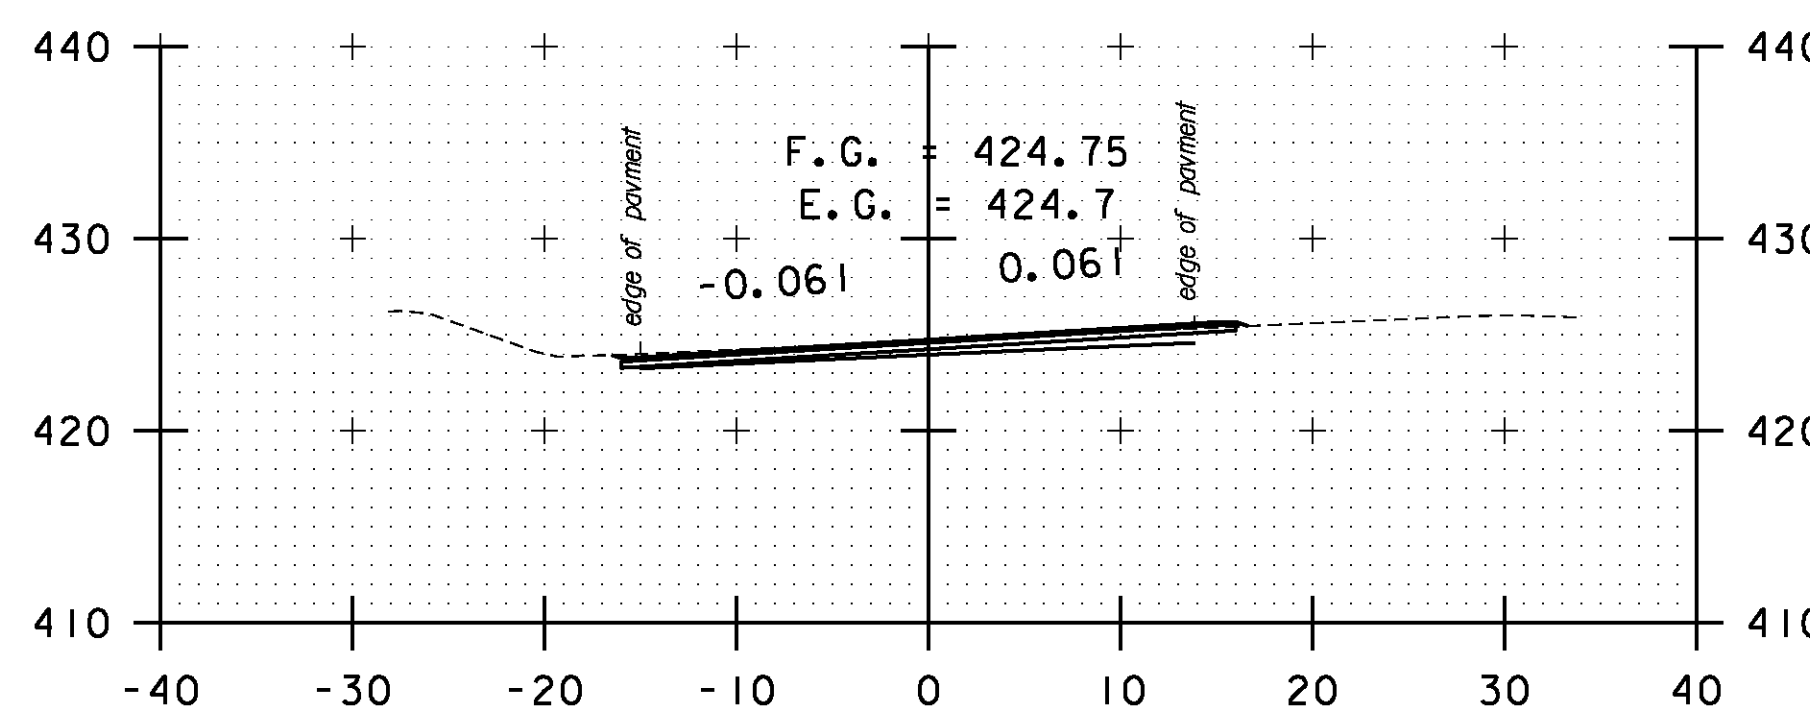


A 179+00

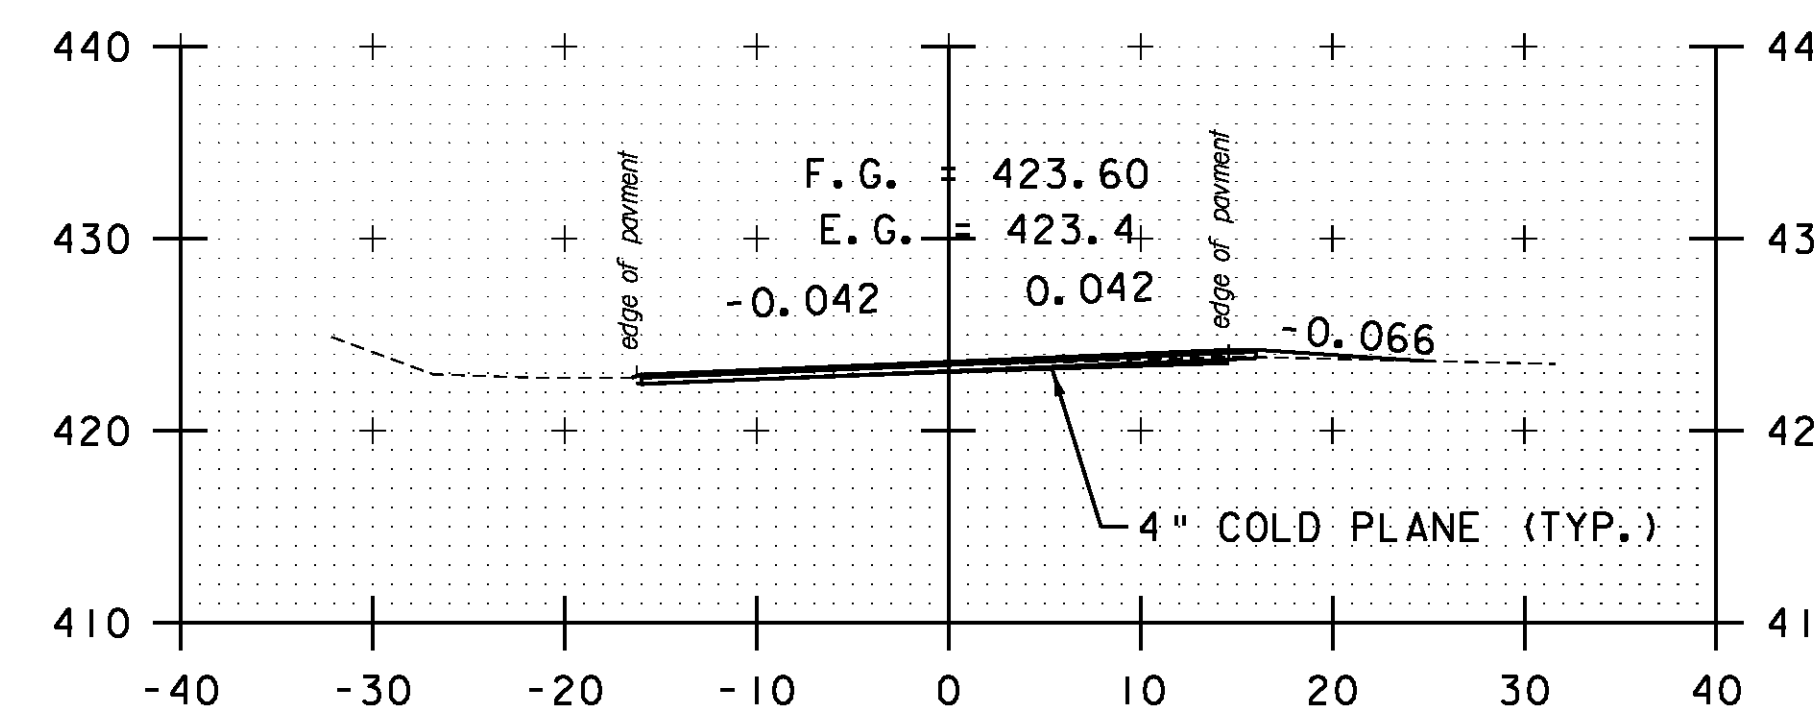


DRIVE RT  
A 180+50

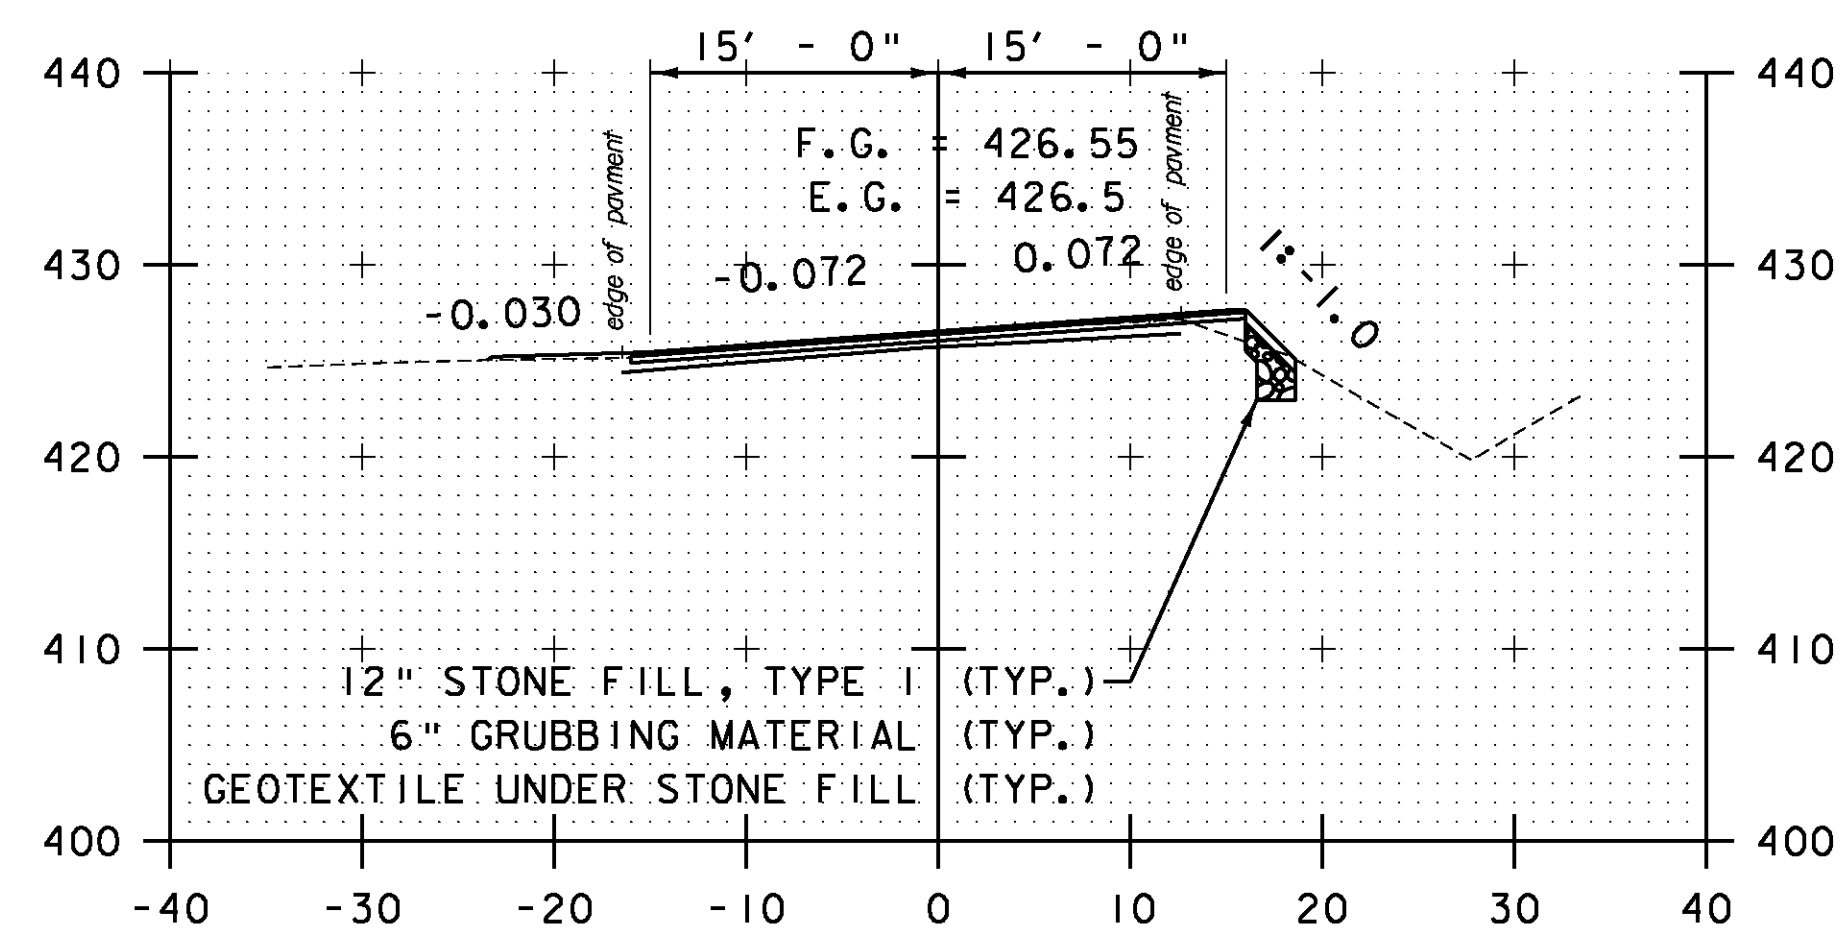

PULL OFF LT  
A 177+00

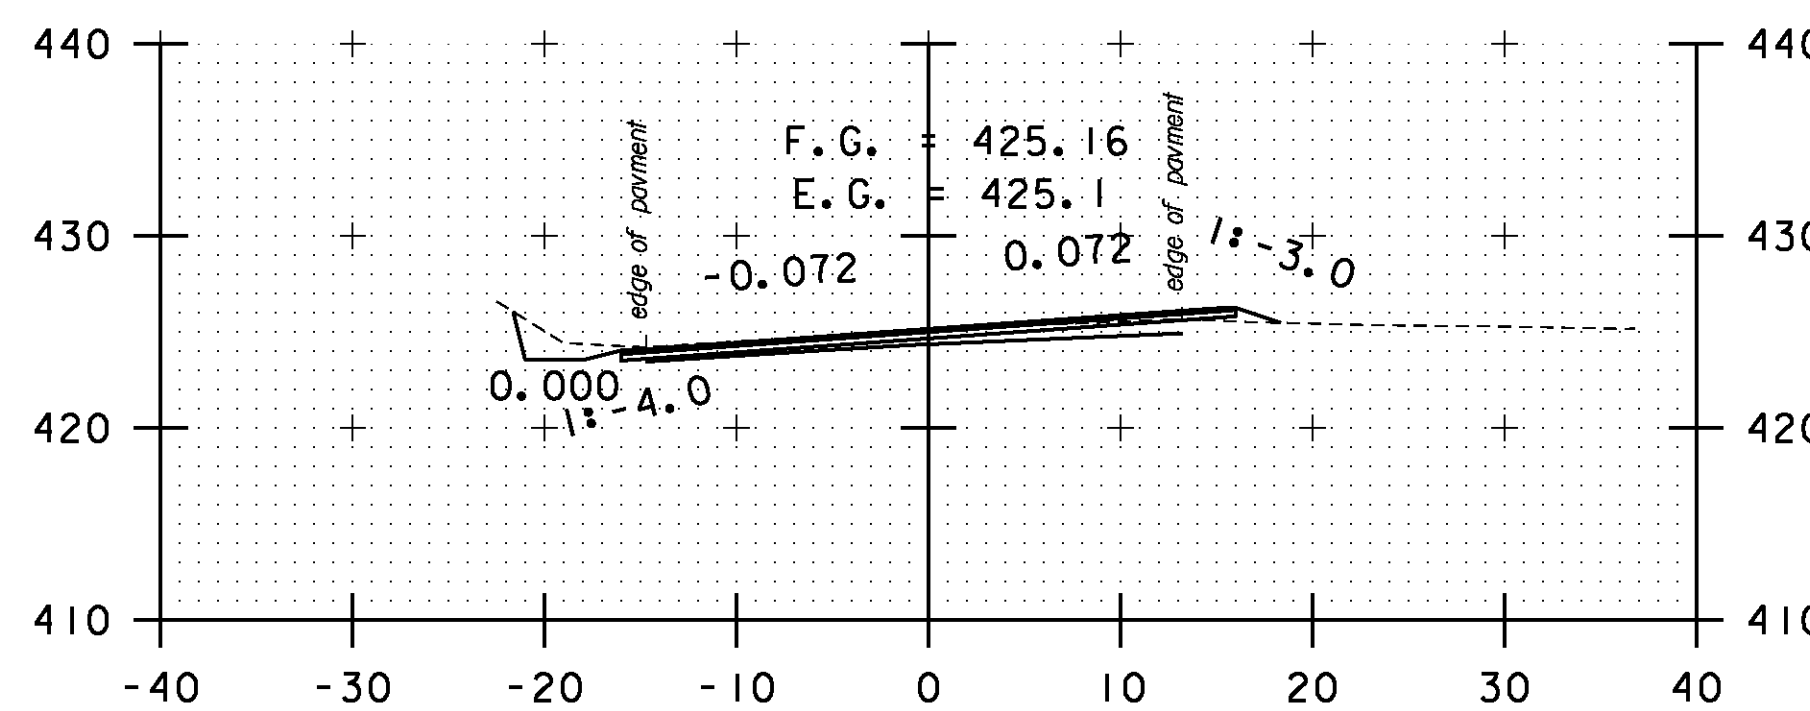

A 178+50

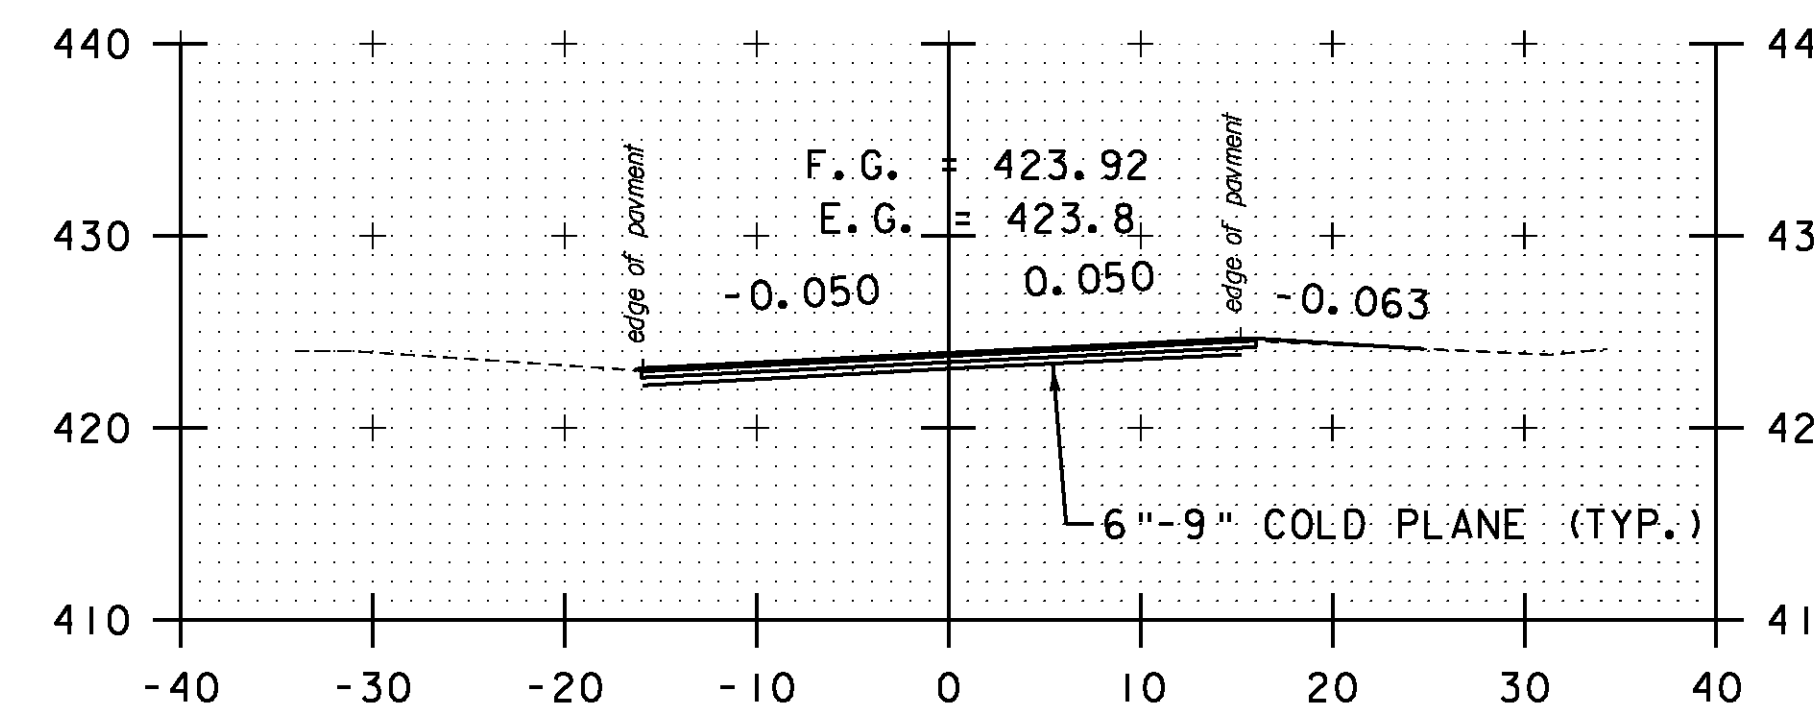

DRIVE RT  
A 180+00

STA. A 177+00 TO STA. A 181+00

SCALE 1" = 10'-0"  
10 0 10

**CROSS SECTION SHEET 87**

PROJECT NAME: BOLTON-WATERBURY

PROJECT NUMBER: STP 2709(1)

FILE NAME: p07C172.dgn

PROJECT LEADER: CDL

DESIGNED BY: BMB

PLOT FILE: p07C172\_213.1

PLOT DATE: 4/16/2013

DRAWN BY: BMB

CHECKED BY: CDL

SHEET 213 OF 217