




A 182+50

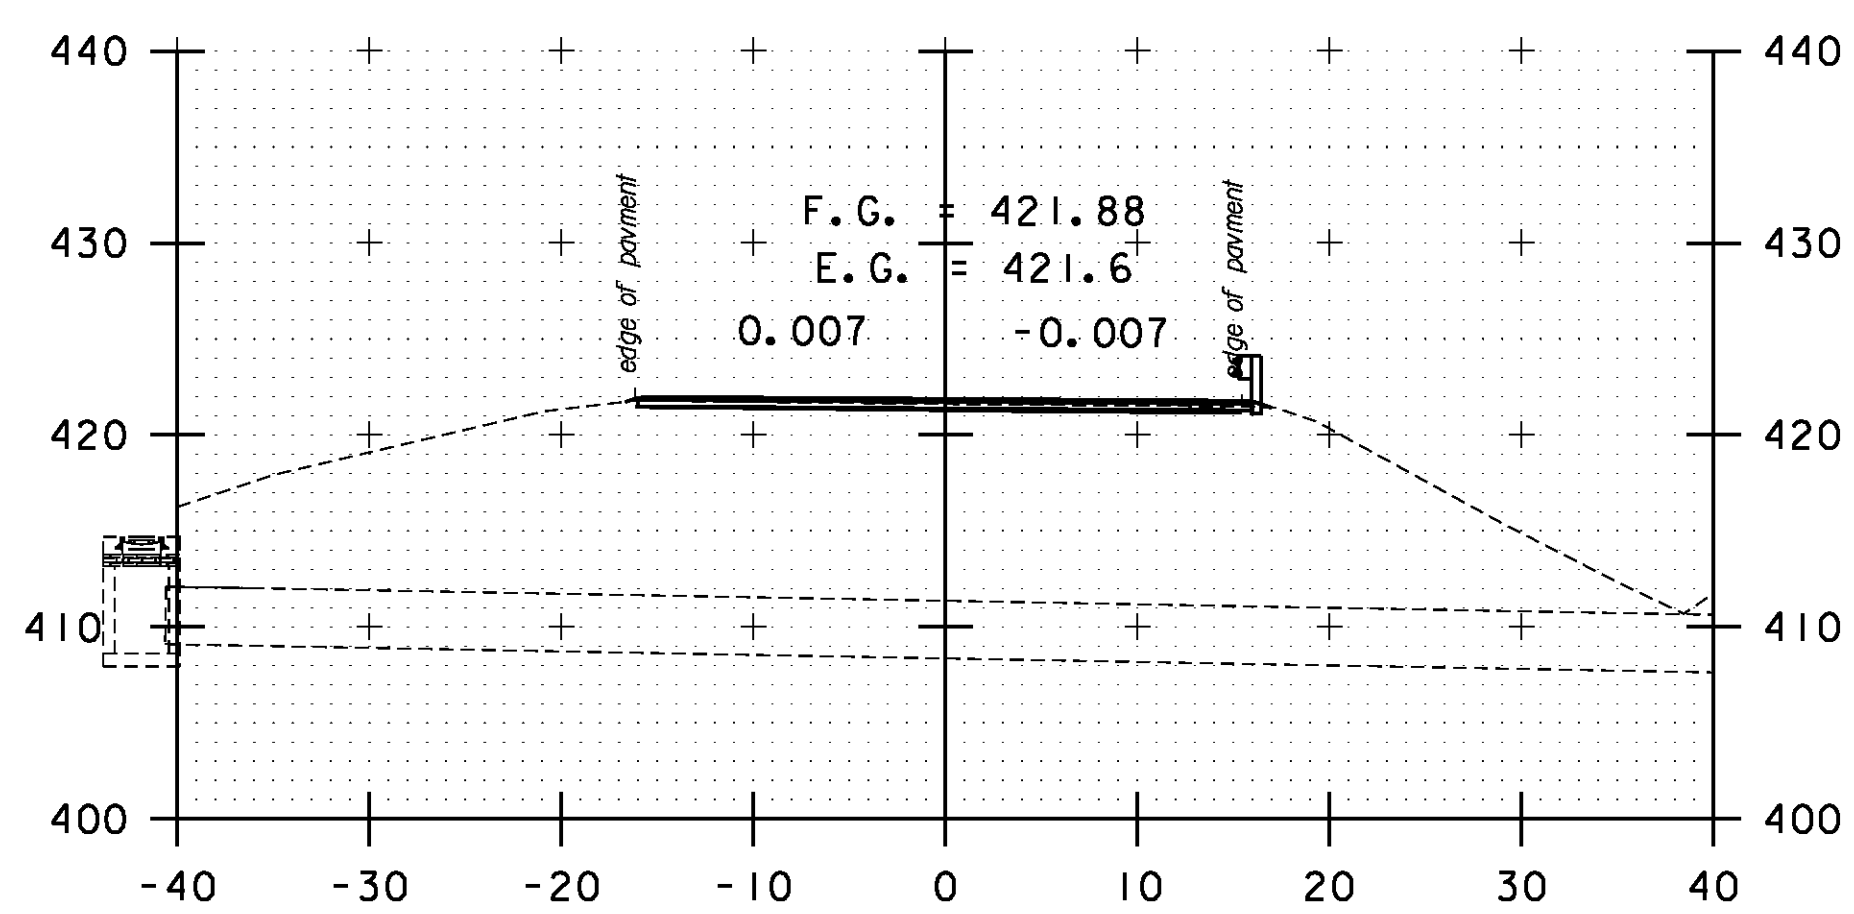


A 182+00

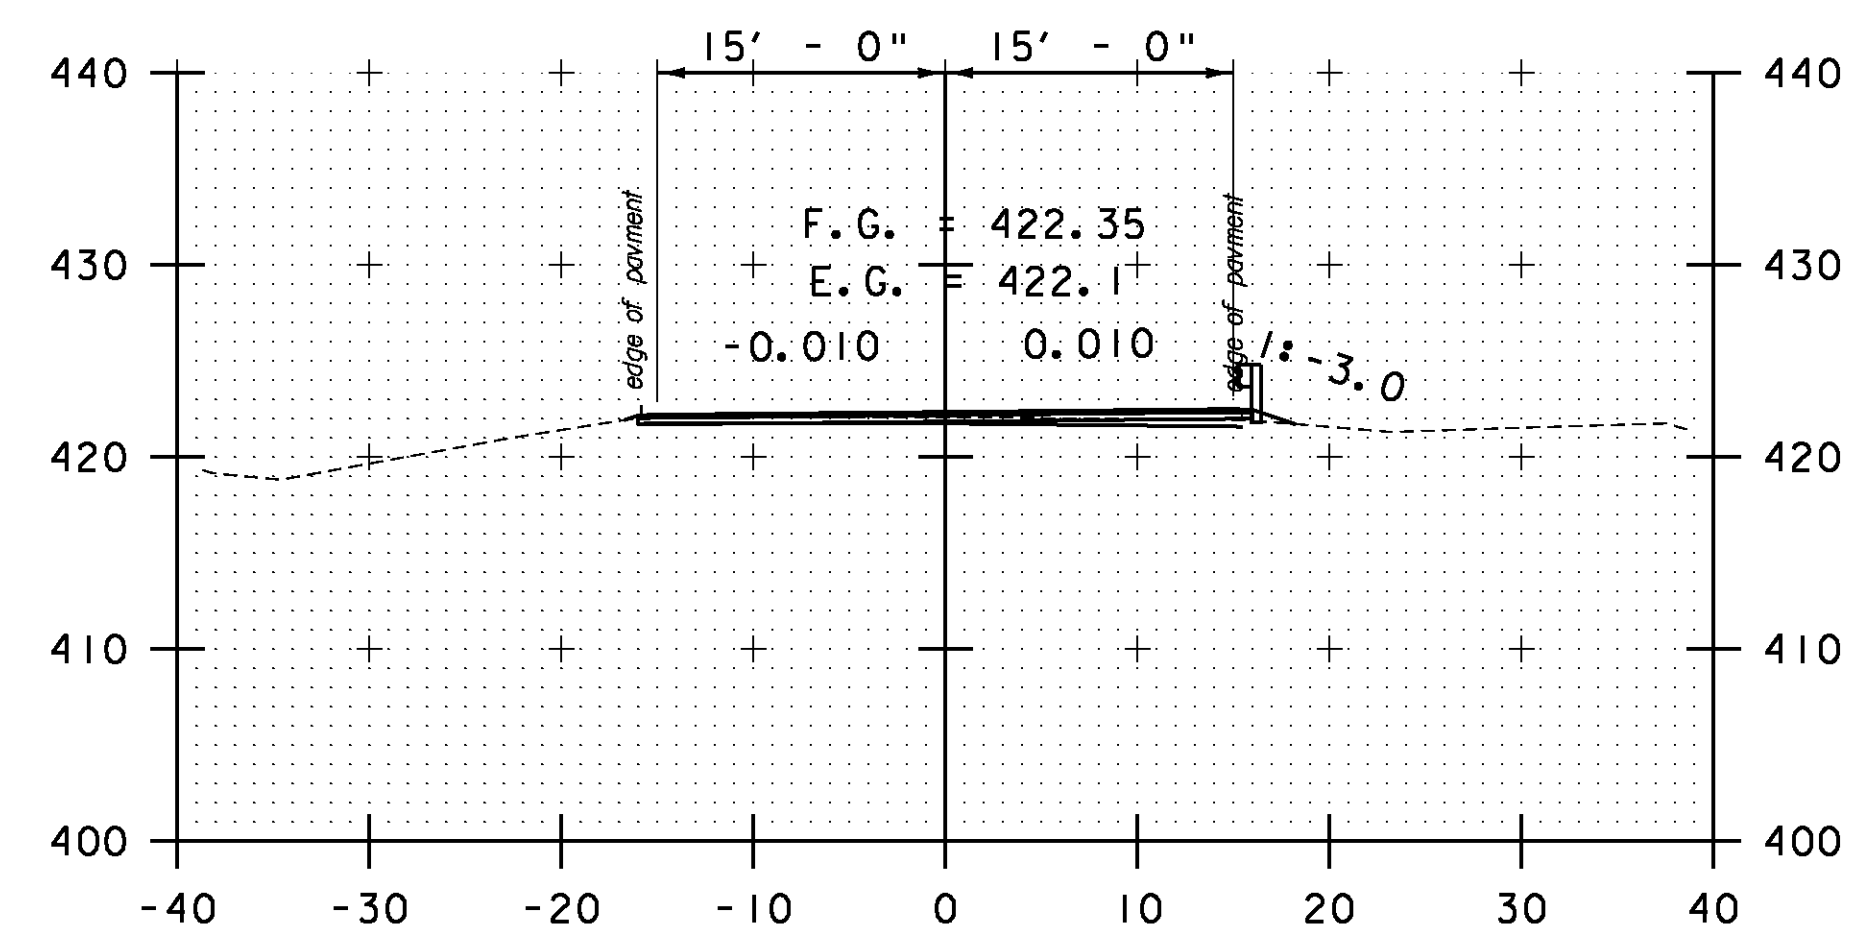


A 181+50

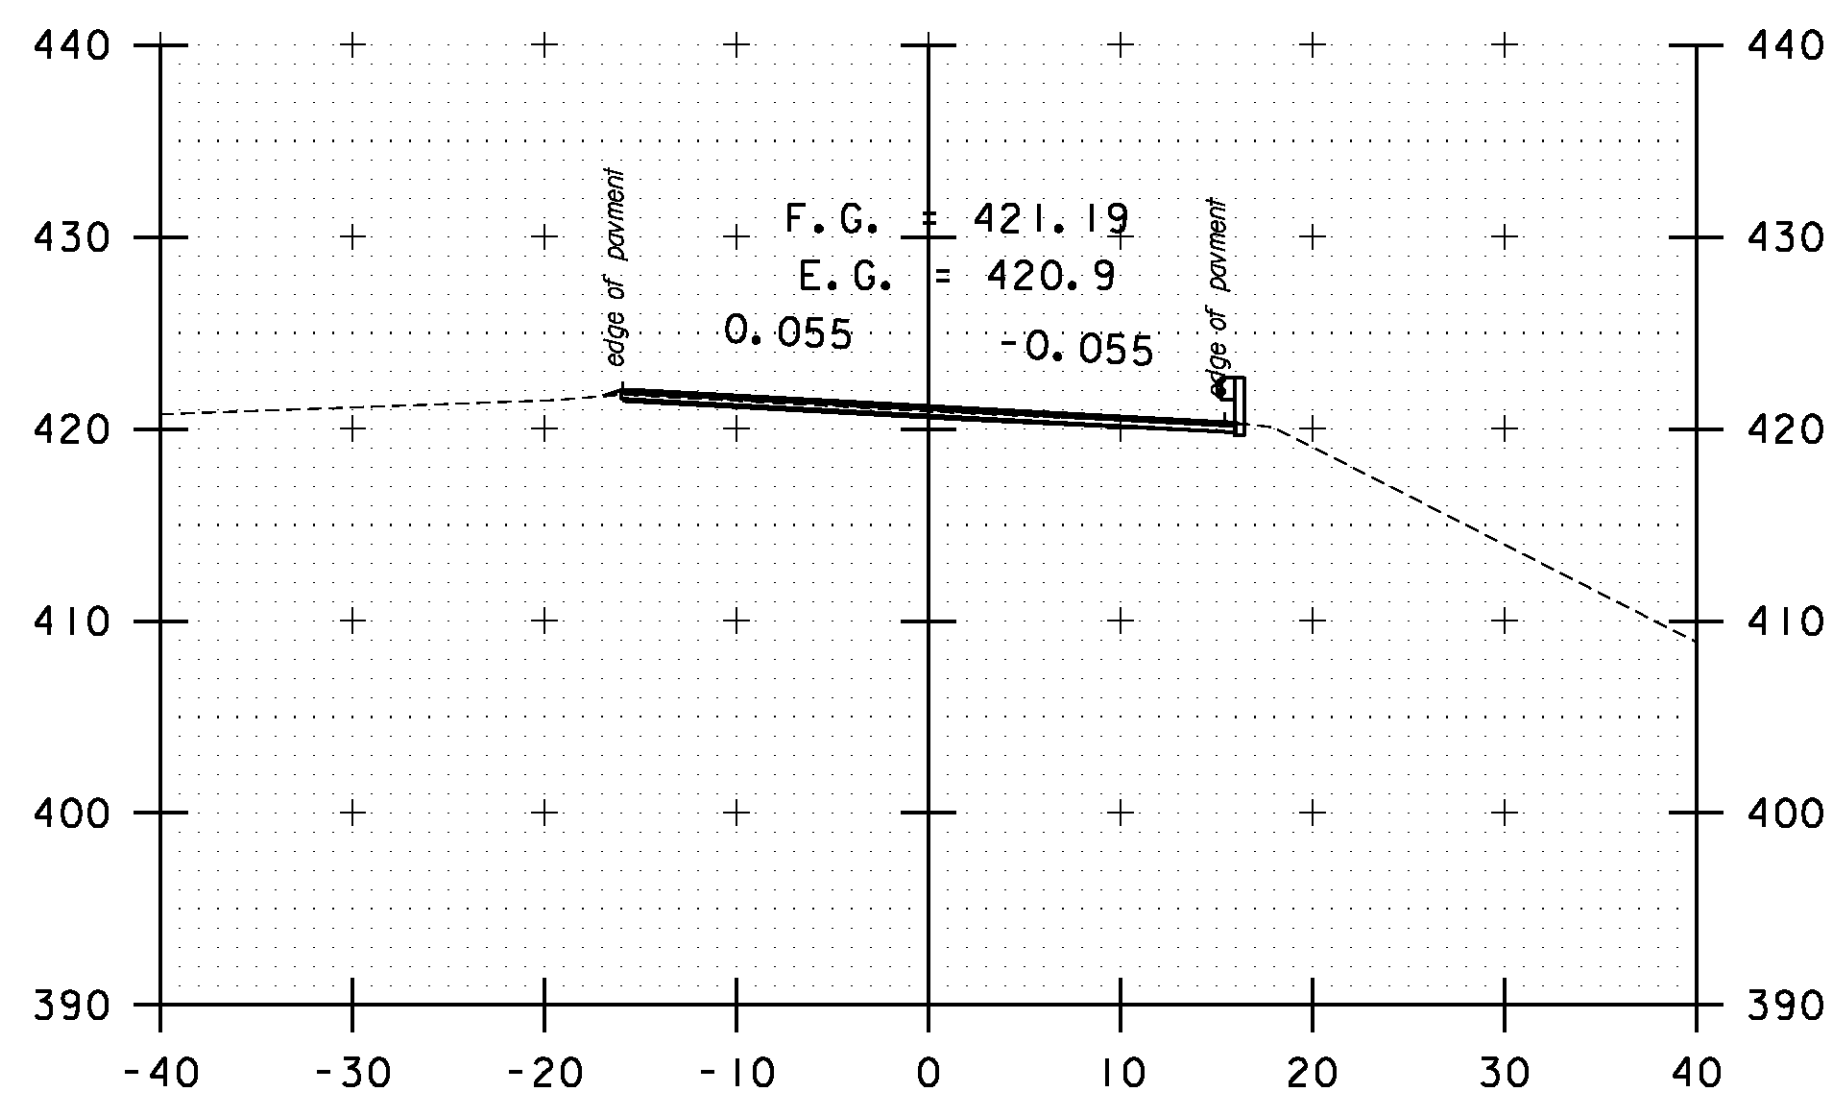


A 183+50

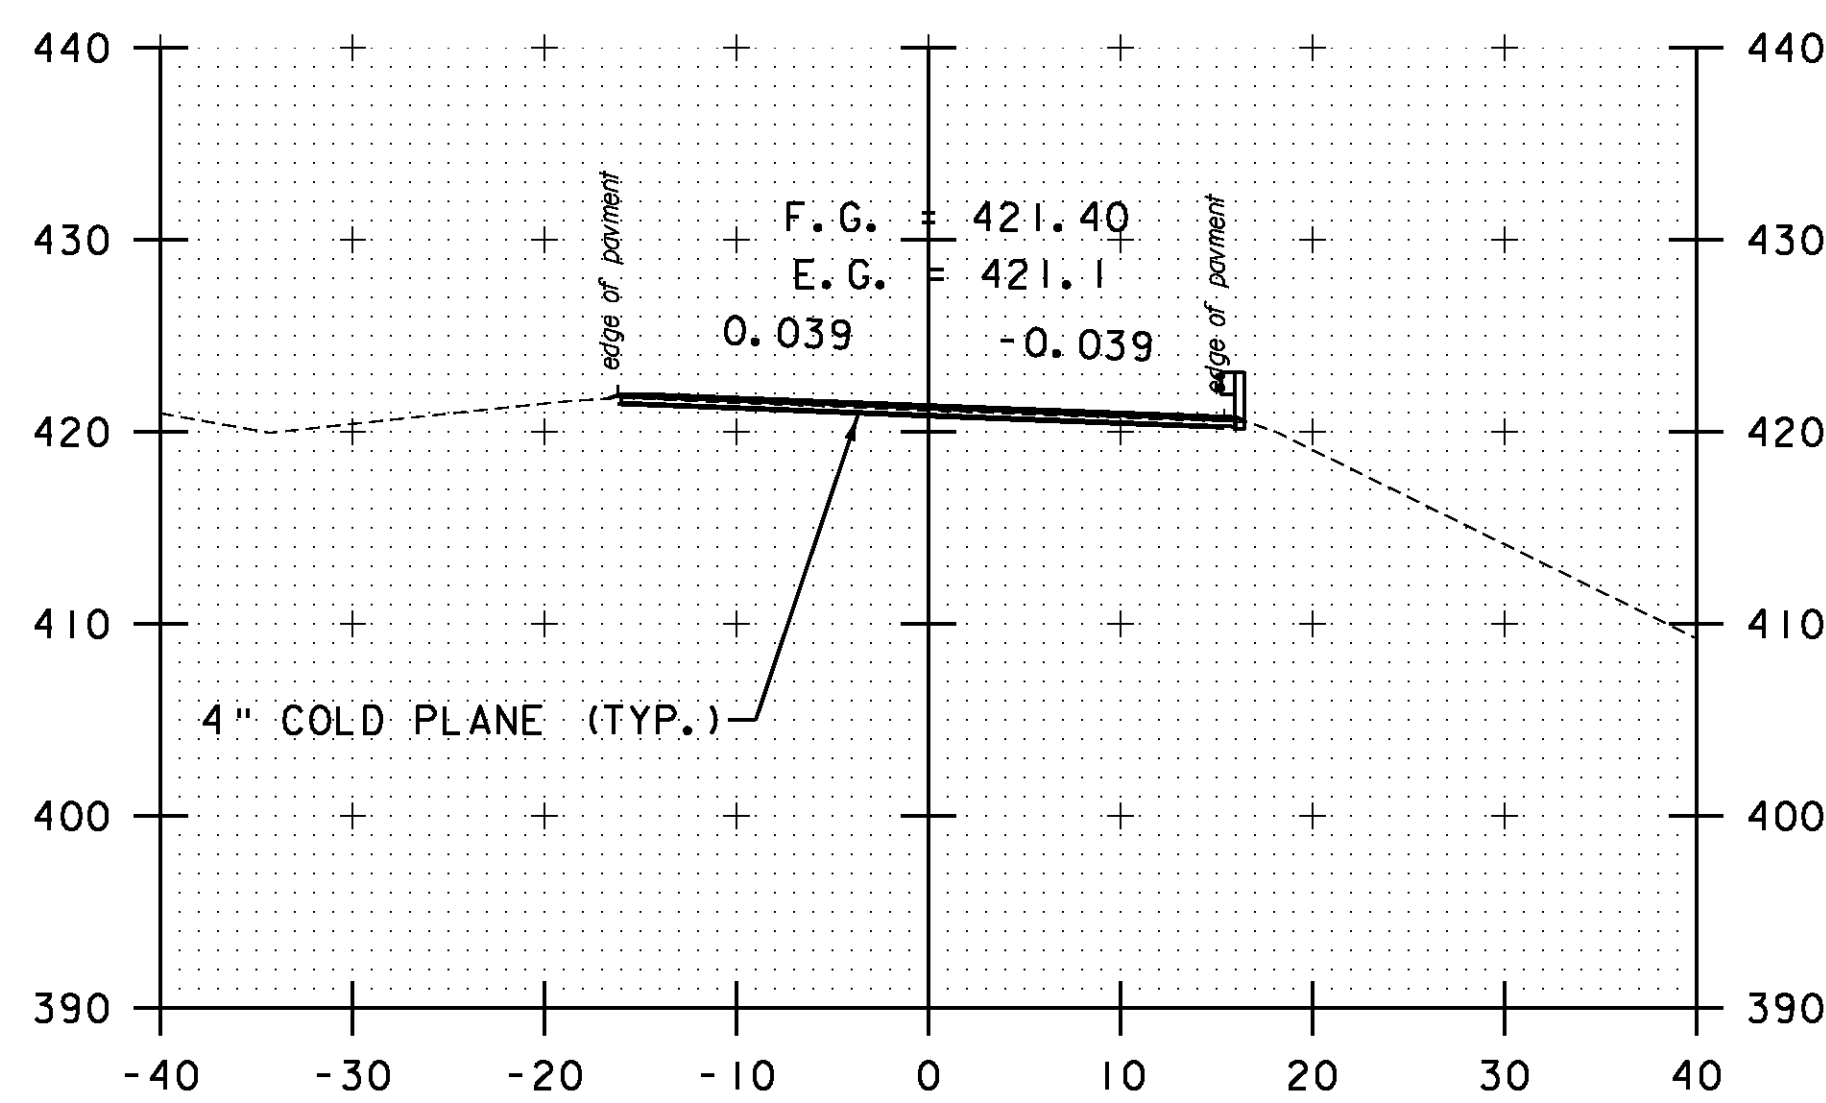

A 183+00

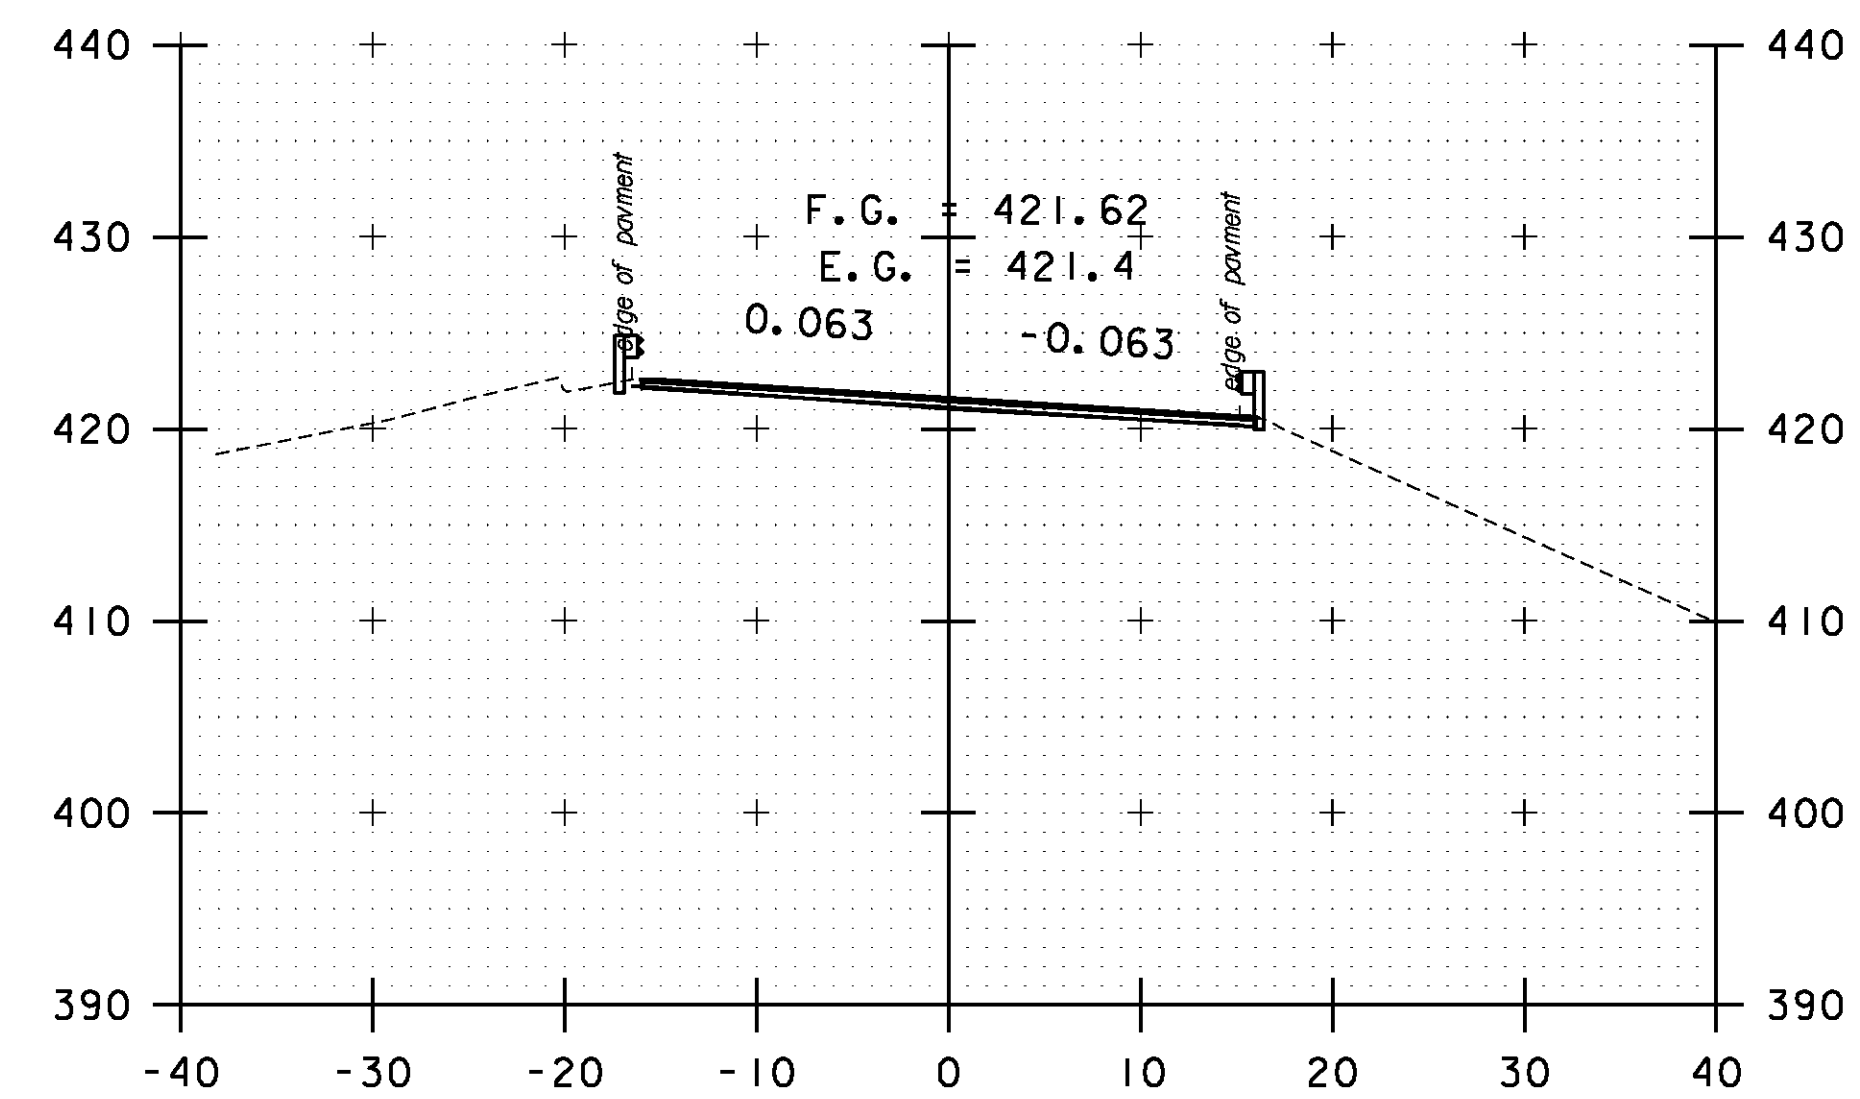

A 184+50

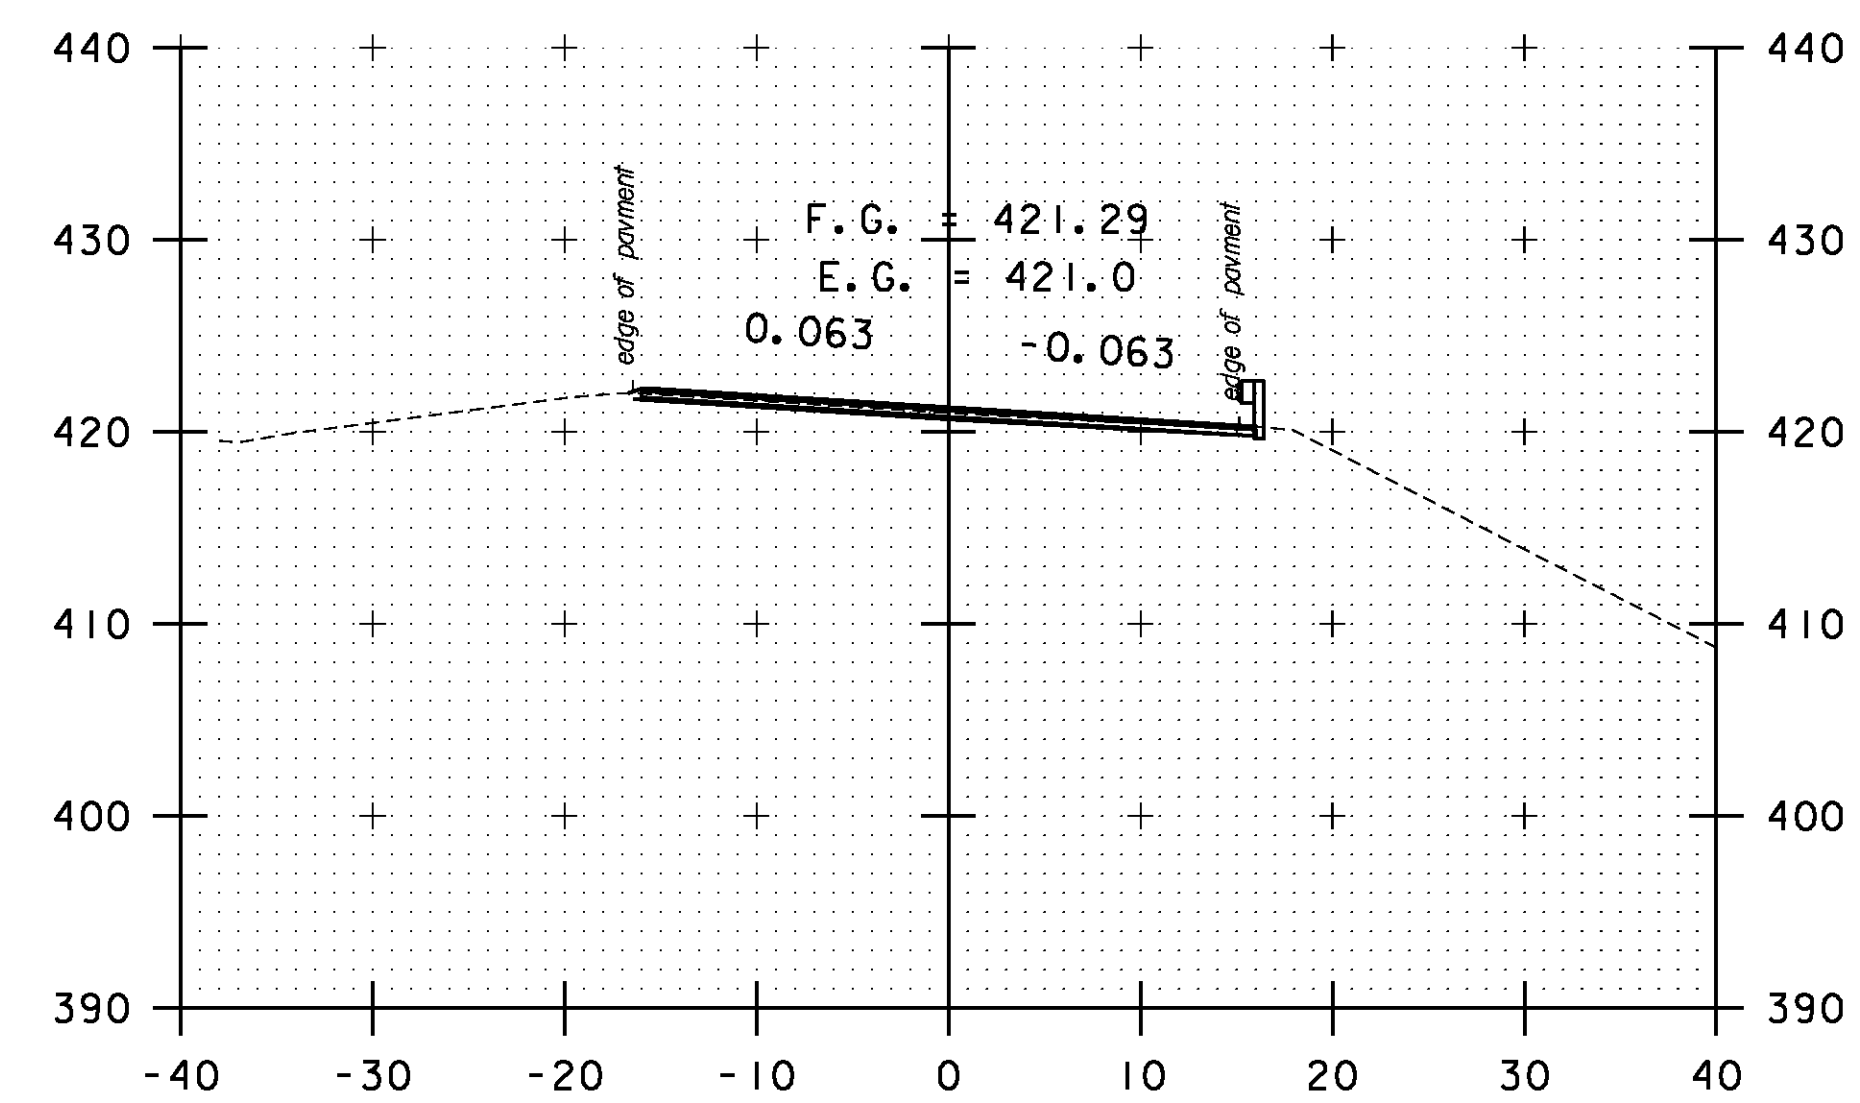

A 184+00

STA. A 181+50 TO STA. A 184+50

SCALE 1" = 10'-0"

CROSS SECTION SHEET 88

PROJECT NAME: BOLTON-WATERBURY

PROJECT NUMBER: STP 2709(I)

FILE NAME: p07C172.dgn

PROJECT LEADER: CDL

DESIGNED BY: BMB

PLOT FILE: p07C172_214.1

PLOT DATE: 4/16/2013

DRAWN BY: BMB

CHECKED BY: CDL

SHEET 214 OF 217