




A 186+00

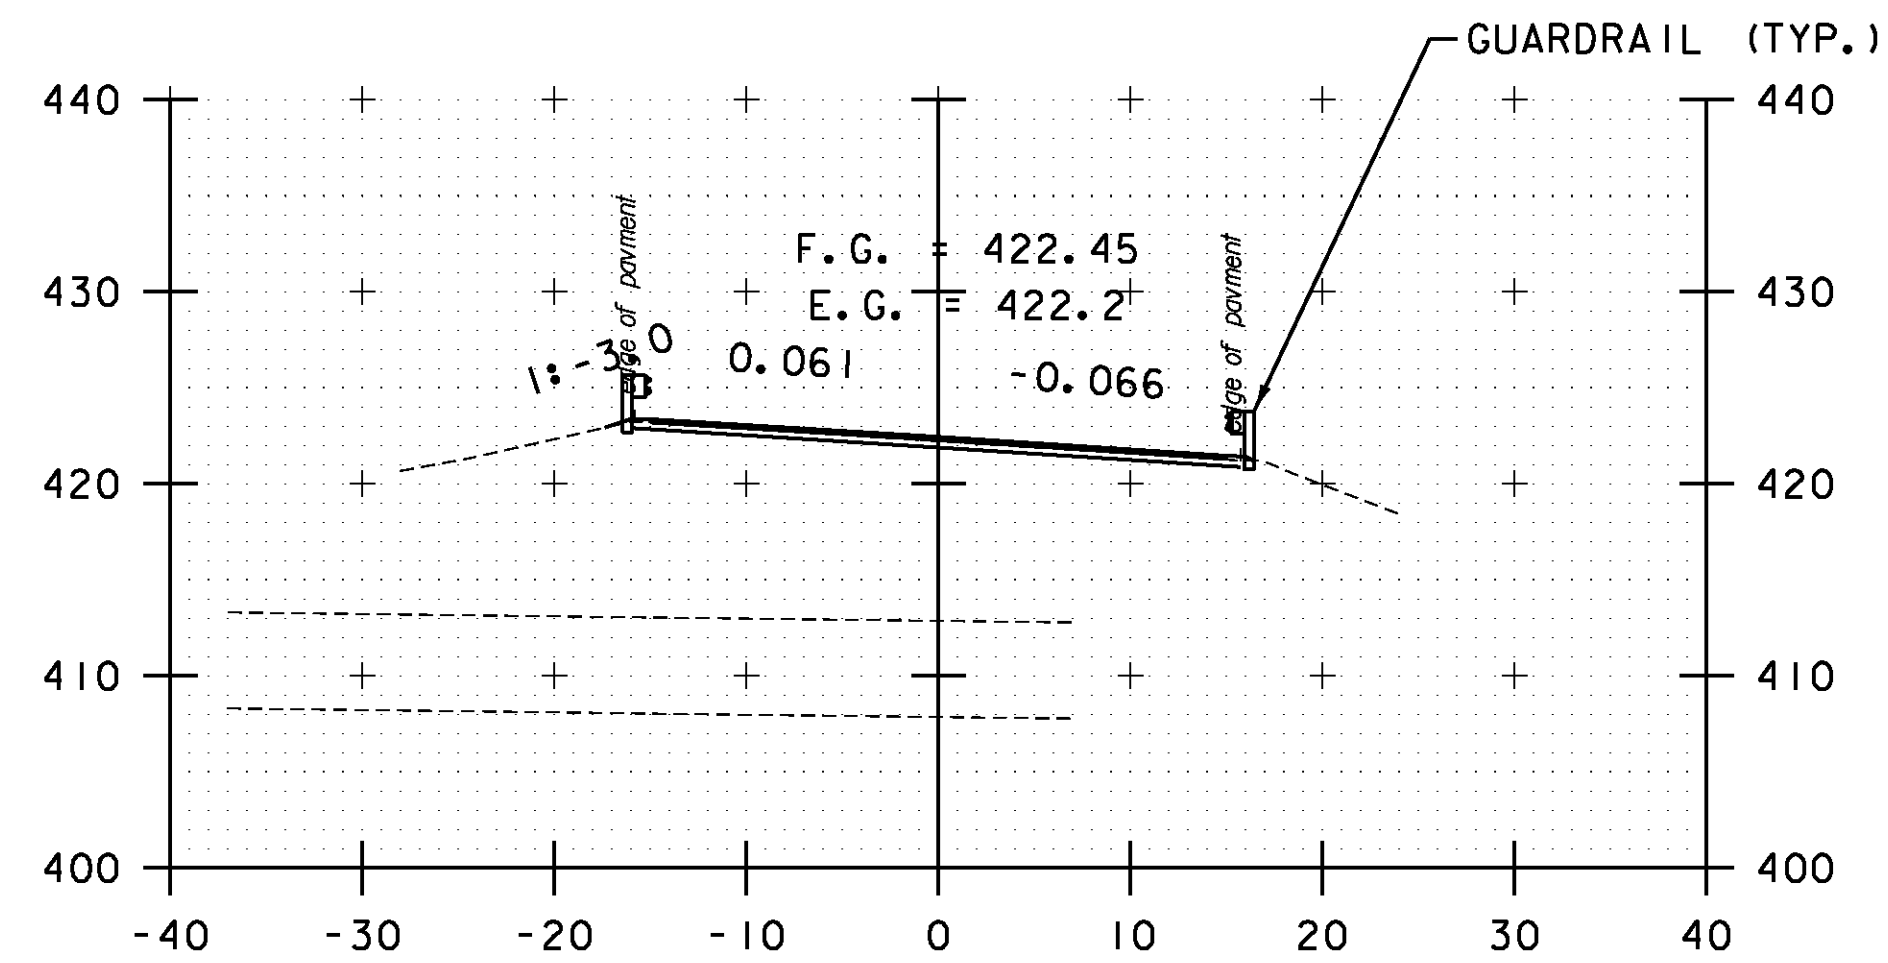


A 185+50

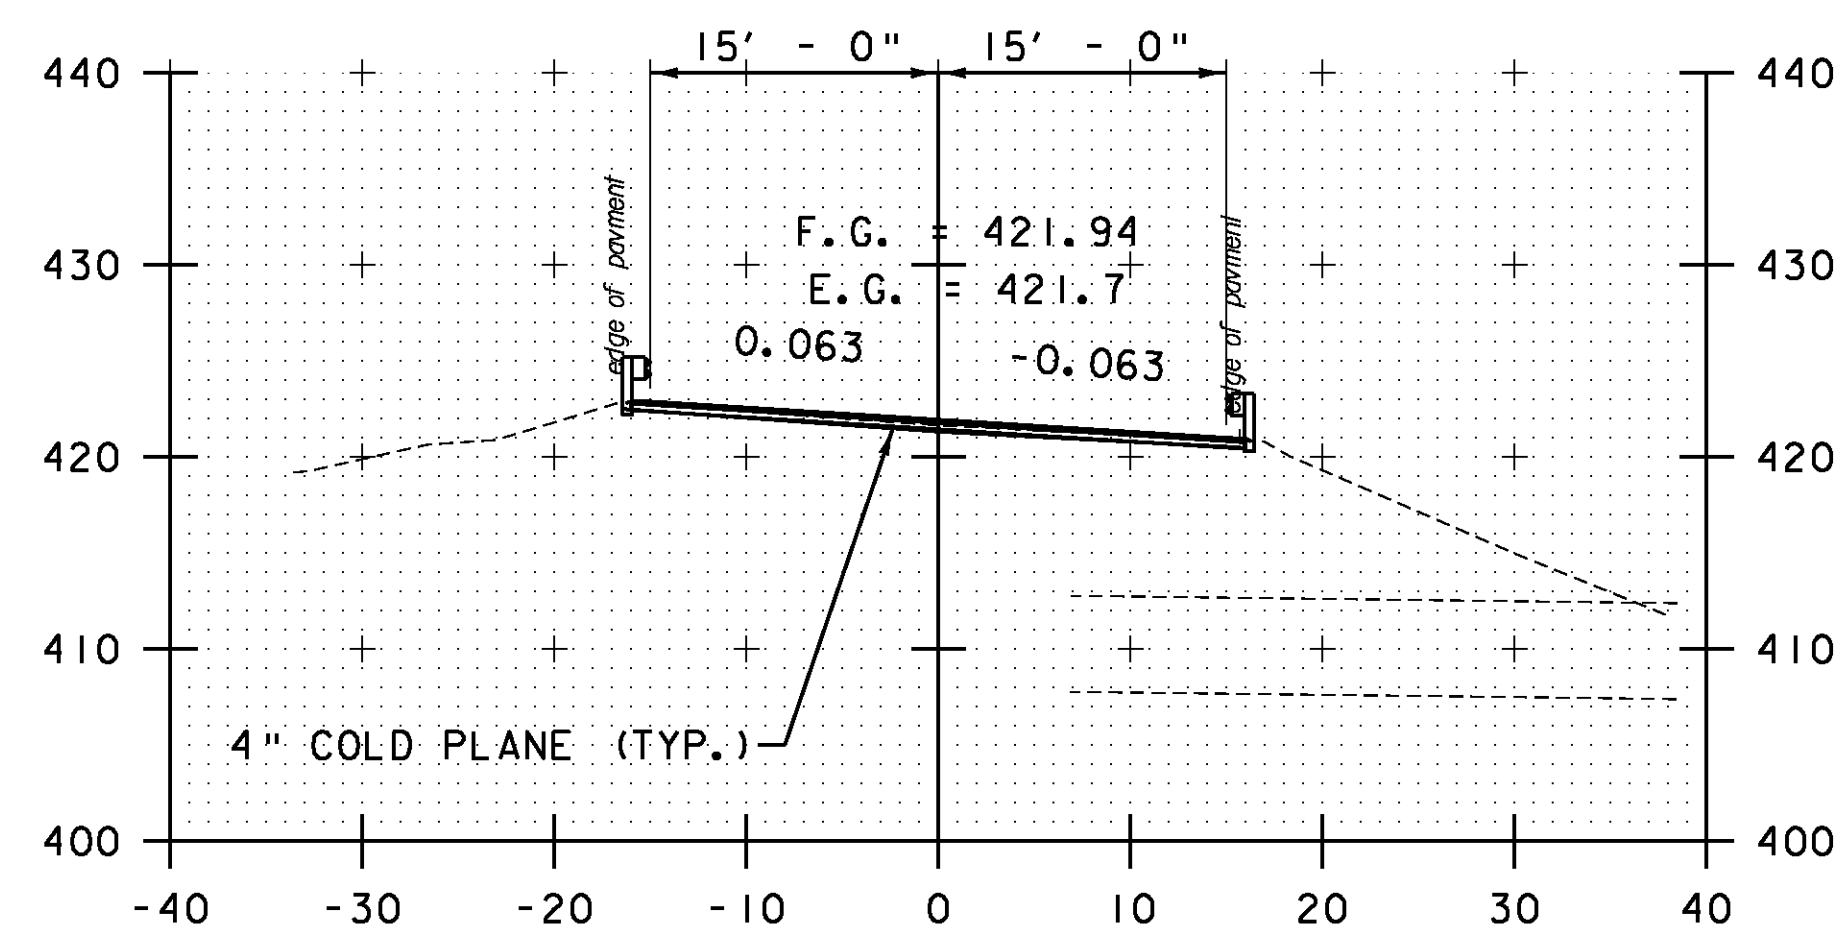

A 185+00

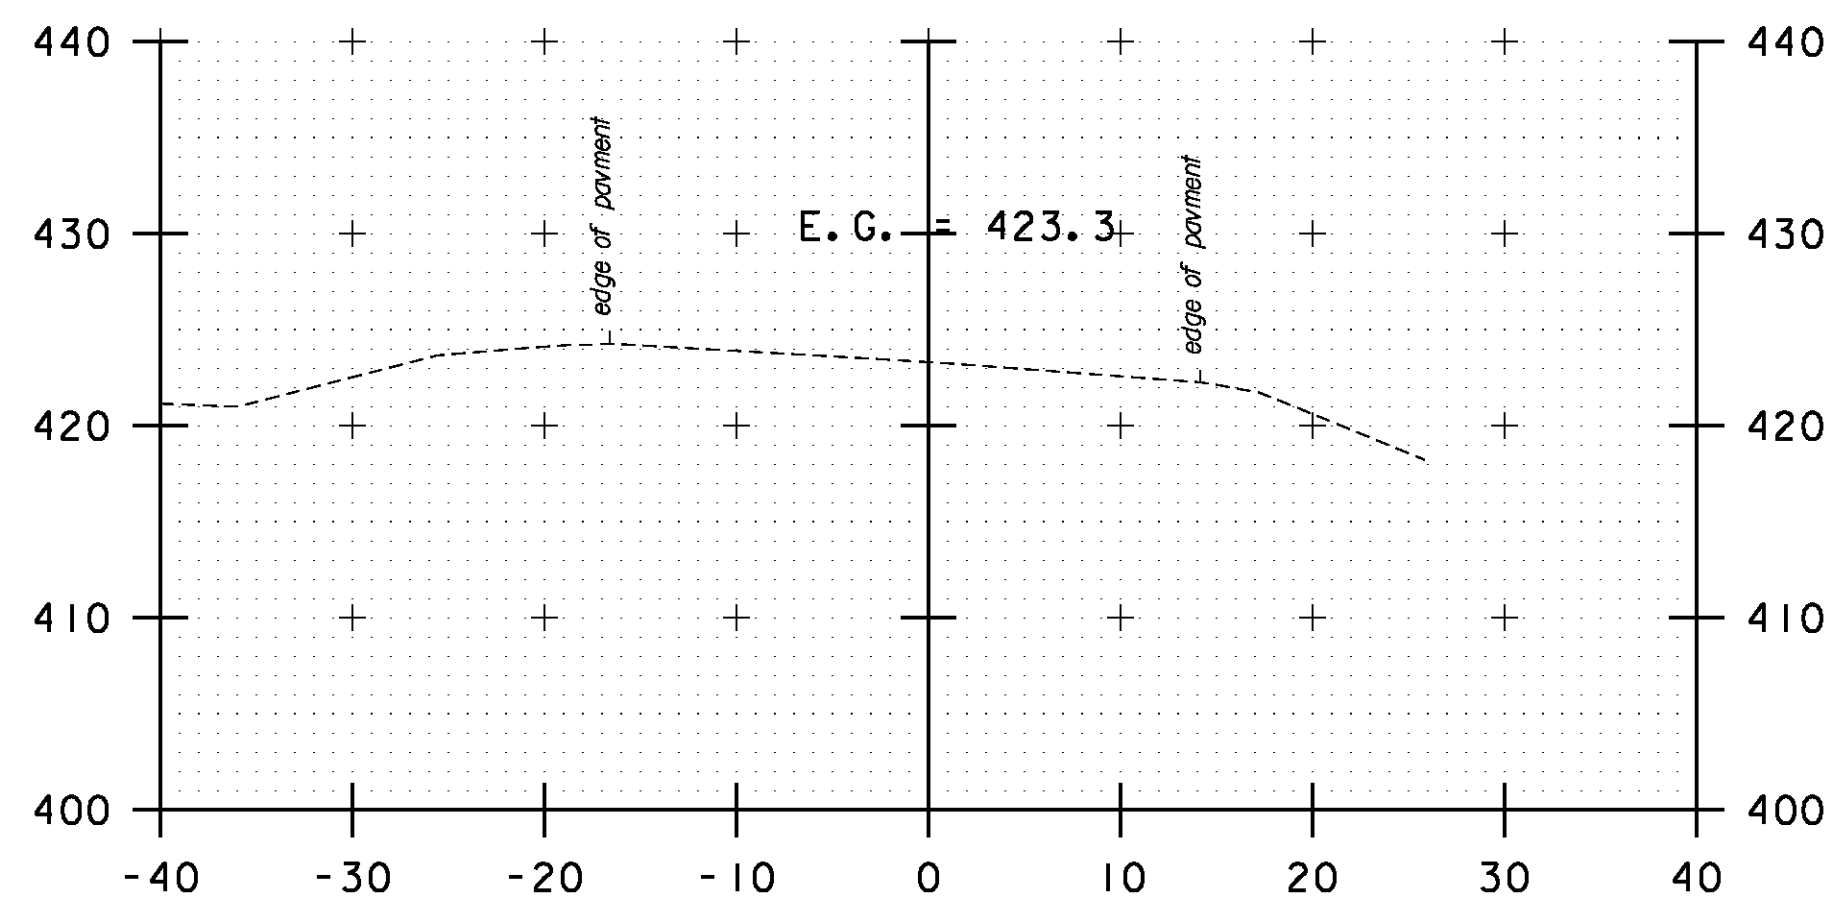

A 186+50

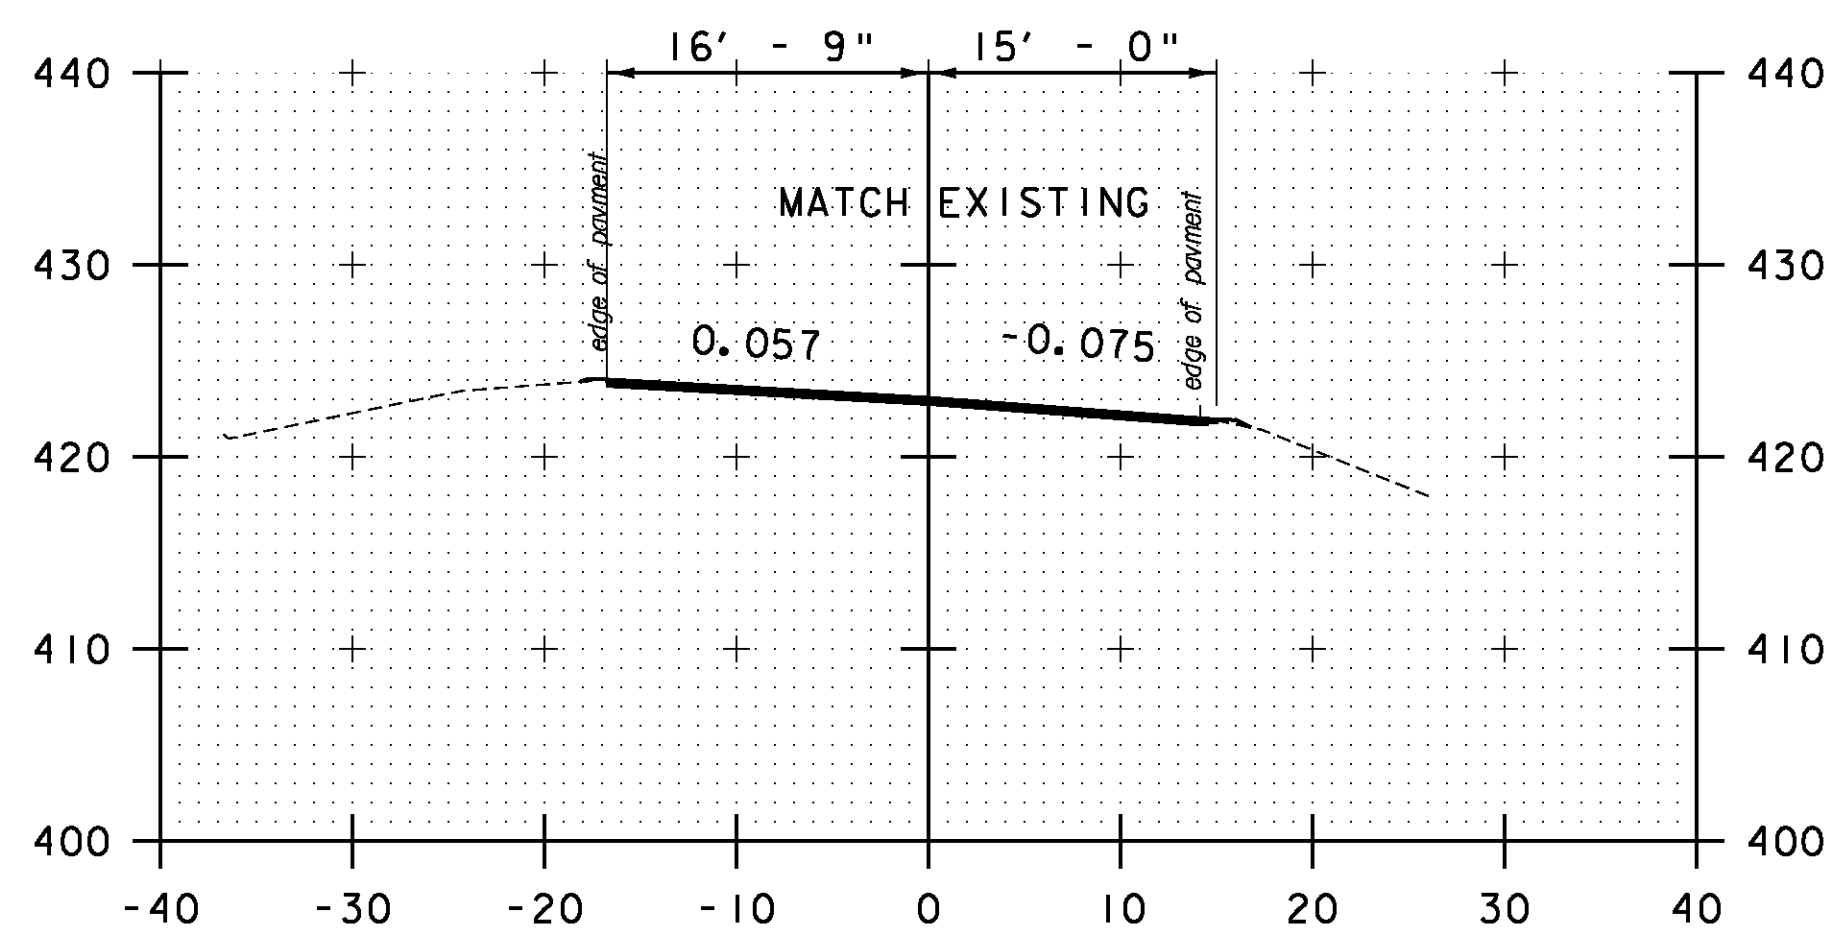

END PROJECT - MATCH EXISTING
A 186+25

STA. A 185+00 TO STA. A 186+50

SCALE 1" = 10'-0"
10 0 10

CROSS SECTION SHEET 89

PROJECT NAME: BOLTON-WATERBURY

PROJECT NUMBER: STP 2709(I)

FILE NAME: p07C172.dgn

PROJECT LEADER: CDL

DESIGNED BY: BMB

PLOT FILE: p07C172_215.i

PLOT DATE: 4/17/2013

DRAWN BY: BMB

CHECKED BY: CDL

SHEET 215 OF 217