


BRIDGE #1 DETAIL
THETFORD MM 0.082

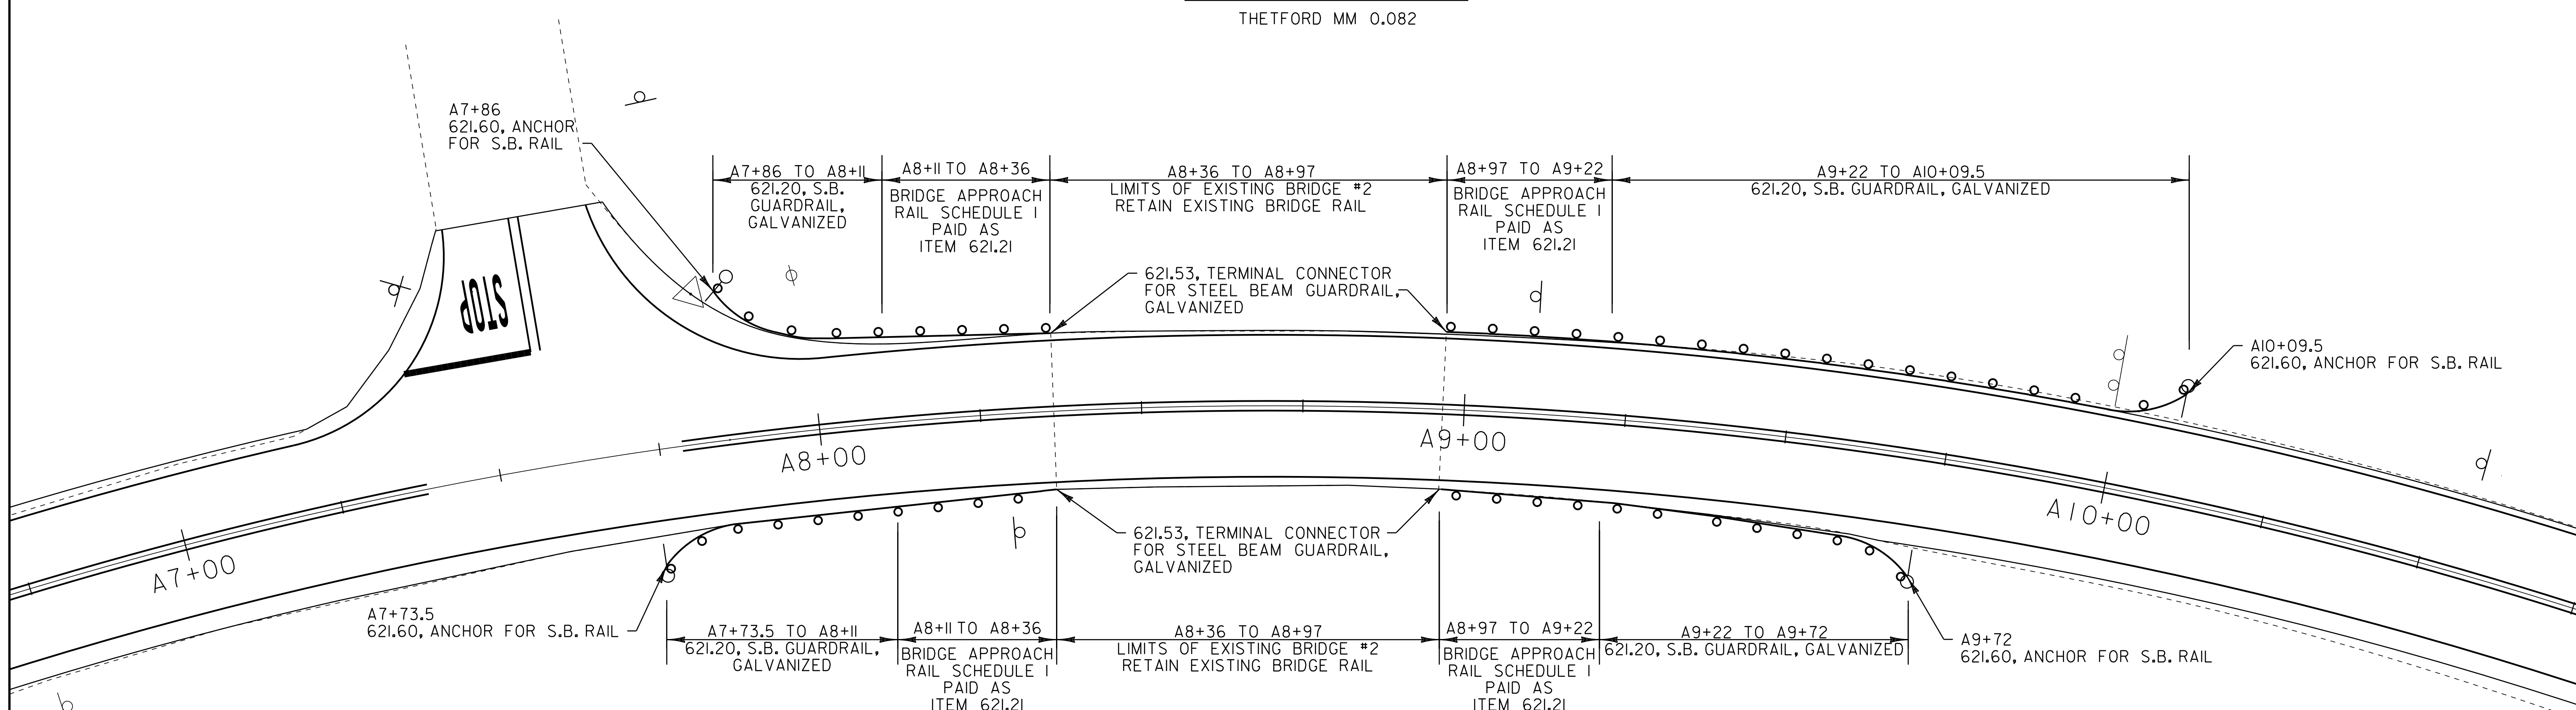

BRIDGE #2 DETAIL
WEST FAIRLEE MM 0.164

BRIDGE DETAIL SHEET 2

PROJECT NAME: THETFORD-FAIRLEE	
PROJECT NUMBER: STP 2710(I)	
FILE NAME: /pave/07c184/pci84	PLOT DATE: 14-OCT-2013 16:34
PROJECT LEADER: PTS	DRAWN BY: WWG
DESIGNED BY: NLL	CHECKED BY: PTS
IPARM FILE NAME: 07C184_10	SHEET 9 OF 77

NOT TO SCALE