

646.602 TEMPORARY 4" WHITE LINE, PAINT
 646.402 DURABLE 4" WHITE LINE, THERMOPLASTIC
 646.403 DURABLE 4" WHITE LINE, EPOXY PAINT
 646.404 DURABLE 4" WHITE LINE, POLYUREA
 59+00 TO 64+00 SOLID LT
 59+00 TO 64+00 SOLID RT

201.31 THINNING AND TRIMMING FOR SIGNS
 61+41 RT


203.40 SHOULDER BERM REMOVAL
 59+00 TO 61+42 RT

621.81 REMOVAL AND DISPOSAL OF GUIDE POSTS
 61+60 TO 64+00 RT
 621.30 BOX BEAM GUARDRAIL
 61+45 TO 61+69 RT
 61+75 TO 64+00 RT

675.50 REMOVING SIGNS
 AS SHOWN - 4

ENVIRONMENTALLY SENSITIVE LOCATION
 59+00 TO 64+00 RT (LAKE FAIRLEE)

646.612 TEMPORARY 4" YELLOW LINE, PAINT
 646.412 DURABLE 4" YELLOW LINE, THERMOPLASTIC
 646.413 DURABLE 4" YELLOW LINE, EPOXY PAINT
 646.414 DURABLE 4" YELLOW LINE, POLYUREA
 59+00 TO 64+00 SOLID LT & RT

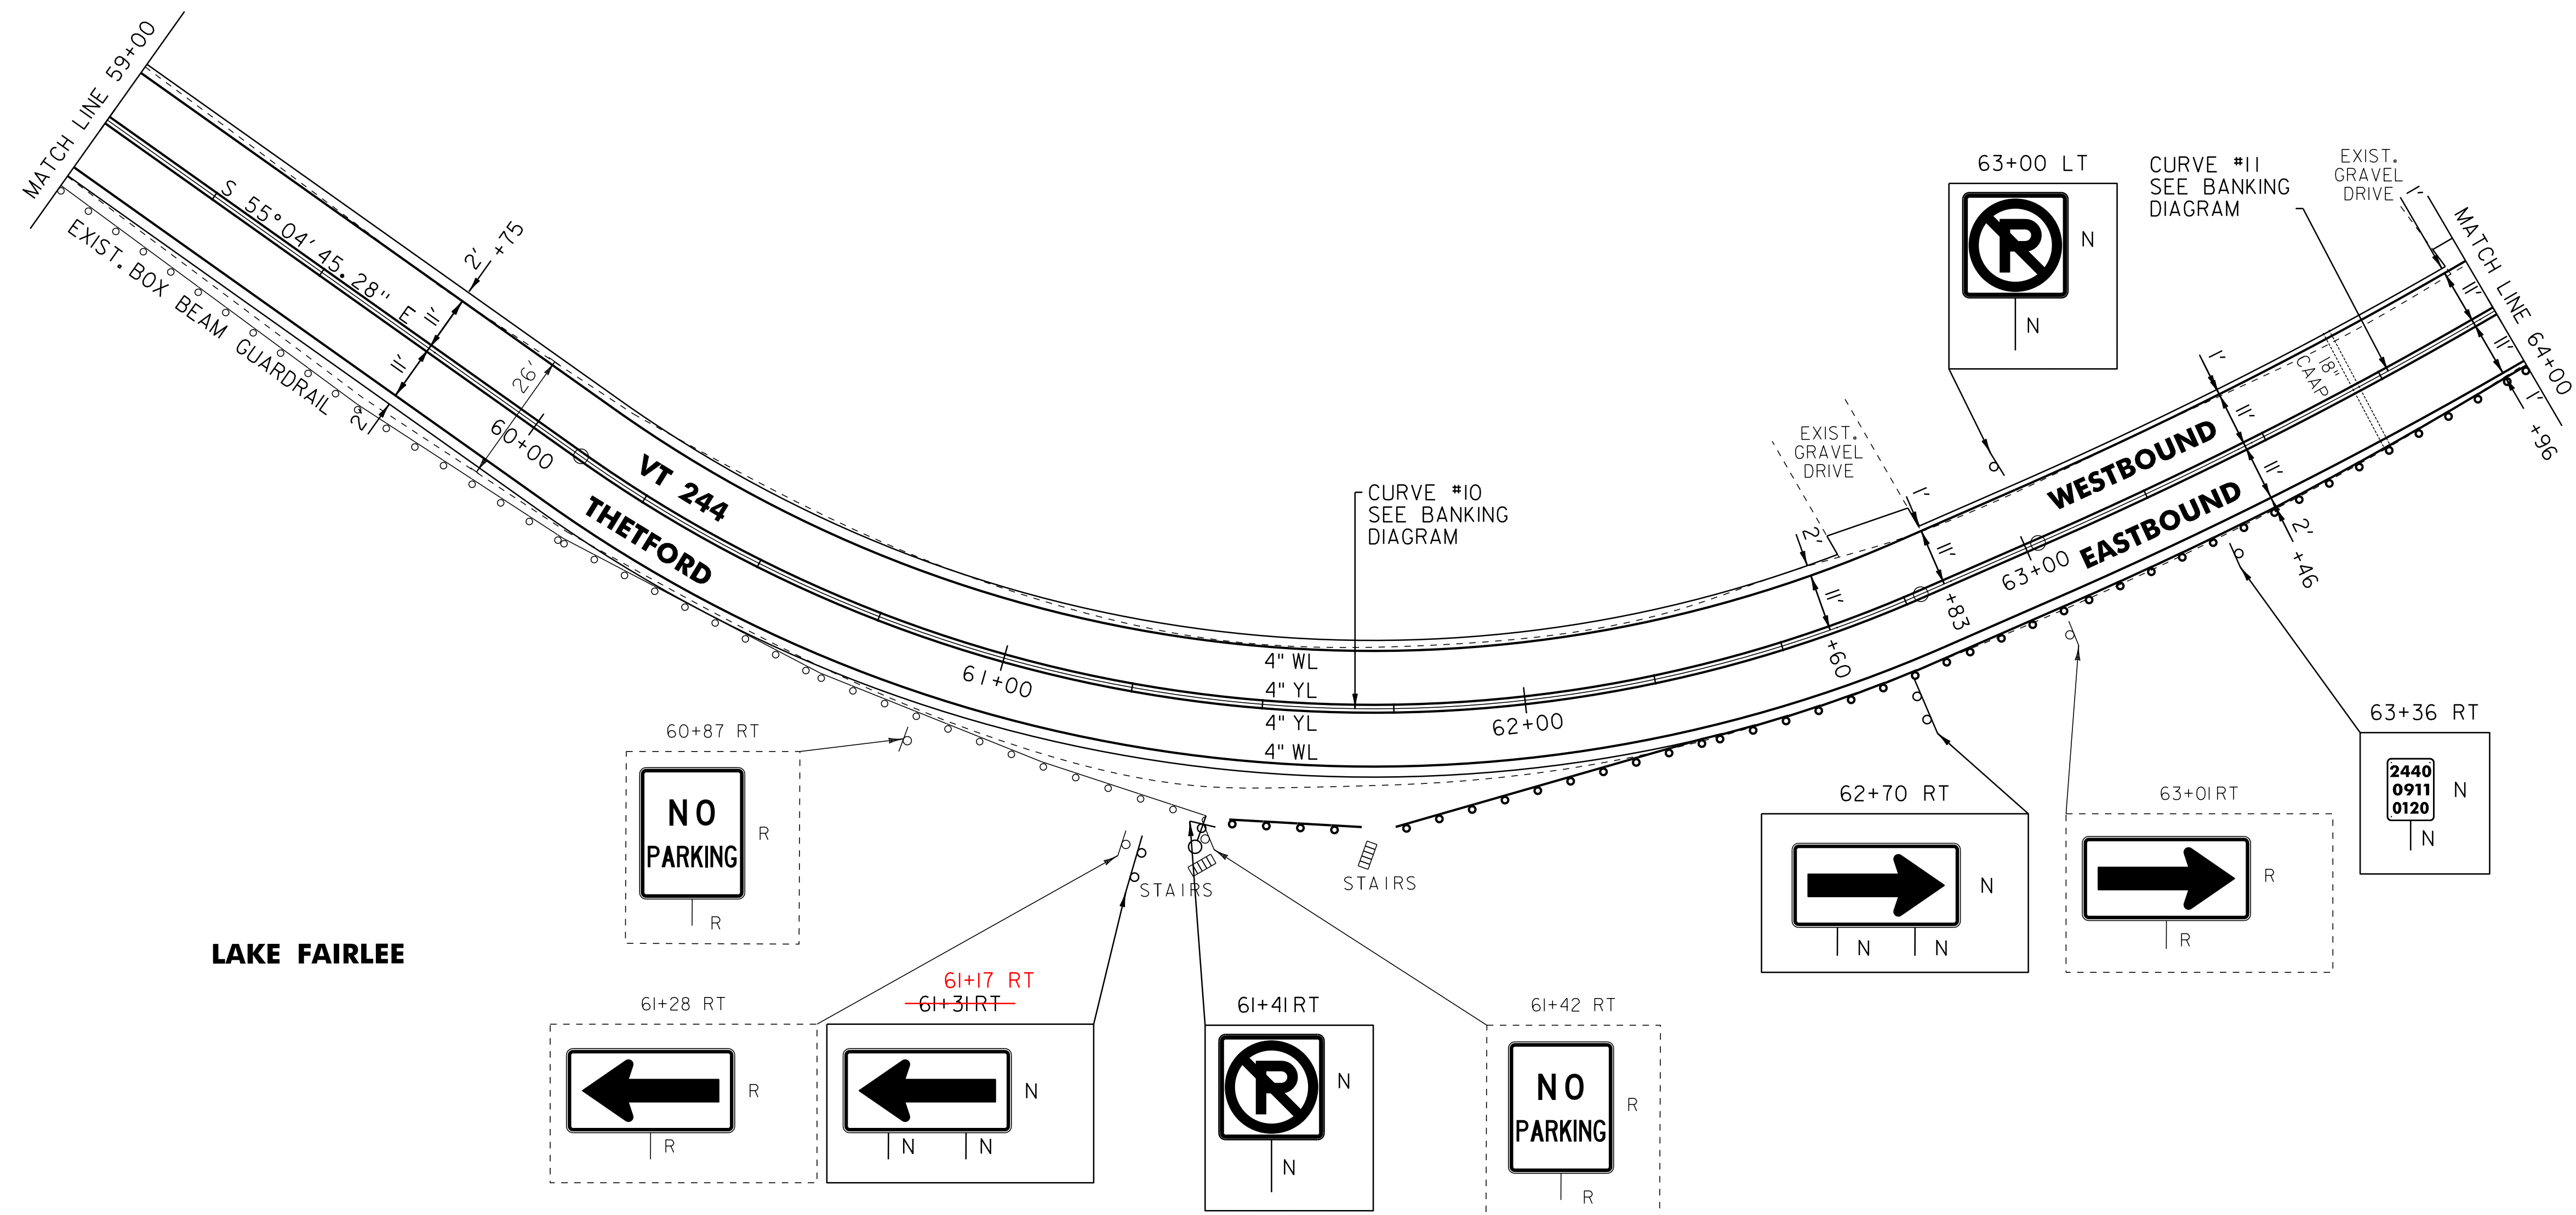

LAKE FAIRLEE

NOT TO SCALE

LEGEND

- R = REMOVE EXISTING
- S = SALVAGE
- R&S = REMOVE AND SALVAGE
- N = NEW
- RET = RETAIN
- B-B = BACK TO BACK
- = EXISTING GUARDRAIL
- = PROPOSED GUARDRAIL
- YL = YELLOW LINE
- WL = WHITE LINE
- = DELINEATOR
- ⊙ = PAVEMENT CORE

ROADWAY LAYOUT 7

PROJECT NAME: THETFORD-FAIRLEE

PROJECT NUMBER: STP 2710(I)

FILE NAME: /pave/07cl84/pcl84
 PROJECT LEADER: PTS
 DESIGNED BY: NLL
 IPARM FILE NAME: 07C184_26

PLOT DATE: 14-OCT-2013 16:35
 DRAWN BY: SNG
 CHECKED BY: DAM/PTS
 SHEET 25 OF 77