


646.602 TEMPORARY 4" WHITE LINE, PAINT  
 646.402 DURABLE 4" WHITE LINE, THERMOPLASTIC  
 646.403 DURABLE 4" WHITE LINE, EPOXY PAINT  
 646.404 DURABLE 4" WHITE LINE, POLYUREA  
 A21+00 TO A26+00 SOLID LT  
 A21+00 TO A26+00 SOLID RT  
 646.612 TEMPORARY 4" YELLOW LINE, PAINT  
 646.412 DURABLE 4" YELLOW LINE, THERMOPLASTIC  
 646.413 DURABLE 4" YELLOW LINE, EPOXY PAINT  
 646.414 DURABLE 4" YELLOW LINE, POLYUREA  
 A21+00 TO A26+00 SOLID LT & RT

621.20 STEEL BEAM GUARDRAIL, GALVANIZED  
 A21+00 TO ~~A22+50 RT~~ A22+29 RT  
 A22+80 TO A24+05 RT  
 621.60 ANCHOR FOR STEEL BEAM RAIL  
 A22+50 RT  
 A22+80 RT  
 A24+05 RT  
 621.80 REMOVAL AND DISPOSAL OF GUARDRAIL  
 A21+88 TO A22+51 RT  
 A22+80 TO A24+05 RT

900.620 SPECIAL PROVISION  
 (DELINEATOR WITH STEEL POST)  
 ( AT GUARDRAIL TERMINAL)  
 A21+82 RT  
 A22+80 RT  
 A24+05 RT

675.60 ERECTING SALVAGED SIGNS  
 AS SHOWN - 1

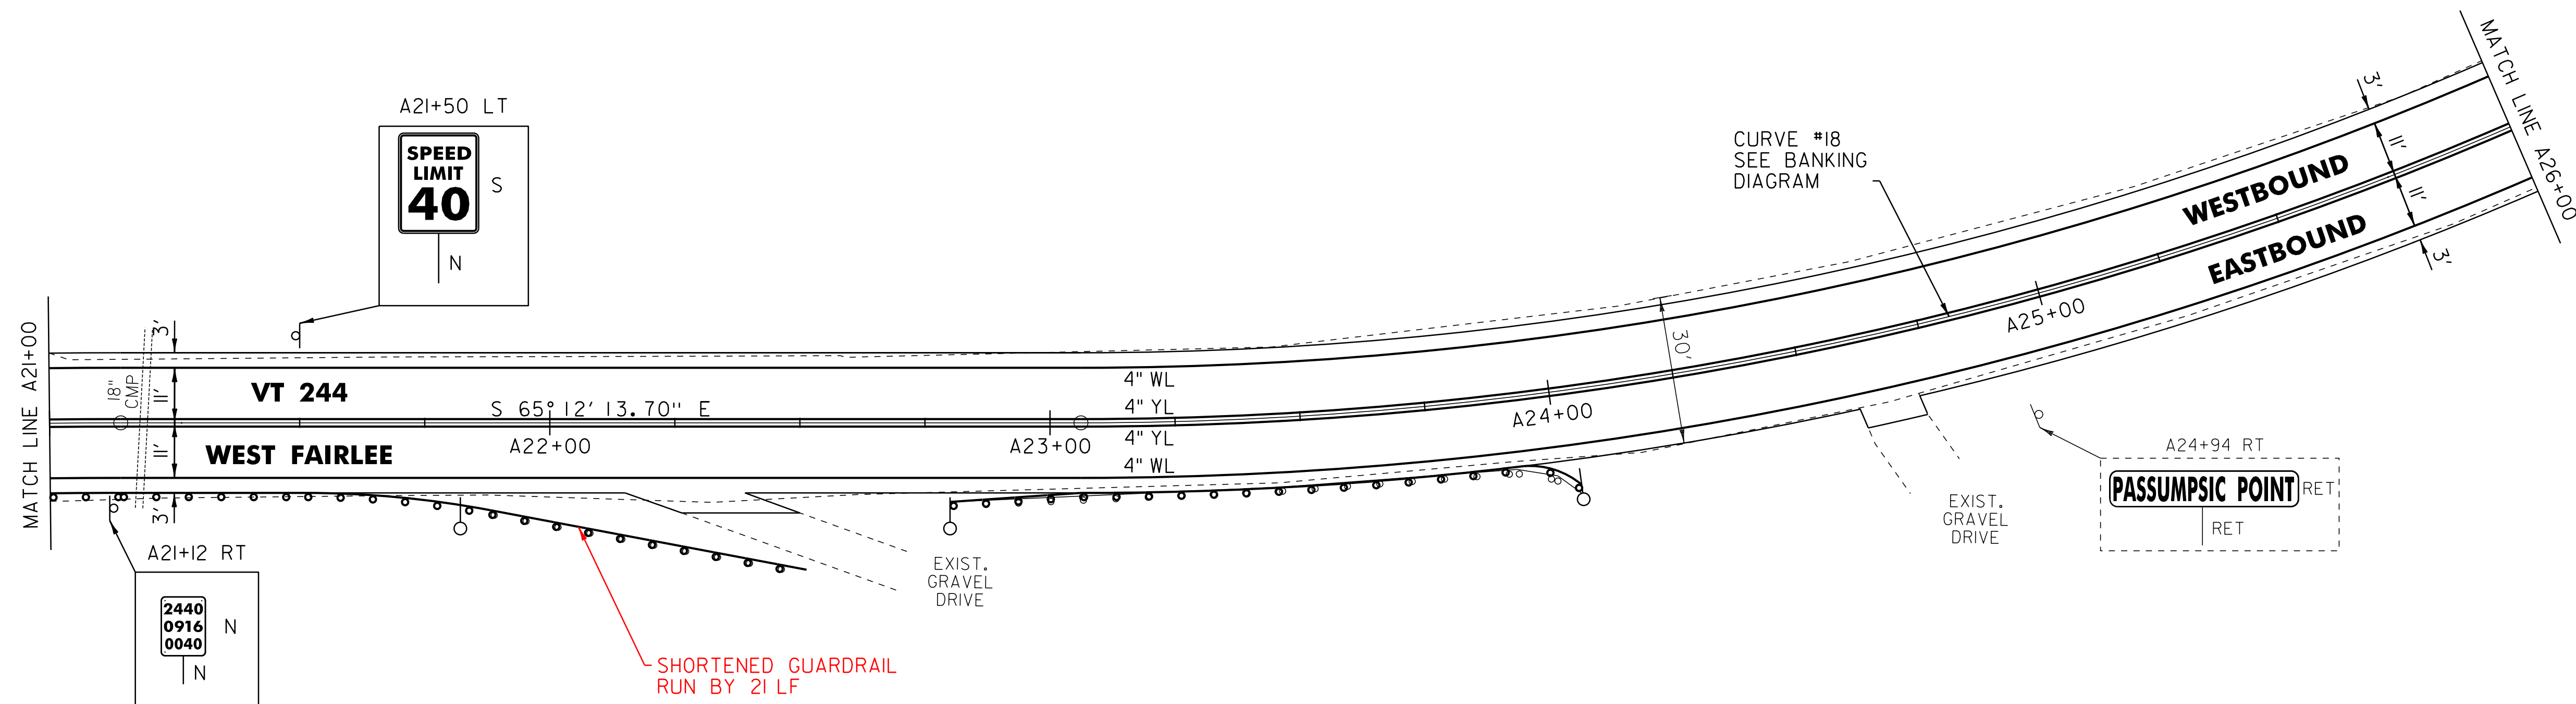

NOT TO SCALE

LEGEND

- R = REMOVE EXISTING
- S = SALVAGE
- R&S = REMOVE AND SALVAGE
- N = NEW
- RET = RETAIN
- B-B = BACK TO BACK
- = EXISTING GUARDRAIL
- = PROPOSED GUARDRAIL
- YL = YELLOW LINE
- WL = WHITE LINE
- = DELINEATOR
- ⊙ = PAVEMENT CORE

ROADWAY LAYOUT 12

PROJECT NAME: THETFORD-FAIRLEE

PROJECT NUMBER: STP 2710(I)

FILE NAME: /pave/07cl84/pcl84

PROJECT LEADER: PTS

DESIGNED BY: NLL

IPARM FILE NAME: 07C184\_31

PLOT DATE: 14-OCT-2013 16:35

DRAWN BY: SNG

CHECKED BY: DAM/PTS

SHEET 30 OF 77