


646.602 TEMPORARY 4" WHITE LINE, PAINT  
 646.402 DURABLE 4" WHITE LINE, THERMOPLASTIC  
 646.403 DURABLE 4" WHITE LINE, EPOXY PAINT  
 646.404 DURABLE 4" WHITE LINE, POLYUREA  
 A26+00 TO A31+00 SOLID LT  
 A26+00 TO A31+00 SOLID RT  
 646.612 TEMPORARY 4" YELLOW LINE, PAINT  
 646.412 DURABLE 4" YELLOW LINE, THERMOPLASTIC  
 646.413 DURABLE 4" YELLOW LINE, EPOXY PAINT  
 646.414 DURABLE 4" YELLOW LINE, POLYUREA  
 A26+00 TO A31+00 SOLID LT & RT

A27+07 RT  
~~A26+95 RT~~ TO A30+20 RT  
 A30+24 TO A31+00 RT  
 621.60 ANCHOR FOR STEEL BEAM RAIL  
~~A26+95 RT~~ A27+07 RT  
 A30+20 RT  
 A30+24 RT  
 621.80 REMOVAL AND DISPOSAL OF GUARDRAIL  
 A27+01 TO A30+20 RT  
 A30+24 TO A31+00 RT

900.620 SPECIAL PROVISION  
 (DELINEATOR WITH STEEL POST)  
 ( AT GUARDRAIL TERMINAL )  
 A26+95 RT

675.50 REMOVING SIGNS  
 AS SHOWN - 2

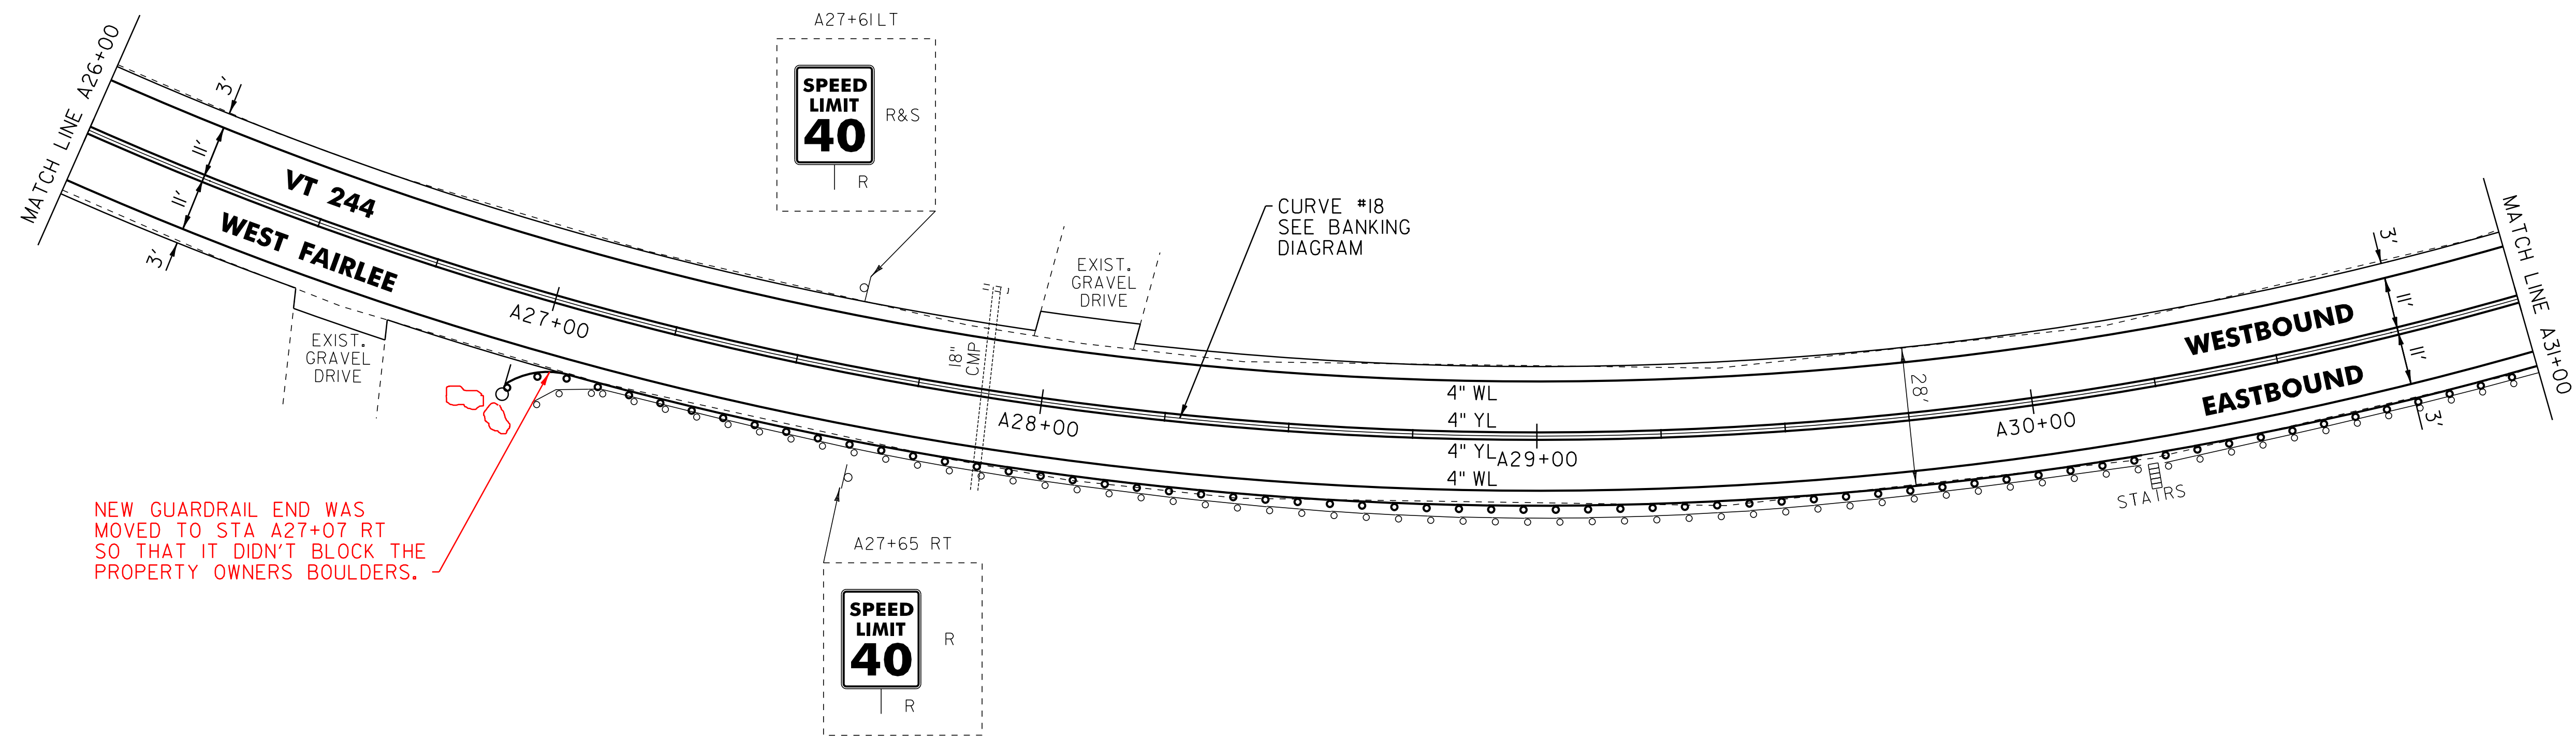

NEW GUARDRAIL END WAS  
 MOVED TO STA A27+07 RT  
 SO THAT IT DIDN'T BLOCK THE  
 PROPERTY OWNERS BOULDERS.

LEGEND

- R = REMOVE EXISTING
- S = SALVAGE
- R&S = REMOVE AND SALVAGE
- N = NEW
- RET = RETAIN
- B-B = BACK TO BACK
- = EXISTING GUARDRAIL
- = PROPOSED GUARDRAIL
- YL = YELLOW LINE
- WL = WHITE LINE
- = DELINEATOR
- ⊙ = PAVEMENT CORE

ROADWAY LAYOUT 13

PROJECT NAME: THETFORD-FAIRLEE

PROJECT NUMBER: STP 2710(I)

FILE NAME: /pave/07cl84/pcl84

PROJECT LEADER: PTS

DESIGNED BY: NULL

IPARM FILE NAME: 07C184\_32

PLOT DATE: 14-OCT-2013 16:35

DRAWN BY: SNG

CHECKED BY: DAM/PTS

SHEET 31 OF 77

NOT TO SCALE