

646.602 TEMPORARY 4" WHITE LINE, PAINT
 646.402 DURABLE 4" WHITE LINE, THERMOPLASTIC
 646.403 DURABLE 4" WHITE LINE, EPOXY PAINT
 646.404 DURABLE 4" WHITE LINE, POLYUREA
 A31+00 TO A41+00 SOLID LT
 A31+00 TO A41+00 SOLID RT

646.612 TEMPORARY 4" YELLOW LINE, PAINT
 646.412 DURABLE 4" YELLOW LINE, THERMOPLASTIC
 646.413 DURABLE 4" YELLOW LINE, EPOXY PAINT
 646.414 DURABLE 4" YELLOW LINE, POLYUREA
 A31+00 TO A41+00 SOLID LT & RT

621.20 STEEL BEAM GUARDRAIL, GALVANIZED
 A31+00 TO A35+49 RT
 A35+57 TO ~~A36+69.5 RT~~ A36+82 RT
 A40+22.5 TO A41+00 RT



621.60 ANCHOR FOR STEEL BEAM RAIL
 A35+49.0 RT
 A35+57.0 RT
 A36+69.5 RT
 A40+22.5 RT

621.80 REMOVAL AND DISPOSAL OF GUARDRAIL
 A31+00 TO A35+47 RT
 A35+57 TO A36+71 RT
 A40+26 TO A41+00 RT

900.620 SPECIAL PROVISION
 (DELINEATOR WITH STEEL POST)
 (AT GUARDRAIL TERMINAL)
 A36+69.5 RT
 A40+22.5 RT

675.50 REMOVING SIGNS
 AS SHOWN - 2

ENVIRONMENTALLY SENSITIVE LOCATION
 A34+00 TO A39+50 RT (LAKE FAIRLEE)

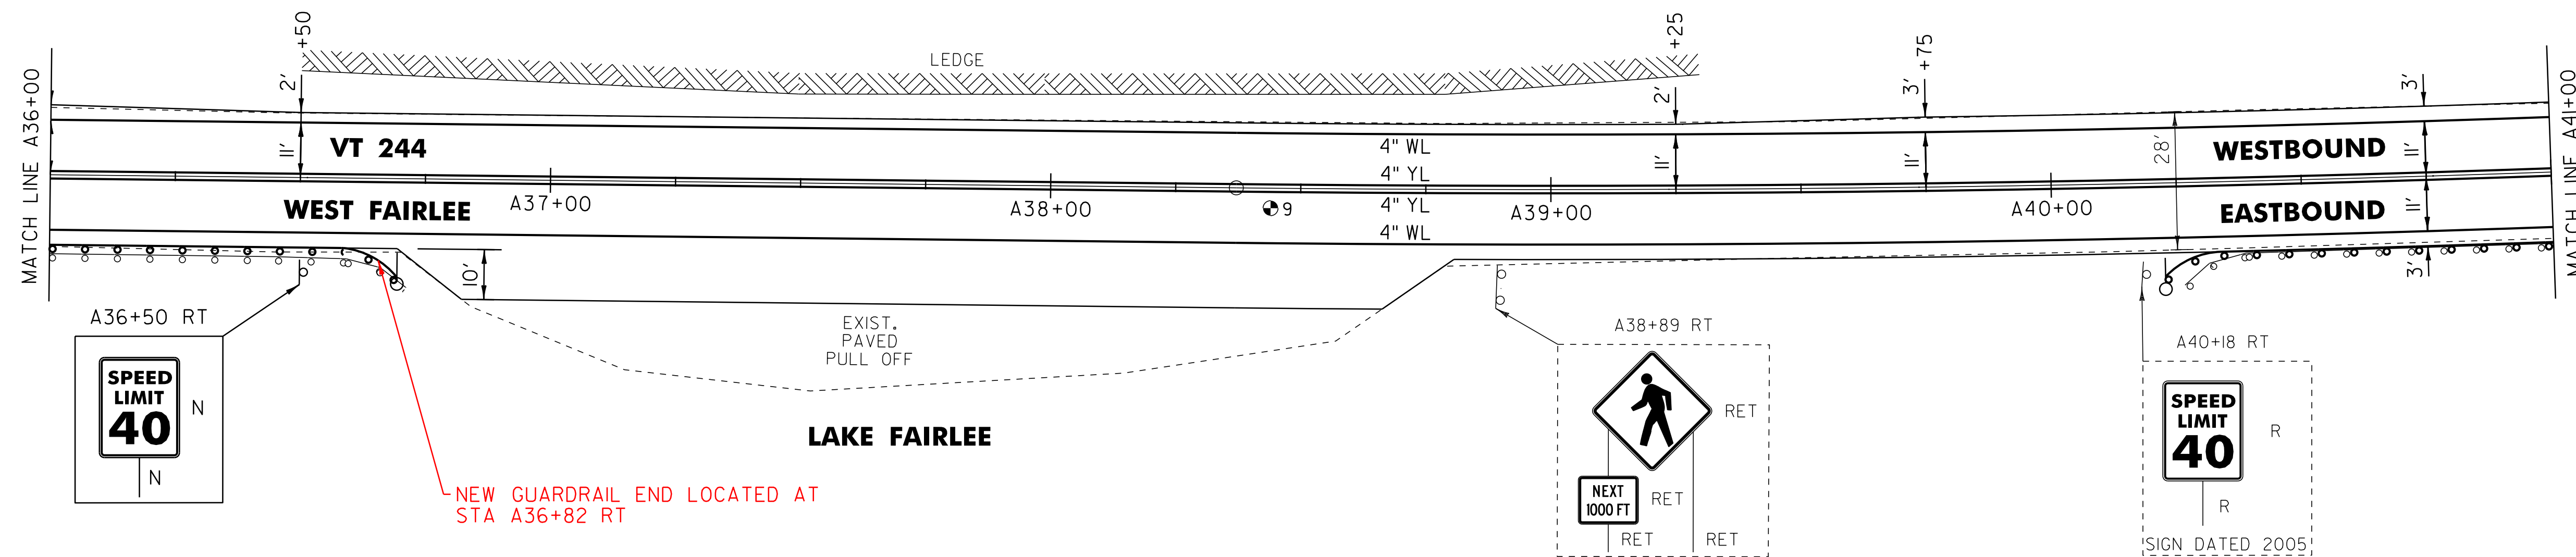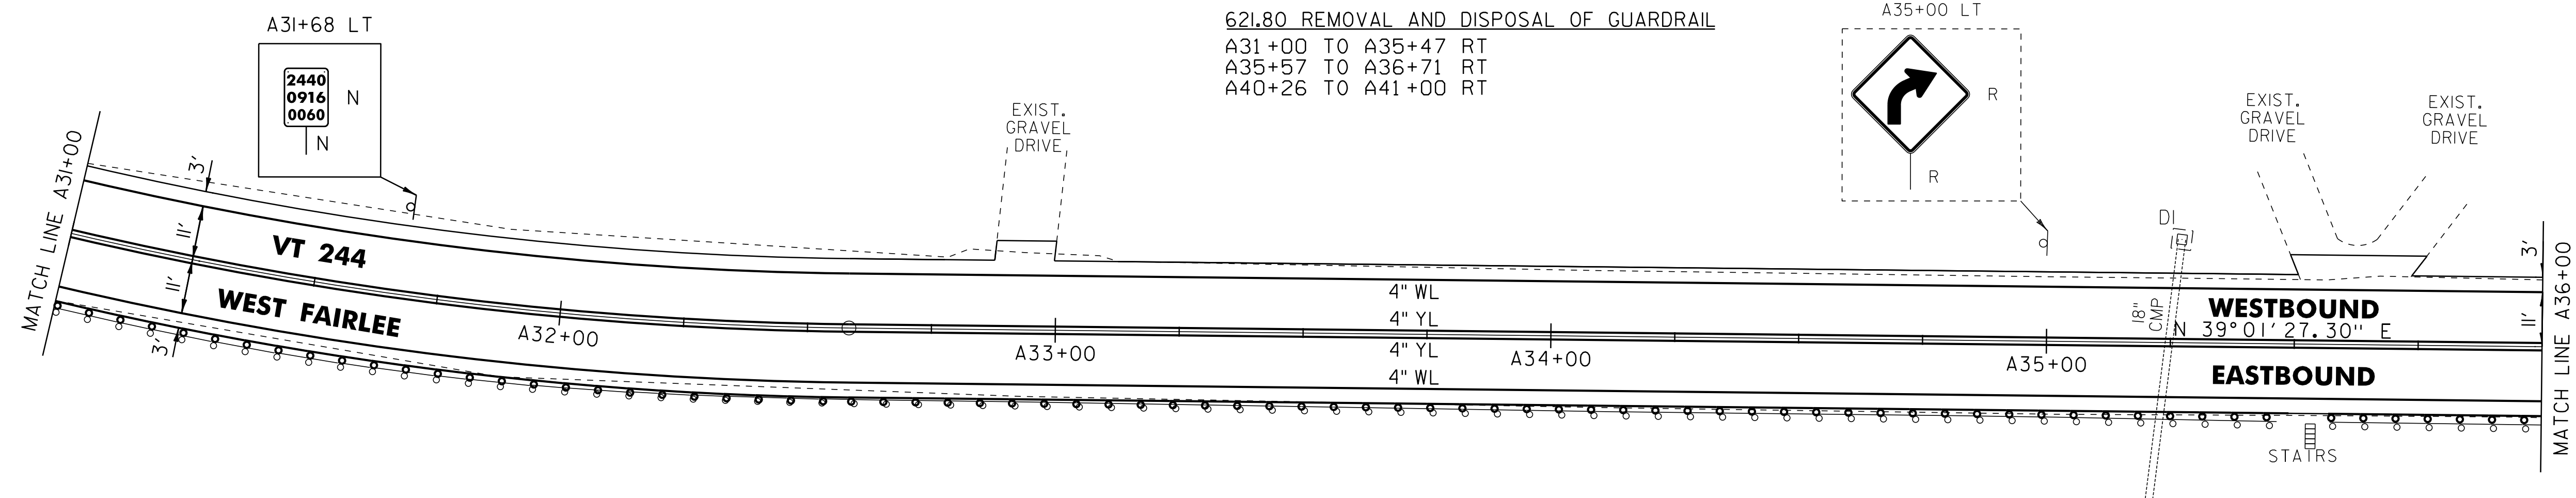

PAVEMENT CORES (IN TRAVEL WAY)

#	STA	DEPTH	PCC
9	A38+44	3.25"	NO

LEGEND

- R = REMOVE EXISTING
- S = SALVAGE
- R&S = REMOVE AND SALVAGE
- N = NEW
- RET = RETAIN
- B-B = BACK TO BACK
- = EXISTING GUARDRAIL
- = PROPOSED GUARDRAIL
- YL = YELLOW LINE
- WL = WHITE LINE
- = DELINEATOR
- ⊙ = PAVEMENT CORE

ROADWAY LAYOUT 14

PROJECT NAME: THETFORD-FAIRLEE

PROJECT NUMBER: STP 2710(I)

FILE NAME: /pave/07cl84/pci84

PROJECT LEADER: PTS

DESIGNED BY: NLL

IPARM FILE NAME: 07CI84_33

PLOT DATE: 14-OCT-2013 16:35

DRAWN BY: SNG

CHECKED BY: DAM/PTS

SHEET 32 OF 77

NOT TO SCALE