

646.602 TEMPORARY 4" WHITE LINE, PAINT  
 646.402 DURABLE 4" WHITE LINE, THERMOPLASTIC  
 646.403 DURABLE 4" WHITE LINE, EPOXY PAINT  
 646.404 DURABLE 4" WHITE LINE, POLYUREA  
 A78+50 TO F2+76 SOLID LT  
 A78+50 TO F5+00 SOLID RT  
 F2+76 TO F2+99 SOLID LT (TH 113)  
 F3+19 TO F3+52 SOLID LT (TH 113)  
 F3+52 TO F5+00 SOLID LT


646.682 TEMPORARY 24" STOP BAR, PAINT  
 646.482 DURABLE 24" STOP BAR, THERMOPLASTIC  
 646.483 DURABLE 24" STOP BAR, EPOXY PAINT  
 646.484 DURABLE 24" STOP BAR, POLYUREA  
 F2+93 TO F3+12 LT (TH 113)  
 646.692 TEMPORARY LETTER OR SYMBOL, PAINT  
 646.492 DURABLE LETTER OR SYMBOL, THERMOPLASTIC  
 646.493 DURABLE LETTER OR SYMBOL, EPOXY PAINT  
 646.494 DURABLE LETTER OR SYMBOL, POLYUREA  
 F3+04 LT - "STOP" (TH 113)

621.20 STEEL BEAM GUARDRAIL, GALVANIZED  
 F1+91 TO F2+91 RT  
 F1+98 TO ~~F2+85.5 LT~~ F2+98 LT  
 621.60 ANCHOR FOR STEEL BEAM RAIL  
 F1+91 RT  
 F1+98 LT  
 F2+85.5 LT  
 F2+91 RT  
 621.80 REMOVAL AND DISPOSAL OF GUARDRAIL  
 F1+91 TO F2+94 RT  
 F1+98 TO F2+82 LT

900.620 SPECIAL PROVISION  
 (DELINEATOR WITH STEEL POST)  
 (AT GUARDRAIL TERMINAL)  
 F1+91.0 RT  
 F1+98.0 LT  
 F2+85.5 LT  
 F2+91.0 RT

675.50 REMOVING SIGNS  
 AS SHOWN - 6  
 675.60 ERECTING SALVAGED SIGNS  
 AS SHOWN - 4  
 ENVIRONMENTALLY SENSITIVE LOCATION  
 F1+30 TO F3+00 LT (SCRUB SHRUB)  
 F1+30 TO F5+00 RT (LAKE FAIRLEE/SCRUB SHRUB)  
 F4+00 TO F5+00 LT (FORESTED)

646.612 TEMPORARY 4" YELLOW LINE, PAINT  
 646.412 DURABLE 4" YELLOW LINE, THERMOPLASTIC  
 646.413 DURABLE 4" YELLOW LINE, EPOXY PAINT  
 646.414 DURABLE 4" YELLOW LINE, POLYUREA  
 A78+50 TO F2+93 SOLID LT & RT  
 F3+09 TO F3+13 DOUBLE SOLID LT (TH 113)  
 F3+33 TO F5+00 SOLID LT & RT

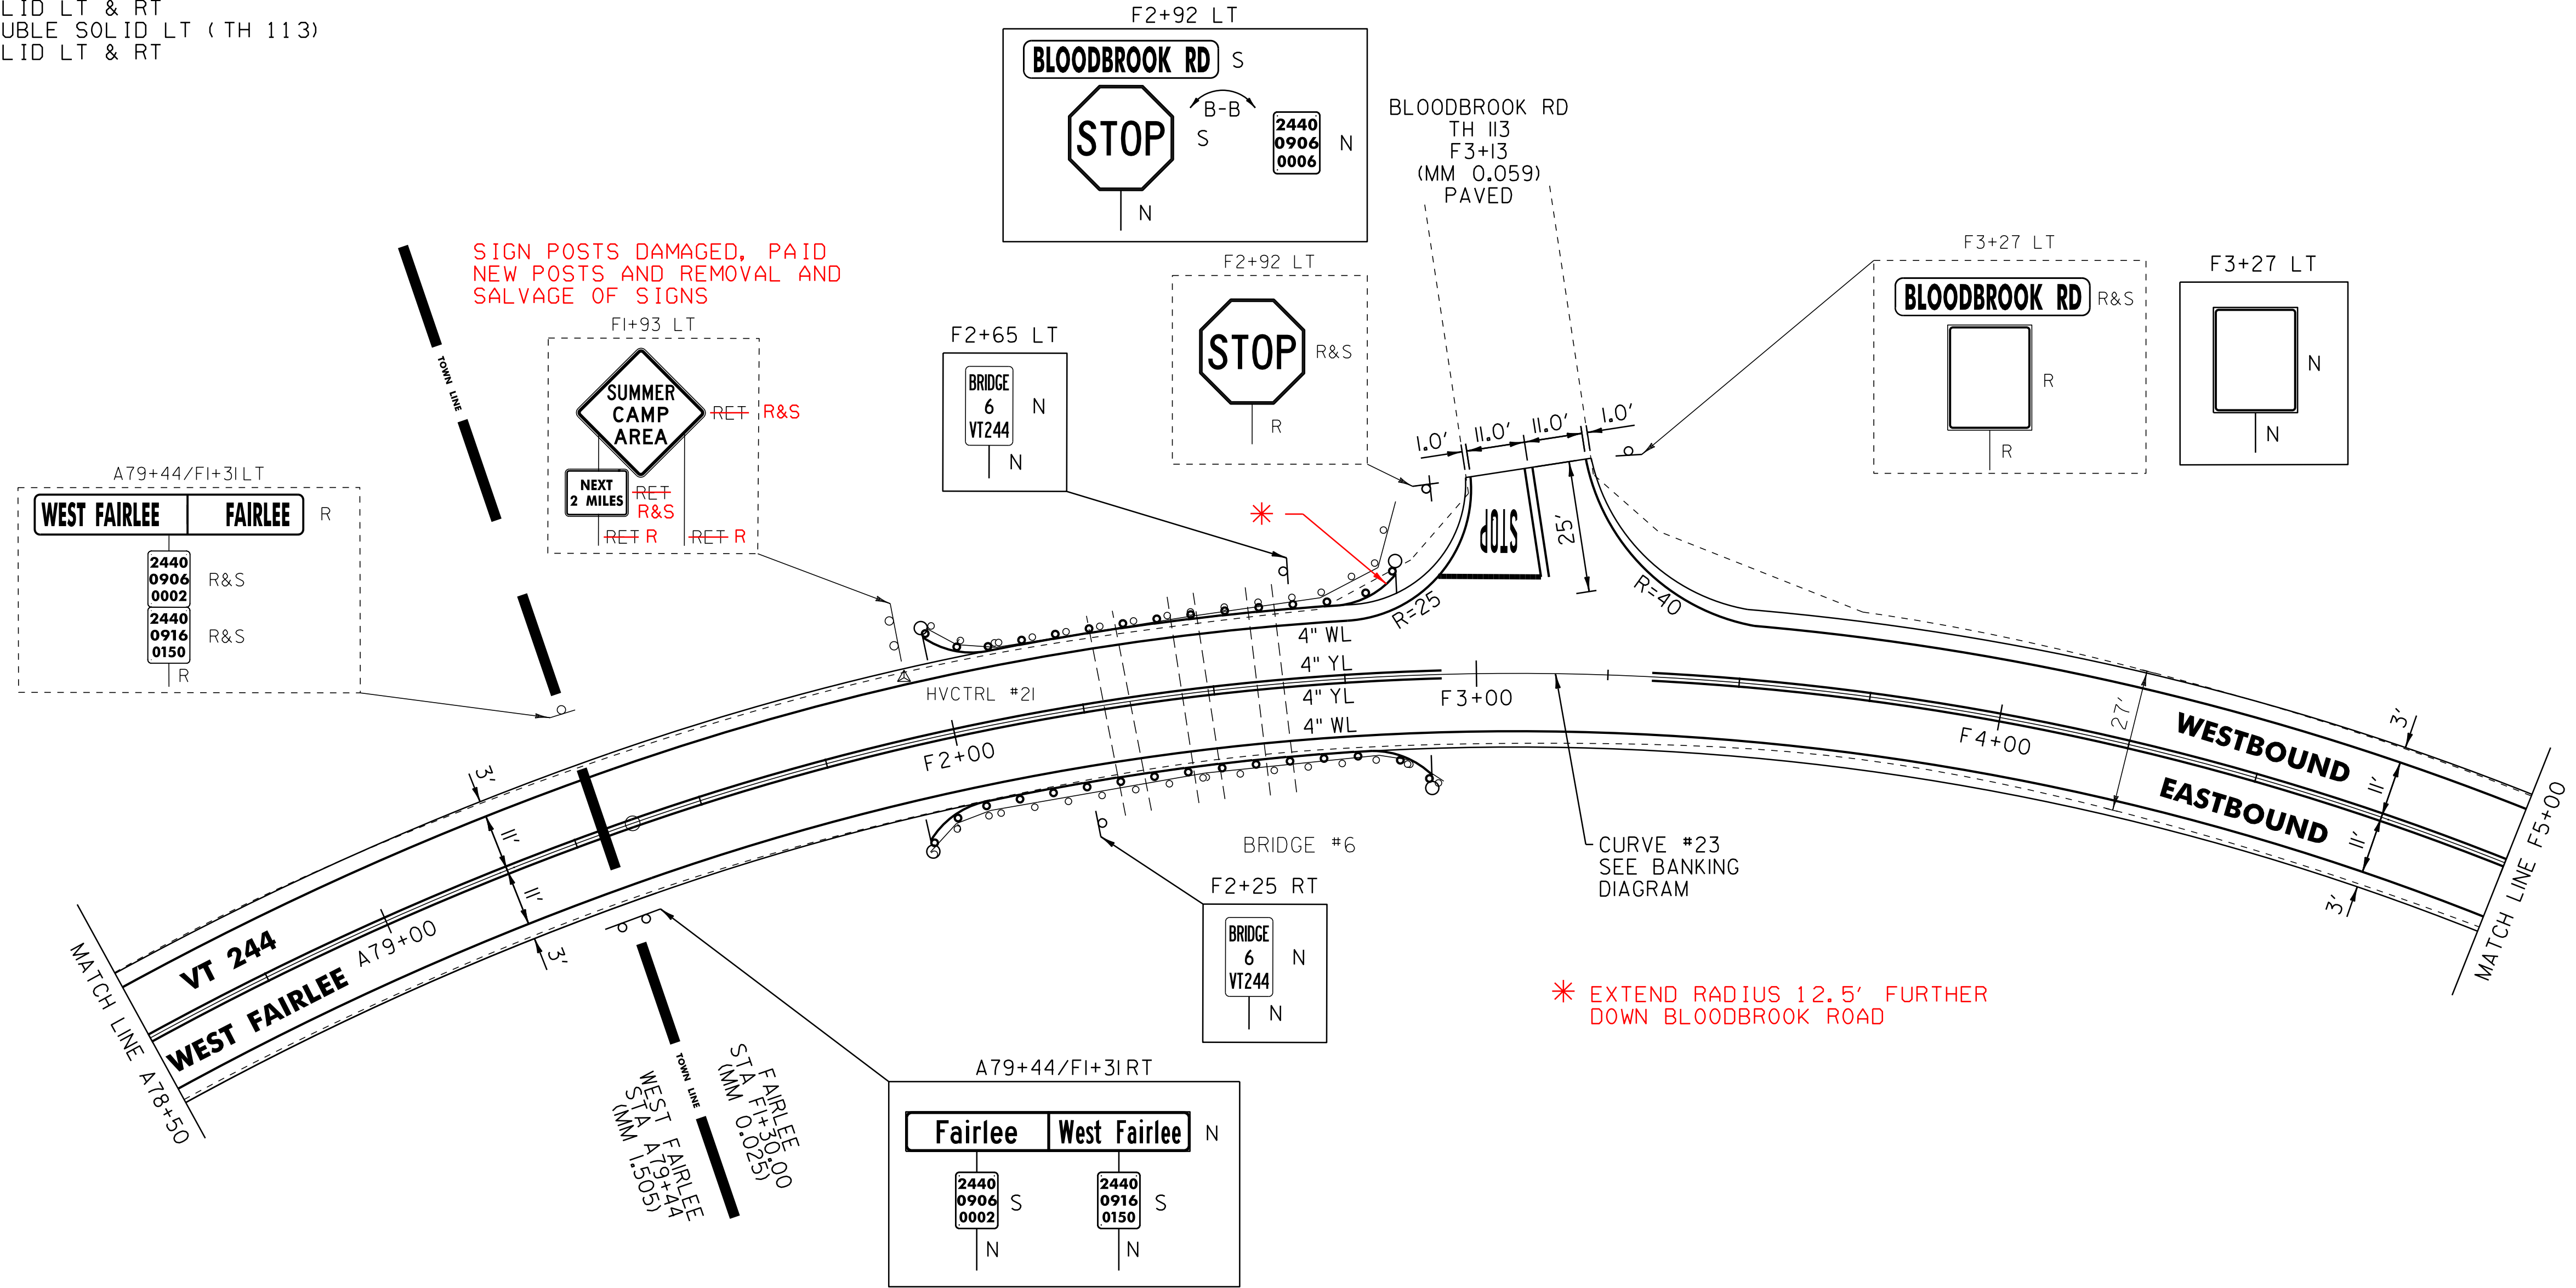

\* EXTEND RADIUS 12.5' FURTHER  
 DOWN BLOODBROOK ROAD

NOT TO SCALE

**LEGEND**

R	=	REMOVE EXISTING
S	=	SALVAGE
R&S	=	REMOVE AND SALVAGE
N	=	NEW
RET	=	RETAIN
B-B	=	BACK TO BACK
—	=	EXISTING GUARDRAIL
—	=	PROPOSED GUARDRAIL
YL	=	YELLOW LINE
WL	=	WHITE LINE
—○	=	DELINEATOR
—●	=	PAVEMENT CORE

**ROADWAY LAYOUT 19**

PROJECT NAME: THETFORD-FAIRLEE  
 PROJECT NUMBER: STP 2710(I)

FILE NAME: /pave/07cl84/pcl84	PLOT DATE: 14-OCT-2013 16:35
PROJECT LEADER: PTS	DRAWN BY: SNG
DESIGNED BY: NLL	CHECKED BY: DAM/PTS
IPARM FILE NAME: 07C184_38	SHEET 37 OF 77