
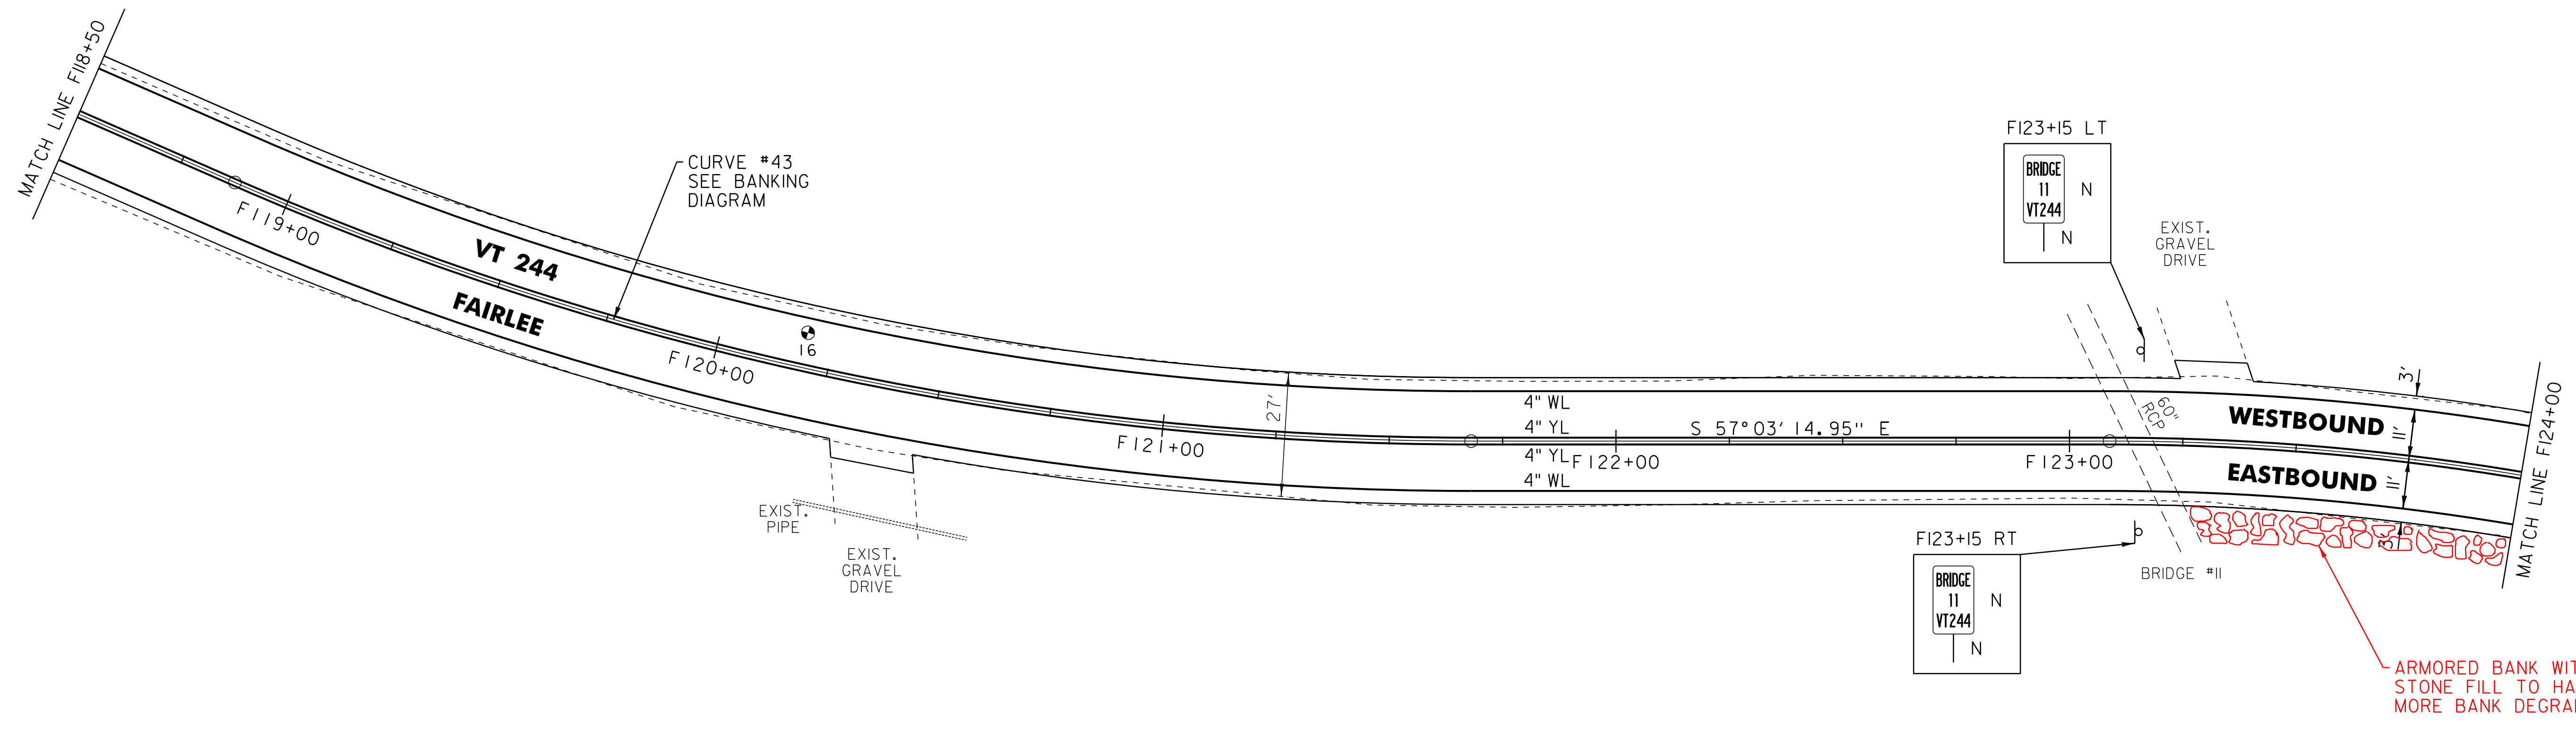


646.602 TEMPORARY 4" WHITE LINE, PAINT
 646.402 DURABLE 4" WHITE LINE, THERMOPLASTIC
 646.403 DURABLE 4" WHITE LINE, EPOXY PAINT
 646.404 DURABLE 4" WHITE LINE, POLYUREA
 F113+50 TO F124+00 SOLID LT
 F113+50 TO F124+00 SOLID RT
 646.612 TEMPORARY 4" YELLOW LINE, PAINT
 646.412 DURABLE 4" YELLOW LINE, THERMOPLASTIC
 646.413 DURABLE 4" YELLOW LINE, EPOXY PAINT
 646.414 DURABLE 4" YELLOW LINE, POLYUREA
 F113+50 TO F124+00 SOLID LT & RT

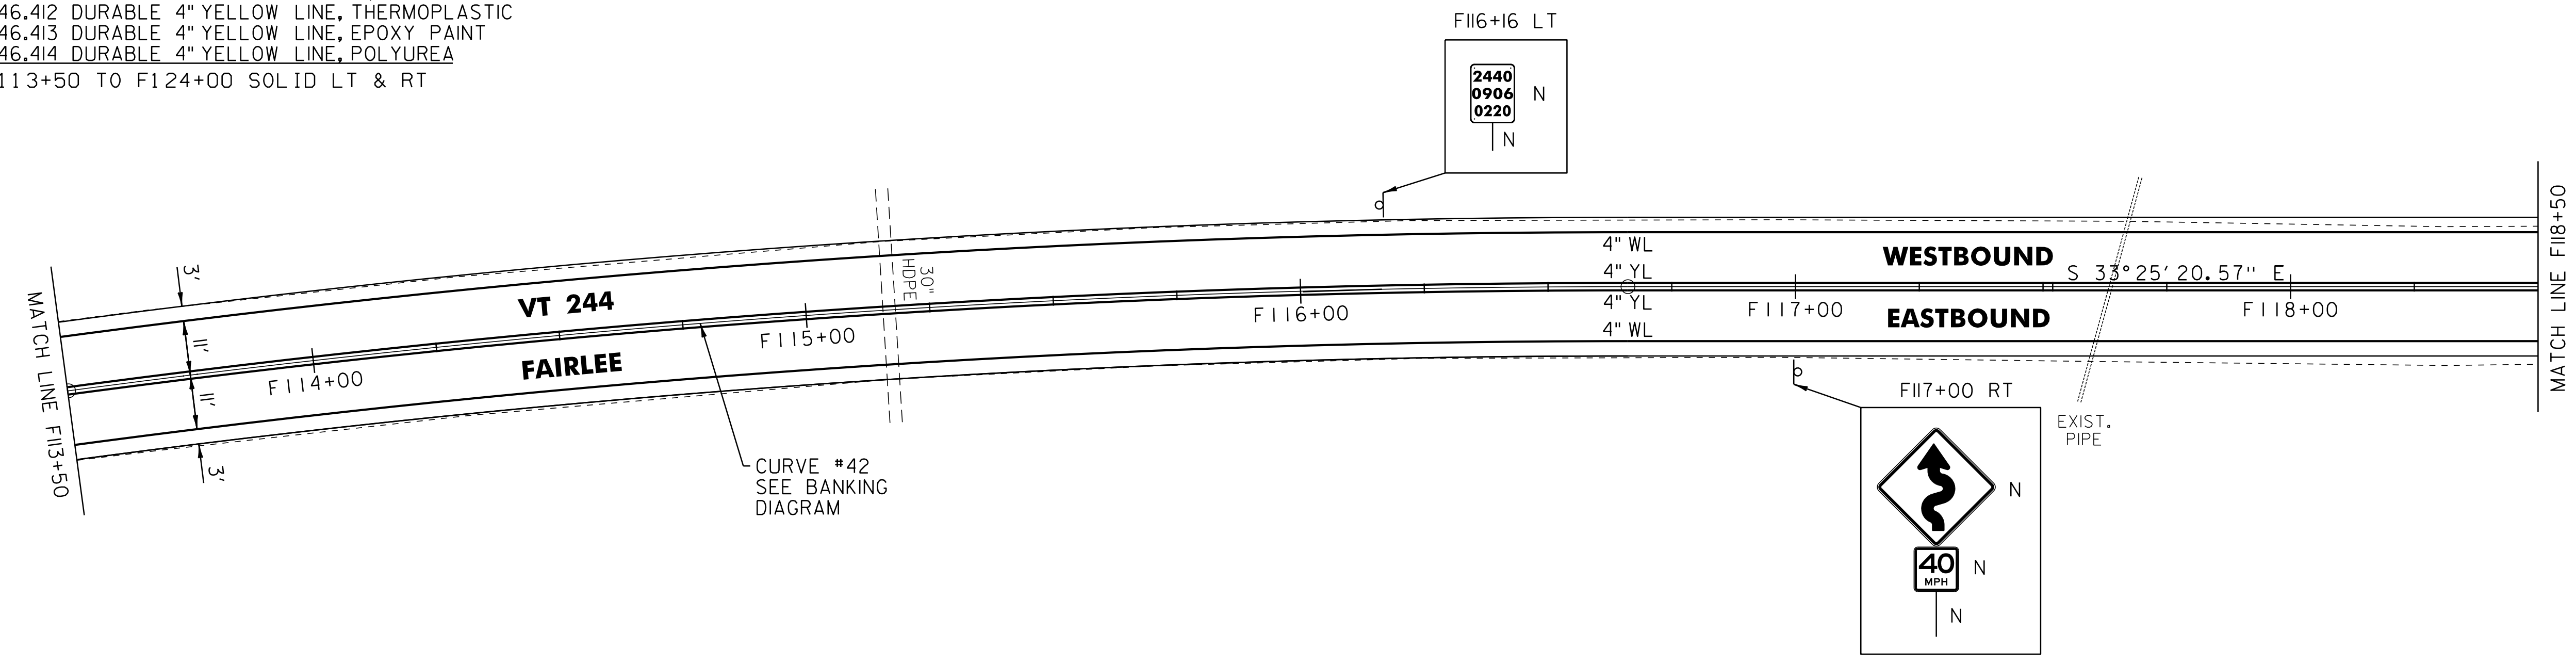

PAVEMENT CORES (IN TRAVEL WAY)

#	STA	DEPTH	PCC
16	F120+17	11.375'	NO

- LEGEND**
- R = REMOVE EXISTING
 - S = SALVAGE
 - R&S = REMOVE AND SALVAGE
 - N = NEW
 - RET = RETAIN
 - B-B = BACK TO BACK
 - = EXISTING GUARDRAIL
 - = PROPOSED GUARDRAIL
 - YL = YELLOW LINE
 - WL = WHITE LINE
 - = DELINEATOR
 - ⊙ = PAVEMENT CORE

ROADWAY LAYOUT 31

PROJECT NAME:	THETFORD-FAIRLEE
PROJECT NUMBER:	STP 2710(I)
FILE NAME:	/pave/07cl84/pcl84
PROJECT LEADER:	PTS
DESIGNED BY:	NLL
IPARM FILE NAME:	07CI84_50
PLOT DATE:	14-OCT-2013 16:35
DRAWN BY:	SNG
CHECKED BY:	DAM/PTS
SHEET	49 OF 77

NOT TO SCALE