

CURVE 10 - THETFORD

CURVE 11 - THETFORD

CURVE 12 - THETFORD

STATION	NORTHING	EASTING	REMARKS
PC 60+10.4	505631.520	1709394.962	POSTED SPEED = 40
PT 62+78.2	505607.337	1709649.892	


DELTA= 59°00'13" LT
 D = 22°02'12"
 R = 260.00'
 T = 147.11'
 L = 267.75'
 E = 38.73'

STATION	NORTHING	EASTING	REMARKS
PC 63+02.5	505617.264	1709672.103	POSTED SPEED = 40
PT 65+01.9	505719.379	1709842.836	

DELTA= 13°36'05" LT
 D = 6°49'15"
 R = 840.00'
 T = 100.17'
 L = 199.41'
 E = 5.95'

STATION	NORTHING	EASTING	REMARKS
PC 66+96.6	505838.401	1709996.920	POSTED SPEED = 40
PT 69+64.9	505975.000	1710226.994	

DELTA= 13°58'17" RT
 D = 5°12'31"
 R = 1100.00'
 T = 134.79'
 L = 268.23'
 E = 8.23'

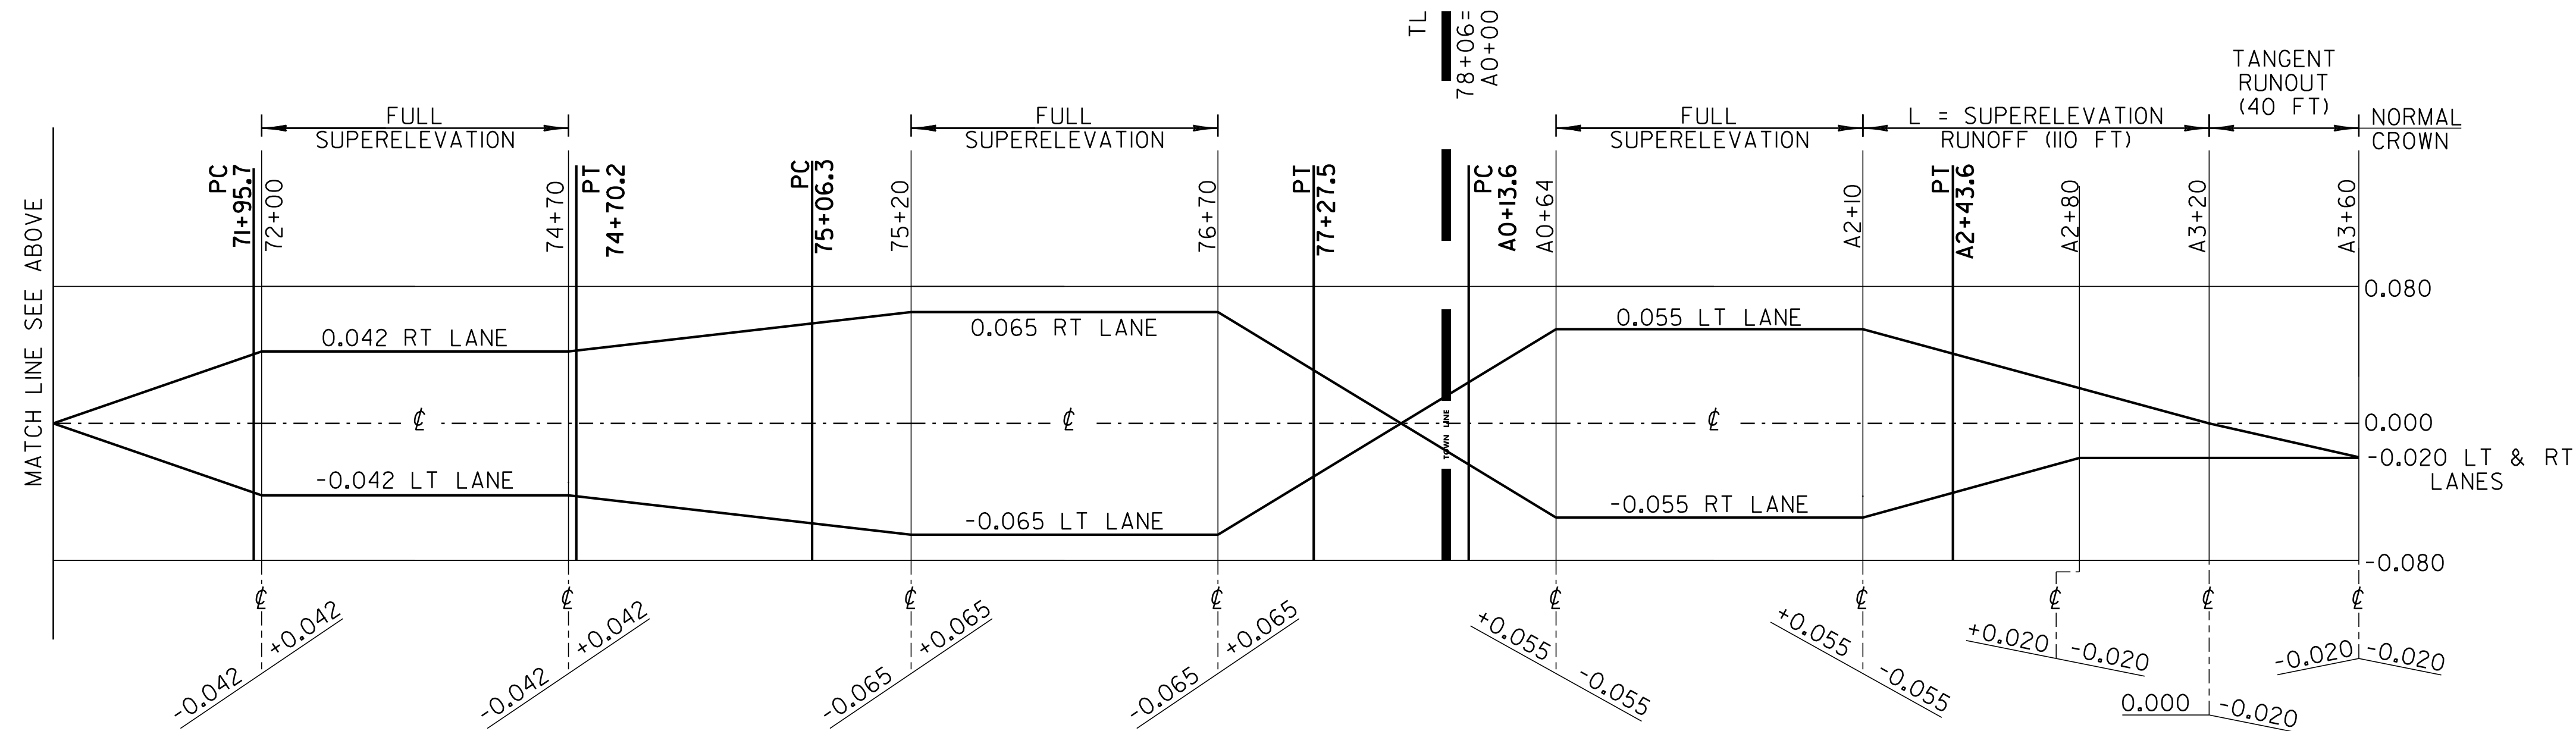

CURVE 13 - THETFORD

CURVE 14 - THETFORD

CURVE 15 - WEST FAIRLEE

STATION	NORTHING	EASTING	REMARKS
PC 71+95.7	506067.826	1710438.331	POSTED SPEED = 40
PT 74+70.2	506211.137	1710671.483	

DELTA= 15°43'47" LT
 D = 5°43'46"
 R = 1000.00'
 T = 138.14'
 L = 274.54'
 E = 9.50'

STATION	NORTHING	EASTING	REMARKS
PC 75+06.3	506234.053	1710699.340	POSTED SPEED = 40
PT 77+27.5	506411.776	1710826.801	

DELTA= 29°49'11" LT
 D = 13°28'53"
 R = 425.00'
 T = 113.16'
 L = 221.19'
 E = 14.81'

STATION	NORTHING	EASTING	REMARKS
PC A0+13.6	506497.739	1710859.349	POSTED SPEED = 40
PT A2+43.6	506692.978	1710978.353	

DELTA= 21°15'06" RT
 D = 9°14'28"
 R = 620.00'
 T = 116.32'
 L = 229.96'
 E = 10.82'

BANKING DIAGRAM 2

PROJECT NAME: THETFORD-FAIRLEE

PROJECT NUMBER: STP 2710(I)

FILE NAME: /pave/07c184/pcl84

PROJECT LEADER: PTS

DESIGNED BY: DAM

IPARM FILE NAME: 07C184_54

PLOT DATE: 14-OCT-2013 16:36

DRAWN BY: SNG

CHECKED BY: PTS

SHEET 53 OF 77

NOT TO SCALE