


SAFETY EDGE DETAIL
NOT TO SCALE

NOTES:

- 1, LEVELING COURSE MAY INCLUDE THE "SAFETY EDGE" AT THE CONTRACTOR'S CHOICE.
- 2, THE EDGE OF PAVEMENT SHALL BE FORMED IN SUCH A WAY THAT THE BITUMINOUS CONCRETE PAVEMENT IS EXTRUDED OR COMPRESSED TO FORM THE 30 TO 35 DEGREE ANGLE. DEVICES THAT SIMPLY STRIKE-OFF THE MIX WITHOUT PROVIDING ANY COMPACTIVE EFFORT WILL NOT BE ALLOWED.

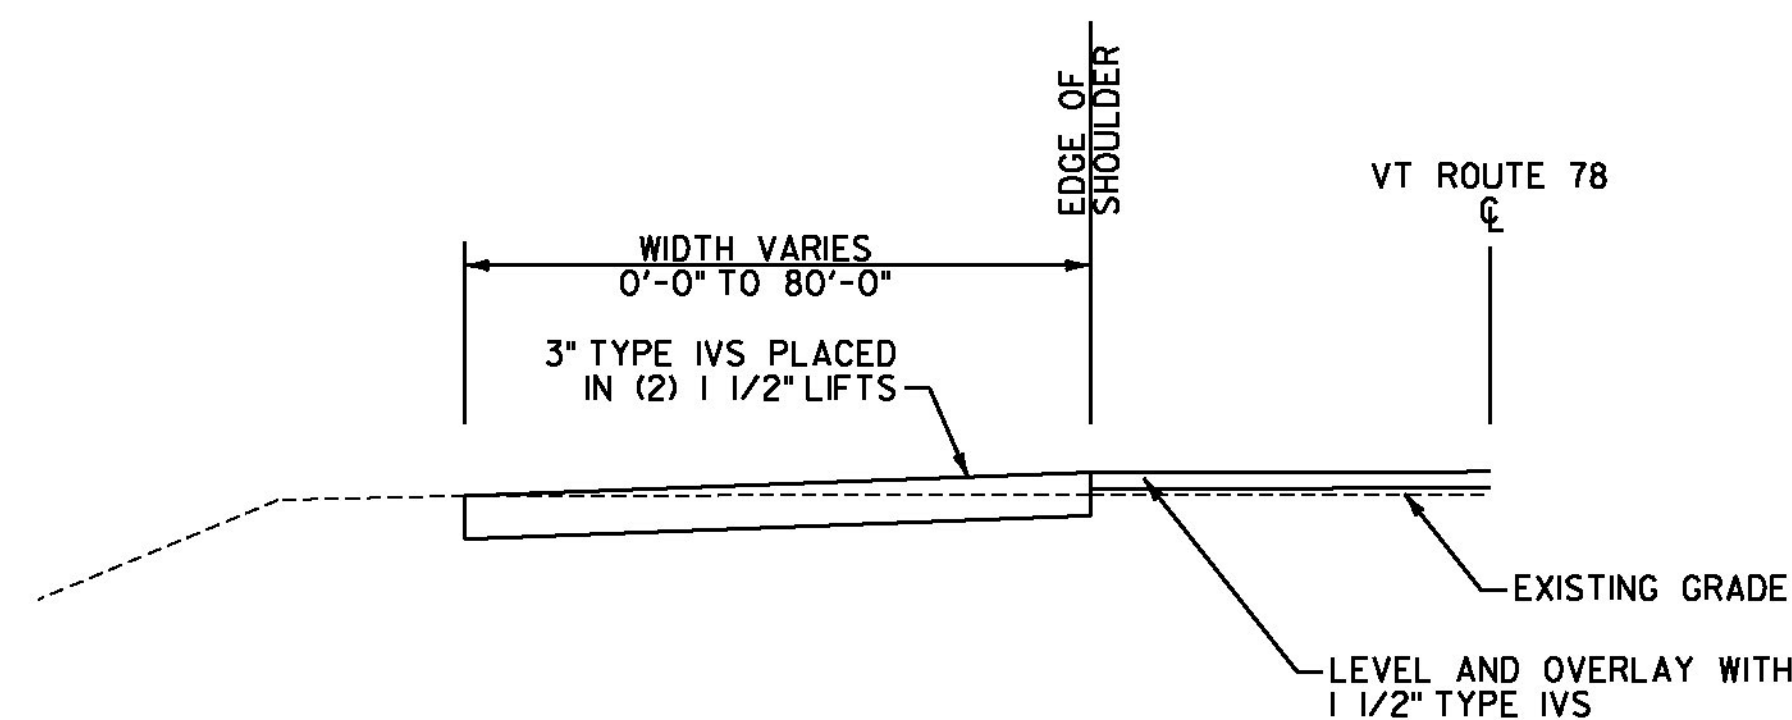

PAVED PULL-OFF DETAIL IN OVERLAY AREAS

HIGHGATE:
STA. 104+1 TO 105+48, RT
STA. 153+29 TO 155+91, LT
STA. 316+97 TO 318+93, RT

PAVED PULL-OFF

NOTES:

1. GRADE EXISTING GRAVEL PULL-OFF AS NECESSARY TO PROVIDE A SMOOTH SURFACE OR AS DIRECTED BY THE ENGINEER. PAYMENT SHALL BE MADE UNDER ITEM 608.15 POWER GRADER RENTAL. ANY EXCAVATION REQUIRED, SHALL BE PAID AS ITEM 203.15 COMMON EXCAVATION.
2. AN ESTIMATED QUANTITY OF ITEM 900.675 SPECIAL PROVISION (HAND-PLACED BITUMINOUS CONCRETE MATERIAL, DRIVES) FOR WORK AT BOTH ENDS OF THE PULL-OFFS HAS BEEN INCLUDED FOR USE AS DIRECTED BY THE ENGINEER.

SEEDING FORMULA

RATE: DOUBLE IF HYDROSEEDING				
% WT.	LBS./A.	NAME	PUR %	GERM %
38	32	CREEPING RED FESCUE	98	90
29	24	SPARTAN HARD FESCUE	95	85
15	12	AZAY SHEEP'S FESCUE	95	87
15	12	ANNUAL RYE GRASS	95	90
3	--	INERTS	--	--
100.0	80 LB/A			

NOTES

- SEED MIXTURE: SHALL NOT HAVE A WEED CONTENT EXCEEDING 0.40% BY WEIGHT AND SHALL BE FREE OF ALL NOXIOUS SEED.
- SEED ITEM 651.15: TO BE APPLIED PER SEEDING FORMULAS OR AS DIRECTED BY THE ENGINEER.
- FERTILIZER ITEM 651.18: FORMULA 10-20-10, TO BE USED WITH SEED, APPLIED AT THE RATE OF 500 LBS./ACRE. (HYDRO SEEDERS MAY USE 19-19-19 FORMULA)
- AGRICULTURAL LIMESTONE ITEM 651.20: TO BE APPLIED AT THE RATE OF 2 TONS/ACRE, OR AS DIRECTED BY THE ENGINEER.
- HAY MULCH ITEM 651.25: TO BE PLACED ON THE EARTH SLOPES AT THE RATE OF 2 TONS/ACRE, OR AS DIRECTED BY THE ENGINEER.
- TOPSOIL ITEM 651.35: TO BE USED WITH SEED AS INDICATED ON THE PLANS, OR AS DIRECTED BY THE ENGINEER.

NOT TO SCALE



**PROJECT
TYPICAL
SHEET #3**

PROJECT NAME: SWANTON-SHELDON	PLOT DATE: 4/24/2014
PROJECT NUMBER: STP 2715(1)	DRAWN BY: G. BARRETT
FILE NAME: p07cl86.dgn	CHECKED BY: M. FOISY
PROJECT LEADER: G. EDWARDS	SHEET 4 OF 121
DESIGNED BY: G. BARRETT	