


TEMPORARY 4 INCH WHITE LINE, PAINT
 DURABLE 4 INCH WHITE LINE (OPTION BID ITEM)
 (ALL LINES WILL INCLUDE EDGE LINE BREAKS
 AND RADII FOR SIDE ROADS)
 STA. 408+50 TO 413+50, SOLID LT & RT


TEMPORARY 4 INCH YELLOW LINE, PAINT
 DURABLE 4 INCH YELLOW LINE (OPTION BID ITEM)
 (ALL LINES WILL INCLUDE C BREAKS FOR SIDE ROADS)
 STA. 408+50 TO 413+50, SOLID LT & RT

REMOVING SIGNS
 AS SHOWN - I

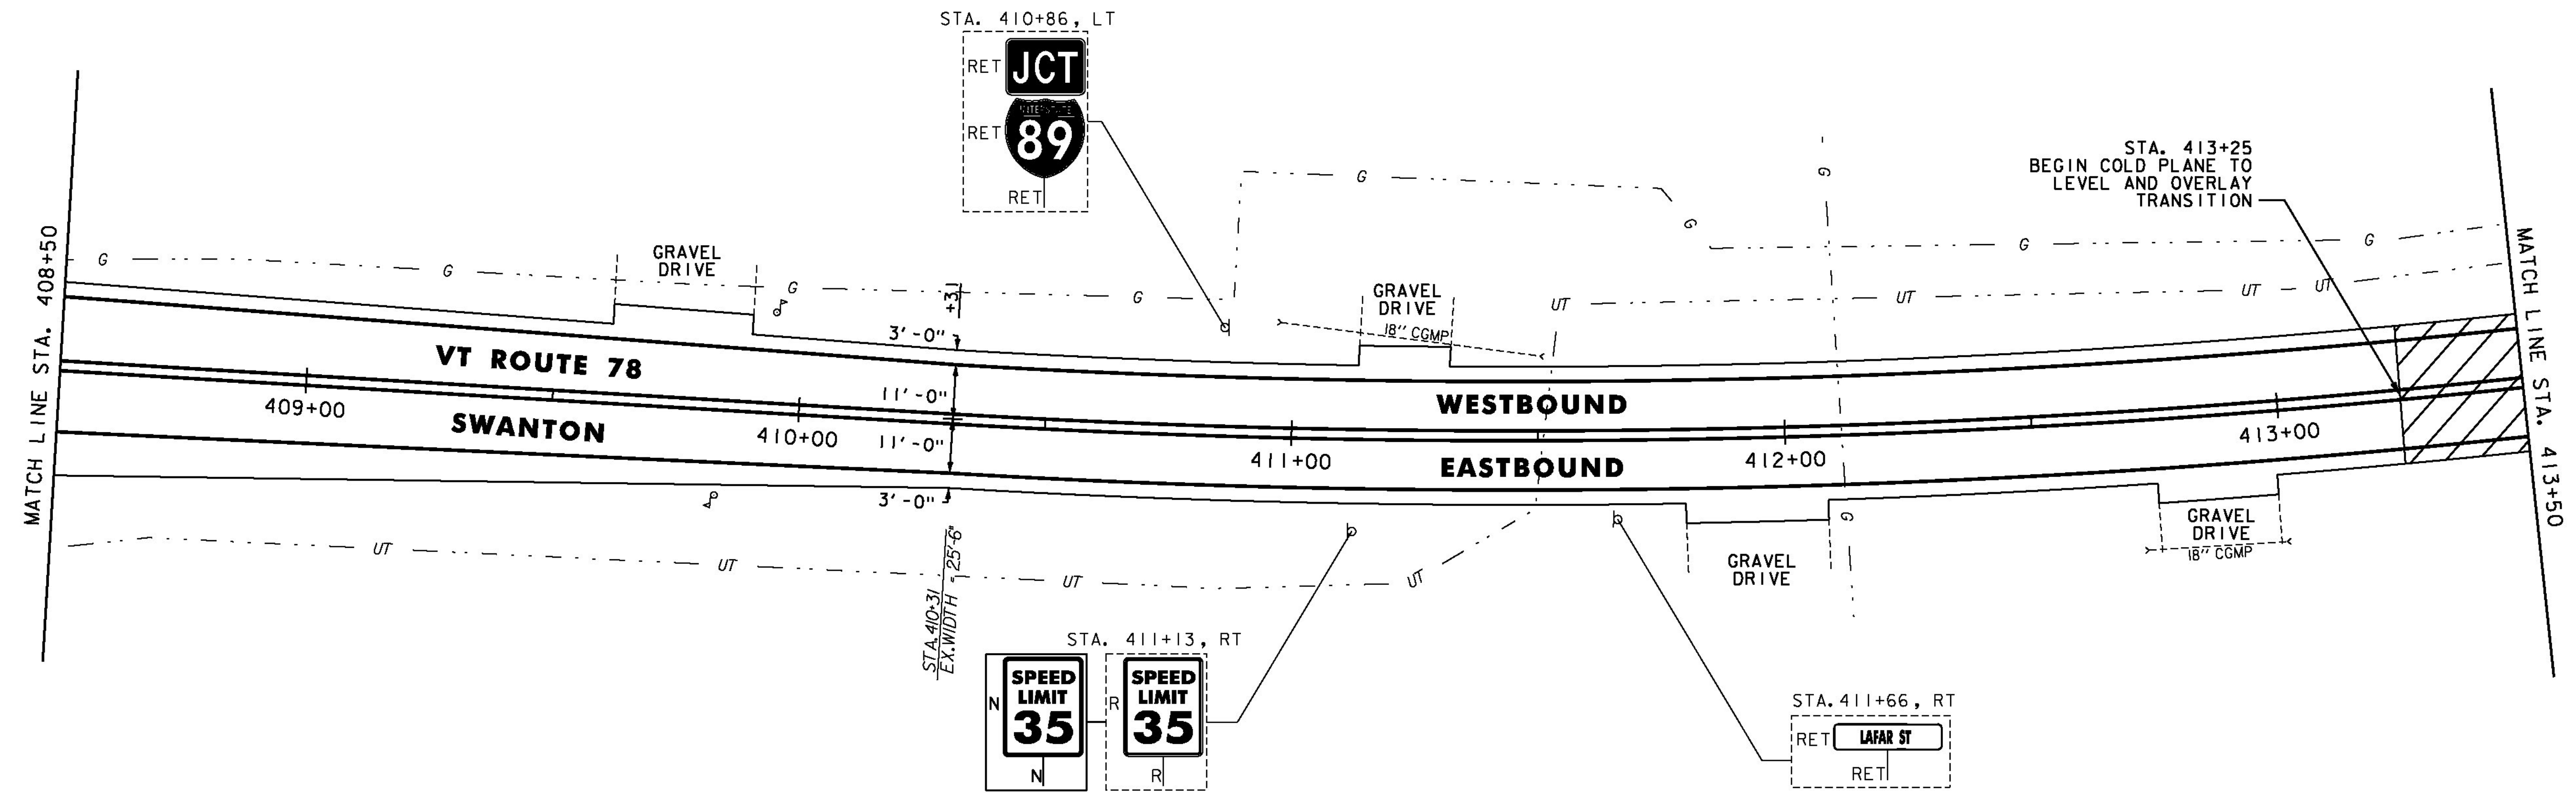

- NOTES:
1. FOR LEGENDS, SEE SHEET 19.
 2. ALL EXISTING SIGNS NOT SHOWN SHALL BE RETAINED.
 3. ALL UTILITY LOCATIONS SHOWN ARE APPROXIMATE AND SHOULD BE VERIFIED PRIOR TO ANY WORK COMMENCING.

NOT TO SCALE

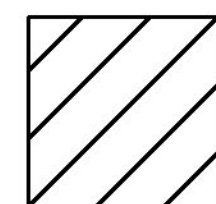

COLD PLANE TRANSITION AREA
 (FOR DETAIL, SEE SHEET 3)



**PROJECT
 LAYOUT
 SHEET #5**

PROJECT NAME: SWANTON-SHELDON	PLOT DATE: 4/24/2014
PROJECT NUMBER: STP 2715(I)	DRAWN BY: G. BARRETT
FILE NAME: p07cl86.dgn	CHECKED BY: M. FOISY
PROJECT LEADER: G. EDWARDS	SHEET 23 OF 121
DESIGNED BY: G. BARRETT	