


TEMPORARY 4 INCH WHITE LINE, PAINT  
 DURABLE 4 INCH WHITE LINE (OPTION BID ITEM)  
 (ALL LINES WILL INCLUDE EDGE LINE BREAKS  
 AND RADI FOR SIDE ROADS)  
 SWANTON STA. 424+50 TO 429+58.08, SOLID LT & RT  
 SWANTON STA. 426+13, SOLID LT (LANE LINE)  
 HIGHGATE STA. 0+00 TO 0+50, SOLID LT & RT

TEMPORARY 4 INCH YELLOW LINE, PAINT  
 DURABLE 4 INCH YELLOW LINE (OPTION BID ITEM)  
 (ALL LINES WILL INCLUDE & BREAKS FOR SIDE ROADS)  
 SWANTON STA. 424+50 TO 429+58.08, SOLID LT & RT  
 SWANTON STA. 425+58, DOUBLE SOLID RT (TORRIE DR, TH-59)  
 HIGHGATE STA. 0+00 TO 0+50, SOLID LT & RT

TEMPORARY 24 INCH STOP BAR, PAINT  
 DURABLE 24 INCH STOP BAR (OPTION BID ITEM)  
 SWANTON STA. 425+58, RT (TORRIE DRIVE, TH-59)  
 SWANTON STA. 426+06, LT (MISSISQUOI SCHOOL)

TEMPORARY LETTER OR SYMBOL, PAINT  
 DURABLE LETTER OR SYMBOL (OPTION BID ITEM)  
 SWANTON STA. 425+58, RT (TORRIE DRIVE, TH-59)  
 SWANTON STA. 426+06, LT ARROWS (2) (MISSISQUOI SCHOOL)

REMOVING SIGNS  
 AS SHOWN - 14

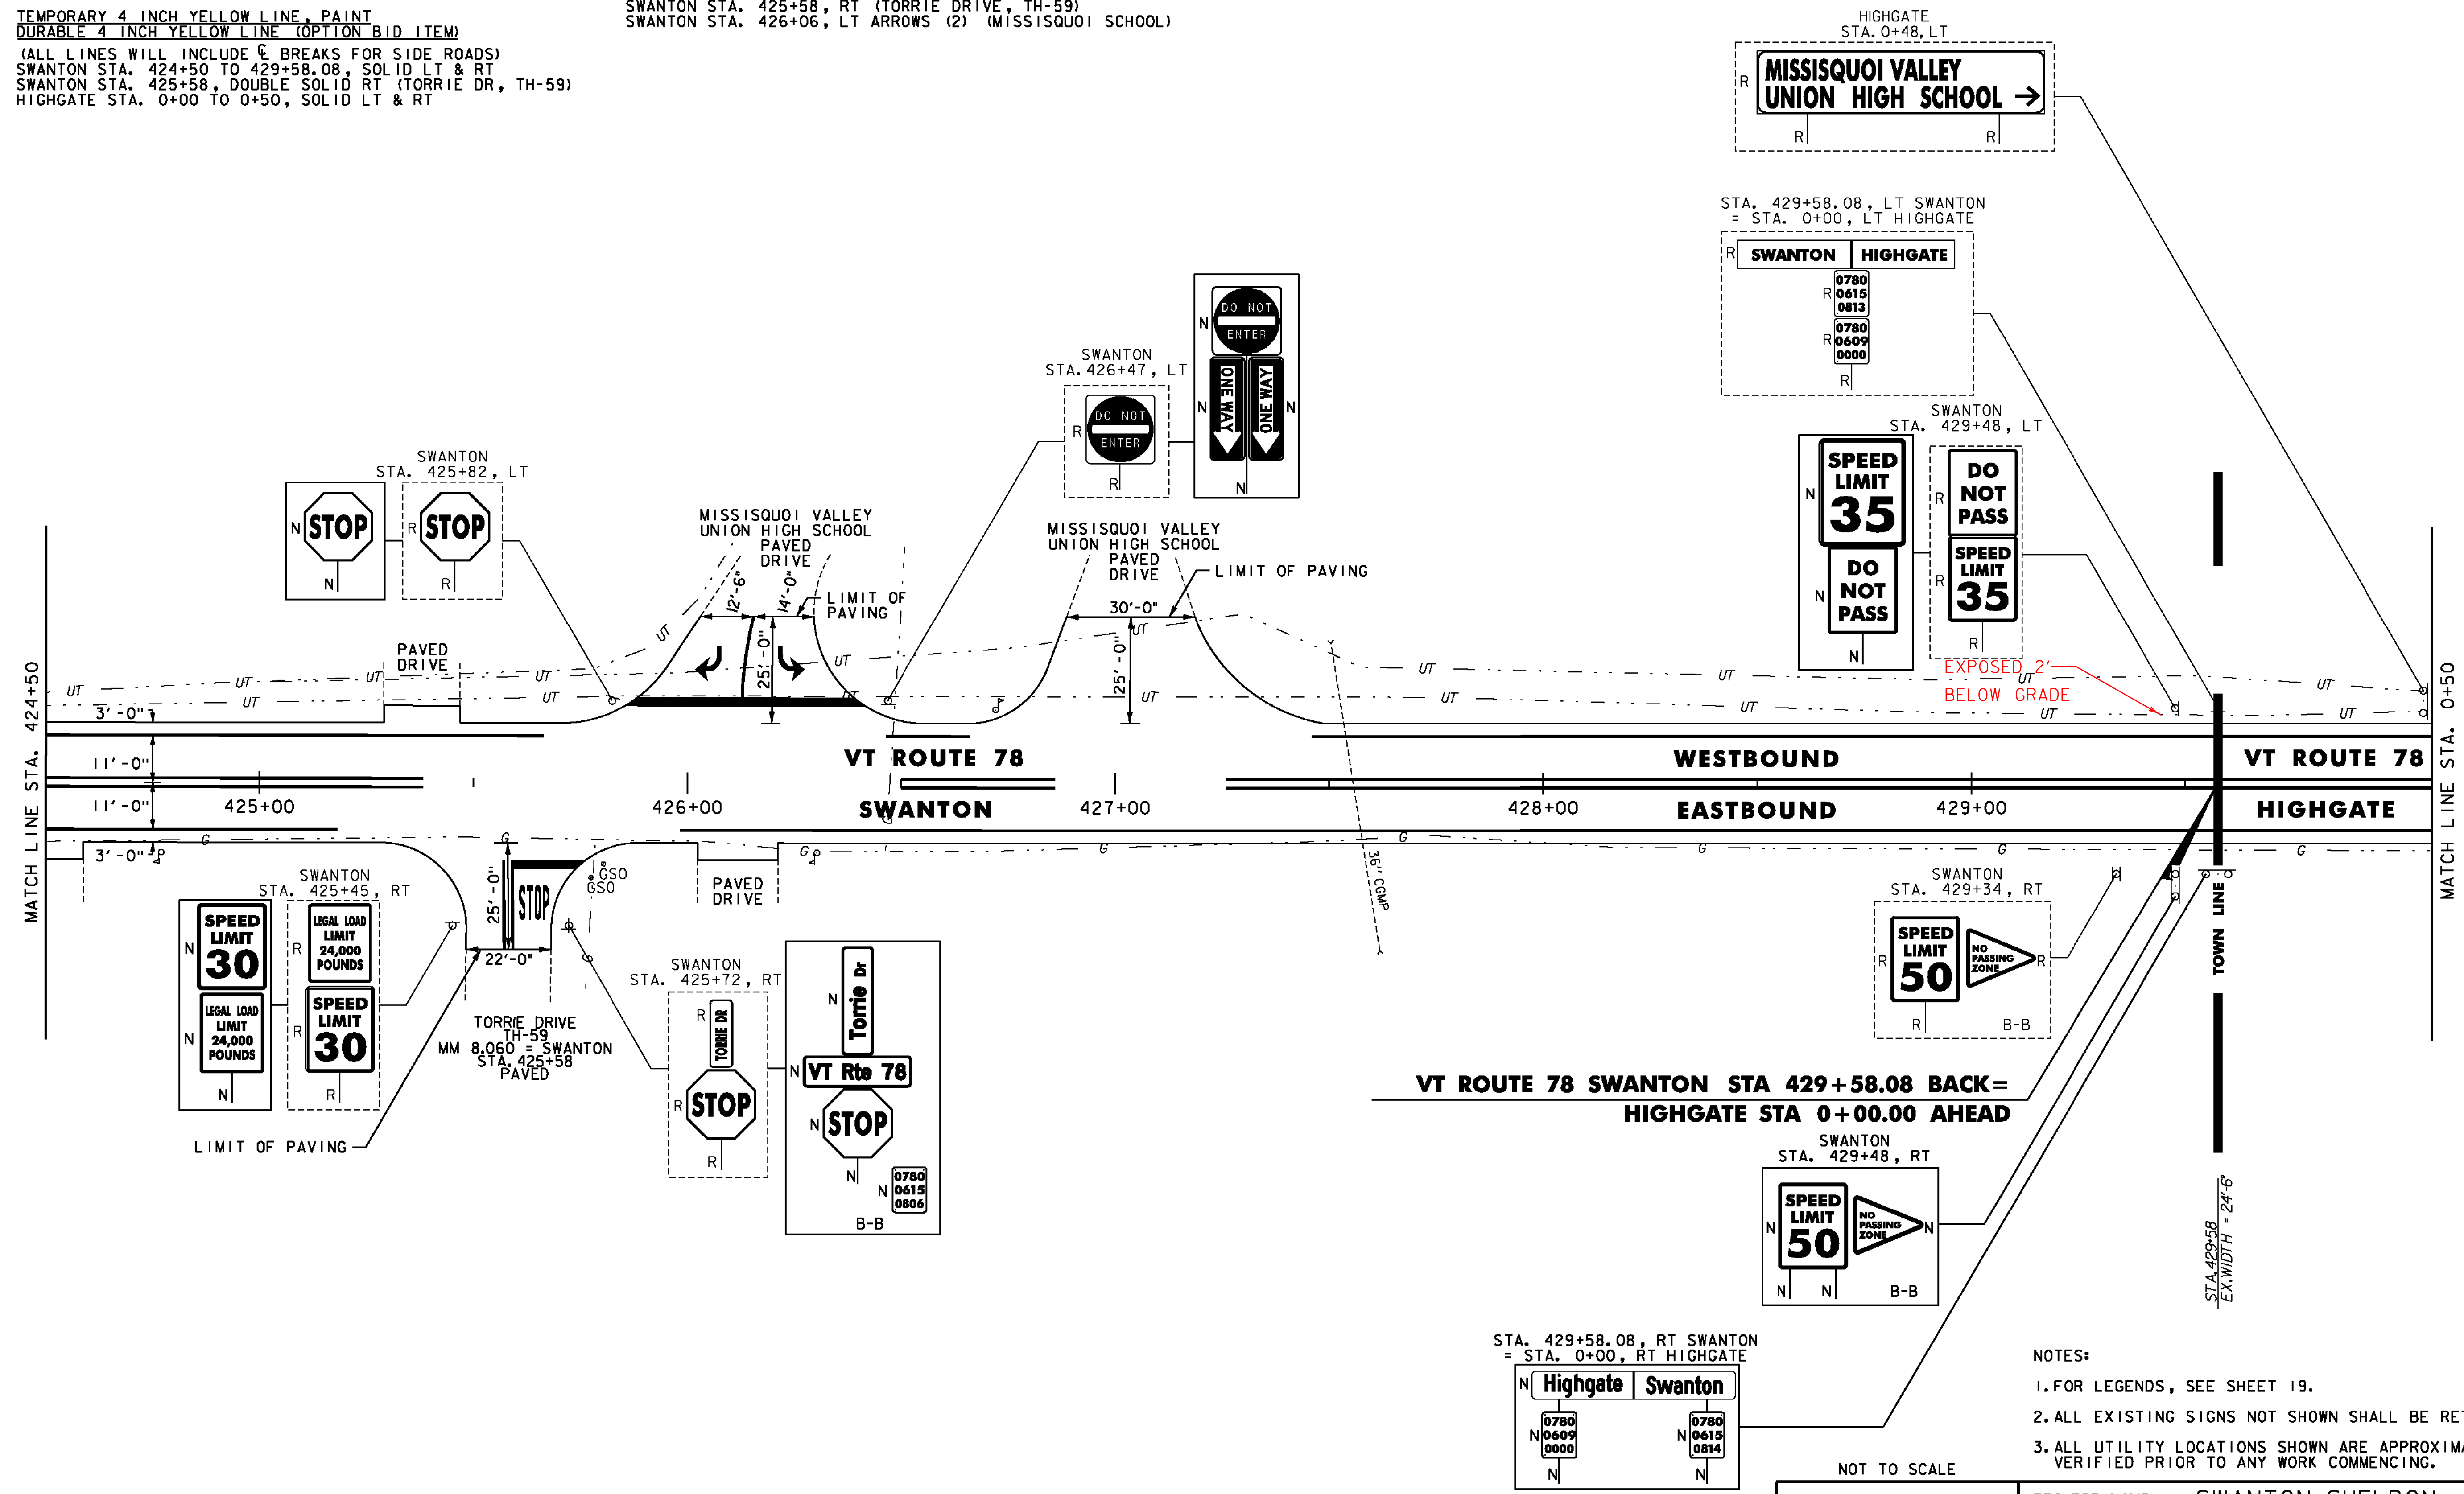

VT ROUTE 78 SWANTON STA 429+58.08 BACK=  
 HIGHGATE STA 0+00.00 AHEAD

- NOTES:
1. FOR LEGENDS, SEE SHEET 19.
  2. ALL EXISTING SIGNS NOT SHOWN SHALL BE RETAINED.
  3. ALL UTILITY LOCATIONS SHOWN ARE APPROXIMATE AND SHOULD BE VERIFIED PRIOR TO ANY WORK COMMENCING.

NOT TO SCALE

**PROJECT LAYOUT SHEET #8**

PROJECT NAME:	SWANTON-SHELDON
PROJECT NUMBER:	STP 2715(I)
FILE NAME:	p07cl86.dgn
PROJECT LEADER:	G. EDWARDS
DESIGNED BY:	G. BARRETT
PLOT DATE:	4/24/2014
DRAWN BY:	G. BARRETT
CHECKED BY:	M. FOISY
SHEET	26 OF 121

