


TEMPORARY 4 INCH WHITE LINE, PAINT
 DURABLE 4 INCH WHITE LINE (OPTION BID ITEM)
 (ALL LINES WILL INCLUDE EDGE LINE BREAKS
 AND RADII FOR SIDE ROADS)
 STA. 0+50 TO 5+00, SOLID LT & RT

TEMPORARY 4 INCH YELLOW LINE, PAINT
 DURABLE 4 INCH YELLOW LINE (OPTION BID ITEM)
 (ALL LINES WILL INCLUDE $\frac{1}{2}$ BREAKS FOR SIDE ROADS)
 STA. 0+50 TO 5+00, SOLID LT & RT

TEMPORARY LETTER OR SYMBOL, PAINT
 DURABLE LETTER OR SYMBOL (OPTION BID ITEM)
 STA. 4+75, LT "SCHOOL"


REMOVING SIGNS
 AS SHOWN - 2

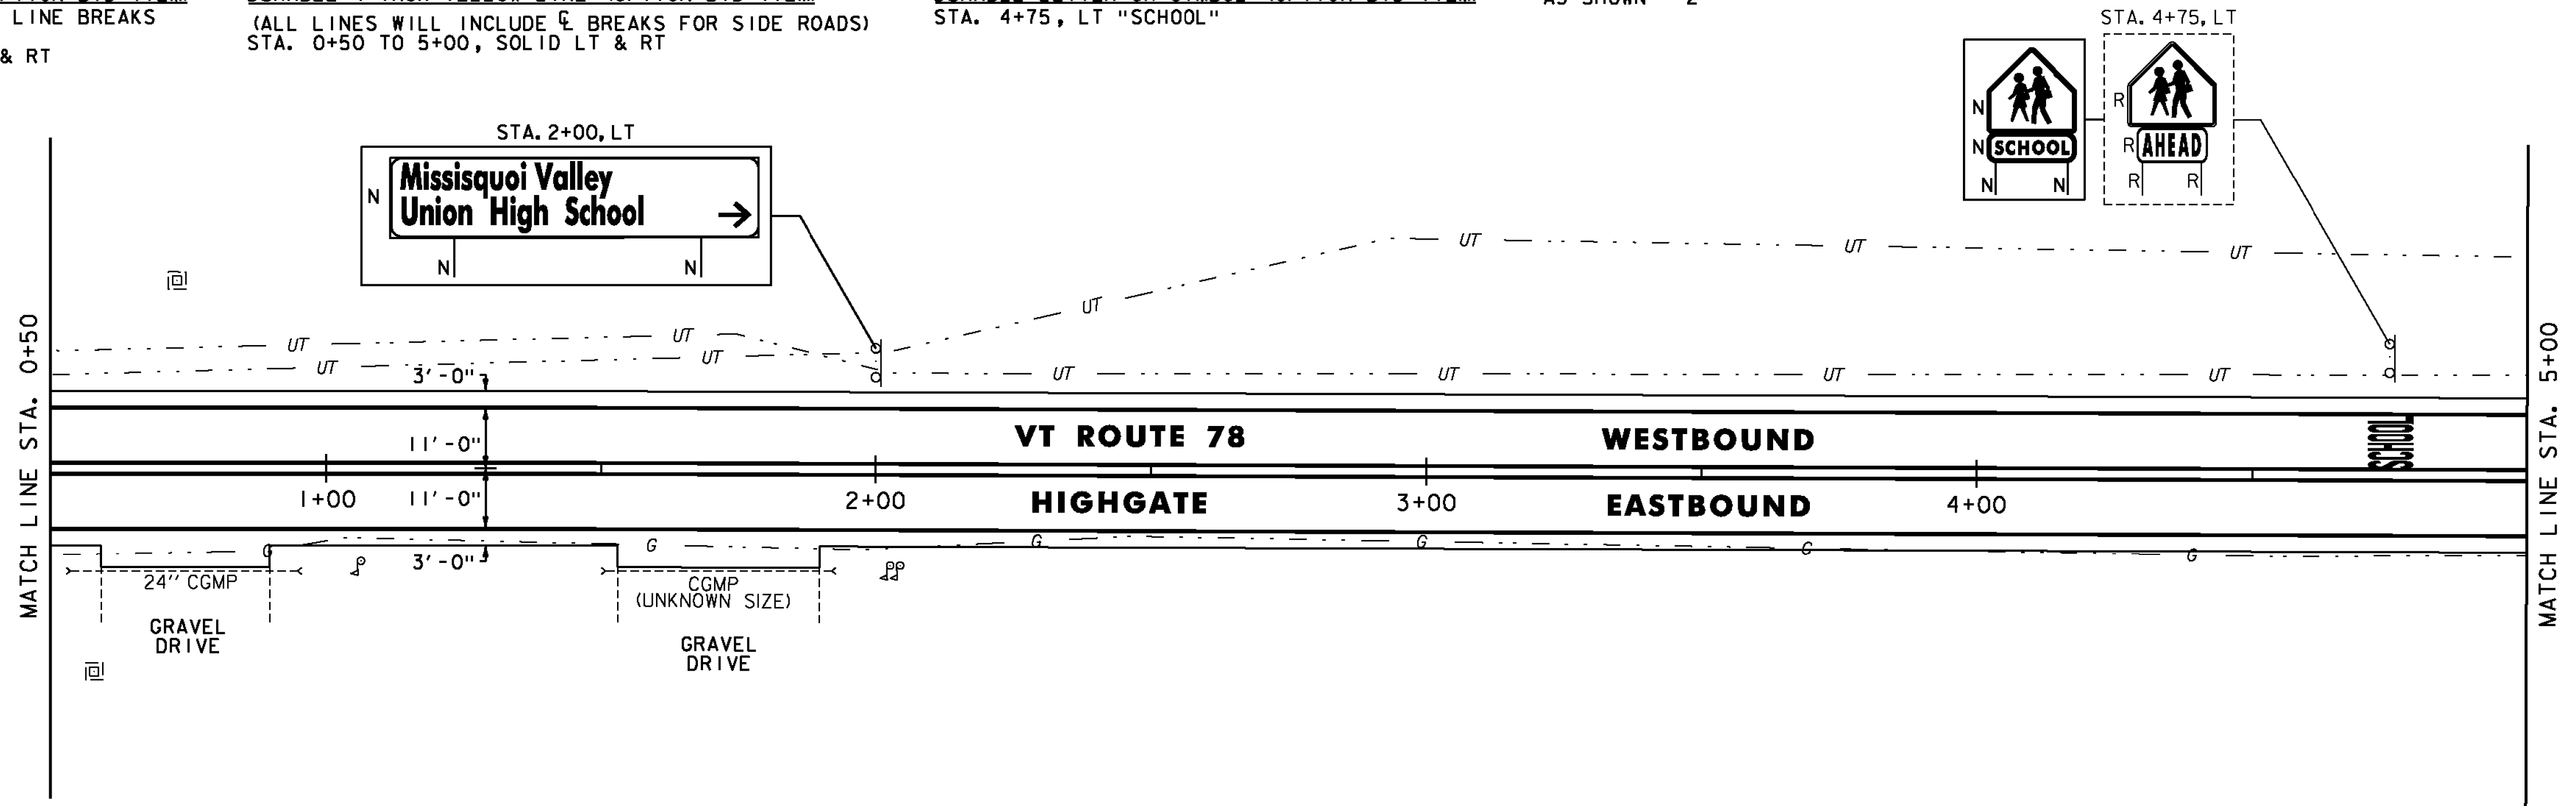

TEMPORARY 4 INCH WHITE LINE, PAINT
 DURABLE 4 INCH WHITE LINE (OPTION BID ITEM)
 (ALL LINES WILL INCLUDE EDGE LINE BREAKS
 AND RADII FOR SIDE ROADS)
 STA. 5+00 TO 10+00, SOLID LT & RT

TEMPORARY 4 INCH YELLOW LINE, PAINT
 DURABLE 4 INCH YELLOW LINE (OPTION BID ITEM)
 (ALL LINES WILL INCLUDE $\frac{1}{2}$ BREAKS FOR SIDE ROADS)
 STA. 5+00 TO 5+28, SOLID LT & RT
 STA. 5+28 TO 6+18, SOLID LT, DASHED RT
 STA. 6+18 TO 10+00, DASHED $\frac{1}{2}$

REMOVING SIGNS
 AS SHOWN - 1

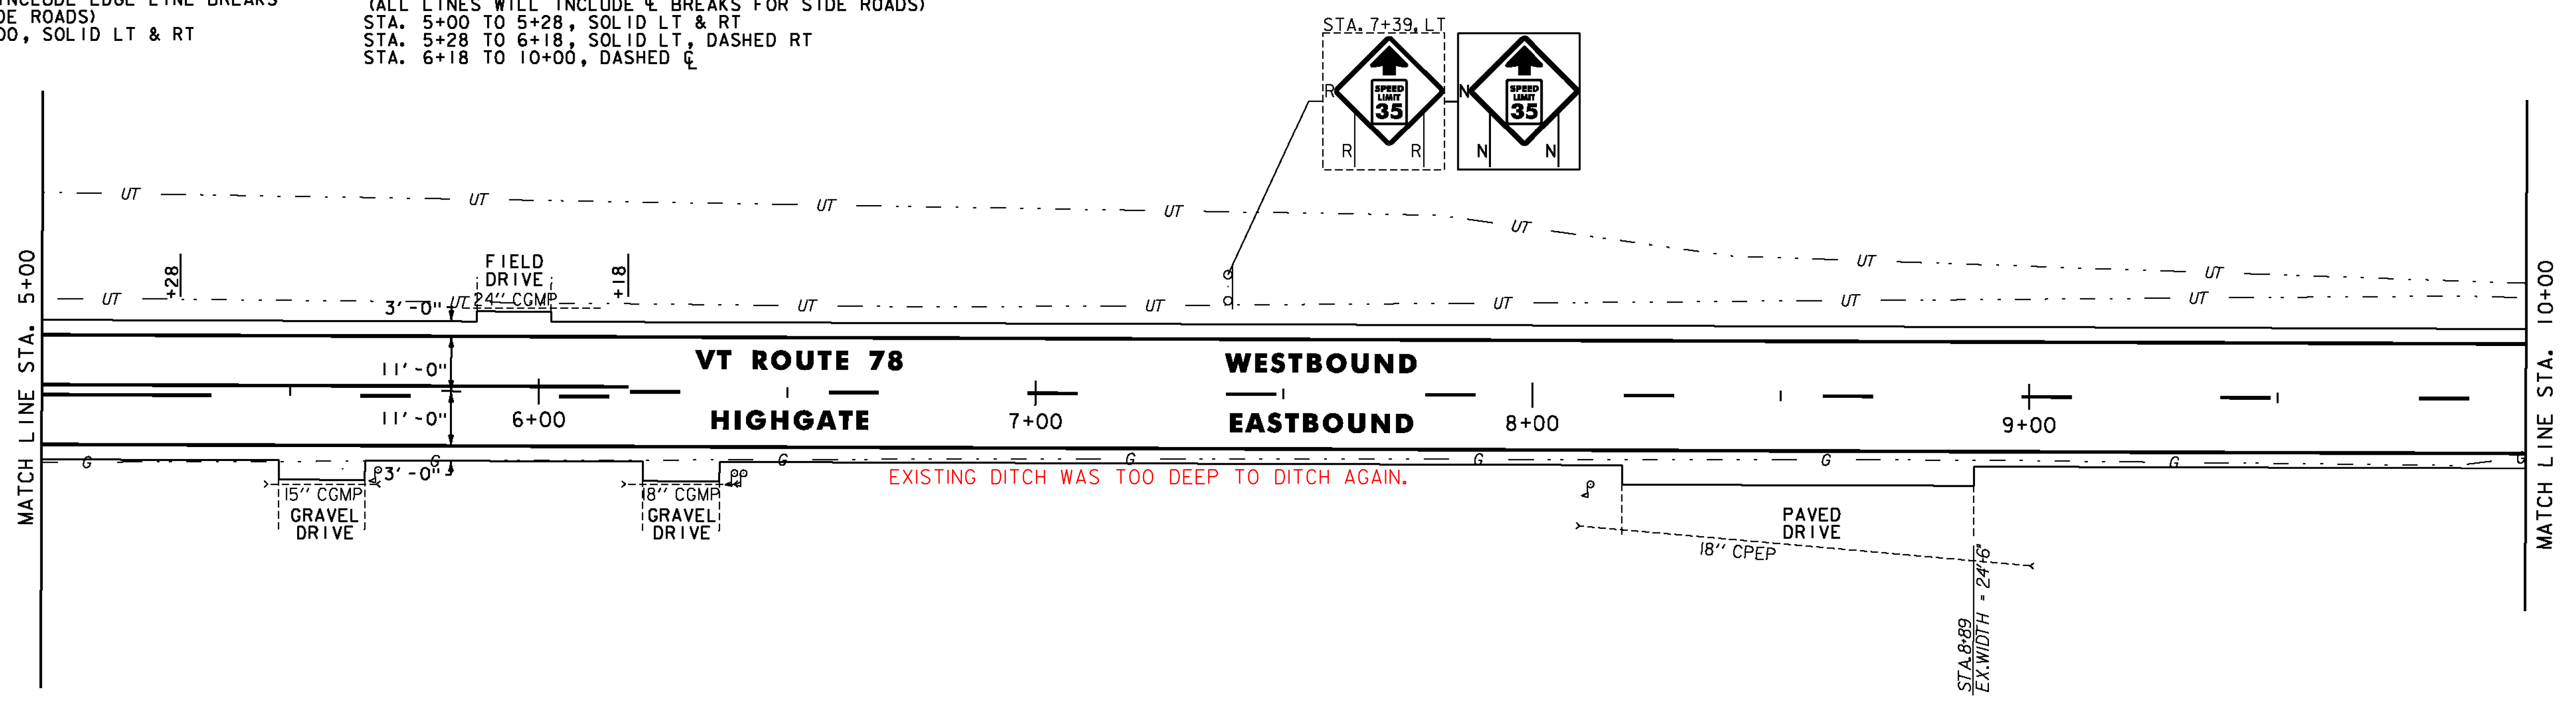

- NOTES:
- FOR LEGENDS, SEE SHEET 19.
 - ALL EXISTING SIGNS NOT SHOWN SHALL BE RETAINED.
 - ALL UTILITY LOCATIONS SHOWN ARE APPROXIMATE AND SHOULD BE VERIFIED PRIOR TO ANY WORK COMMENCING.



NOT TO SCALE

PROJECT LAYOUT SHEET #9

PROJECT NAME: SWANTON-SHELDON	PLOT DATE: 4/24/2014
PROJECT NUMBER: STP 2715(I)	DRAWN BY: G. BARRETT
FILE NAME: p07cl86.dgn	CHECKED BY: M. FOISY
PROJECT LEADER: G. EDWARDS	SHEET 27 OF 121
DESIGNED BY: G. BARRETT	