


**MILLED RUMBLE STRIPS**  
 STA. 100+00 TO 105+00, C  
**STONE FILL, TYPE I**  
 STA. 100+22 TO 100+28, RT ???  
 STA. 103+83 TO 103+89, RT ???

**STEEL BEAM GUARDRAIL, GALVANIZED**  
~~STA. 101+03.5 TO 101+28.5, RT~~  
~~STA. 100+86.5 TO 101+11.5, LT~~  
 STA. 102+71.5 TO 102+96.5, RT  
 STA. 103+96.5 TO 104+21.5, RT  
~~STA. 103+10.5 TO 103+35.5, LT~~  
~~STA. 104+60.5 TO 104+85.5, LT~~  
**W/8 FEET POSTS**  
 STA. 100+00.0 TO 101+03.5, RT 101+28.5  
 STA. 100+00.0 TO 100+86.5, LT 101+11.5  
 STA. 102+96.5 TO 103+96.5, RT  
~~STA. 103+35.5 TO 104+60.5, LT~~  
 STA. 103+10.5 TO 104+85.5, LT

**ANCHOR FOR STEEL BEAM RAIL**  
 STA. 101+28.5, RT  
 STA. 101+11.5, LT  
 STA. 102+71.5, RT  
 STA. 103+10.5, LT  
 STA. 104+21.5, RT  
 STA. 104+85.5, LT  
**REMOVAL AND DISPOSAL OF GUARDRAIL**  
 STA. 100+00 TO 101+28.5, RT  
 STA. 100+00 TO 101+11.5, LT  
 STA. 102+71.5 TO 104+21.5, RT  
 STA. 103+10.5 TO 104+85.5, LT

**TEMPORARY 4 INCH WHITE LINE, PAINT**  
**DURABLE 4 INCH WHITE LINE (OPTION BID ITEM)**  
 (ALL LINES WILL INCLUDE EDGE LINE BREAKS AND RADI FOR SIDE ROADS)  
 STA. 100+00 TO 105+00, SOLID LT & RT  
**TEMPORARY 4 INCH YELLOW LINE, PAINT**  
**DURABLE 4 INCH YELLOW LINE (OPTION BID ITEM)**  
 (ALL LINES WILL INCLUDE C BREAKS FOR SIDE ROADS)  
 STA. 100+00 TO 105+00, SOLID LT & RT

**GEOTEXTILE UNDER STONE FILL**  
 STA. 100+22 TO 100+28, RT  
 STA. 103+83 TO 103+89, RT  
**GRUBBING MATERIAL**  
 STA. 100+22 TO 100+28, RT  
 STA. 103+83 TO 103+89, RT  
**REMOVING SIGNS**  
 AS SHOWN - 1

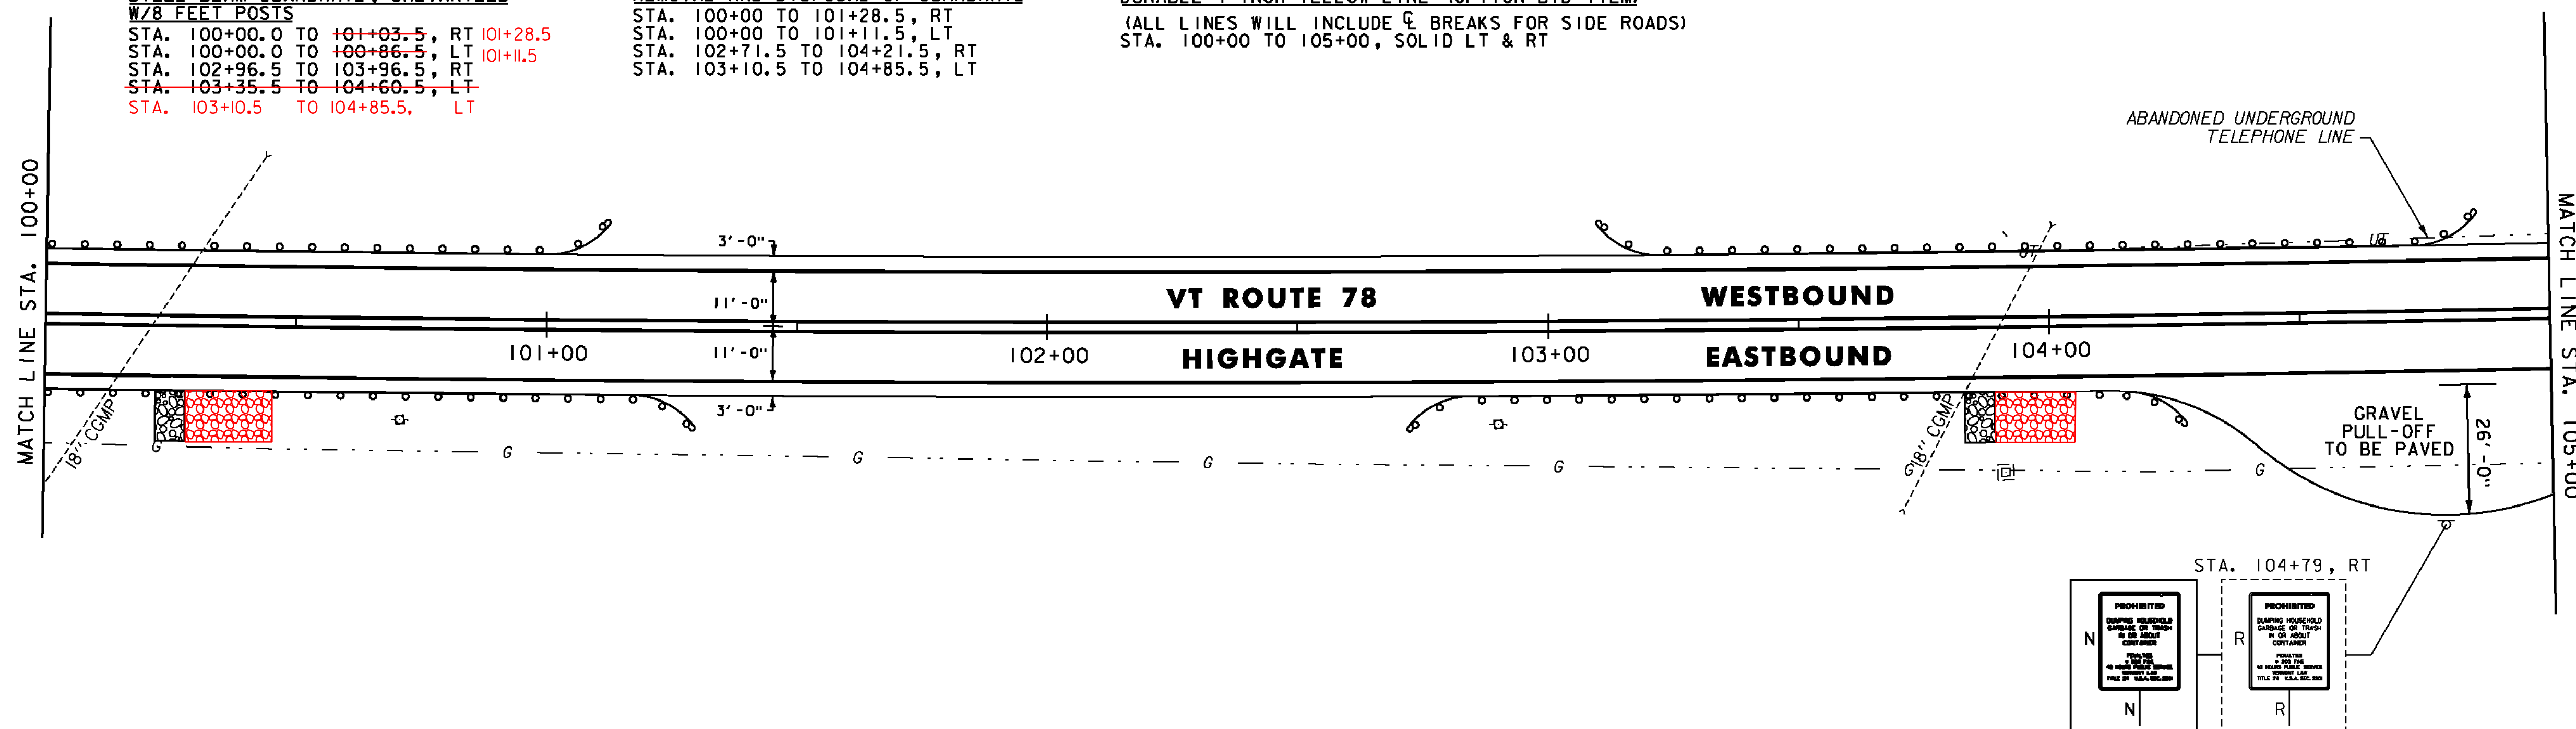

**MILLED RUMBLE STRIPS**  
 STA. 105+00 TO 110+00, C  
**STONE FILL, TYPE I**  
 STA. 106+93 TO 106+99, RT  
 STA. 107+32 TO 107+38, RT  
 STA. 108+60 TO 108+66, LT

**STEEL BEAM GUARDRAIL, GALVANIZED**  
 STA. 105+24.5 TO 105+49.5, RT  
 STA. 105+11.5 TO 105+36.5, LT  
 STA. 106+99.0 TO 107+24.0, LT  
~~STA. 108+52.0 TO 108+77.0, LT~~  
 STA. 109+87.0 TO 110+00.0, RT  
 STA. 105+49.5 TO 105+74.5, RT  
 STA. 107+62.0 TO 108+24.5, RT


**STEEL BEAM GUARDRAIL, GALVANIZED**  
**W/8 FEET POSTS**  
 STA. 105+36.5 TO 106+99.0, LT  
~~STA. 105+49.5 TO 109+87.0, RT~~  
~~STA. 108+77.0 TO 110+00.0, LT~~  
 STA. 105+74.5 TO 107+62.0, RT  
 STA. 108+24.5 TO 109+87.0, RT  
 STA. 108+52.0 TO 112+14.5, LT

**ANCHOR FOR STEEL BEAM RAIL**  
 STA. 105+11.5, LT  
 STA. 105+24.5, RT  
 STA. 107+24.0, LT  
 STA. 108+52.0, LT

**REMOVAL AND DISPOSAL OF GUARDRAIL**  
 STA. 105+11.5 TO 107+24.0, LT  
 STA. 105+49.5 TO 110+00, RT  
 STA. 108+54.5 TO 110+00, LT

**TEMPORARY 4 INCH WHITE LINE, PAINT**  
**DURABLE 4 INCH WHITE LINE (OPTION BID ITEM)**  
 (ALL LINES WILL INCLUDE EDGE LINE BREAKS AND RADI FOR SIDE ROADS)  
 STA. 105+00 TO 110+00, SOLID LT & RT  
**TEMPORARY 4 INCH YELLOW LINE, PAINT**  
**DURABLE 4 INCH YELLOW LINE (OPTION BID ITEM)**  
 (ALL LINES WILL INCLUDE C BREAKS FOR SIDE ROADS)  
 STA. 105+00 TO 110+00, SOLID LT & RT

**GEOTEXTILE UNDER STONE FILL**  
 STA. 106+93 TO 106+99, RT  
 STA. 107+32 TO 107+38, RT  
 STA. 108+60 TO 108+66, LT  
**GRUBBING MATERIAL**  
 STA. 106+93 TO 106+99, RT  
 STA. 107+32 TO 107+38, RT  
 STA. 108+60 TO 108+66, LT  
**REMOVING SIGNS**  
 AS SHOWN - 1

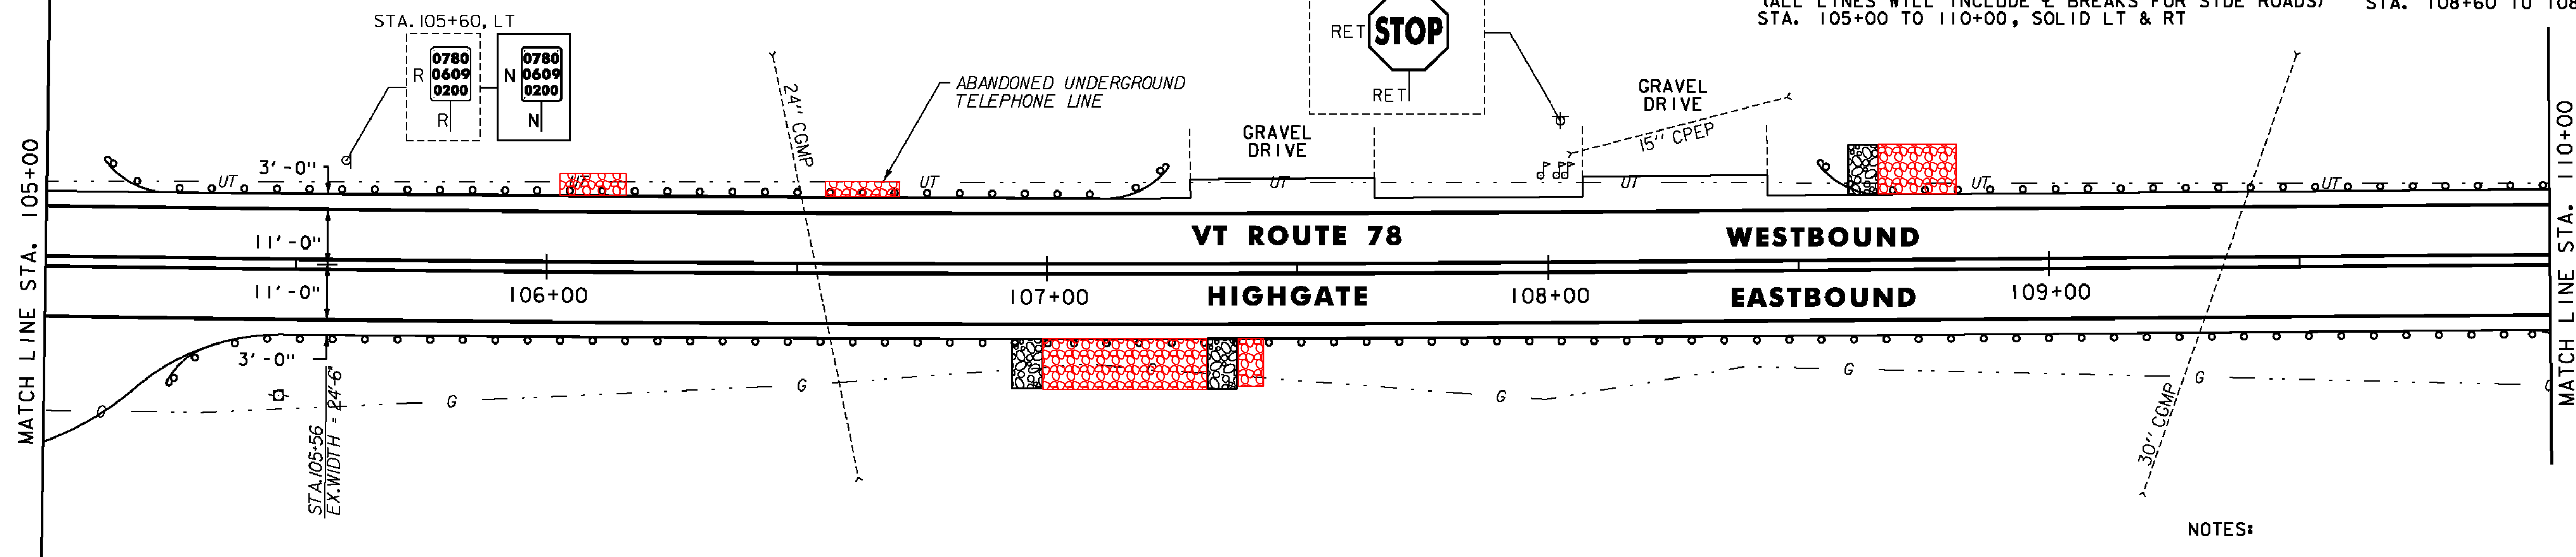

**NOTES:**

1. FOR LEGENDS, SEE SHEET 19.
2. ALL EXISTING SIGNS NOT SHOWN SHALL BE RETAINED.
3. ALL UTILITY LOCATIONS SHOWN ARE APPROXIMATE AND SHOULD BE VERIFIED PRIOR TO ANY WORK COMMENCING.

NOT TO SCALE

**PROJECT LAYOUT SHEET #19**

PROJECT NAME: SWANTON-SHELDON  
 PROJECT NUMBER: STP 2715(I)

FILE NAME: p07cl86.dgn  
 PROJECT LEADER: G. EDWARDS  
 DESIGNED BY: G. BARRETT

PLOT DATE: 4/24/2014  
 DRAWN BY: G. BARRETT  
 CHECKED BY: M. FOISY  
 SHEET 37 OF 121

