

MILLED RUMBLE STRIPS  
STA. 120+00 TO 125+00, C  
123+50

STONE FILL, TYPE J  
STA. 124+37 TO 125+00, RT

STEEL BEAM GUARDRAIL, GALVANIZED  
STA. 120+00.0 TO 121+26.0, LT  
STA. 124+09.0 TO 125+00.0, LT  
STA. 124+24.5 TO 124+49.5, RT  
STA. 123+84.0 TO 124+09.0, LT

STEEL BEAM GUARDRAIL, GALVANIZED  
W/8 FEET POSTS  
STA. 124+49.5 TO 125+00.0, RT  
124+24.5  
STA. 123+84.0 TO 124+09.0, LT  
ANCHOR FOR STEEL BEAM RAIL  
STA. 121+26.0, LT  
STA. 124+09.0, LT  
STA. 124+24.5, RT  
STA. 123+84.0, LT

REMOVAL AND DISPOSAL OF GUARDRAIL  
STA. 120+00 TO 121+26, LT  
STA. 124+09 TO 125+00, LT  
STA. 124+24.5 TO 125+00, RT

TEMPORARY 4 INCH WHITE LINE, PAINT  
DURABLE 4 INCH WHITE LINE (OPTION BID ITEM)  
(ALL LINES WILL INCLUDE EDGE LINE BREAKS  
AND RADII FOR SIDE ROADS)  
STA. 120+00 TO 125+00, SOLID LT & RT  
STA. 124+24, SOLID LT (EDGELINES, CARTER HILL ROAD, TH-1)

TEMPORARY 4 INCH YELLOW LINE, PAINT  
DURABLE 4 INCH YELLOW LINE (OPTION BID ITEM)  
(ALL LINES WILL INCLUDE C BREAKS FOR SIDE ROADS)  
STA. 120+00 TO 125+00, SOLID LT & RT  
STA. 124+24, DOUBLE SOLID LT (CARTER HILL ROAD, TH-1)


TEMPORARY 24 INCH STOP BAR, PAINT  
DURABLE 24 INCH STOP BAR (OPTION BID ITEM)  
STA. 124+24, LT (CARTER HILL ROAD, TH-1)

TEMPORARY LETTER OR SYMBOL, PAINT  
DURABLE LETTER OR SYMBOL (OPTION BID ITEM)  
STA. 124+24, LT "STOP" (CARTER HILL ROAD, TH-1)

GEOTEXTILE UNDER STONE FILL  
STA. 124+37 TO 125+00, RT

GRUBBING MATERIAL  
STA. 124+37 TO 125+00, RT

REMOVING SIGNS  
AS SHOWN - 8

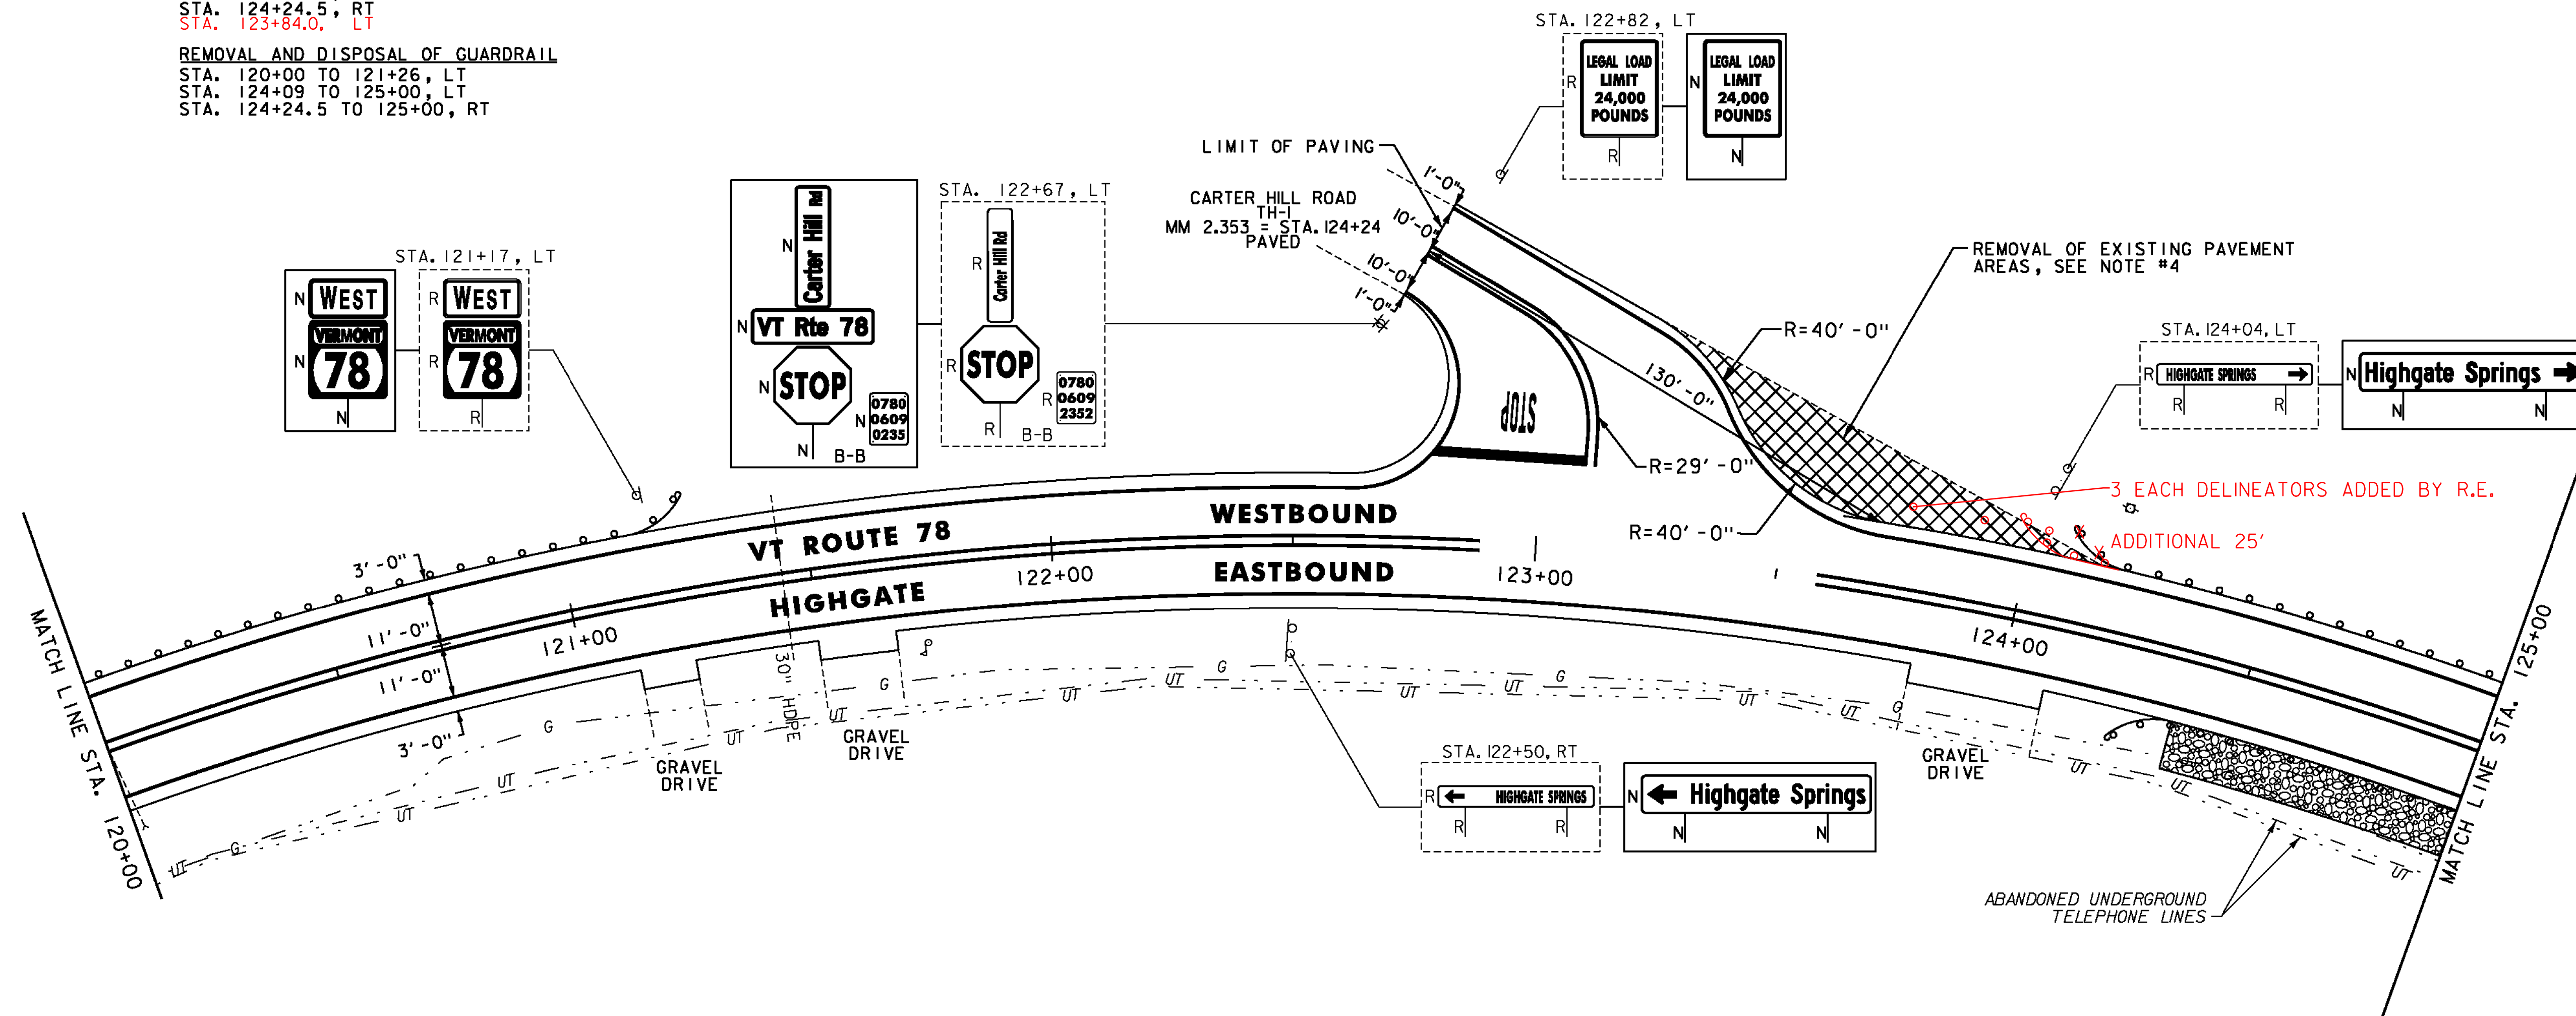

NOTES:

1. FOR LEGENDS, SEE SHEET 19.
2. ALL EXISTING SIGNS NOT SHOWN SHALL BE RETAINED.
3. ALL UTILITY LOCATIONS SHOWN ARE APPROXIMATE AND SHOULD BE VERIFIED PRIOR TO ANY WORK COMMENCING.
4. REMOVE 4 INCHES OF EXISTING PAVEMENT AS SHOWN. PAYMENT TO BE MADE UNDER ITEM 203.15 - COMMON EXCAVATION. IF LESS THAN 4 INCHES OF PAVEMENT IS ENCOUNTERED, REMOVAL OF SUBBASE SHALL BE PAID UNDER ITEM 203.15 - COMMON EXCAVATION. REPLACE WITH 4 INCHES OF ITEM 651.35 - TOPSOIL, 651.15 - SEED, 651.18 - FERTILIZER, 651.20 - AGRICULTURAL LIMESTONE AND 653.20 - TEMPORARY EROSION MATTING. ESTIMATED QUANTITIES OF THE INDICATED ITEMS HAVE BEEN INCLUDED FOR USE AS DIRECTED BY THE ENGINEER.

NOT TO SCALE

PROJECT LAYOUT SHEET #21

PROJECT NAME: SWANTON-SHELDON  
PROJECT NUMBER: STP 2715(I)

FILE NAME: p07cl86.dgn  
PROJECT LEADER: G. EDWARDS  
DESIGNED BY: G. BARRETT

PLOT DATE: 4/24/2014  
DRAWN BY: G. BARRETT  
CHECKED BY: M. FOISY  
SHEET 39 OF 121

