

STONE FILL, TYPE I
STA. 151+42 TO 151+52, RT

TEMPORARY 4 INCH WHITE LINE, PAINT
DURABLE 4 INCH WHITE LINE (OPTION BID ITEM)
(ALL LINES WILL INCLUDE EDGE LINE BREAKS
AND RADII FOR SIDE ROADS)
STA. 150+00 TO 155+00, SOLID LT & RT
STA. 152+03, SOLID RT (EDGELINES, VT ROUTE 207, HIGHGATE ROAD)

TEMPORARY 4 INCH YELLOW LINE, PAINT
DURABLE 4 INCH YELLOW LINE (OPTION BID ITEM)
(ALL LINES WILL INCLUDE E BREAKS FOR SIDE ROADS)
STA. 150+00 TO 155+00, SOLID LT & RT
STA. 152+03, DOUBLE SOLID RT (VT ROUTE 207, HIGHGATE ROAD)

TEMPORARY 8 INCH WHITE LINE, PAINT
DURABLE 8 INCH WHITE LINE (OPTION BID ITEM)
STA. 154+20 TO 154+32, LT (HYDRANT)
SEE DETAIL ON SHEET 16



TEMPORARY 24 INCH STOP BAR, PAINT
DURABLE 24 INCH STOP BAR (OPTION BID ITEM)
STA. 152+03, RT (VT ROUTE 207, HIGHGATE ROAD)

TEMPORARY LETTER OR SYMBOL, PAINT
DURABLE LETTER OR SYMBOL (OPTION BID ITEM)
STA. 152+03, RT "STOP" (VT ROUTE 207, HIGHGATE ROAD)

GEOTEXTILE UNDER STONE FILL
STA. 151+42 TO 151+52, RT

REMOVING SIGNS
AS SHOWN - 22

GRUBBING MATERIAL
STA. 151+42 TO 151+52, RT

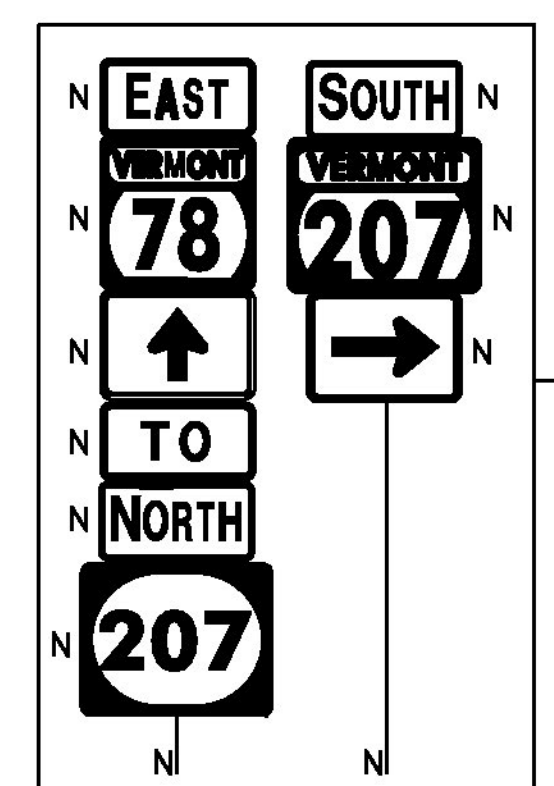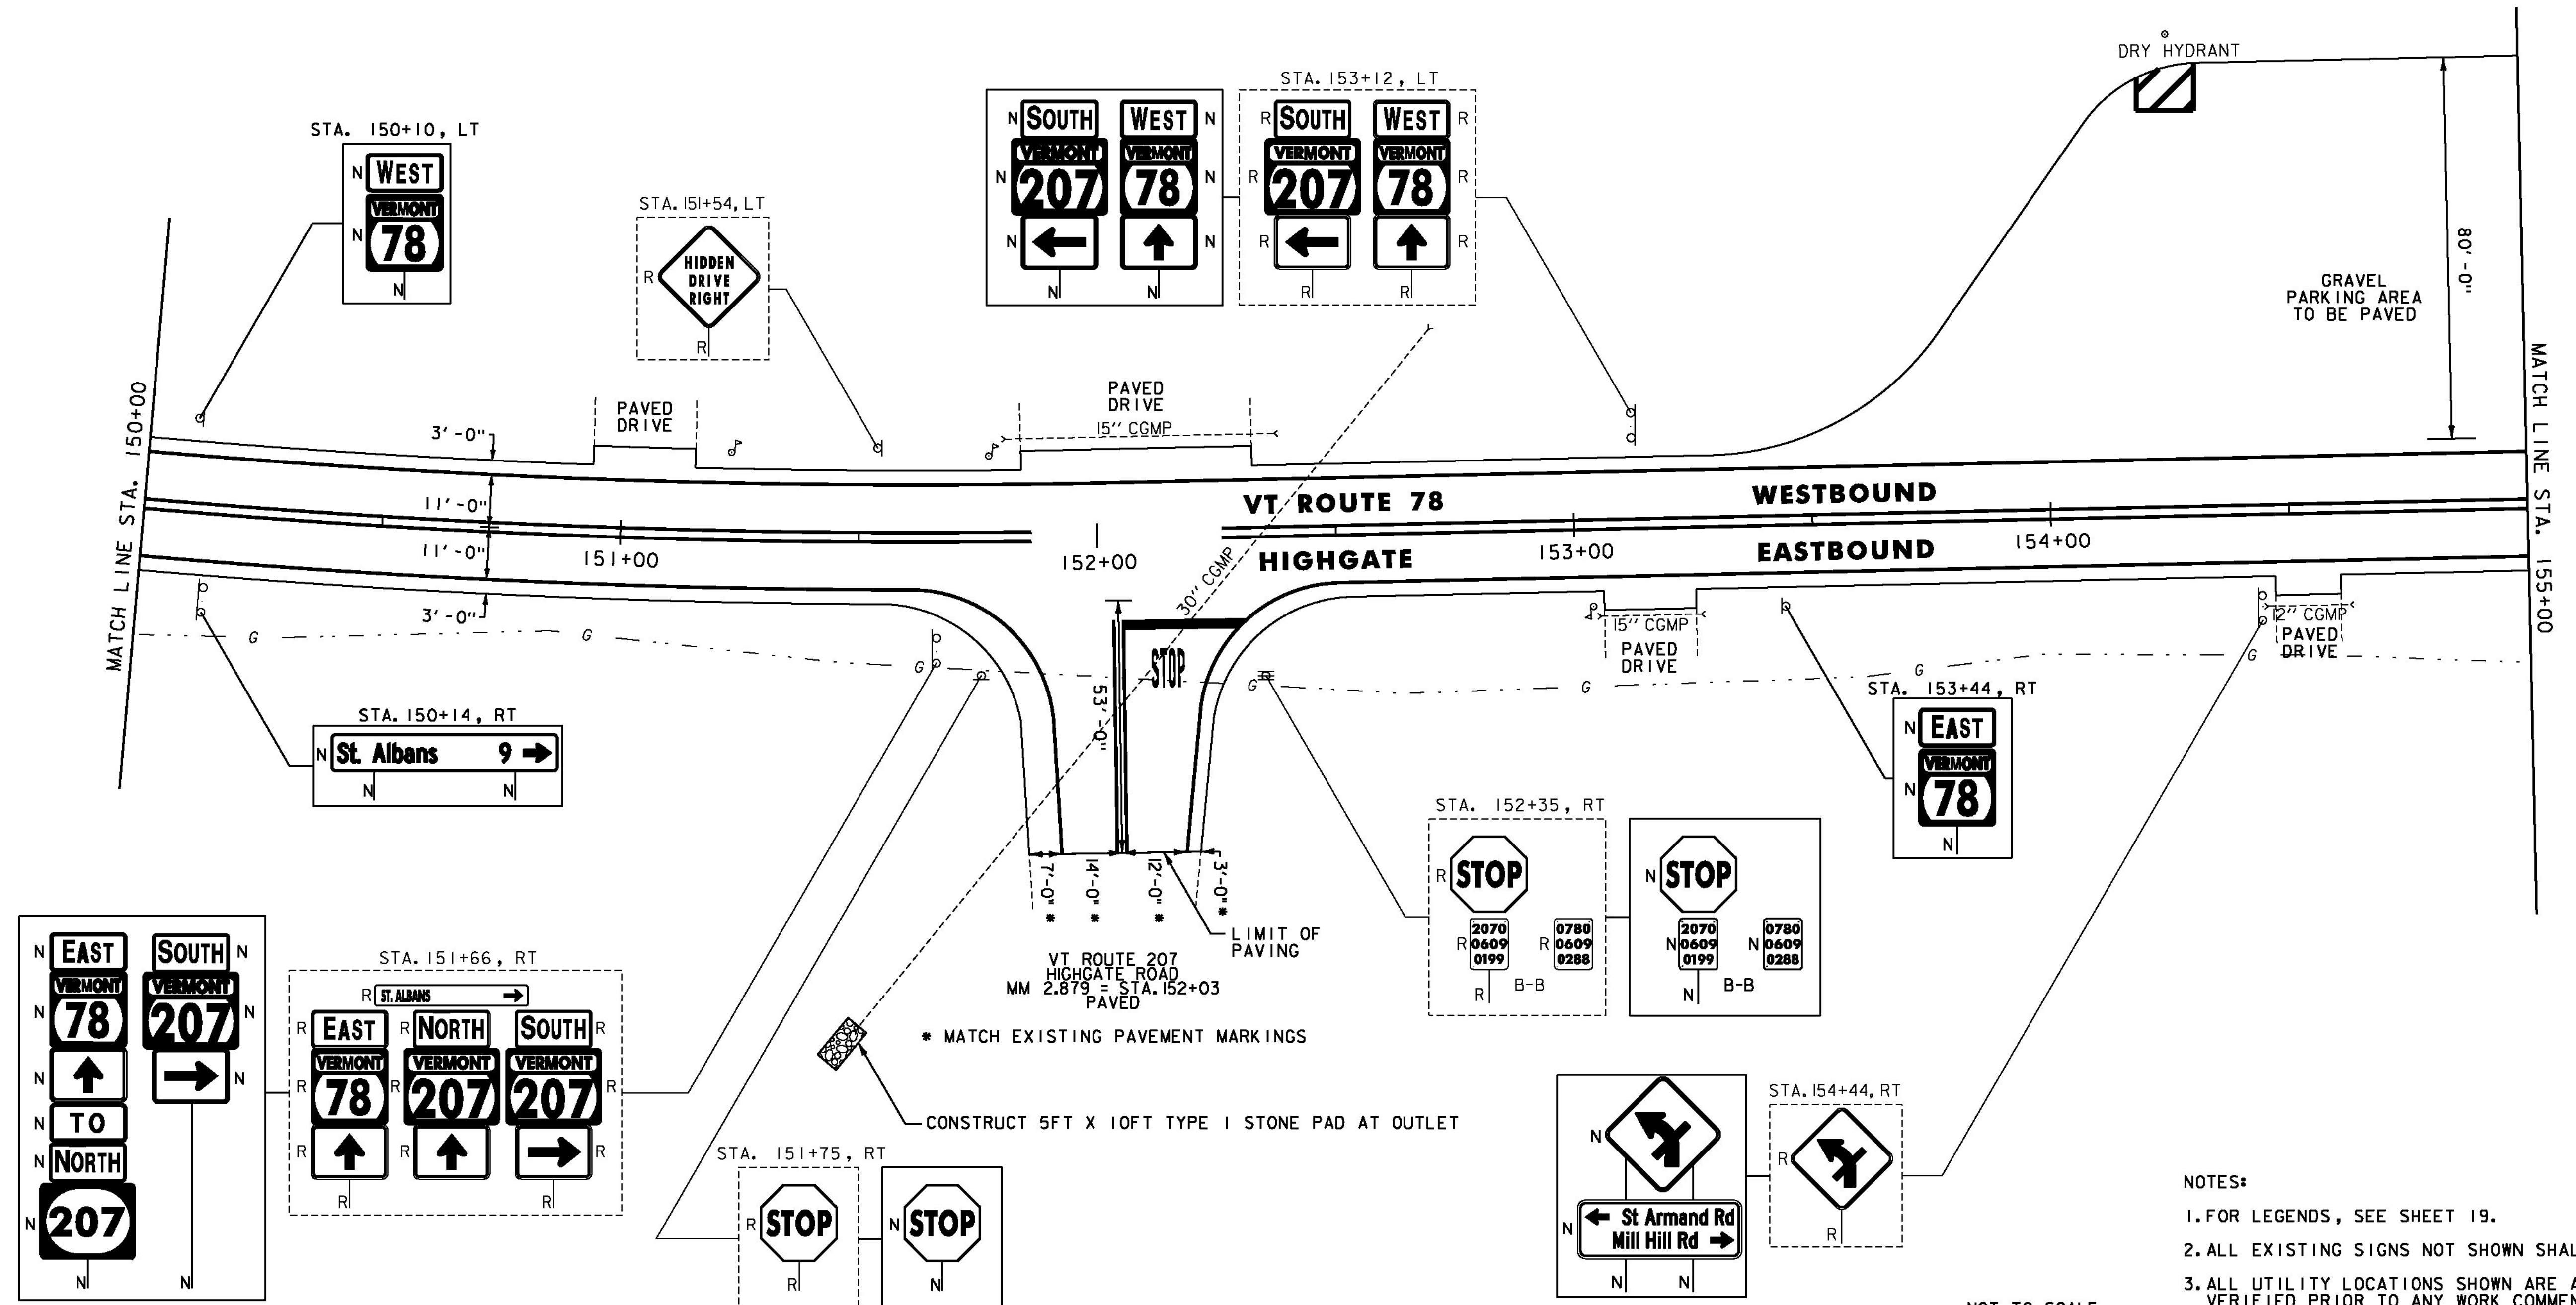

- NOTES:
1. FOR LEGENDS, SEE SHEET 19.
 2. ALL EXISTING SIGNS NOT SHOWN SHALL BE RETAINED.
 3. ALL UTILITY LOCATIONS SHOWN ARE APPROXIMATE AND SHOULD BE VERIFIED PRIOR TO ANY WORK COMMENCING.

NOT TO SCALE



PROJECT LAYOUT SHEET #25	PROJECT NAME: SWANTON-SHELDON	PLOT DATE: 4/24/2014
	PROJECT NUMBER: STP 2715(I)	DRAWN BY: G. BARRETT
	FILE NAME: p07cl86.dgn	CHECKED BY: M. FOISY
	DESIGNED BY: G. BARRETT	SHEET 43 OF 121