


MILLED RUMBLE STRIPS
~~STA. 200+00 TO 205+00, C~~

TEMPORARY 4 INCH WHITE LINE, PAINT
 DURABLE 4 INCH WHITE LINE (OPTION BID ITEM)
 (ALL LINES WILL INCLUDE EDGE LINE BREAKS
 AND RADI1 FOR SIDE ROADS)
 STA. 200+00 TO 205+00, SOLID LT & RT

TEMPORARY 4 INCH YELLOW LINE, PAINT
 DURABLE 4 INCH YELLOW LINE (OPTION BID ITEM)
 (ALL LINES WILL INCLUDE C BREAKS FOR SIDE ROADS)
 STA. 200+00 TO 205+00, SOLID LT & RT


REMOVING SIGNS
 AS SHOWN - 1

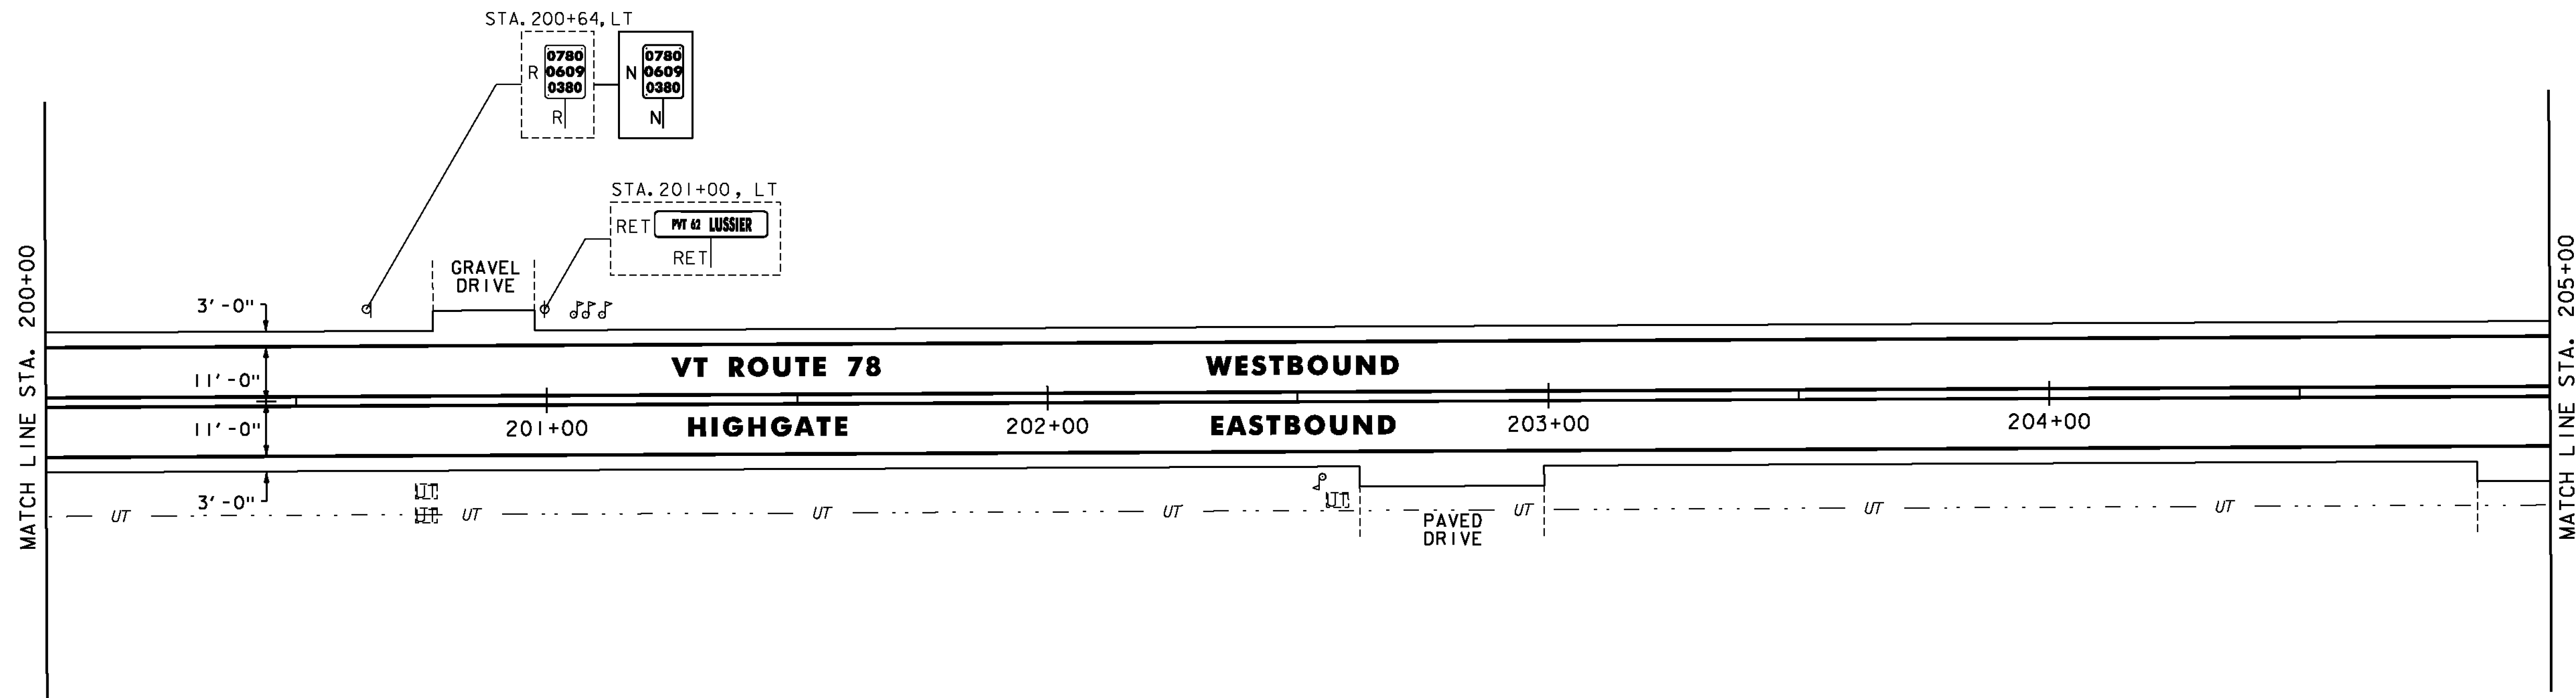

MILLED RUMBLE STRIPS
~~STA. 205+00 TO 210+00, C~~

TEMPORARY 4 INCH WHITE LINE, PAINT
 DURABLE 4 INCH WHITE LINE (OPTION BID ITEM)
 (ALL LINES WILL INCLUDE EDGE LINE BREAKS
 AND RADI1 FOR SIDE ROADS)
 STA. 205+00 TO 210+00, SOLID LT & RT

TEMPORARY 4 INCH YELLOW LINE, PAINT
 DURABLE 4 INCH YELLOW LINE (OPTION BID ITEM)
 (ALL LINES WILL INCLUDE C BREAKS FOR SIDE ROADS)
 STA. 205+00 TO 210+00, SOLID LT & RT

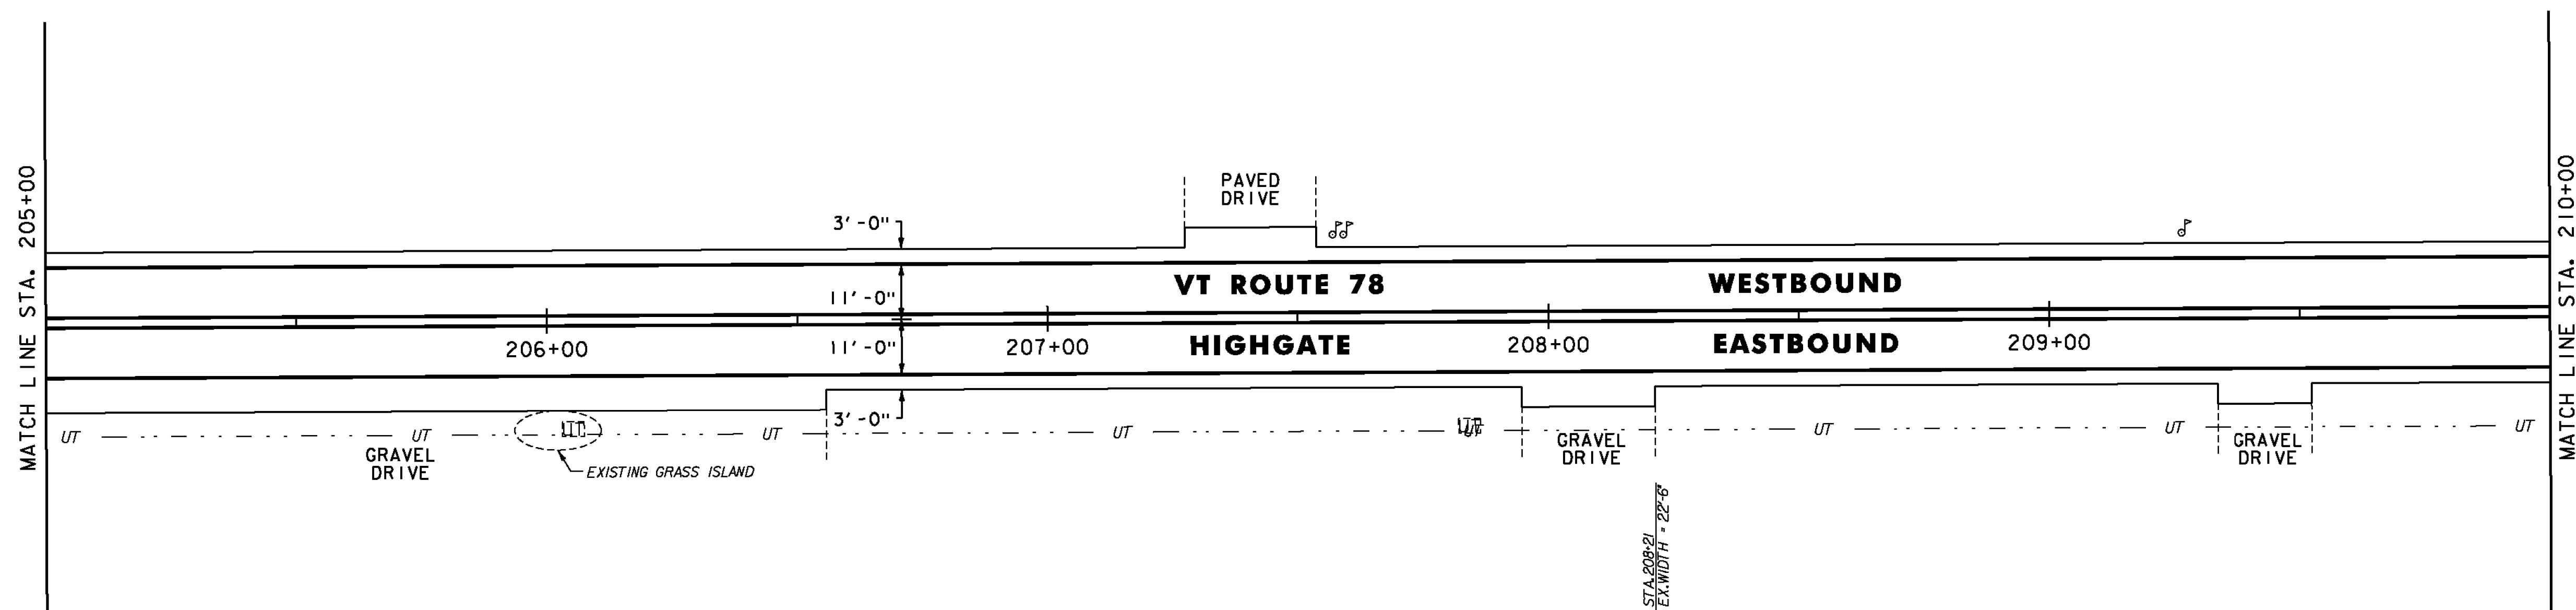

NOTES:

1. FOR LEGENDS, SEE SHEET 19.
2. ALL EXISTING SIGNS NOT SHOWN SHALL BE RETAINED.

NOT TO SCALE

**PROJECT
 LAYOUT
 SHEET #32**

PROJECT NAME: SWANTON-SHELDON
 PROJECT NUMBER: STP 2715(I)

FILE NAME: p07cl86.dgn
 PROJECT LEADER: G. EDWARDS
 DESIGNED BY: G. BARRETT

PLOT DATE: 4/24/2014
 DRAWN BY: G. BARRETT
 CHECKED BY: M. FOISY
 SHEET 50 OF 121

