


MILLED RUMBLE STRIPS
~~STA. 210+00 TO 215+00, C~~

TEMPORARY 4 INCH WHITE LINE, PAINT
 DURABLE 4 INCH WHITE LINE (OPTION BID ITEM)
 (ALL LINES WILL INCLUDE EDGE LINE BREAKS
 AND RADII FOR SIDE ROADS)
 STA. 210+00 TO 215+00, SOLID LT & RT

TEMPORARY 4 INCH YELLOW LINE, PAINT
 DURABLE 4 INCH YELLOW LINE (OPTION BID ITEM)
 (ALL LINES WILL INCLUDE C BREAKS FOR SIDE ROADS)
 STA. 210+00 TO 215+00, SOLID LT & RT

REMOVING SIGNS
 AS SHOWN - 1

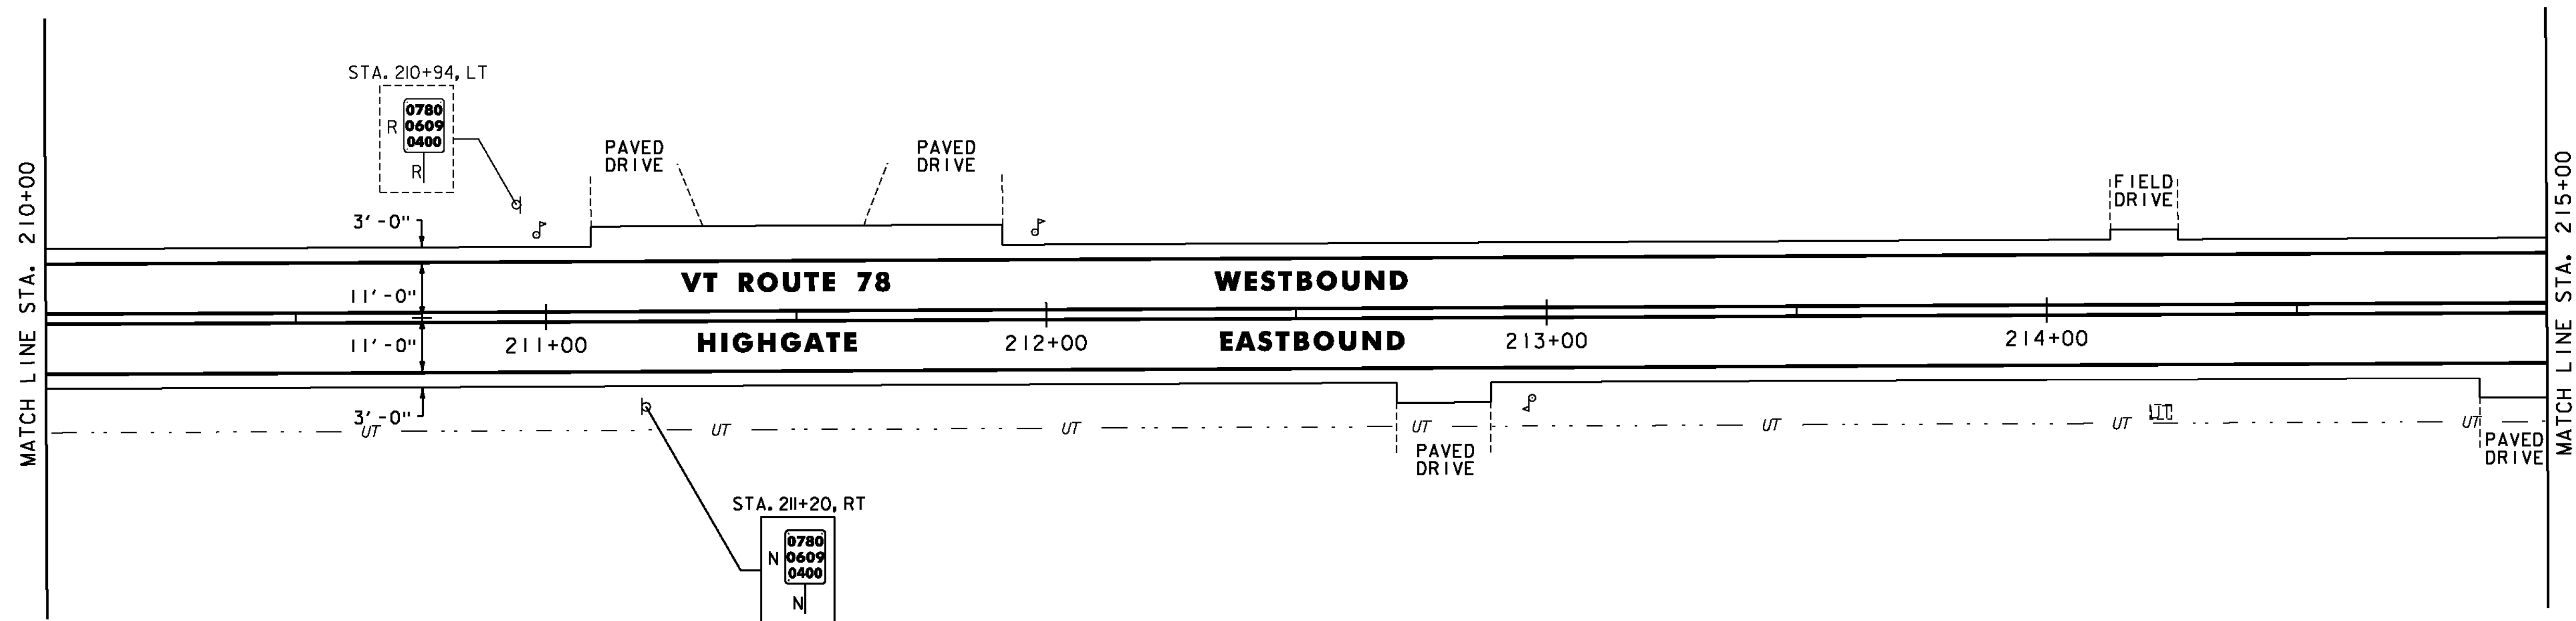


MILLED RUMBLE STRIPS
~~STA. 215+00 TO 220+00, C~~

STEEL BEAM GUARDRAIL, GALVANIZED
~~STA. 216+90.0 TO 218+15.0, RT~~
~~STA. 217+00.0 TO 218+50.0, LT~~
 STEEL BEAM GUARDRAIL, GALVANIZED
 W/ 8 FEET POSTS
 STA. 216+90.0 TO 218+02.5, RT

ANCHOR FOR STEEL BEAM RAIL
 STA. 216+90.0, RT
 STA. 217+00.0, LT
 STA. 218+15.0, RT 218+02.5
 STA. 218+50.0, LT

TEMPORARY 4 INCH WHITE LINE, PAINT
 DURABLE 4 INCH WHITE LINE (OPTION BID ITEM)
 (ALL LINES WILL INCLUDE EDGE LINE BREAKS
 AND RADII FOR SIDE ROADS)
 STA. 215+00 TO 220+00, SOLID LT & RT

TEMPORARY 4 INCH YELLOW LINE, PAINT
 DURABLE 4 INCH YELLOW LINE (OPTION BID ITEM)
 (ALL LINES WILL INCLUDE C BREAKS FOR SIDE ROADS)
 STA. 215+00 TO 220+00, SOLID LT & RT

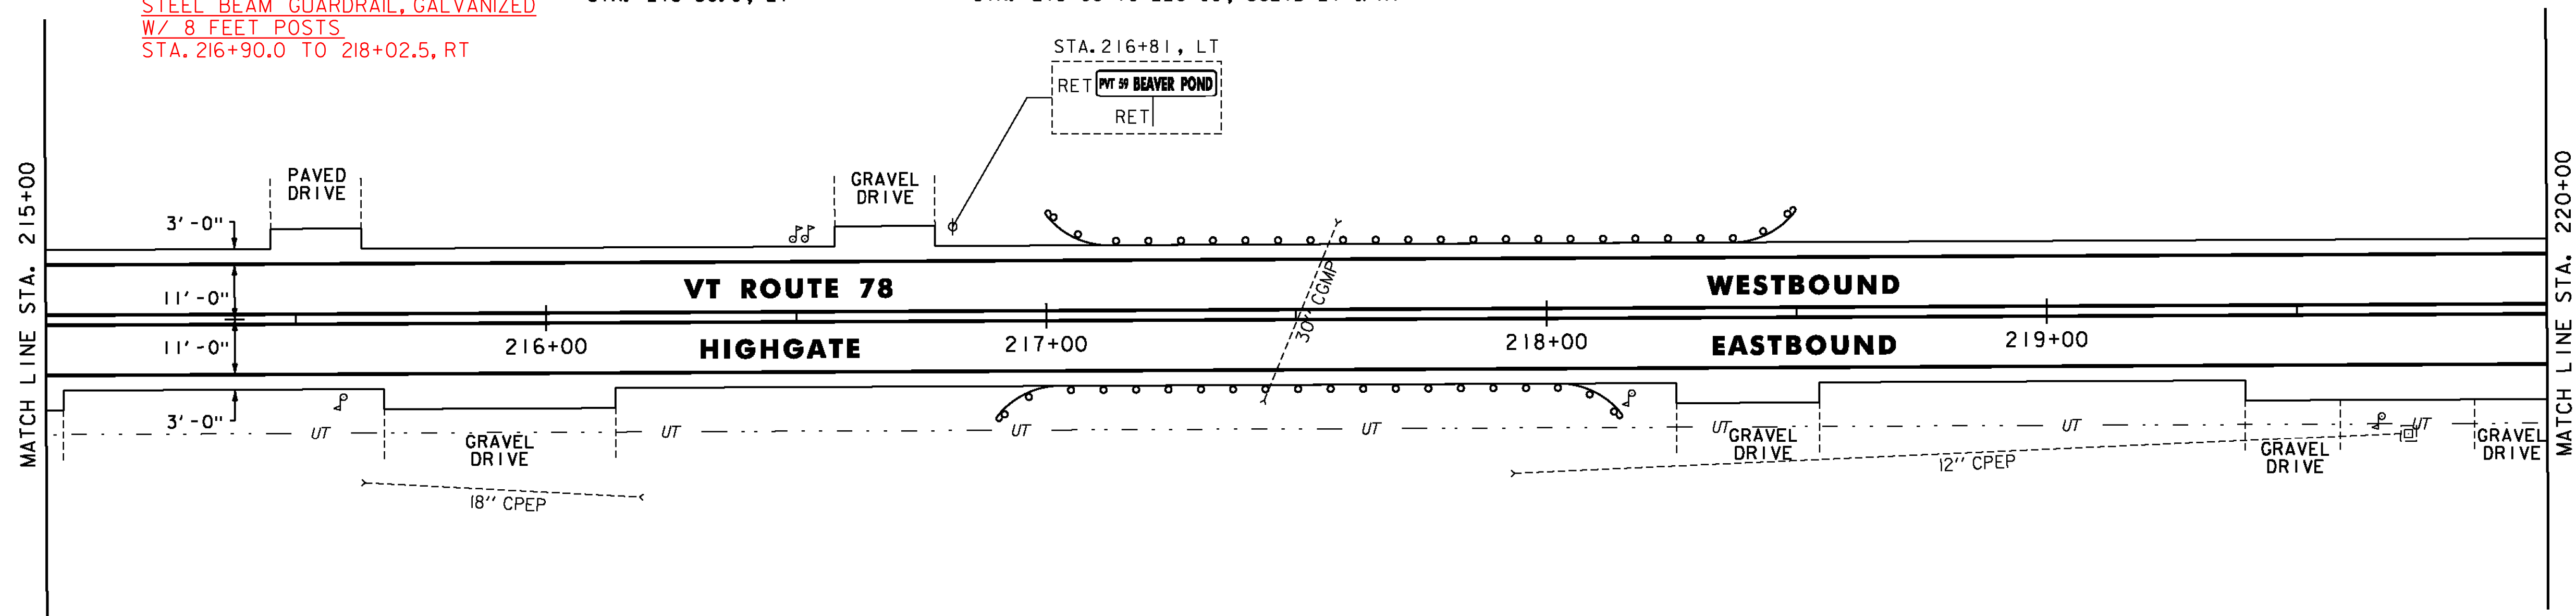

NOTES:

1. FOR LEGENDS, SEE SHEET 19.
2. ALL EXISTING SIGNS NOT SHOWN SHALL BE RETAINED.

NOT TO SCALE

PROJECT LAYOUT SHEET #33



PROJECT NAME: SWANTON-SHELDON
 PROJECT NUMBER: STP 2715(I)

FILE NAME: p07cl86.dgn
 PROJECT LEADER: G. EDWARDS
 DESIGNED BY: G. BARRETT

PLOT DATE: 4/24/2014
 DRAWN BY: G. BARRETT
 CHECKED BY: M. FOISY
 SHEET 51 OF 121