

MILLED RUMBLE STRIPS
STA. 240+00 TO 245+00, C

STEEL BEAM GUARDRAIL, GALVANIZED
STA. 242+25.0 TO 242+50.0, RT
STA. 242+31.0 TO 245+00.0, LT
STA. 244+00.0 TO 244+25.0, RT

STEEL BEAM GUARDRAIL, GALVANIZED
W/8 FEET POSTS
STA. 242+50.0 TO 244+00.0, RT


ANCHOR FOR STEEL BEAM RAIL
STA. 242+25.0, RT
STA. 242+31.0, LT
STA. 244+25.0, RT

REMOVAL AND DISPOSAL OF GUARDRAIL
STA. 242+25 TO 244+25, RT
STA. 242+31 TO 245+00, LT

TEMPORARY 4 INCH WHITE LINE, PAINT
DURABLE 4 INCH WHITE LINE (OPTION BID ITEM)
(ALL LINES WILL INCLUDE EDGE LINE BREAKS
AND RADII FOR SIDE ROADS)
STA. 240+00 TO 245+00, SOLID LT & RT

TEMPORARY 4 INCH YELLOW LINE, PAINT
DURABLE 4 INCH YELLOW LINE (OPTION BID ITEM)
(ALL LINES WILL INCLUDE C BREAKS FOR SIDE ROADS)
STA. 240+00 TO 245+00, SOLID LT & RT

REMOVING SIGNS
AS SHOWN - 4

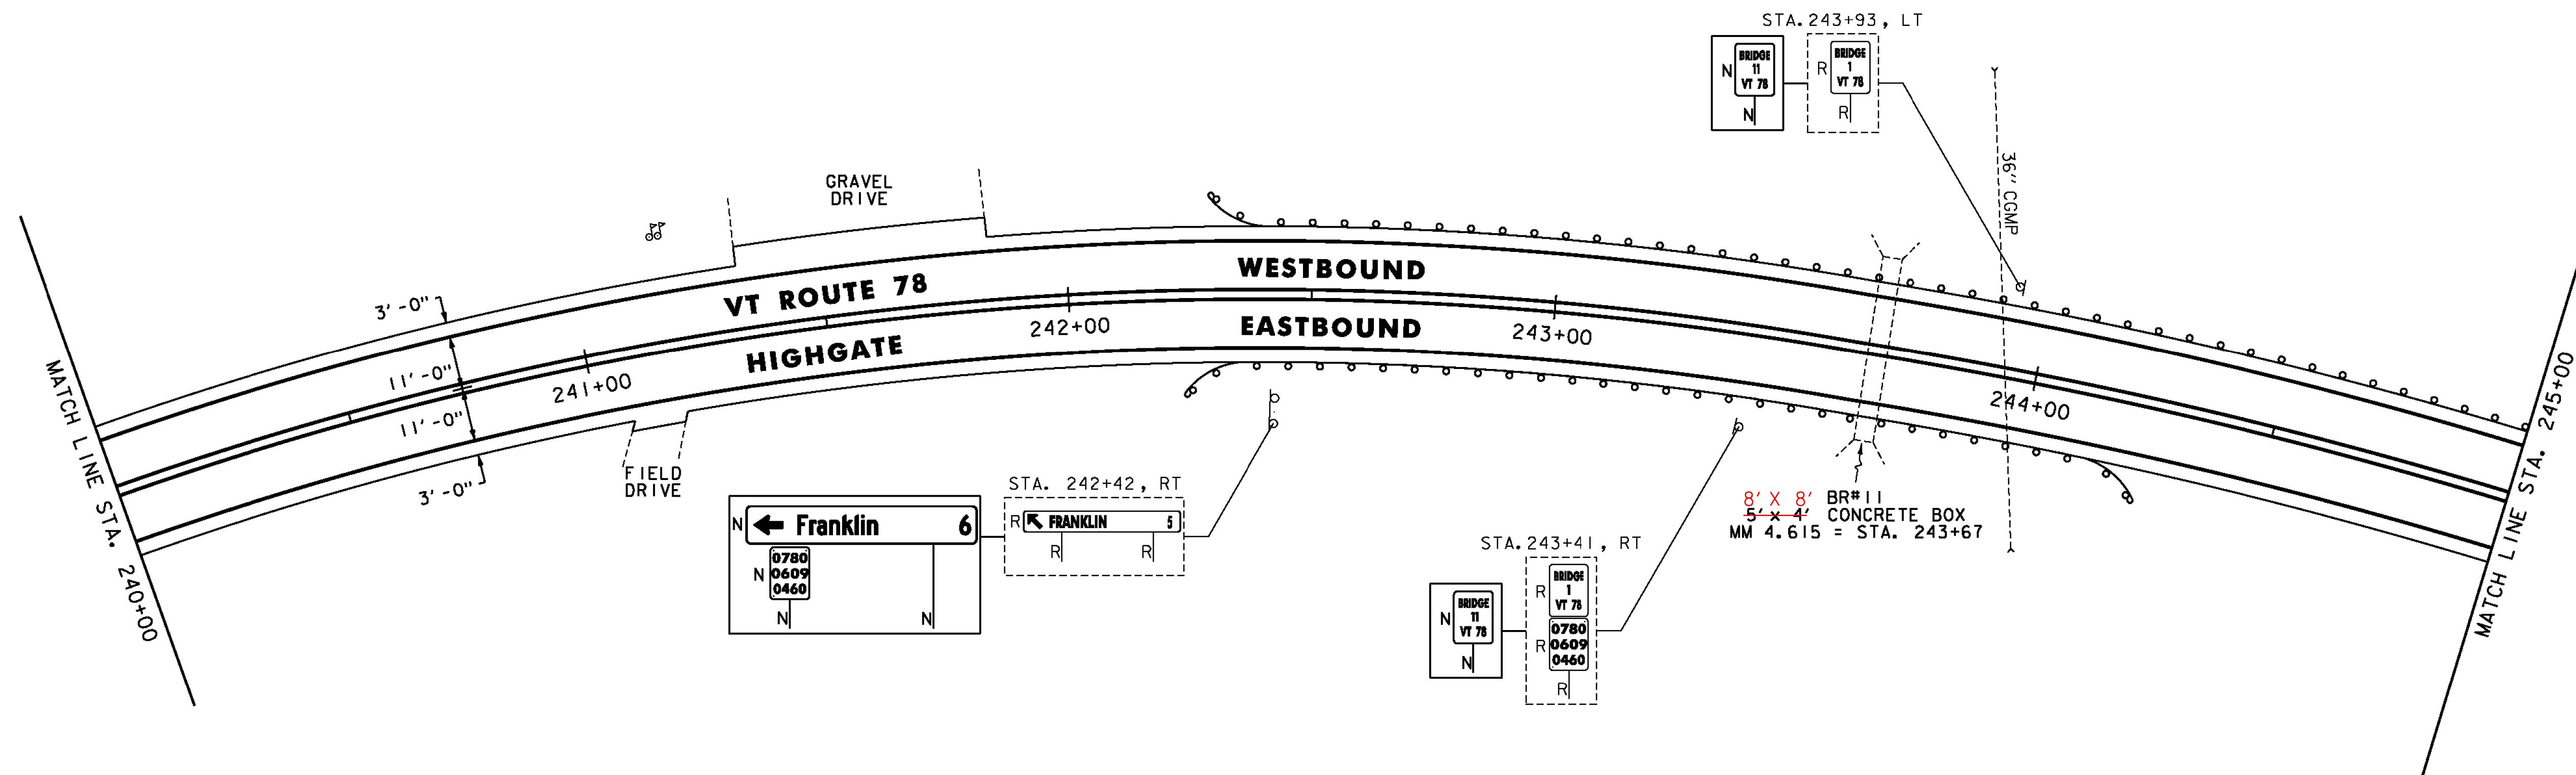

NOTES:

- FOR LEGENDS, SEE SHEET 19.
- ALL EXISTING SIGNS NOT SHOWN SHALL BE RETAINED.

NOT TO SCALE

PROJECT LAYOUT SHEET #36



PROJECT NAME: SWANTON-SHELDON
PROJECT NUMBER: STP 2715(I)

FILE NAME: p07cl86.dgn
PROJECT LEADER: G. EDWARDS
DESIGNED BY: G. BARRETT

PLOT DATE: 4/24/2014
DRAWN BY: G. BARRETT
CHECKED BY: M. FOISY
SHEET 54 OF 121