


MILLED RUMBLE STRIPS
 STA. 289+50 TO 295+00, C
 292+04

TEMPORARY 4 INCH WHITE LINE, PAINT
 DURABLE 4 INCH WHITE LINE (OPTION BID ITEM)
 (ALL LINES WILL INCLUDE EDGE LINE BREAKS
 AND RADII FOR SIDE ROADS)
 STA. 289+50 TO 295+00, SOLID LT & RT

TEMPORARY 4 INCH YELLOW LINE, PAINT
 DURABLE 4 INCH YELLOW LINE (OPTION BID ITEM)
 (ALL LINES WILL INCLUDE C BREAKS FOR SIDE ROADS)
 STA. 289+50 TO 295+00, SOLID LT & RT

REMOVING SIGNS
 AS SHOWN - 3

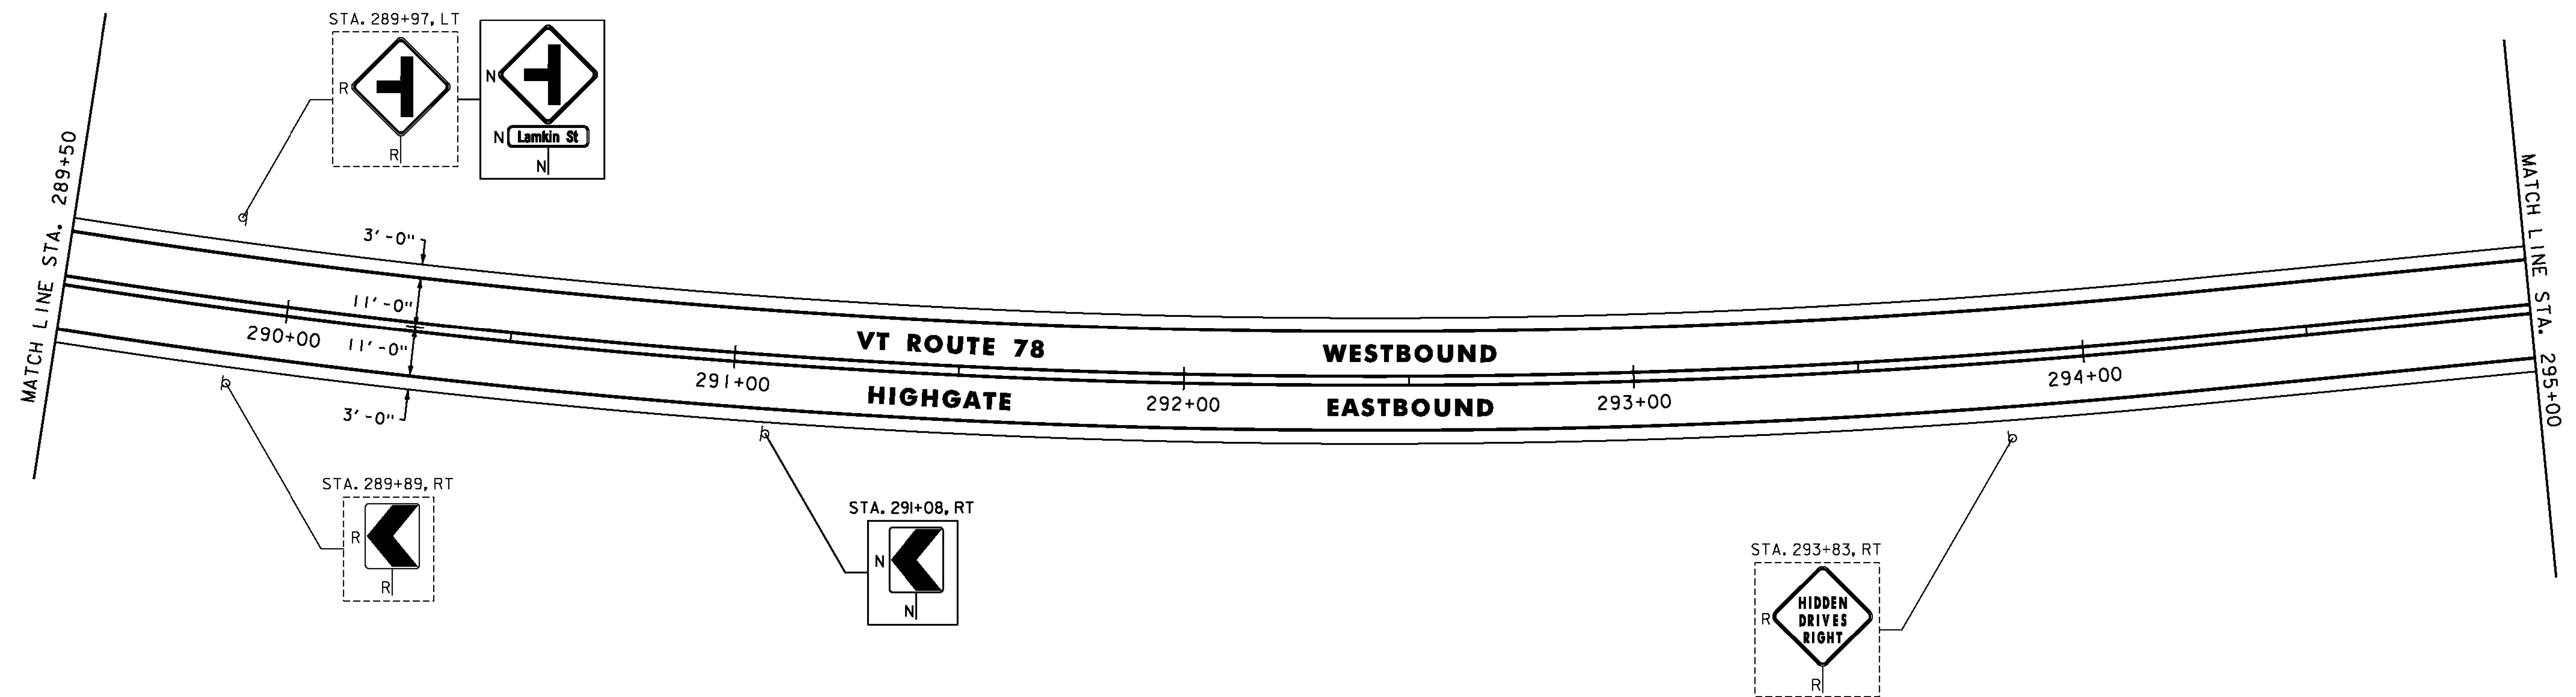

MILLED RUMBLE STRIPS
~~STA. 295+00 TO 300+00, C~~

STEEL BEAM GUARDRAIL, GALVANIZED
 STA. 298+20.0 TO 300+00.0, RT


TEMPORARY 4 INCH WHITE LINE, PAINT
 DURABLE 4 INCH WHITE LINE (OPTION BID ITEM)
 (ALL LINES WILL INCLUDE EDGE LINE BREAKS
 AND RADII FOR SIDE ROADS)
 STA. 295+00 TO 300+00, SOLID LT & RT

REMOVING SIGNS
 AS SHOWN - 3

ANCHOR FOR STEEL BEAM RAIL
 STA. 298+20.0, RT

REMOVAL AND DISPOSAL OF GUARDRAIL
 STA. 298+20 TO 300+00, RT

TEMPORARY 4 INCH YELLOW LINE, PAINT
 DURABLE 4 INCH YELLOW LINE (OPTION BID ITEM)
 (ALL LINES WILL INCLUDE C BREAKS FOR SIDE ROADS)
 STA. 295+00 TO 300+00, SOLID LT & RT

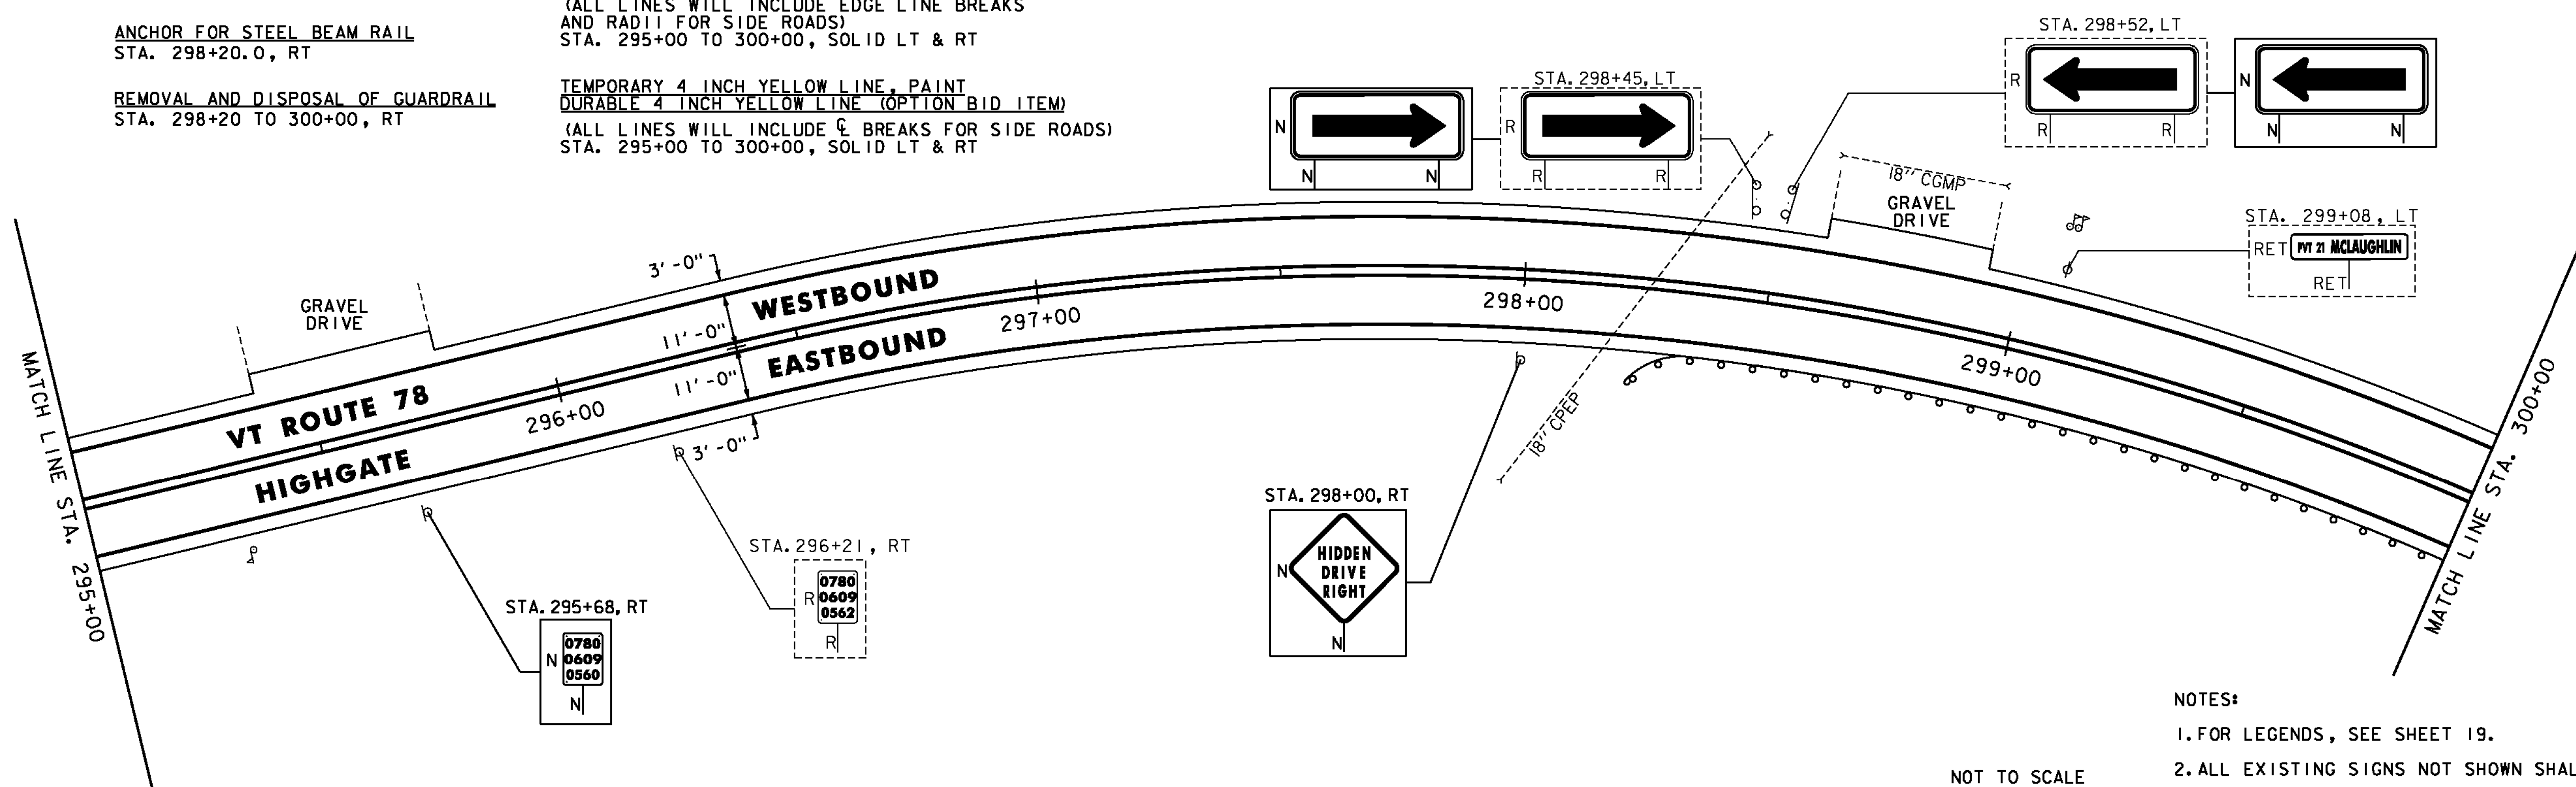

NOTES:

- FOR LEGENDS, SEE SHEET 19.
- ALL EXISTING SIGNS NOT SHOWN SHALL BE RETAINED.

NOT TO SCALE

**PROJECT
 LAYOUT
 SHEET #42**

PROJECT NAME: SWANTON-SHELDON
 PROJECT NUMBER: STP 2715(I)

FILE NAME: p07cl86.dgn
 PROJECT LEADER: G. EDWARDS
 DESIGNED BY: G. BARRETT

PLOT DATE: 4/24/2014
 DRAWN BY: G. BARRETT
 CHECKED BY: M. FOISY
 SHEET 60 OF 121

