

MILLED RUMBLE STRIPS  
STA. 300+00 TO 305+00, ☒

REHAB. DIS. CBS OR MHS. CLASS I OR II  
SEE SHEET 13

STEEL BEAM GUARDRAIL, GALVANIZED  
STA. 300+00.0 TO 302+32.5, RT  
STA. 303+89.0 TO 304+14.0, RT

STEEL BEAM GUARDRAIL, GALVANIZED  
W/8 FEET POSTS  
STA. 304+14.0 TO 305+00.0, RT


ANCHOR FOR STEEL BEAM RAIL  
STA. 302+32.5, RT  
STA. 303+89.0, RT

REMOVAL AND DISPOSAL OF GUARDRAIL  
STA. 300+00 TO 302+32.5, RT  
STA. 303+89 TO 305+00, RT

TEMPORARY 4 INCH WHITE LINE, PAINT  
DURABLE 4 INCH WHITE LINE (OPTION BID ITEM)  
(ALL LINES WILL INCLUDE EDGE LINE BREAKS  
AND RADI FOR SIDE ROADS)  
STA. 300+00 TO 305+00, SOLID LT & RT

REMOVING SIGNS  
AS SHOWN - I

TEMPORARY 4 INCH YELLOW LINE, PAINT  
DURABLE 4 INCH YELLOW LINE (OPTION BID ITEM)  
(ALL LINES WILL INCLUDE ☒ BREAKS FOR SIDE ROADS)  
STA. 300+00 TO 305+00, SOLID LT & RT

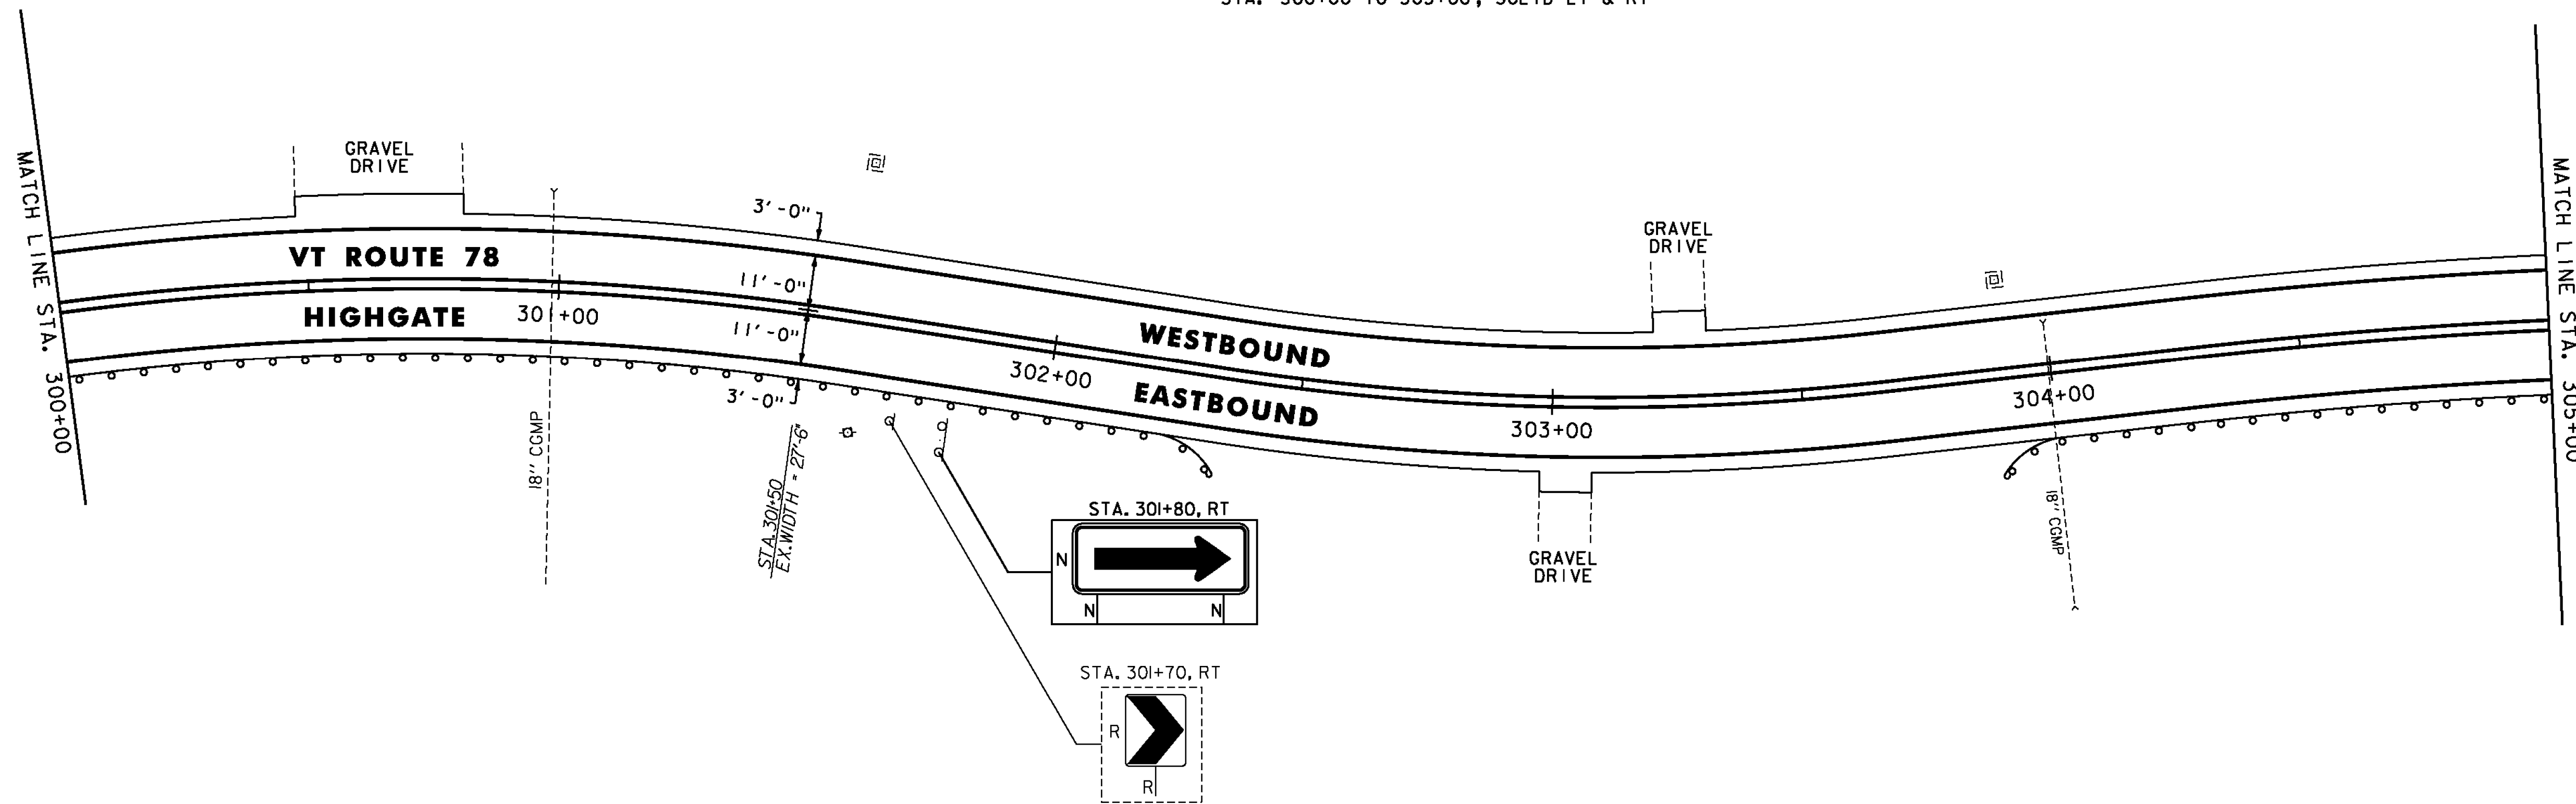

MILLED RUMBLE STRIPS  
STA. 305+00 TO 310+00, ☒

REHAB. DIS. CBS OR MHS. CLASS I OR II  
SEE SHEET 13

STEEL BEAM GUARDRAIL, GALVANIZED  
W/8 FEET POSTS  
STA. 305+00.0 TO 310+00.0, RT

REMOVAL AND DISPOSAL OF GUARDRAIL  
STA. 305+00 TO 305+39, RT  
STA. 309+09 TO 310+00, RT

STA. 306+24, LT


STA. 307+00, LT

TEMPORARY 4 INCH WHITE LINE, PAINT  
DURABLE 4 INCH WHITE LINE (OPTION BID ITEM)  
(ALL LINES WILL INCLUDE EDGE LINE BREAKS  
AND RADI FOR SIDE ROADS)  
STA. 305+00 TO 310+00, SOLID LT & RT

REMOVING SIGNS  
AS SHOWN - I

TEMPORARY 4 INCH YELLOW LINE, PAINT  
DURABLE 4 INCH YELLOW LINE (OPTION BID ITEM)  
(ALL LINES WILL INCLUDE ☒ BREAKS FOR SIDE ROADS)  
STA. 305+00 TO 310+00, SOLID LT & RT

STA. 309+67, LT

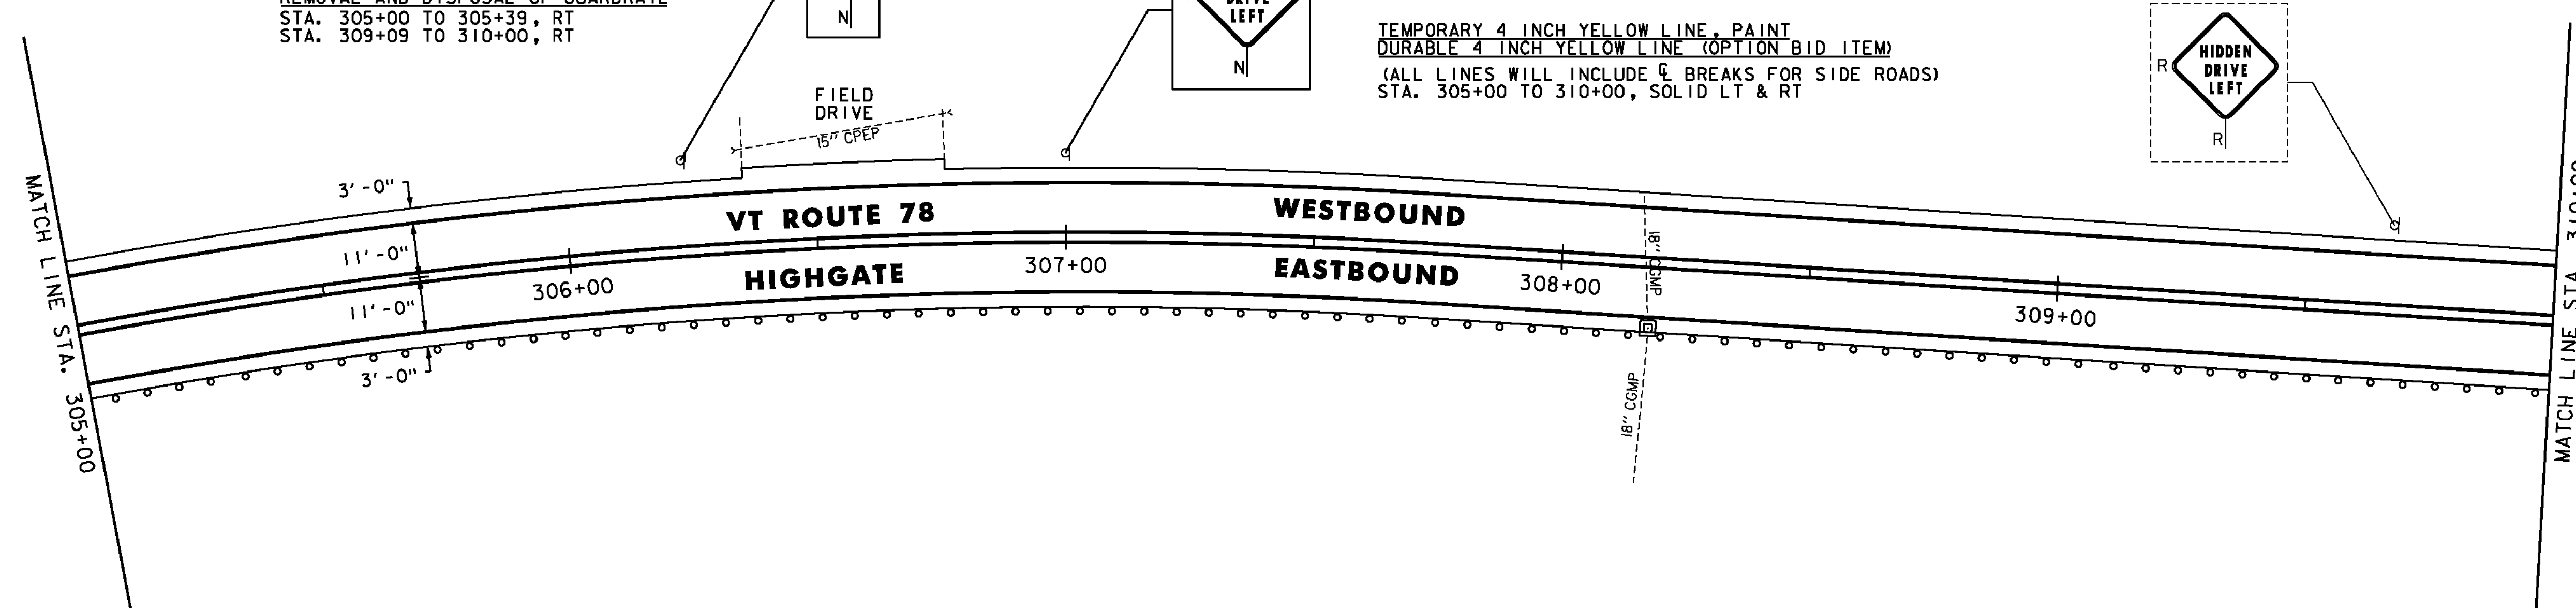

NOTES:

- FOR LEGENDS, SEE SHEET 19.
- ALL EXISTING SIGNS NOT SHOWN SHALL BE RETAINED.

NOT TO SCALE

**PROJECT LAYOUT SHEET #43**



PROJECT NAME: SWANTON-SHELDON  
PROJECT NUMBER: STP 2715(I)

FILE NAME: p07cl86.dgn  
PROJECT LEADER: G. EDWARDS  
DESIGNED BY: G. BARRETT

PLOT DATE: 4/24/2014  
DRAWN BY: G. BARRETT  
CHECKED BY: M. FOISY  
SHEET 61 OF 121