

MILLED RUMBLE STRIPS  
STA. 330+00 TO 335+00, ☐

STEEL BEAM GUARDRAIL, GALVANIZED  
STA. 334+10.0 TO 334+35.0, RT

STEEL BEAM GUARDRAIL, GALVANIZED  
W/8 FEET POSTS  
STA. 334+35.0 TO 335+00.0, RT


ANCHOR FOR STEEL BEAM RAIL  
STA. 334+10.0, RT

REMOVAL AND DISPOSAL OF GUARDRAIL  
STA. 334+15 TO 335+00, RT

TEMPORARY 4 INCH WHITE LINE, PAINT  
DURABLE 4 INCH WHITE LINE (OPTION BID ITEM)  
(ALL LINES WILL INCLUDE EDGE LINE BREAKS  
AND RADII FOR SIDE ROADS)  
STA. 330+00 TO 335+00, SOLID LT & RT

REMOVING SIGNS  
AS SHOWN - 1

TEMPORARY 4 INCH YELLOW LINE, PAINT  
DURABLE 4 INCH YELLOW LINE (OPTION BID ITEM)  
(ALL LINES WILL INCLUDE ☐ BREAKS FOR SIDE ROADS)  
STA. 330+00 TO 335+00, SOLID LT & RT

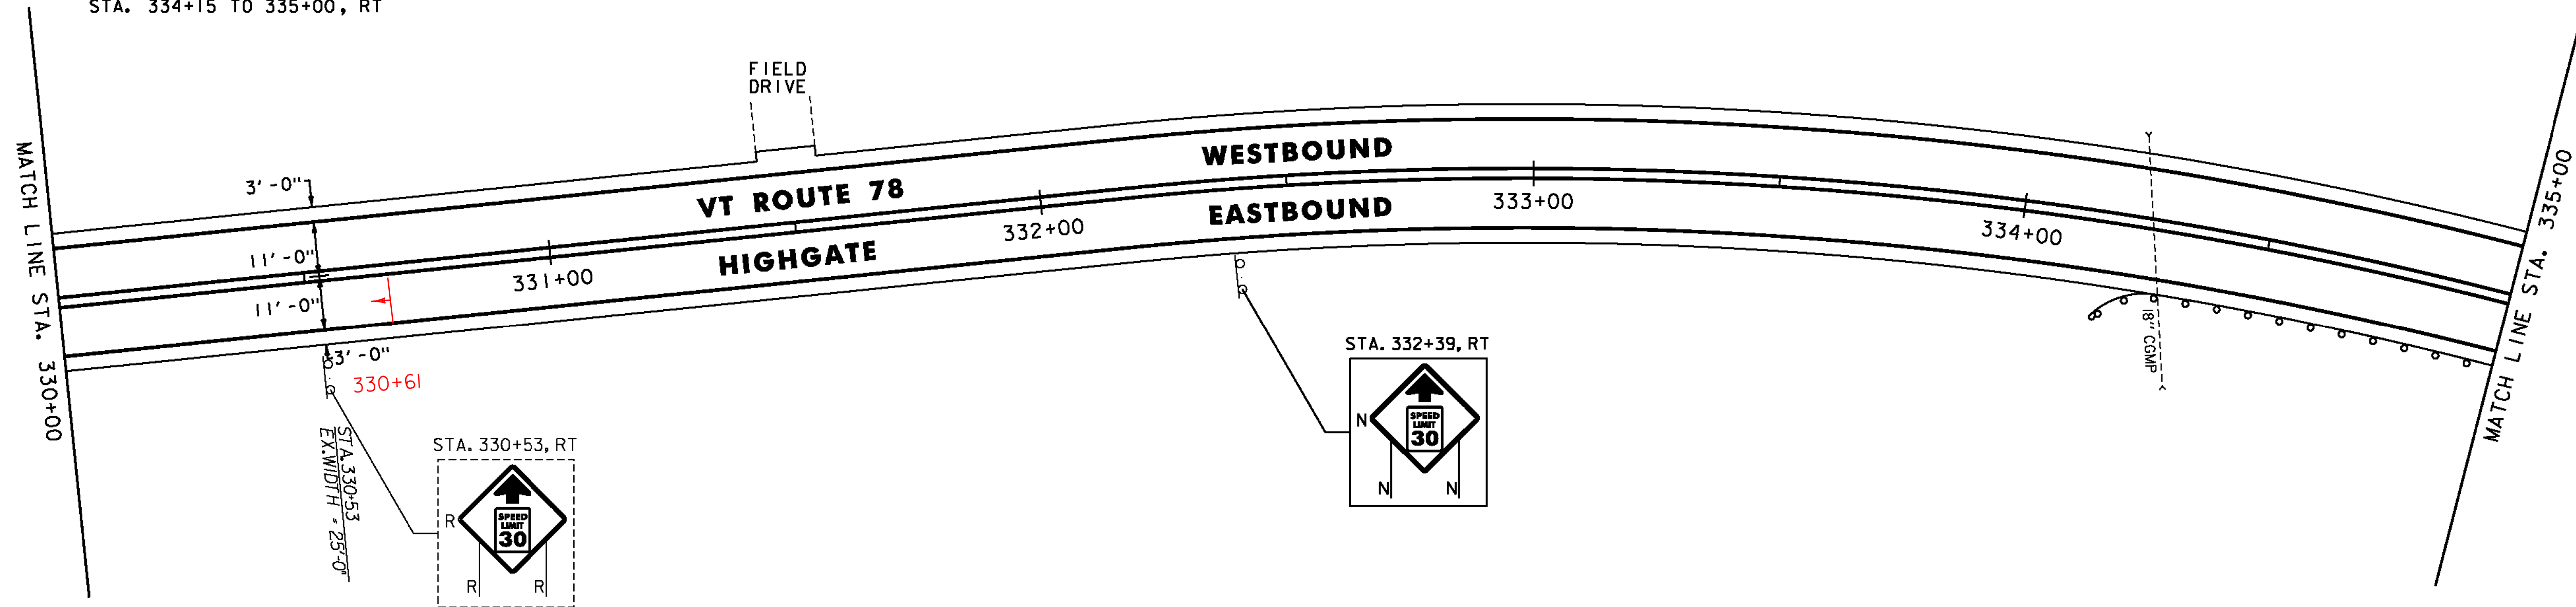

MILLED RUMBLE STRIPS  
STA. 335+00 TO 336+34, ☐  
336+55


STEEL BEAM GUARDRAIL, GALVANIZED  
W/8 FEET POSTS  
STA. 335+00.0 TO 340+50.0, RT

REMOVAL AND DISPOSAL OF GUARDRAIL  
STA. 335+00 TO 340+50, RT

TEMPORARY 4 INCH WHITE LINE, PAINT  
DURABLE 4 INCH WHITE LINE (OPTION BID ITEM)  
(ALL LINES WILL INCLUDE EDGE LINE BREAKS  
AND RADII FOR SIDE ROADS)  
STA. 335+00 TO 340+50, SOLID LT & RT

REMOVING SIGNS  
AS SHOWN - 3

TEMPORARY 4 INCH YELLOW LINE, PAINT  
DURABLE 4 INCH YELLOW LINE (OPTION BID ITEM)  
(ALL LINES WILL INCLUDE ☐ BREAKS FOR SIDE ROADS)  
STA. 335+00 TO 340+50, SOLID LT & RT

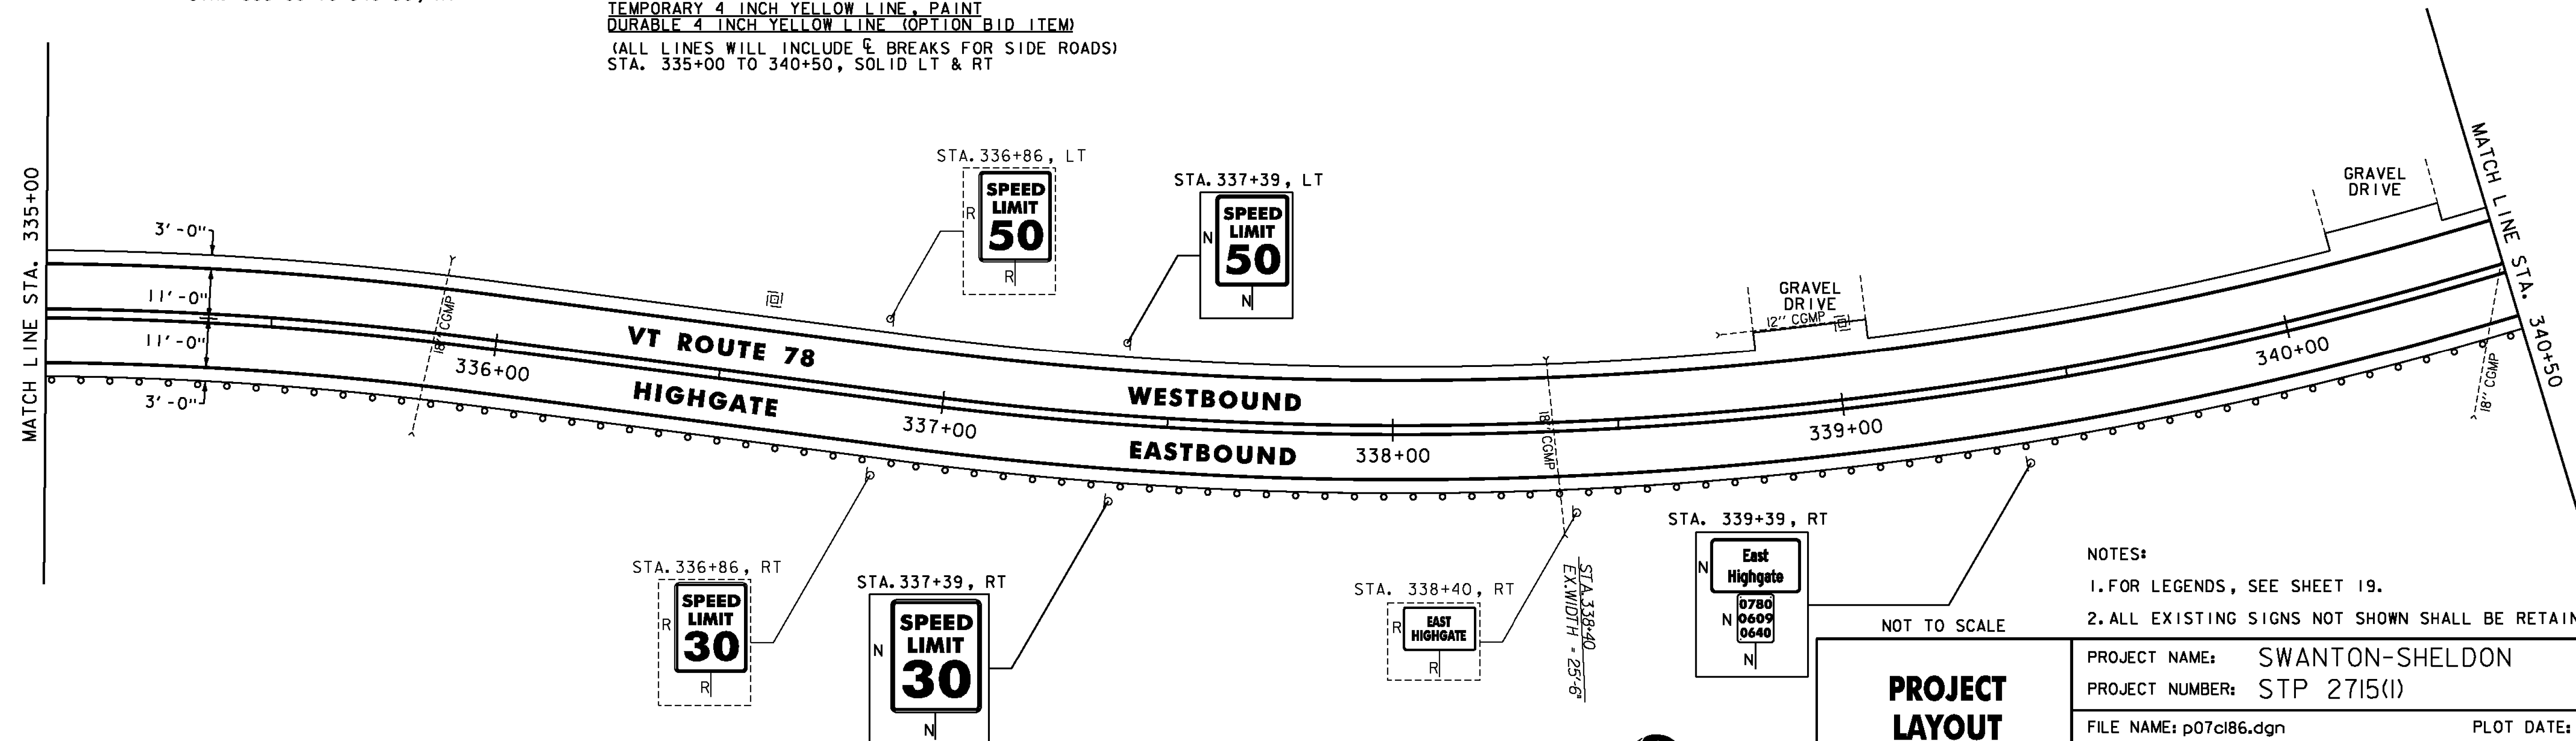

NOTES:

- FOR LEGENDS, SEE SHEET 19.
- ALL EXISTING SIGNS NOT SHOWN SHALL BE RETAINED.

NOT TO SCALE

**PROJECT LAYOUT SHEET #46**

PROJECT NAME: SWANTON-SHELDON  
PROJECT NUMBER: STP 2715(I)

FILE NAME: p07cl86.dgn  
PROJECT LEADER: G. EDWARDS  
DESIGNED BY: G. BARRETT

PLOT DATE: 4/24/2014  
DRAWN BY: G. BARRETT  
CHECKED BY: M. FOISY  
SHEET 64 OF 121

