

REHAB. DIS. CBs OR MHS. CLASS I OR II  
SEE SHEET 13

STONE FILL, TYPE J  
STA. 344+84 TO 344+90, RT  
STA. 345+50 TO 345+56, RT

RELOCATE MAILBOX, SINGLE SUPPORT  
STA. 343+78, RT

STEEL BEAM GUARDRAIL, GALVANIZED  
W/8 FEET POSTS  
STA. 340+50.0 TO 346+00.0, RT

REMOVAL AND DISPOSAL OF GUARDRAIL  
STA. 340+50 TO 346+00, RT

TEMPORARY 4 INCH WHITE LINE, PAINT  
DURABLE 4 INCH WHITE LINE (OPTION BID ITEM)  
(ALL LINES WILL INCLUDE EDGE LINE BREAKS  
AND RADI FOR SIDE ROADS)  
STA. 340+50 TO 346+00, SOLID LT & RT  
STA. 345+22, SOLID LT (EDGELINES, HANNA ROAD, TH-62)

TEMPORARY 4 INCH YELLOW LINE, PAINT  
DURABLE 4 INCH YELLOW LINE (OPTION BID ITEM)  
(ALL LINES WILL INCLUDE  $\phi$  BREAKS FOR SIDE ROADS)  
STA. 340+50 TO 346+00, SOLID LT & RT  
STA. 345+22, DOUBLE SOLID LT (HANNA ROAD, TH-62)

TEMPORARY 24 INCH STOP BAR, PAINT  
DURABLE 24 INCH STOP BAR (OPTION BID ITEM)  
STA. 345+22, LT (HANNA ROAD, TH-62)

TEMPORARY TEMPORARY LETTER OR SYMBOL, PAINT  
DURABLE LETTER OR SYMBOL (OPTION BID ITEM)  
STA. 345+22, LT "STOP" (HANNA ROAD, TH-62)

GEOTEXTILE UNDER STONE FILL  
STA. 344+84 TO 344+90, RT  
STA. 345+50 TO 345+56, RT

GRUBBING MATERIAL  
STA. 344+84 TO 344+90, RT  
STA. 345+50 TO 345+56, RT

REMOVING SIGNS  
AS SHOWN - 5

STA. 345+05, LT


LEGAL LOAD  
LIMIT  
24,000  
POUNDS

SPEED  
LIMIT  
35

LEGAL LOAD  
LIMIT  
24,000  
POUNDS

SPEED  
LIMIT  
35

MATCH LINE STA. 340+50

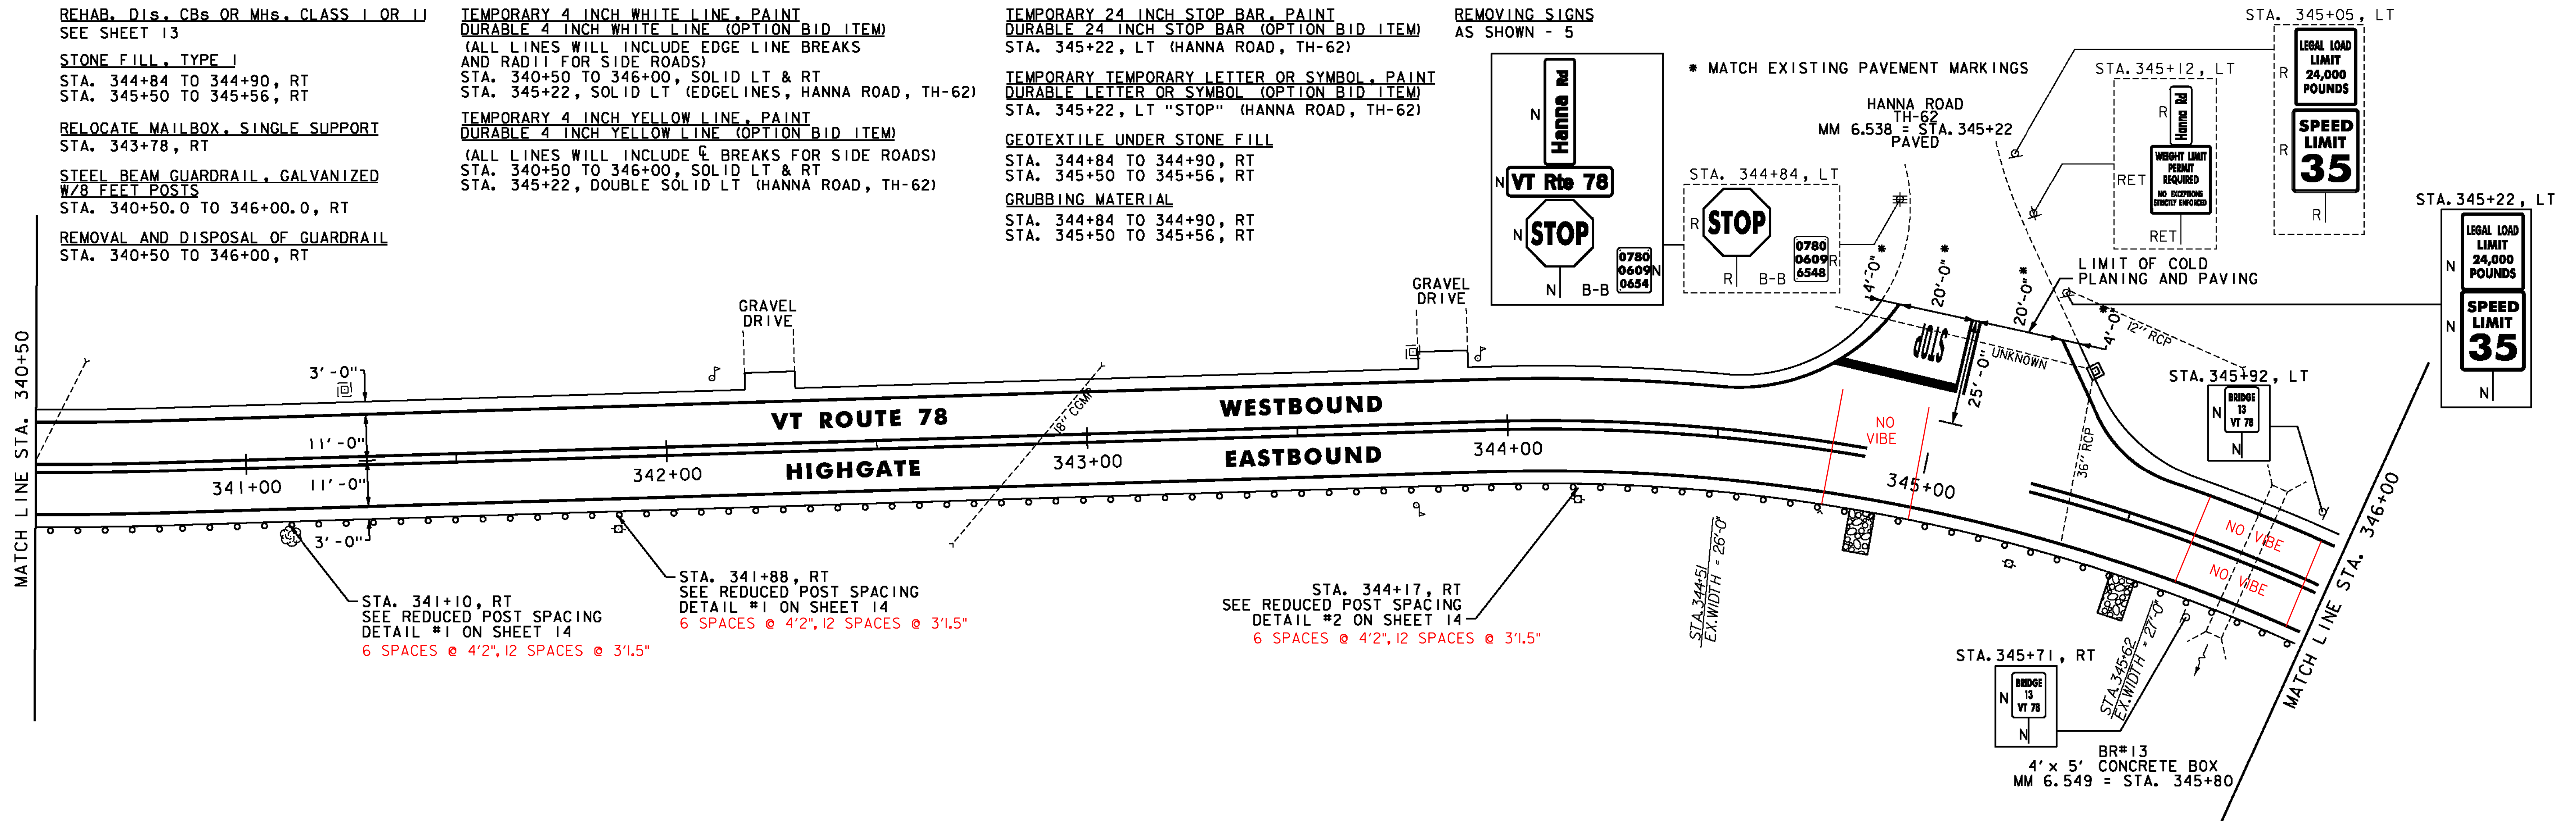

STONE FILL, TYPE J  
STA. 346+33 TO 346+39, RT

STEEL BEAM GUARDRAIL, GALVANIZED  
STA. 347+97.5 TO 348+22.5, RT

STEEL BEAM GUARDRAIL, GALVANIZED  
W/8 FEET POSTS  
STA. 346+00.0 TO 347+97.5, RT

ANCHOR FOR STEEL BEAM RAIL  
STA. 348+22.5, RT

REMOVAL AND DISPOSAL OF GUARDRAIL  
STA. 346+00 TO 348+15, RT


TEMPORARY 4 INCH WHITE LINE, PAINT  
DURABLE 4 INCH WHITE LINE (OPTION BID ITEM)  
(ALL LINES WILL INCLUDE EDGE LINE BREAKS  
AND RADI FOR SIDE ROADS)  
STA. 346+00 TO 350+00, SOLID LT & RT

TEMPORARY 4 INCH YELLOW LINE, PAINT  
DURABLE 4 INCH YELLOW LINE (OPTION BID ITEM)  
(ALL LINES WILL INCLUDE  $\phi$  BREAKS FOR SIDE ROADS)  
STA. 346+00 TO 350+00, SOLID LT & RT

GEOTEXTILE UNDER STONE FILL  
STA. 346+33 TO 346+39, RT

GRUBBING MATERIAL  
STA. 346+33 TO 346+39, RT

REMOVING SIGNS  
AS SHOWN - 2

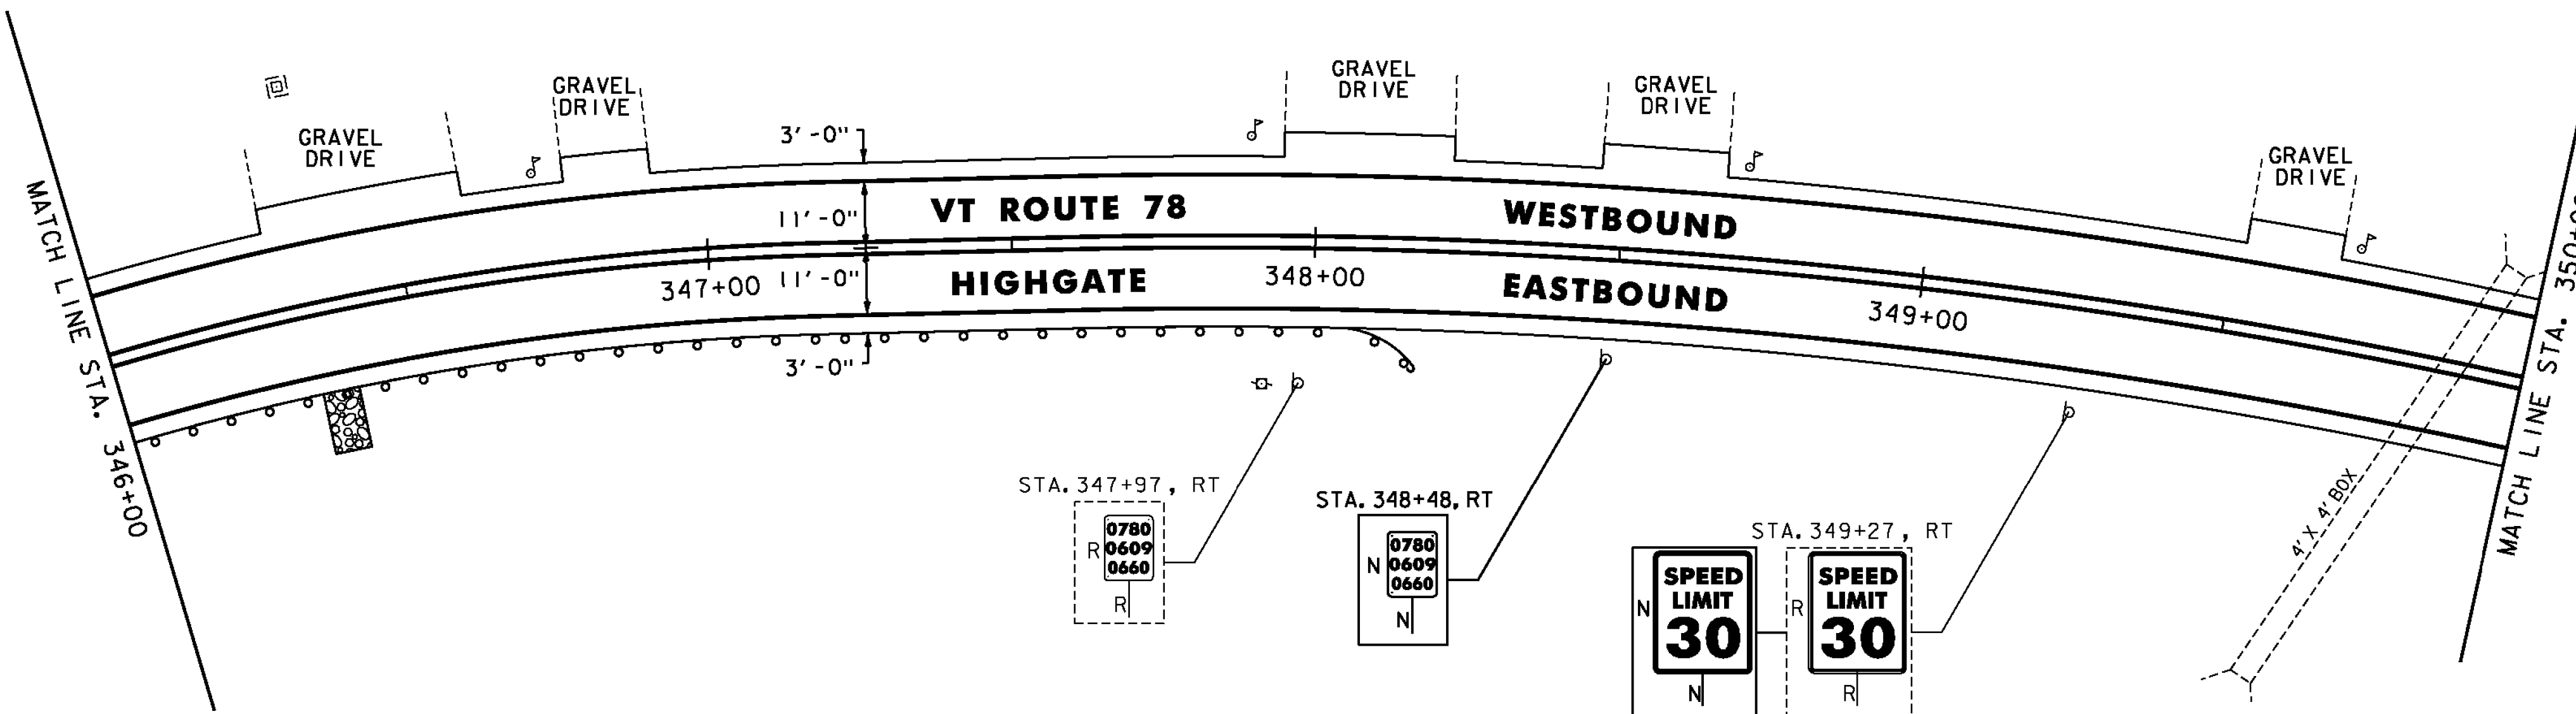

NOTES:

- FOR LEGENDS, SEE SHEET 19.
- ALL EXISTING SIGNS NOT SHOWN SHALL BE RETAINED.

NOT TO SCALE

**PROJECT  
LAYOUT  
SHEET #47**

PROJECT NAME: SWANTON-SHELDON  
PROJECT NUMBER: STP 2715(I)

FILE NAME: p07cl86.dgn  
PROJECT LEADER: G. EDWARDS  
DESIGNED BY: G. BARRETT

PLOT DATE: 4/24/2014  
DRAWN BY: G. BARRETT  
CHECKED BY: M. FOISY  
SHEET 65 OF 121

