

MILLED RUMBLE STRIPS  
STA. 380+00 TO 385+00, C  
380+95

STEEL BEAM GUARDRAIL, GALVANIZED  
STA. 381+69.5 TO 381+94.5, RT  
  
STEEL BEAM GUARDRAIL, GALVANIZED  
W/8 FEET POSTS  
STA. 380+00.0 TO 381+69.5, RT


ANCHOR FOR STEEL BEAM RAIL  
STA. 381+94.5, RT

REMOVAL AND DISPOSAL OF GUARDRAIL  
STA. 380+00 TO 381+94.5, RT

TEMPORARY 4 INCH WHITE LINE, PAINT  
DURABLE 4 INCH WHITE LINE (OPTION BID ITEM)  
(ALL LINES WILL INCLUDE EDGE LINE BREAKS  
AND RADII FOR SIDE ROADS)  
STA. 380+00 TO 385+00, SOLID LT & RT

TEMPORARY 4 INCH YELLOW LINE, PAINT  
DURABLE 4 INCH YELLOW LINE (OPTION BID ITEM)  
(ALL LINES WILL INCLUDE C BREAKS FOR SIDE ROADS)  
STA. 380+00 TO 385+00, SOLID LT & RT

REMOVING SIGNS  
AS SHOWN - 5

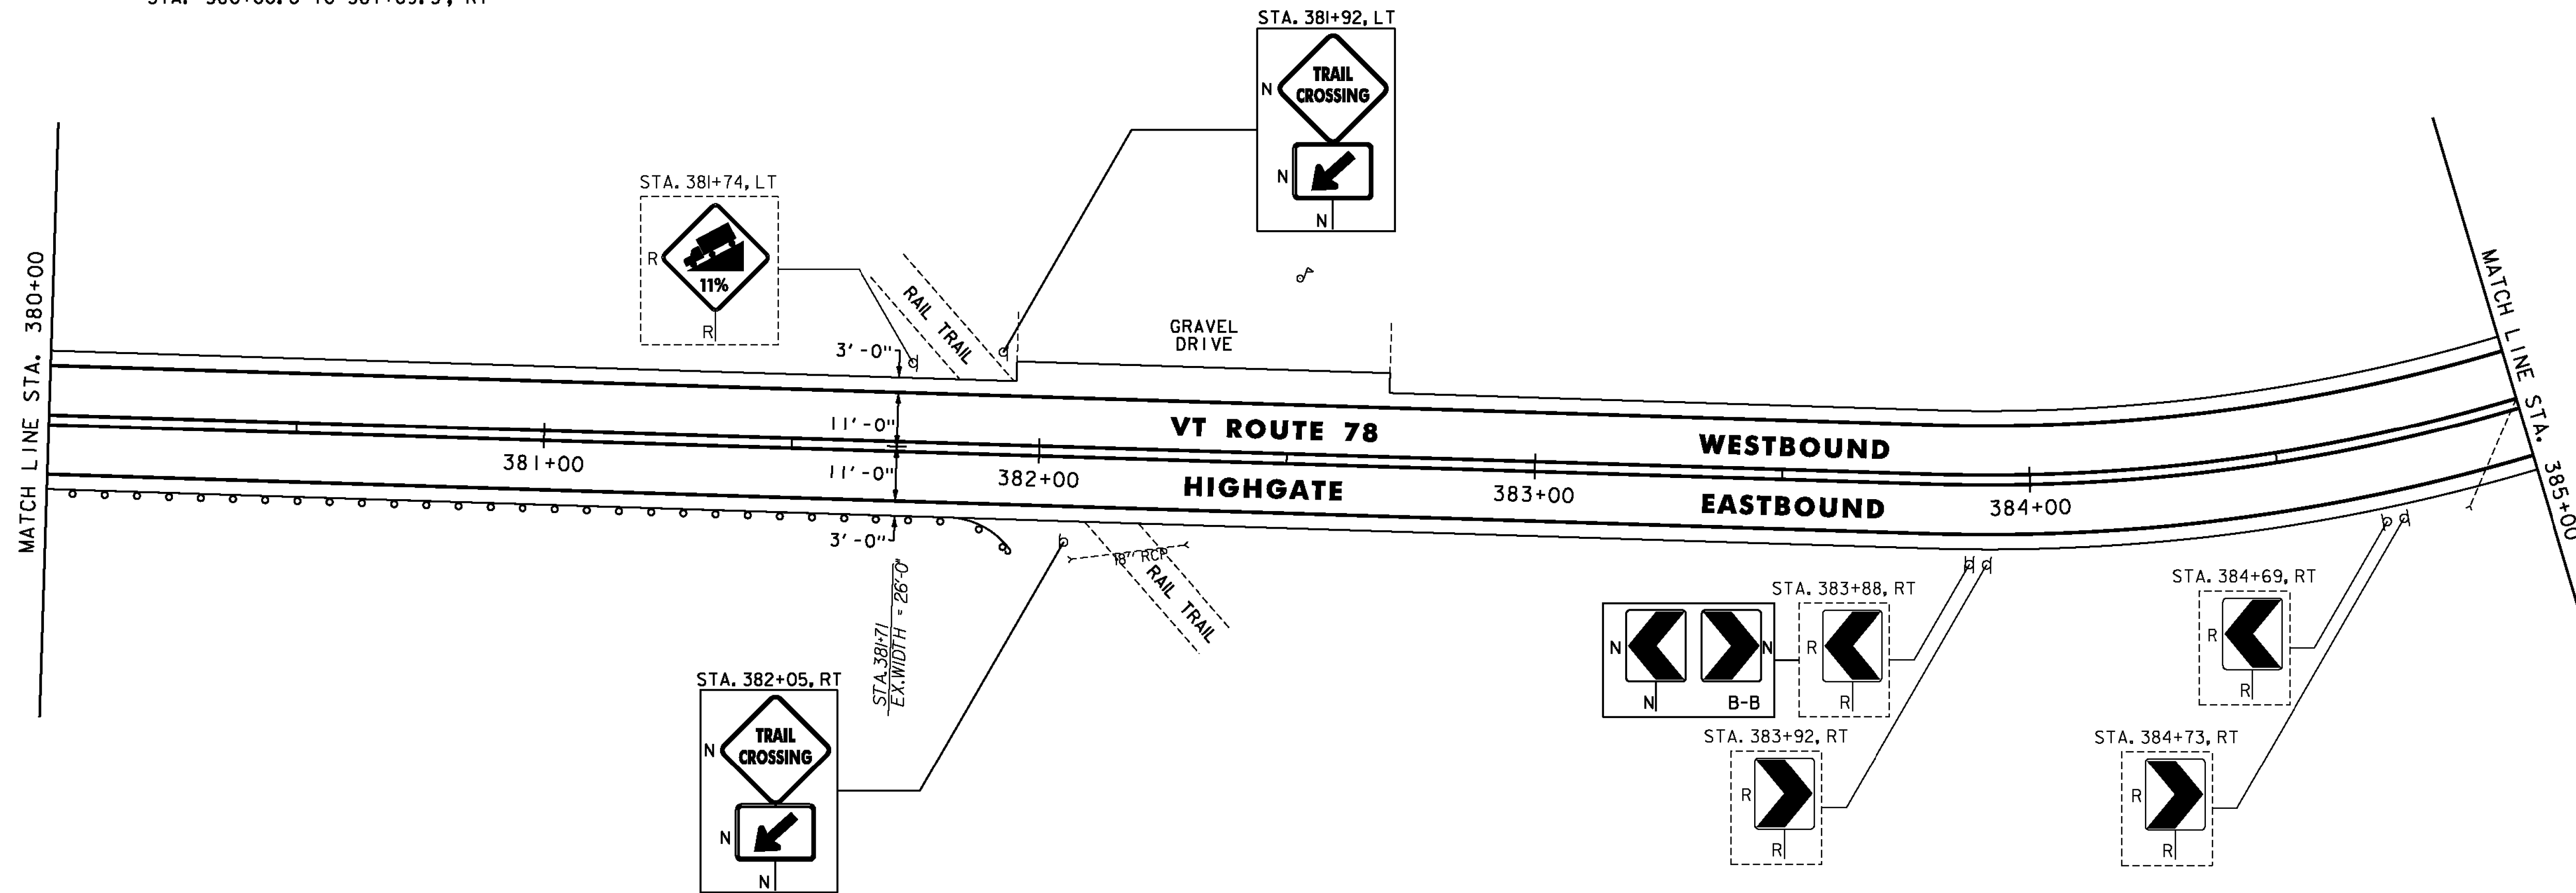


MILLED RUMBLE STRIPS  
STA. 385+00 TO 390+00, C  
388+92

TEMPORARY 4 INCH WHITE LINE, PAINT  
DURABLE 4 INCH WHITE LINE (OPTION BID ITEM)  
(ALL LINES WILL INCLUDE EDGE LINE BREAKS  
AND RADII FOR SIDE ROADS)  
STA. 385+00 TO 390+00, SOLID LT & RT

TEMPORARY 4 INCH YELLOW LINE, PAINT  
DURABLE 4 INCH YELLOW LINE (OPTION BID ITEM)  
(ALL LINES WILL INCLUDE C BREAKS FOR SIDE ROADS)  
STA. 385+00 TO 390+00, SOLID LT & RT

REMOVING SIGNS  
AS SHOWN - 3

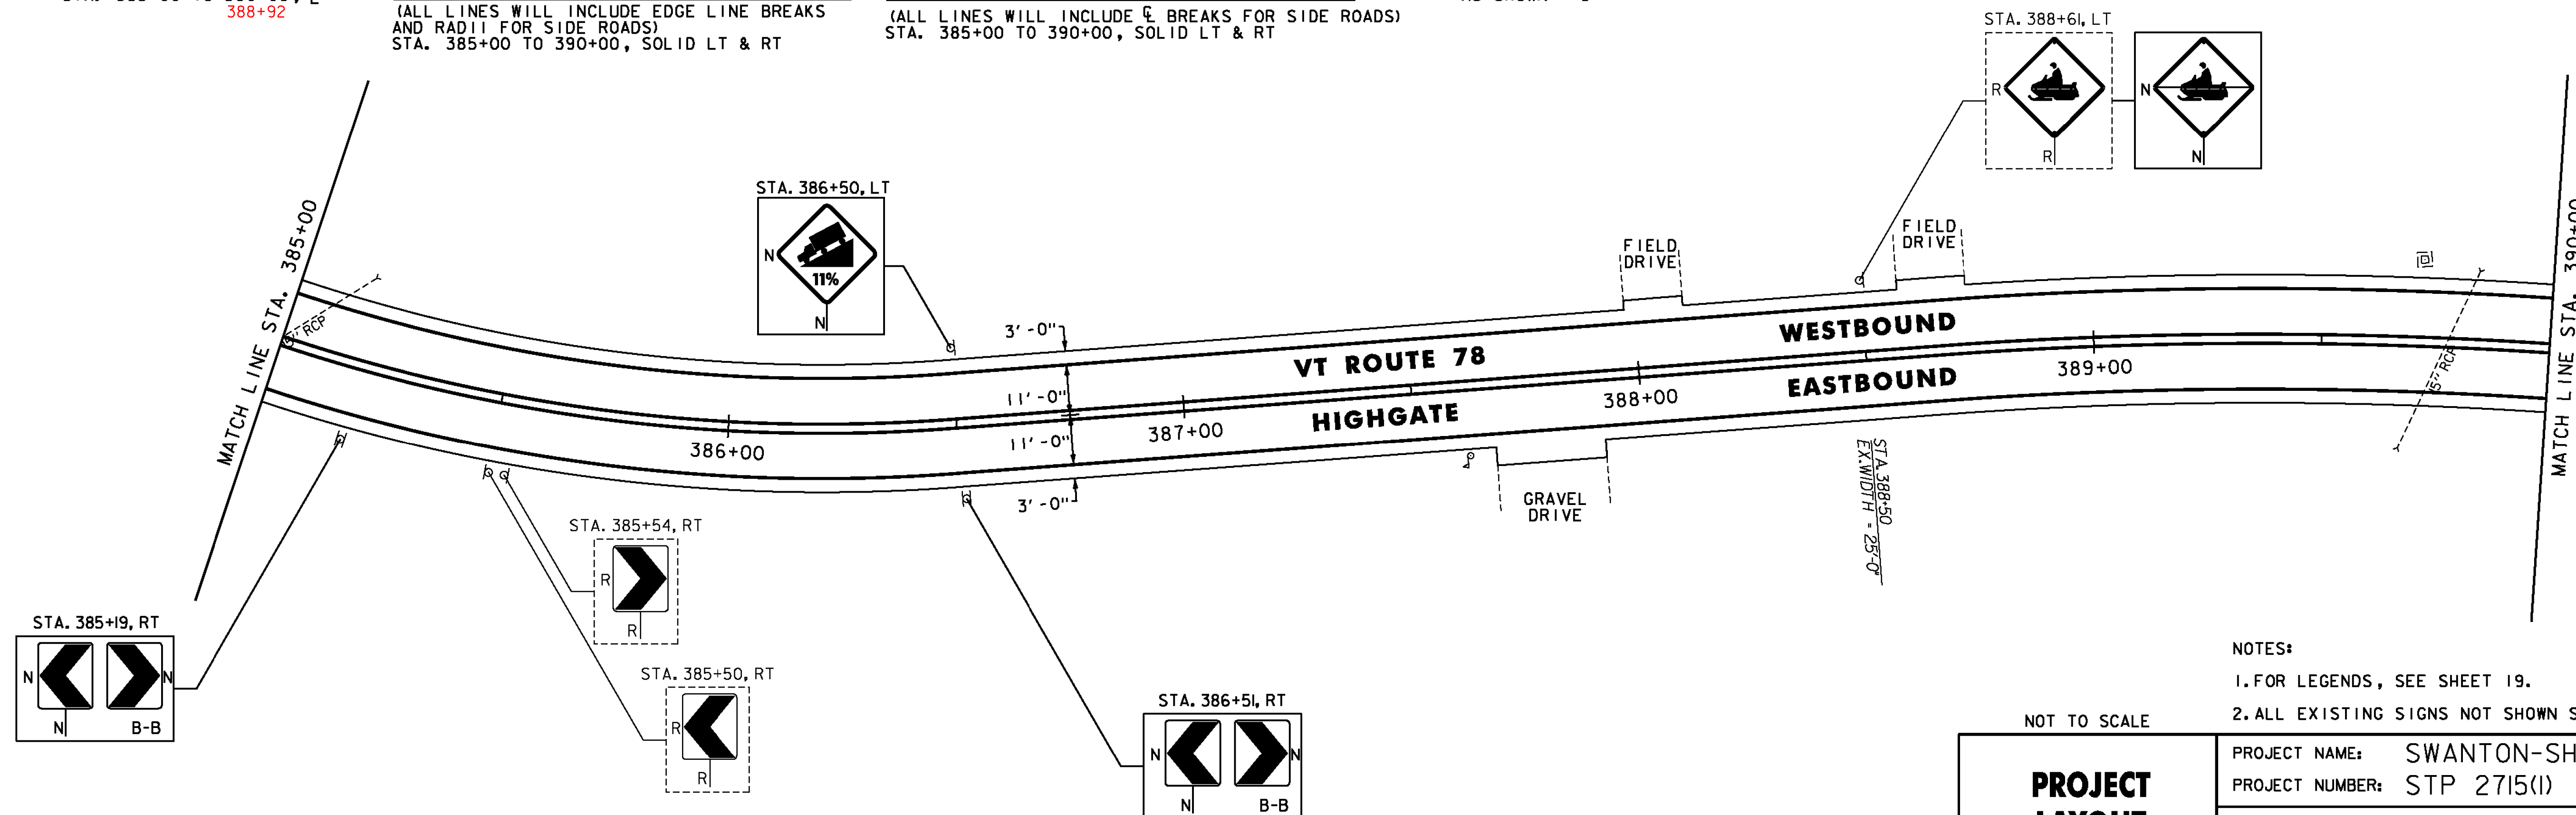

NOTES:

1. FOR LEGENDS, SEE SHEET 19.
2. ALL EXISTING SIGNS NOT SHOWN SHALL BE RETAINED.

NOT TO SCALE

**PROJECT LAYOUT SHEET #52**

PROJECT NAME: SWANTON-SHELDON  
PROJECT NUMBER: STP 2715(I)

FILE NAME: p07cl86.dgn  
PROJECT LEADER: G. EDWARDS  
DESIGNED BY: G. BARRETT

PLOT DATE: 4/24/2014  
DRAWN BY: G. BARRETT  
CHECKED BY: M. FOISY  
SHEET 70 OF 121

