


TEMPORARY 4 INCH WHITE LINE, PAINT
 DURABLE 4 INCH WHITE LINE (OPTION BID ITEM)
 (ALL LINES WILL INCLUDE EDGE LINE BREAKS
 AND RADII FOR SIDE ROADS)
 STA. 25+00 TO 30+00, SOLID LT & RT

TEMPORARY 4 INCH YELLOW LINE, PAINT
 DURABLE 4 INCH YELLOW LINE (OPTION BID ITEM)
 (ALL LINES WILL INCLUDE $\frac{1}{2}$ BREAKS FOR SIDE ROADS)
 STA. 25+00 TO 28+78, SOLID LT, DASHED RT
 STA. 28+78 TO 30+00, DASHED LT, SOLID RT

MILLED RUMBLE STRIPS
 STA. 25+00 TO 30+00 CL

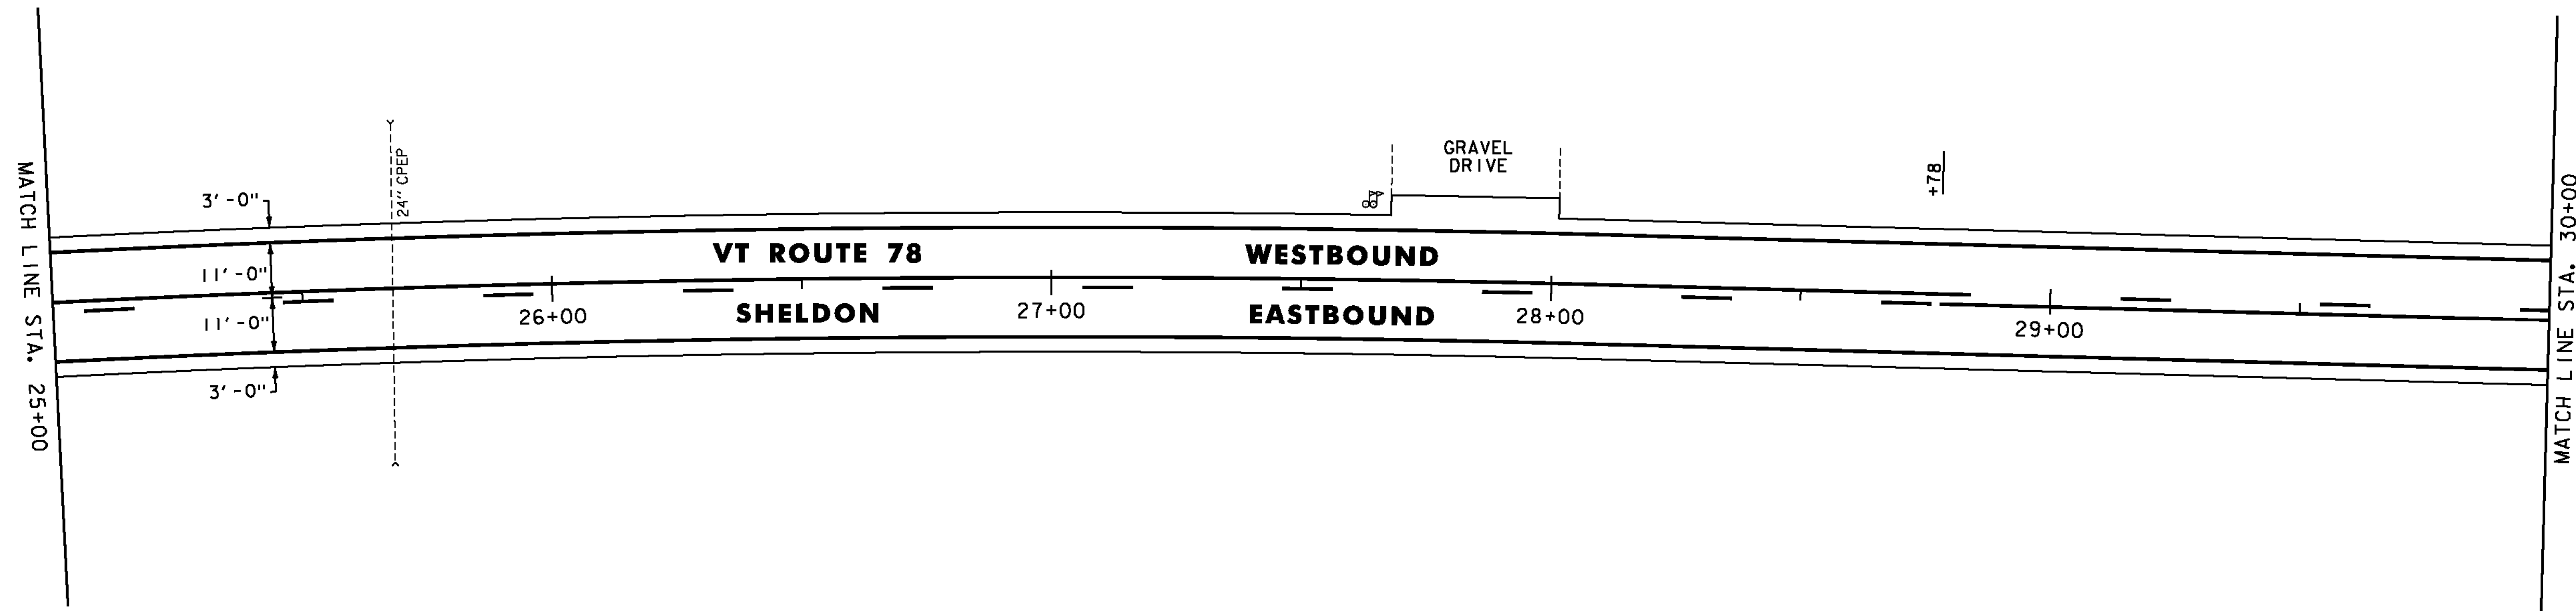

STEEL BEAM GUARDRAIL, GALVANIZED
 STA. 31+21.0 TO 31+58.5, LT
 STA. 31+21.0 TO 31+58.5, RT
 STA. 31+83.5 TO 32+33.5, LT
 STA. 31+83.5 TO 32+33.5, RT

HD STEEL BEAM GUARDRAIL, GALVANIZED / NESTED
 STA. 31+58.5 TO 31+83.5, LT
 STA. 31+58.5 TO 31+83.5, RT

MILLED RUMBLE STRIPS
 STA. 30+00 TO 35+00 CL


ANCHOR FOR STEEL BEAM RAIL
 STA. 31+21.0, LT
 STA. 31+21.0, RT
 STA. 32+33.5, LT
 STA. 32+33.5, RT

REMOVAL AND DISPOSAL OF GUARDRAIL
 STA. 31+25.5 TO 32+25.5, LT
 STA. 31+26.5 TO 32+26.5, RT

TEMPORARY 4 INCH WHITE LINE, PAINT
 DURABLE 4 INCH WHITE LINE (OPTION BID ITEM)
 (ALL LINES WILL INCLUDE EDGE LINE BREAKS
 AND RADII FOR SIDE ROADS)
 STA. 30+00 TO 35+00, SOLID LT & RT

TEMPORARY 4 INCH YELLOW LINE, PAINT
 DURABLE 4 INCH YELLOW LINE (OPTION BID ITEM)
 (ALL LINES WILL INCLUDE $\frac{1}{2}$ BREAKS FOR SIDE ROADS)
 STA. 30+00 TO 34+85, DASHED LT, SOLID RT
 STA. 34+85 TO 35+00, SOLID LT & RT

REMOVING SIGNS
 AS SHOWN - 3

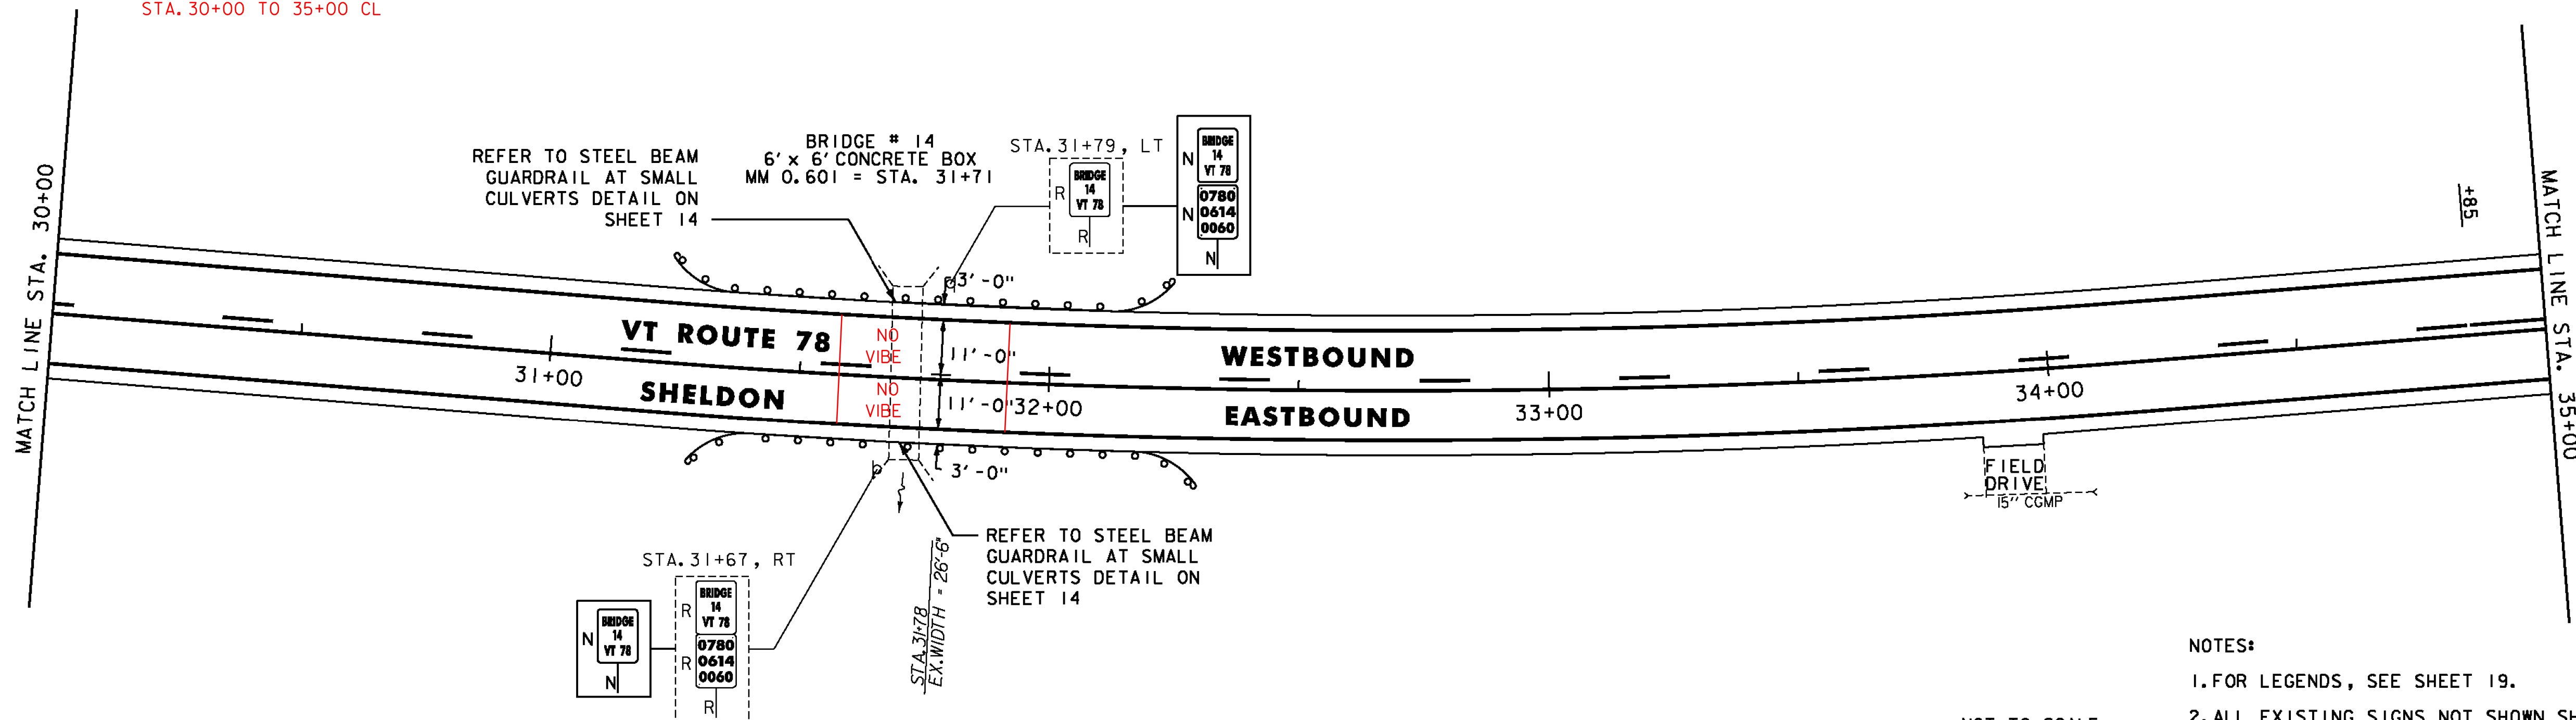

NOTES:

- FOR LEGENDS, SEE SHEET 19.
- ALL EXISTING SIGNS NOT SHOWN SHALL BE RETAINED.

NOT TO SCALE

PROJECT LAYOUT SHEET #58

PROJECT NAME: SWANTON-SHELDON
 PROJECT NUMBER: STP 2715(I)

FILE NAME: p07cl86.dgn
 PROJECT LEADER: G. EDWARDS
 DESIGNED BY: G. BARRETT

PLOT DATE: 4/24/2014
 DRAWN BY: G. BARRETT
 CHECKED BY: M. FOISY
 SHEET 76 OF 121

