


MILLED RUMBLE STRIPS  
STA. 35+00 TO 40+00, ☐

TEMPORARY 4 INCH WHITE LINE, PAINT  
DURABLE 4 INCH WHITE LINE (OPTION BID ITEM)  
(ALL LINES WILL INCLUDE EDGE LINE BREAKS  
AND RADII FOR SIDE ROADS)  
STA. 35+00 TO 40+00, SOLID LT & RT

TEMPORARY 4 INCH YELLOW LINE, PAINT  
DURABLE 4 INCH YELLOW LINE (OPTION BID ITEM)  
(ALL LINES WILL INCLUDE ☐ BREAKS FOR SIDE ROADS)  
STA. 35+00 TO 40+00, SOLID LT & RT

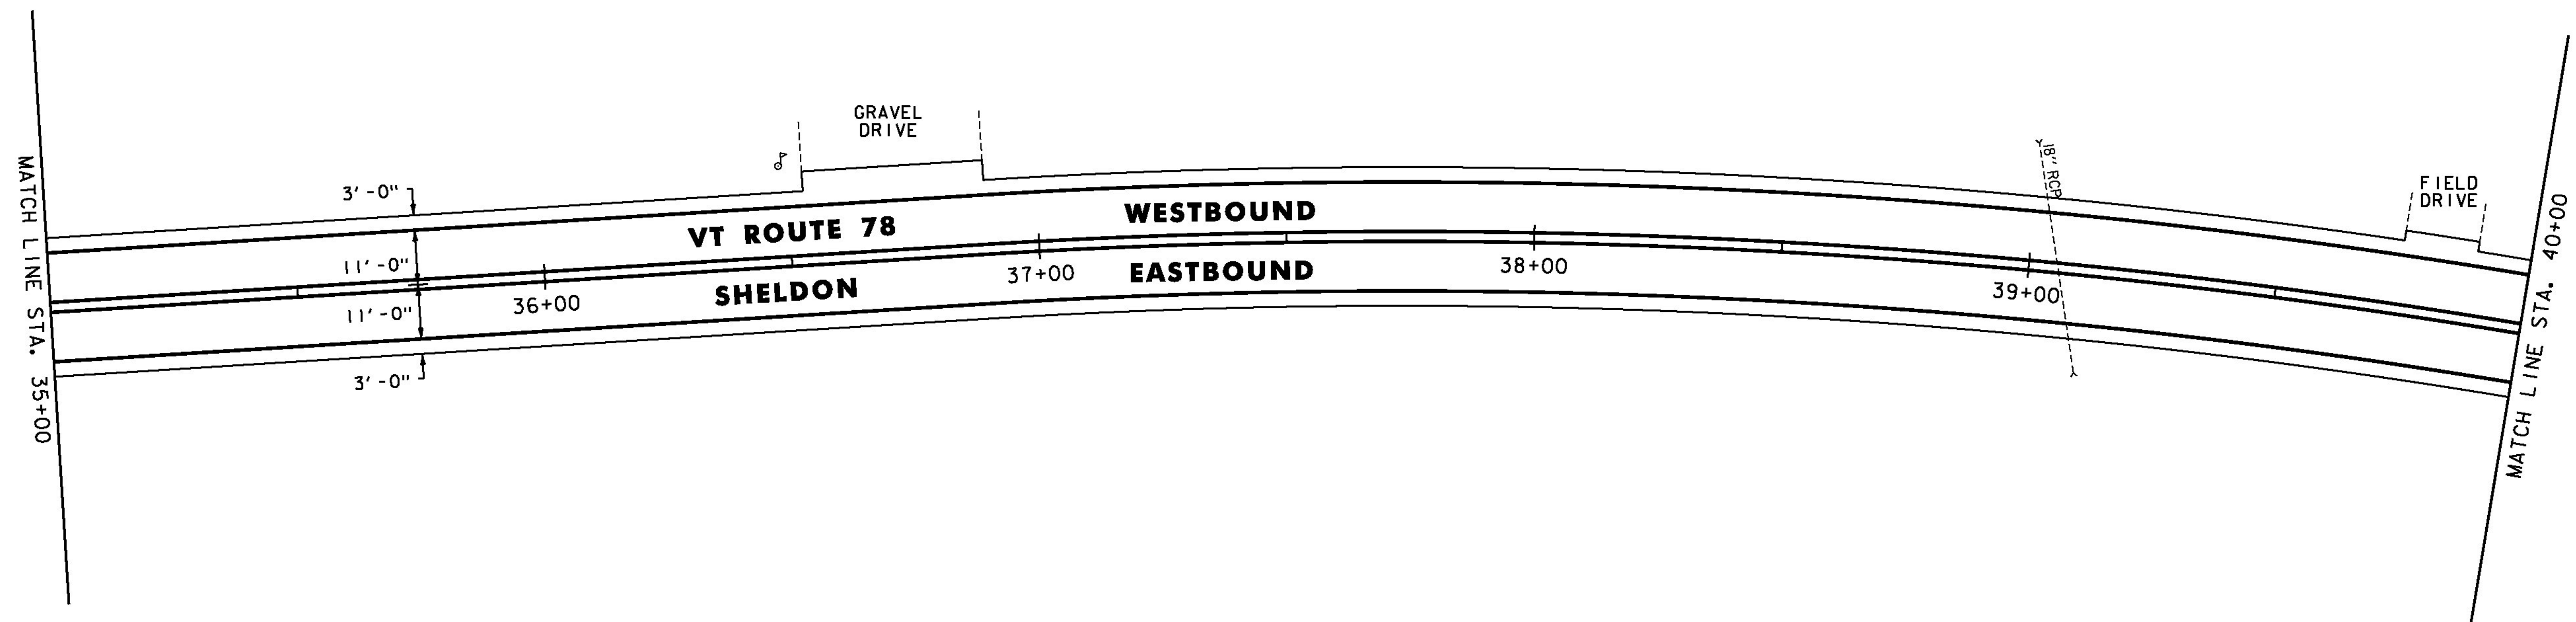


MILLED RUMBLE STRIPS  
STA. 40+00 TO 45+00, ☐

TEMPORARY 4 INCH WHITE LINE, PAINT  
DURABLE 4 INCH WHITE LINE (OPTION BID ITEM)  
(ALL LINES WILL INCLUDE EDGE LINE BREAKS  
AND RADII FOR SIDE ROADS)  
STA. 40+00 TO 45+00, SOLID LT & RT

TEMPORARY 4 INCH YELLOW LINE, PAINT  
DURABLE 4 INCH YELLOW LINE (OPTION BID ITEM)  
(ALL LINES WILL INCLUDE ☐ BREAKS FOR SIDE ROADS)  
STA. 40+00 TO 45+00, SOLID LT & RT

REMOVING SIGNS  
AS SHOWN - I

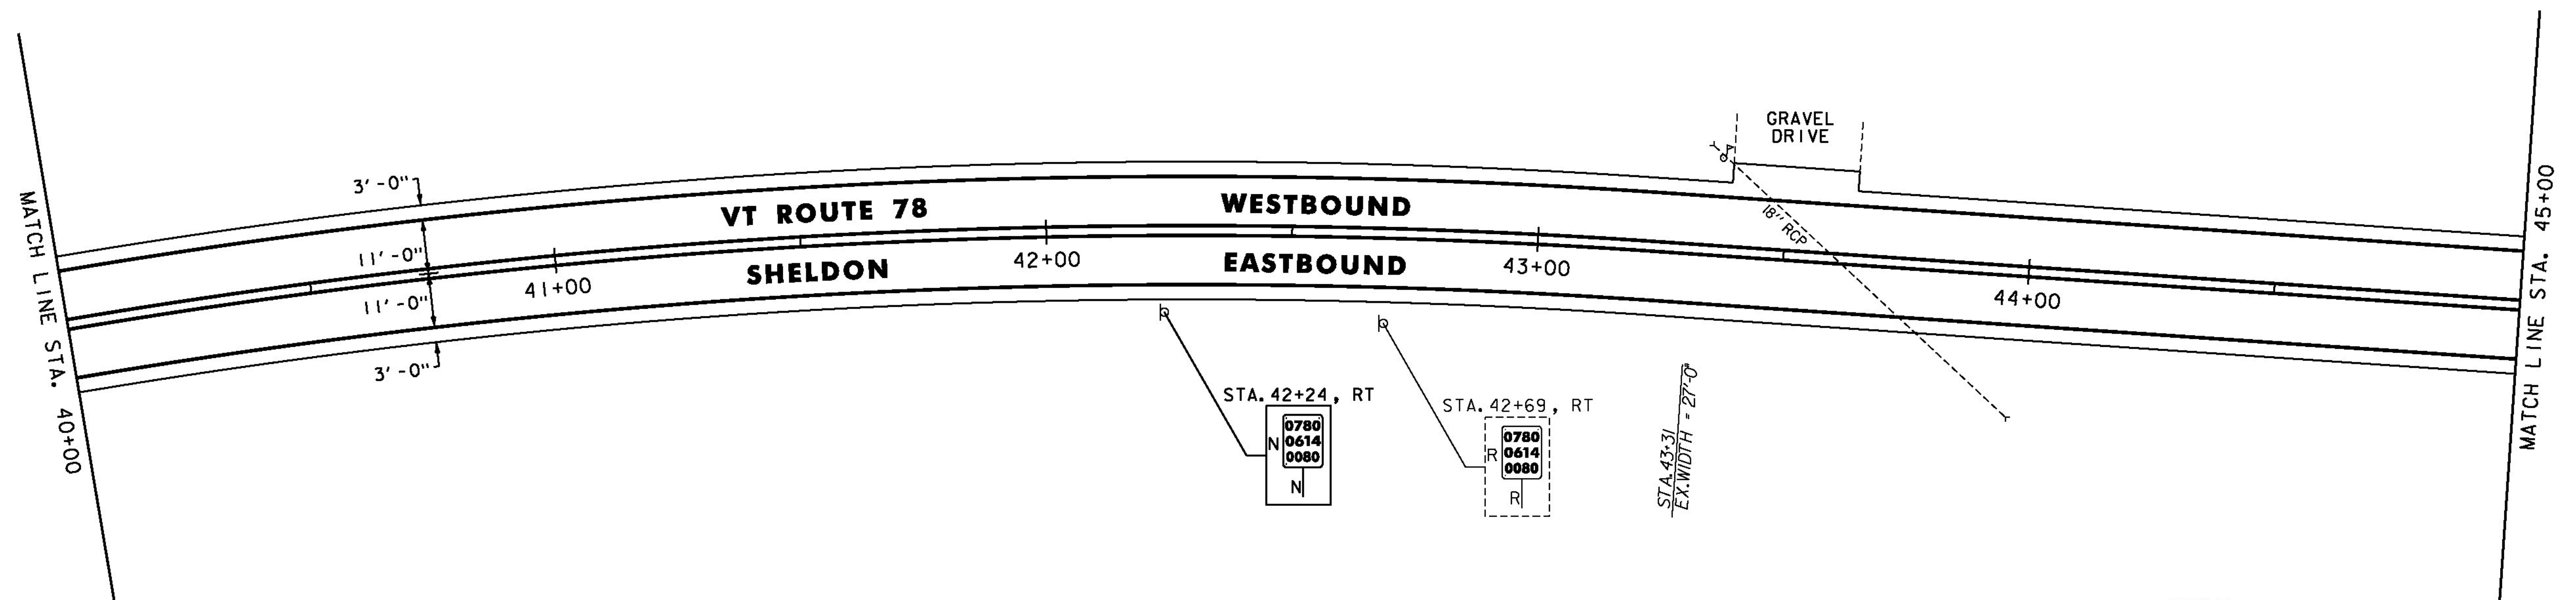

NOTES:

1. FOR LEGENDS, SEE SHEET 19.
2. ALL EXISTING SIGNS NOT SHOWN SHALL BE RETAINED.

NOT TO SCALE

**PROJECT  
LAYOUT  
SHEET #59**



PROJECT NAME: SWANTON-SHELDON  
PROJECT NUMBER: STP 2715(I)

FILE NAME: p07cl86.dgn  
PROJECT LEADER: G. EDWARDS  
DESIGNED BY: G. BARRETT

PLOT DATE: 4/24/2014  
DRAWN BY: G. BARRETT  
CHECKED BY: M. FOISY  
SHEET 77 OF 121