

MILLED RUMBLE STRIPS  
STA. 55+00 TO 60+00, C

STEEL BEAM GUARDRAIL, GALVANIZED  
STA. 56+68.0 TO 56+93.0, RT


ANCHOR FOR STEEL BEAM RAIL  
STA. 56+93.0, RT

TEMPORARY 4 INCH WHITE LINE, PAINT  
DURABLE 4 INCH WHITE LINE (OPTION BID ITEM)  
(ALL LINES WILL INCLUDE EDGE LINE BREAKS  
AND RADII FOR SIDE ROADS)  
STA. 55+00 TO 60+00, SOLID LT & RT

STEEL BEAM GUARDRAIL, GALVANIZED  
W/8 FEET POSTS  
STA. 55+00 TO 56+68.0, RT

REMOVAL AND DISPOSAL OF GUARDRAIL  
STA. 55+00 TO 56+93.0, RT


TEMPORARY 4 INCH YELLOW LINE, PAINT  
DURABLE 4 INCH YELLOW LINE (OPTION BID ITEM)  
(ALL LINES WILL INCLUDE C BREAKS FOR SIDE ROADS)  
STA. 55+00 TO 60+00, SOLID LT & RT

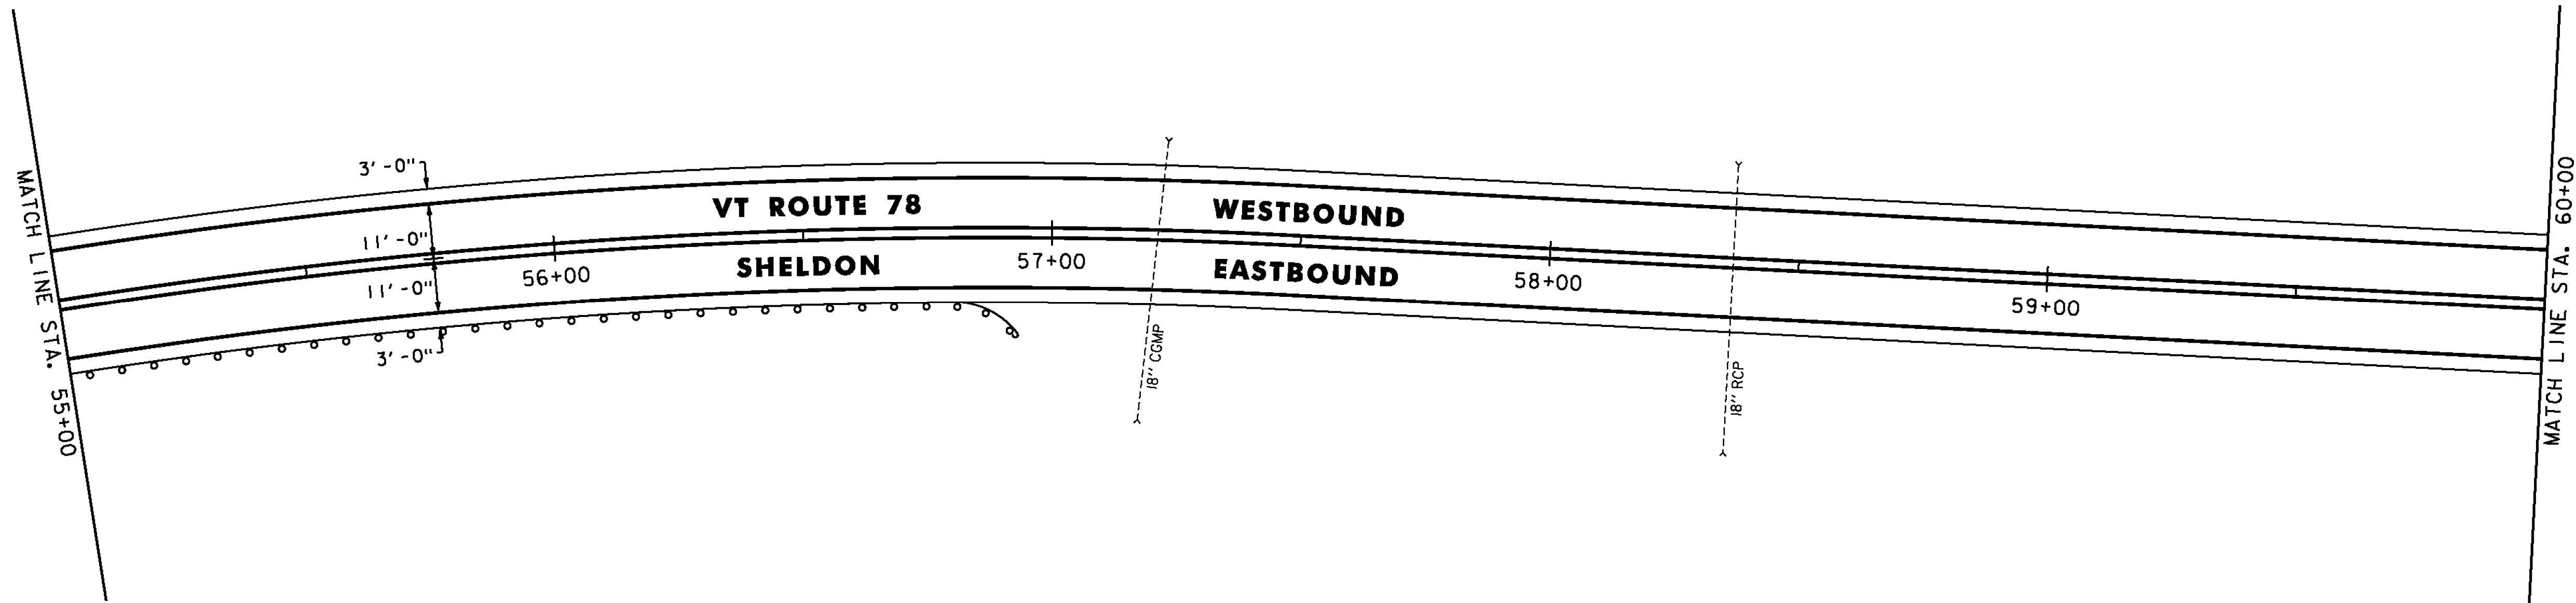

MILLED RUMBLE STRIPS  
STA. 60+00 TO 65+00, C  
61+30

TEMPORARY 4 INCH WHITE LINE, PAINT  
DURABLE 4 INCH WHITE LINE (OPTION BID ITEM)  
(ALL LINES WILL INCLUDE EDGE LINE BREAKS  
AND RADII FOR SIDE ROADS)  
STA. 60+00 TO 65+00, SOLID LT & RT

TEMPORARY 4 INCH YELLOW LINE, PAINT  
DURABLE 4 INCH YELLOW LINE (OPTION BID ITEM)  
(ALL LINES WILL INCLUDE C BREAKS FOR SIDE ROADS)  
STA. 60+00 TO 65+00, SOLID LT & RT

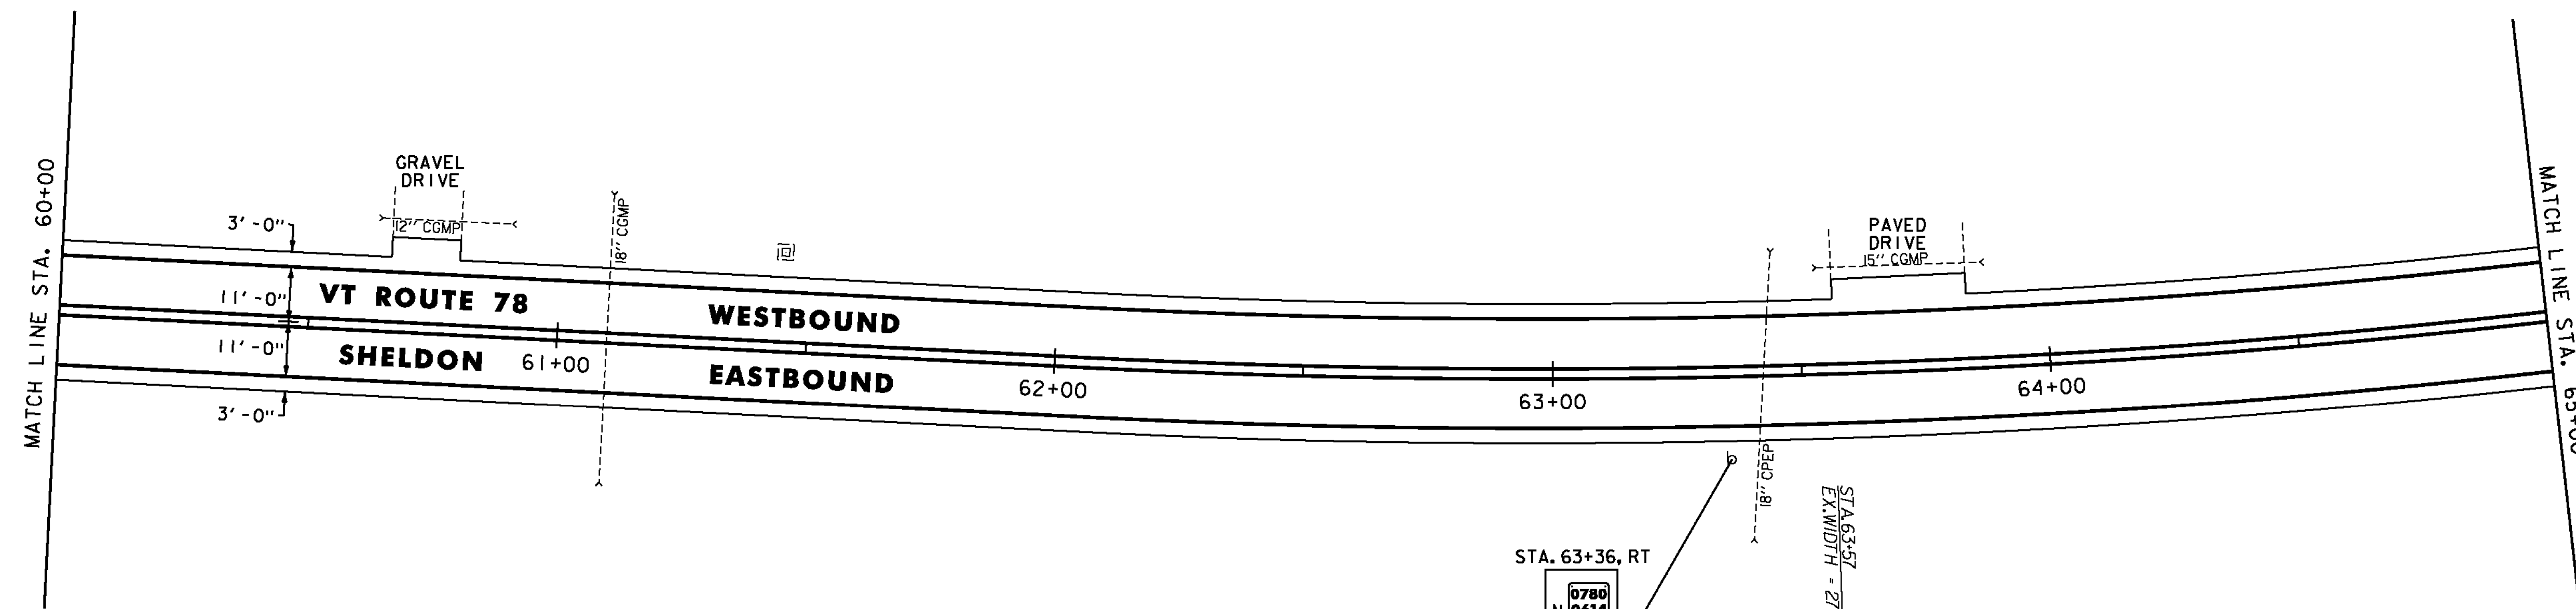

NOTES:

1. FOR LEGENDS, SEE SHEET 19.
2. ALL EXISTING SIGNS NOT SHOWN SHALL BE RETAINED.

NOT TO SCALE

**PROJECT LAYOUT SHEET #61**

PROJECT NAME: SWANTON-SHELDON  
PROJECT NUMBER: STP 2715(I)

FILE NAME: p07c186.dgn  
PROJECT LEADER: G. EDWARDS  
DESIGNED BY: G. BARRETT

PLOT DATE: 4/24/2014  
DRAWN BY: G. BARRETT  
CHECKED BY: M. FOISY  
SHEET 79 OF 121

