


MILLED RUMBLE STRIPS  
STA. 65+00 TO 70+00, C  
STONE FILL, TYPE J  
STA. 69+69 TO 69+75, RT

STEEL BEAM GUARDRAIL, GALVANIZED  
STA. 69+12.5 TO 69+37.5, RT  
STEEL BEAM GUARDRAIL, GALVANIZED  
W/8 FEET POSTS  
STA. 69+37.5 TO 70+00.0, RT

ANCHOR FOR STEEL BEAM RAIL  
STA. 69+12.5, RT  
REMOVAL AND DISPOSAL OF GUARDRAIL  
STA. 69+12.5 TO 70+00, RT

TEMPORARY 4 INCH WHITE LINE, PAINT  
DURABLE 4 INCH WHITE LINE (OPTION BID ITEM)  
(ALL LINES WILL INCLUDE EDGE LINE BREAKS  
AND RADIUS FOR SIDE ROADS)  
STA. 65+00 TO 70+00, SOLID LT & RT  
TEMPORARY 4 INCH YELLOW LINE, PAINT  
DURABLE 4 INCH YELLOW LINE (OPTION BID ITEM)  
(ALL LINES WILL INCLUDE C BREAKS FOR SIDE ROADS)  
STA. 65+00 TO 70+00, SOLID LT & RT

GEOTEXTILE UNDER STONE FILL  
STA. 69+69 TO 69+75, RT  
GRUBBING MATERIAL  
STA. 69+69 TO 69+75, RT

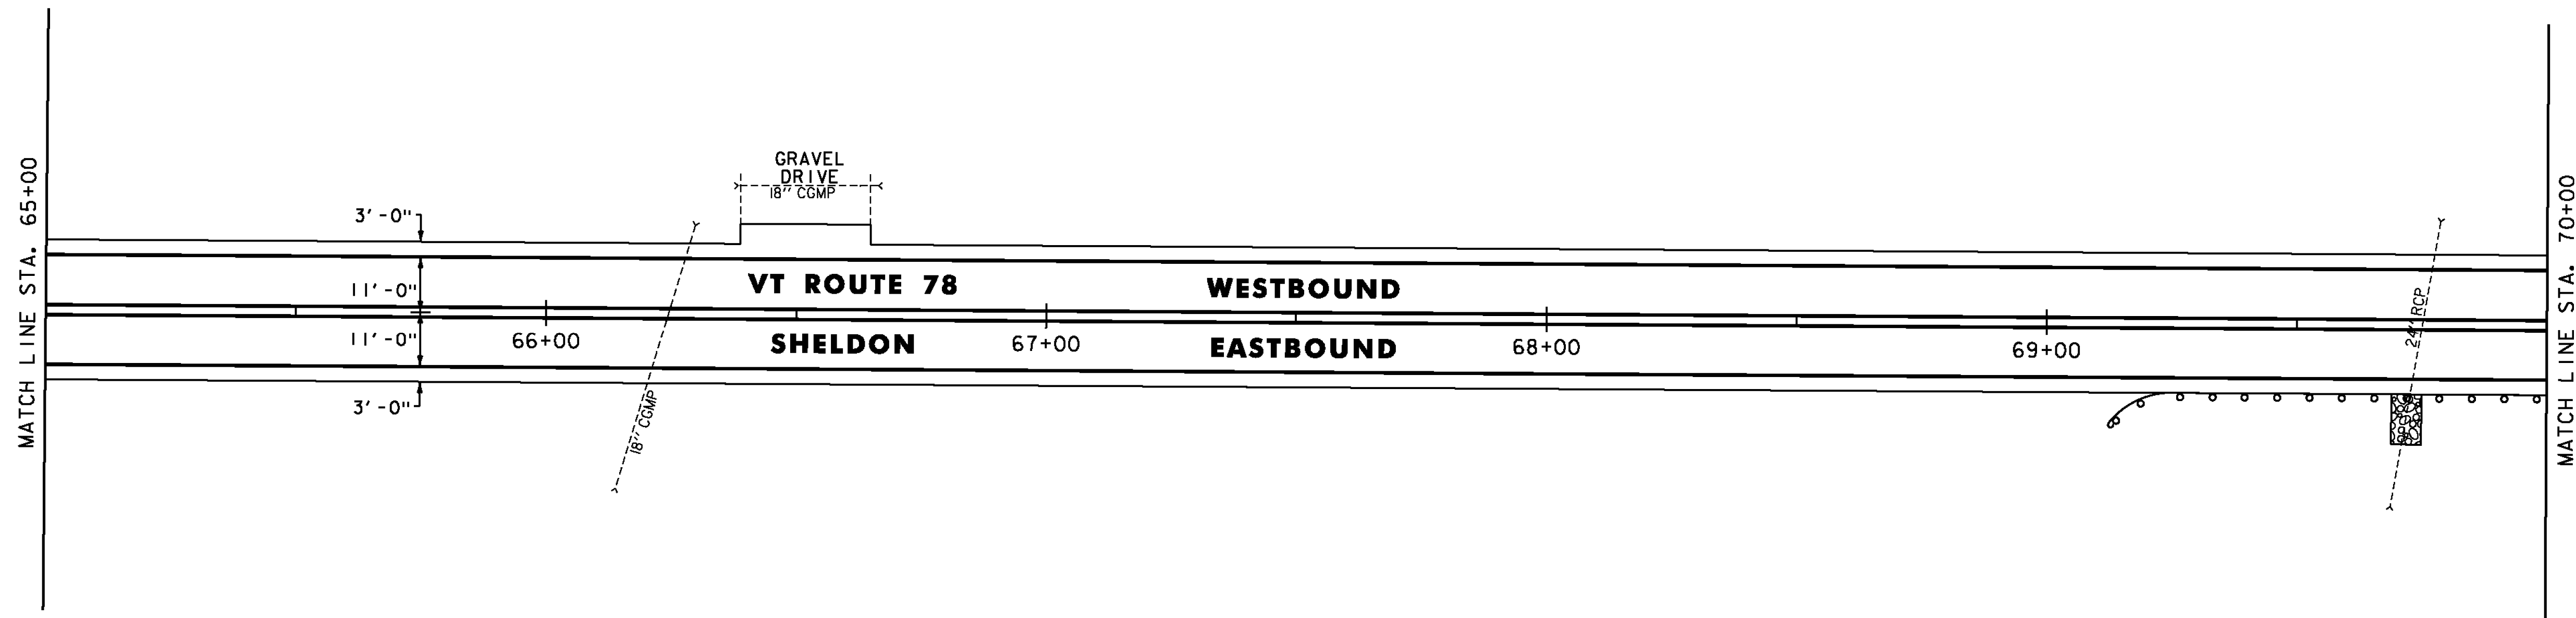


MILLED RUMBLE STRIPS  
STA. 70+00 TO 75+00, C  
STONE FILL, TYPE J  
STA. 70+37 TO 70+82, RT  
STA. 71+62 TO 71+68, LT

STEEL BEAM GUARDRAIL, GALVANIZED  
STA. 70+77.5 TO 71+02.5, LT  
STA. 72+27.5 TO 72+52.5, LT  
STEEL BEAM GUARDRAIL, GALVANIZED  
W/8 FEET POSTS  
STA. 70+00.0 TO 75+00.0, RT  
STA. 71+02.5 TO 72+27.5, LT

ANCHOR FOR STEEL BEAM RAIL  
STA. 70+77.5, LT  
STA. 72+52.5, LT  
REMOVAL AND DISPOSAL OF GUARDRAIL  
STA. 70+00 TO 75+00, RT  
STA. 70+77.5 TO 72+52.5, LT

TEMPORARY 4 INCH WHITE LINE, PAINT  
DURABLE 4 INCH WHITE LINE (OPTION BID ITEM)  
(ALL LINES WILL INCLUDE EDGE LINE BREAKS  
AND RADIUS FOR SIDE ROADS)  
STA. 70+00 TO 75+00, SOLID LT & RT  
TEMPORARY 4 INCH YELLOW LINE, PAINT  
DURABLE 4 INCH YELLOW LINE (OPTION BID ITEM)  
(ALL LINES WILL INCLUDE C BREAKS FOR SIDE ROADS)  
STA. 70+00 TO 75+00, SOLID LT & RT

GEOTEXTILE UNDER STONE FILL  
STA. 70+37 TO 70+82, RT  
STA. 71+62 TO 71+68, LT  
REMOVING SIGNS  
AS SHOWN - 1  
GRUBBING MATERIAL  
STA. 70+37 TO 70+82, RT  
STA. 71+62 TO 71+68, LT

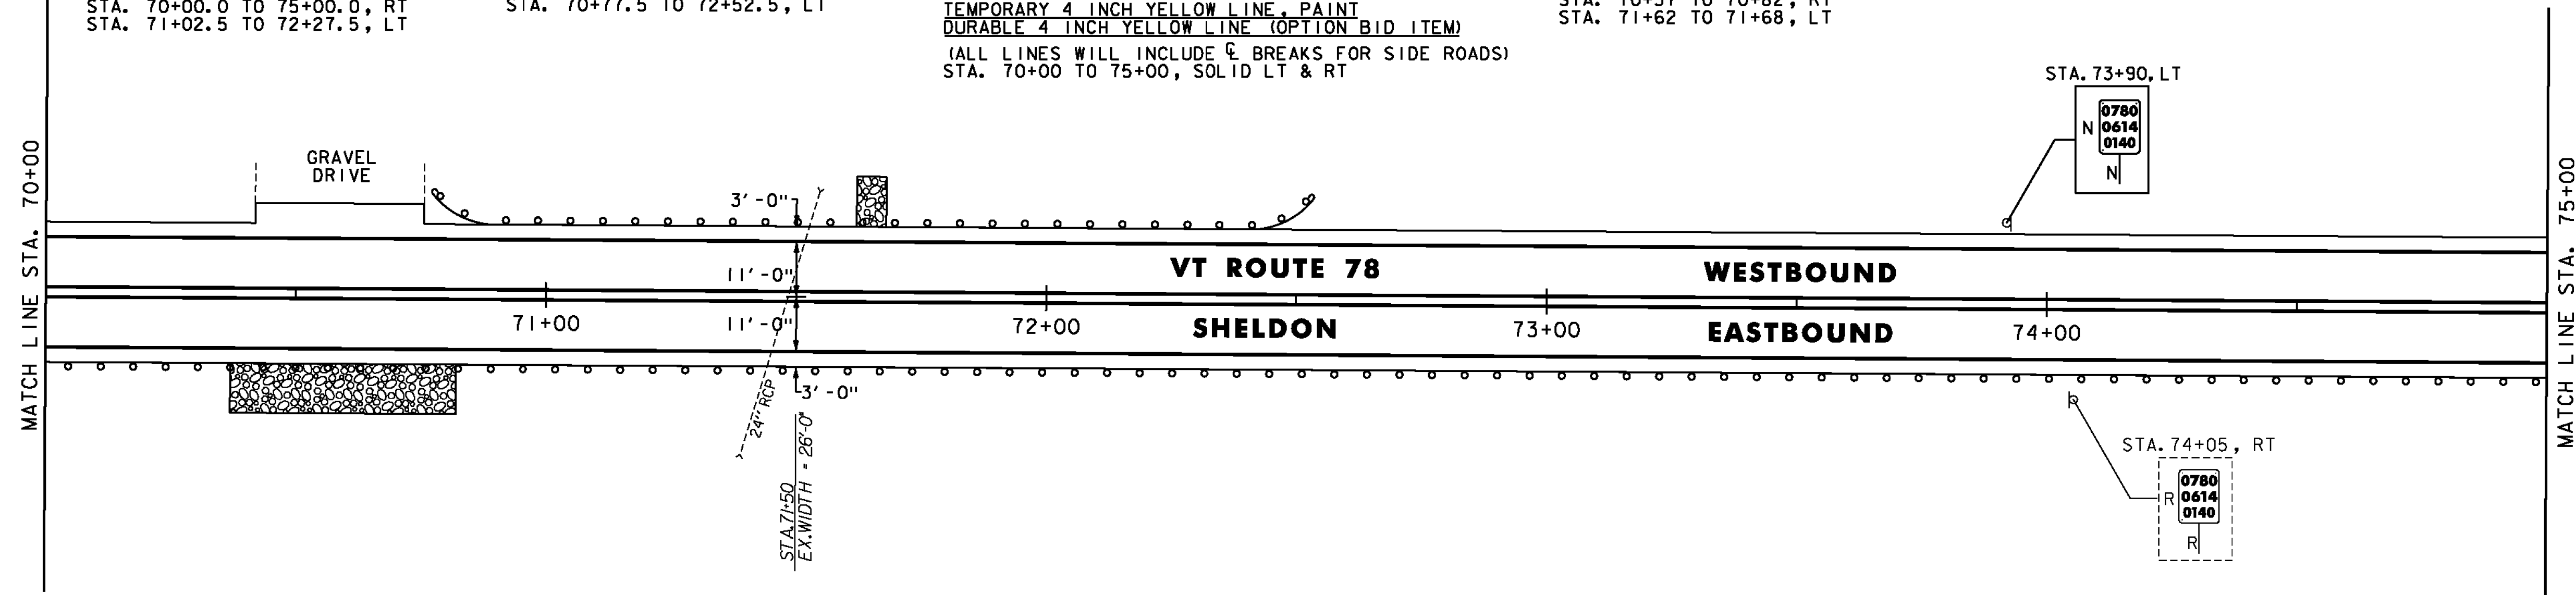

- NOTES:
- FOR LEGENDS, SEE SHEET 19.
  - ALL EXISTING SIGNS NOT SHOWN SHALL BE RETAINED.

NOT TO SCALE

**PROJECT LAYOUT SHEET #62**

PROJECT NAME: SWANTON-SHELDON  
PROJECT NUMBER: STP 2715(I)

FILE NAME: p07cl86.dgn  
PROJECT LEADER: G. EDWARDS  
DESIGNED BY: G. BARRETT

PLOT DATE: 4/24/2014  
DRAWN BY: G. BARRETT  
CHECKED BY: M. FOISY  
SHEET 80 OF 121

